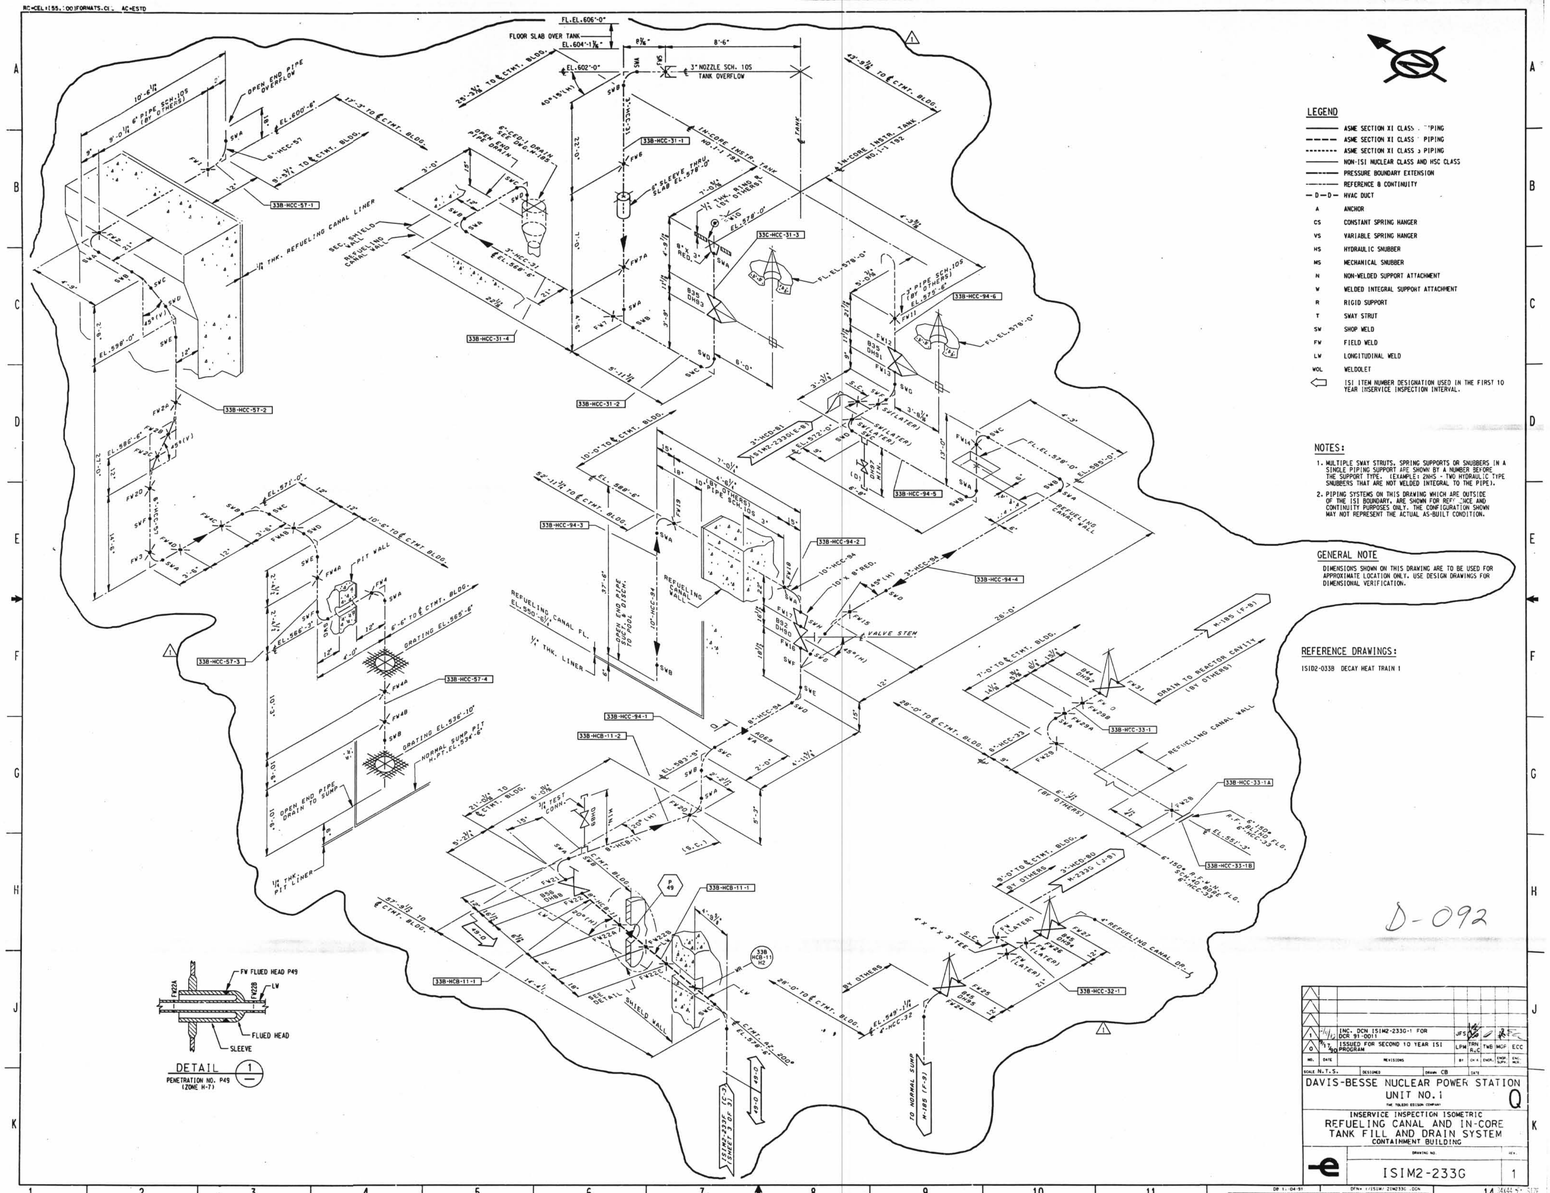

LEGEND

- ASME SECTION XI CLASS 1 PIPING
- ASME SECTION XI CLASS 2 PIPING
- ASME SECTION XI CLASS 3 PIPING
- NON-ISI NUCLEAR CLASS AND HSC CLASS
- PRESSURE BOUNDARY EXTENSION
- REFERENCE & CONTINUITY
- HVAC DUCT
- A — ANCHOR
- CS — CONSTANT SPRING HANGER
- VS — VARIABLE SPRING HANGER
- HS — HYDRAULIC SNUBBER
- MS — MECHANICAL SNUBBER
- N — NON-WELDED SUPPORT ATTACHMENT
- W — WELDED INTEGRAL SUPPORT ATTACHMENT
- R — RIGID SUPPORT
- T — SWAY STRUT
- SW — SHOP WELD
- FW — FIELD WELD
- LW — LONGITUDINAL WELD
- WOL — WELDOLET
- ISI ITEM NUMBER DESIGNATION USED IN THE FIRST 10 YEAR INSERVICE INSPECTION INTERVAL.

NOTES:

1. MULTIPLE SWAY STRUTS, SPRING SUPPORTS OR SNUBBERS IN A SINGLE PIPING SUPPORT ARE SHOWN BY A NUMBER BEFORE THE SUPPORT TYPE. (EXAMPLE: 2HMS - TWO HYDRAULIC TYPE SNUBBERS THAT ARE NOT WELDED INTEGRAL TO THE PIPE).
2. PIPING SYSTEMS ON THIS DRAWING WHICH ARE OUTSIDE OF THE ISI BOUNDARY, ARE SHOWN FOR REFERENCE AND CONTINUITY PURPOSES ONLY. THE CONFIGURATION SHOWN MAY NOT REPRESENT THE ACTUAL AS-BUILT CONDITION.

GENERAL NOTE

DIMENSIONS SHOWN ON THIS DRAWING ARE TO BE USED FOR APPROXIMATE LOCATION ONLY. USE DESIGN DRAWINGS FOR DIMENSIONAL VERIFICATION.

REFERENCE DRAWINGS:

ISI02-033B DECAY HEAT TRAIN 1

D-092

NO.	DATE	REVISIONS	BY	CH.	CHK.	ENGR.	ENGR. MGR.
1	11/96	ING- DCN ISIM2-233G-1 FOR ECR 31-0015	JFS				
0	11/95	ISSUED FOR SECOND 10 YEAR ISI PROGRAM	LPM	TRN DLC	TMB	MCF	ECC

SCALE N.T.S. | DESIGNED | DRAWN CB | DATE

DAVIS-BESSE NUCLEAR POWER STATION
UNIT NO.1
THE TOLEDO EDISON COMPANY

INSERVICE INSPECTION ISOMETRIC
REFUELING CANAL AND IN-CORE TANK FILL AND DRAIN SYSTEM
CONTAINMENT BUILDING

DRAWING NO. ISIM2-233G | REV. 1

DP 1-04-91 | DFN= I:\ISIM\ISIM233G.DGN

LEVELS *23*598*2305*8024*8030*2147*8024*2305*8024

I HEREBY CERTIFY THAT THE INFORMATION ON THIS FRAME WAS MADE IN THE SMALLEST DETAIL CLEARLY IS LEGIBLE, AS THE DATA STATES HERE AND THAT IT IS AN ACCURATE REPRODUCTION OF THE DRAWING SUBMITTED TO NUCLEAR REVISION MANAGEMENT.