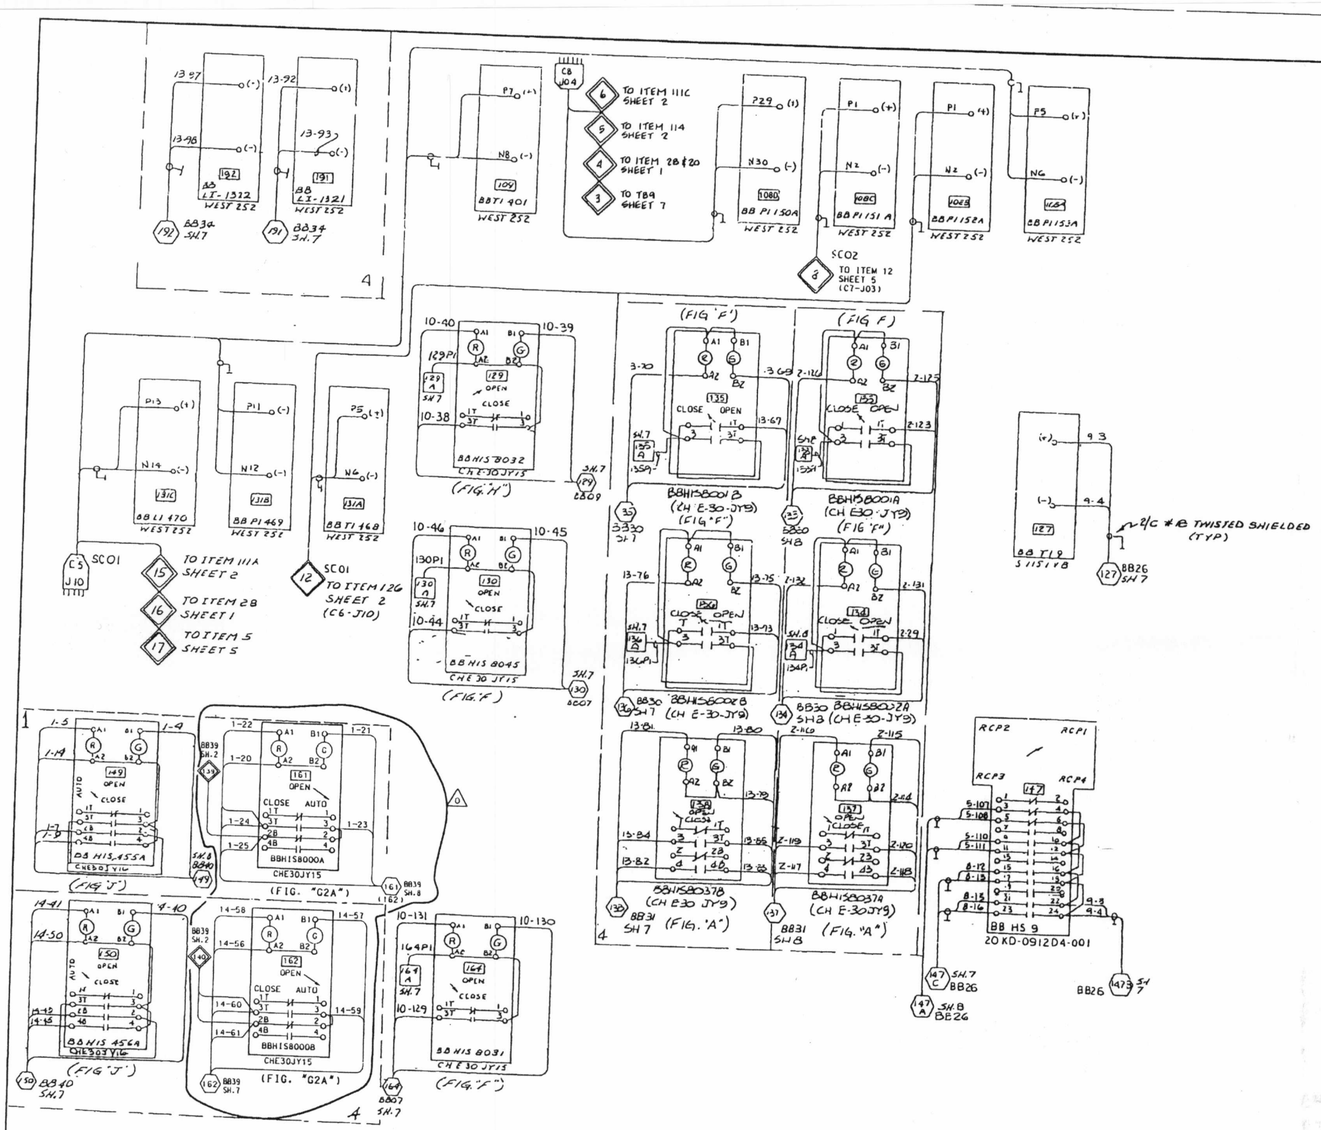

REV.	DATE	DRAWN
17	7-21	MAL
CHKD	APPV	APPD
RLW	7-21	NA

REFLECTO FLIPOVER TO USE ISSUE 17 PER EDP-E-CA024

REV.	DATE	DRAWN
18	7-29	X
CHKD	APPV	APPD
		NA

ISSUED PER EDP-E-CA024

REV.	DATE	DRAWN
19	7-31	MAL
CHKD	APPV	APPD
RLW	7-31	NA

INCORP. CMF 90-100 12

REV.	DATE	DRAWN
20	7-91	MAL
CHKD	APPV	APPD
RLW	7-91	NA

INCORP. CMF 91-1084

REV.	DATE	DRAWN
21	00-1004	BL
CHKD	APPV.	APPD
MAL	AMR	N/A

INCORP. MF 00-1005A

REV.	SEQ.	DATE
21	0	10-4-01
DRAWN	CHKD	APPD
SKC	X	LR

INITIAL ISSUE PER RFR-20411B

D-03

REF NO.	DRAWING NO.	REV.	SEQ.
20411B	J-200-00055	021	000

SYSTEM: RL ~~AS-BUILT~~

DRAWING NO.	REV.
~~J-200-00055~~	~~21~~

Comsip Customline, Corp.
LINDEN, NEW JERSEY

TITLE: MAIN CONTROL BOARD RL021-& RL022 WIRING DIAGRAM

PROJECT BECHTEL SNUPPS GAITHERSBURG, MD

DRWN BY OA	DATE 7-12-77	SCALE N/S	APPD FOR CONST 11/12
CHKD BY WVA	DATE 7-15-77	DRAWING NO.	REV NO.
APPV BY MW	DATE 8-22-77		