MPL No. 1P44 1015M M-1072F

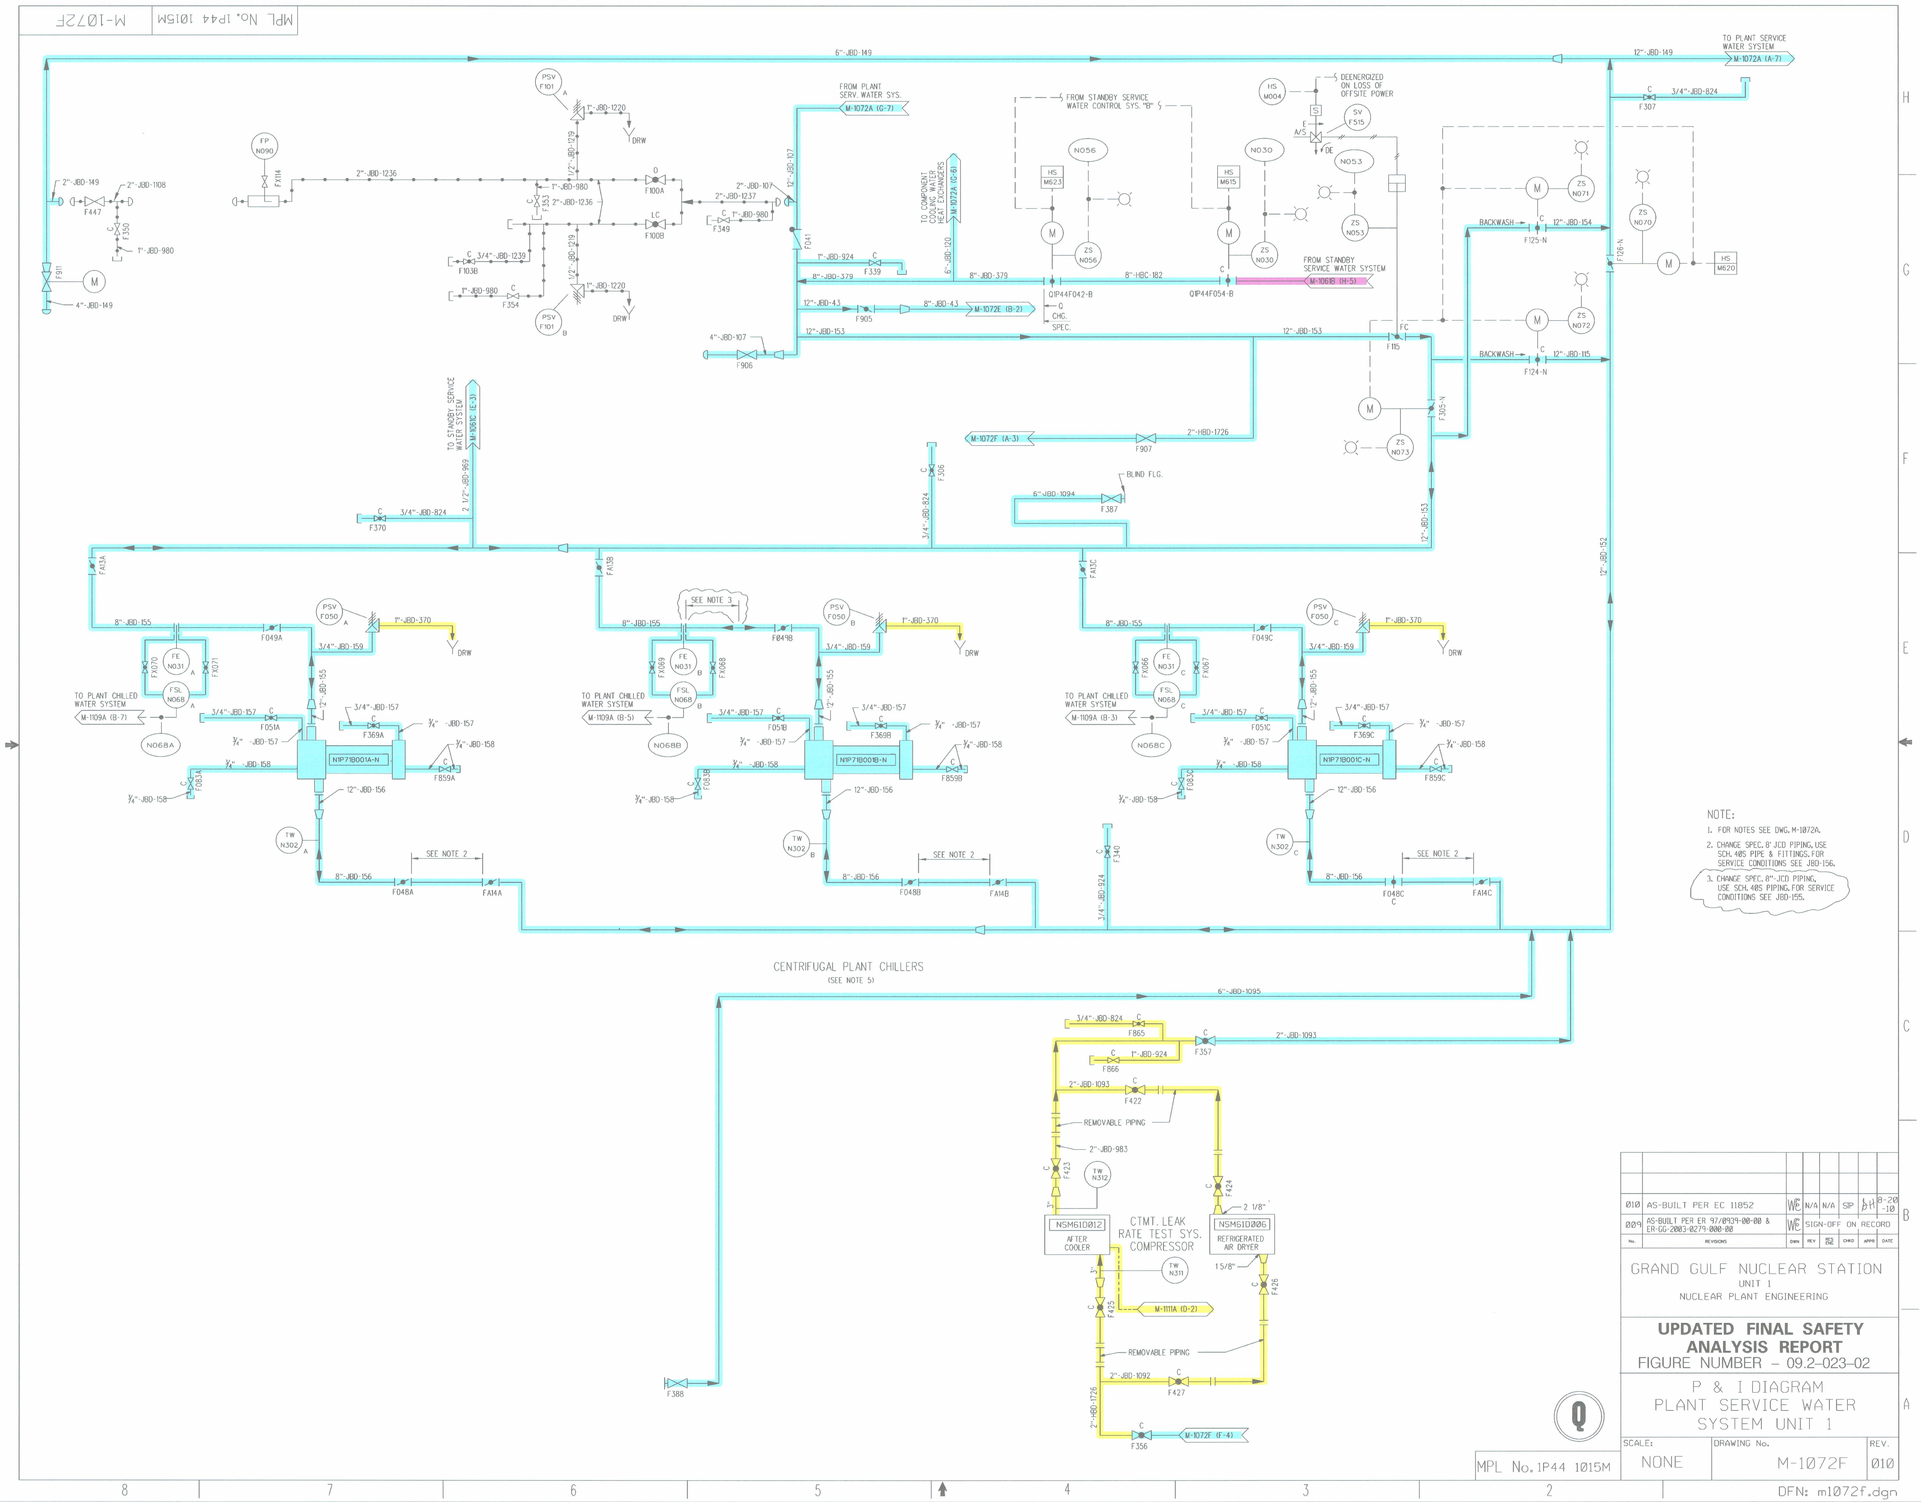

NOTE:

1. FOR NOTES SEE DWG. M-1072A.
2. CHANGE SPEC. 8" JCD PIPING, USE SCH. 40S PIPE & FITTINGS, FOR SERVICE CONDITIONS SEE JBD-156.
3. CHANGE SPEC. 8"-JCD PIPING, USE SCH. 40S PIPING, FOR SERVICE CONDITIONS SEE JBD-155.

COMPONENTS SUBJECT TO AMR

- STANDBY SERVICE WATER SYSTEM AMM12
- NON-SAFETY RELATED SYSTEMS & COMPONENTS AFFECTING SAFETY RELATED SYSTEMS AMM20
- PLANT SERVICE WATER SYSTEM AMM29

NO.	REVISIONS	DWN	REV	CHKD	APPD	DATE
Ø10	AS-BUILT PER EC 11852	WE	N/A	N/A	SIP	8-20-10
Ø09	AS-BUILT PER ER 97-0029-00-00 & ER-GG-2003-0279-000-00	WE	SIGN-OFF ON RECORD			

GRAND GULF NUCLEAR STATION
UNIT 1
NUCLEAR PLANT ENGINEERING

UPDATED FINAL SAFETY ANALYSIS REPORT
FIGURE NUMBER – 09.2-023-02

P & I DIAGRAM
PLANT SERVICE WATER SYSTEM UNIT 1

SCALE:	DRAWING No.	REV.
NONE	M-1072F	Ø10

NO.	DATE	DESCRIPTION	BY	ENG CHK	APP
0	10-11-2011	.	.	. .	.

REVISIONS

LRA-M-1072F

CAD FILE: m1072f.DGN

RASTER FILE:

MPL No. 1P44 1015M

DFN: m1072f.dgn

D005