MPL No. 1N19 1015M | M-1053D

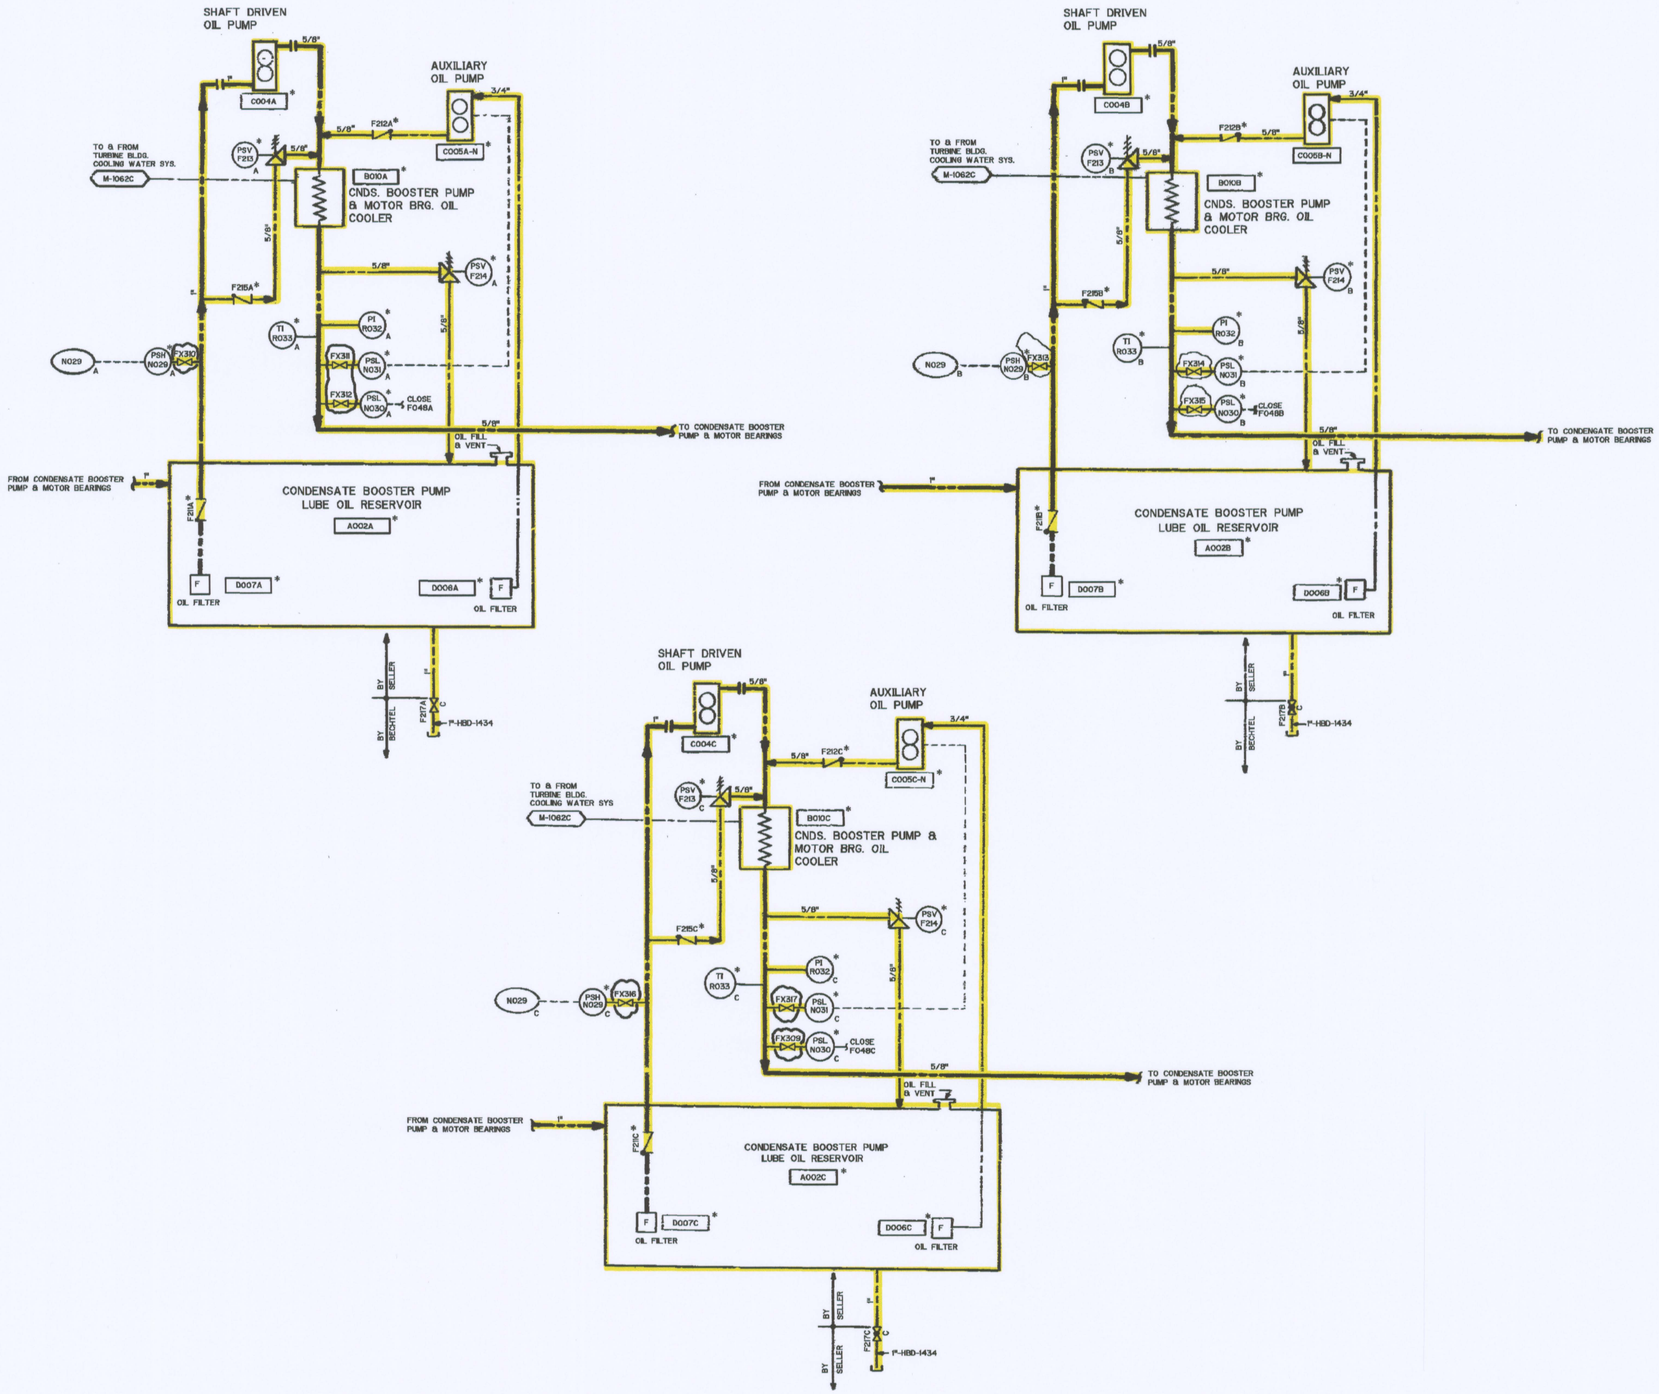

NOTES:
1. FOR NOTES SEE DWG. M-1053C

COMPONENTS SUBJECT TO AMR

NON-SAFETY RELATED SYSTEMS & COMPONENTS AFFECTING SAFETY RELATED SYSTEMS AMM20

No.	REVISIONS	DWN	REV	PEB ENG	CHKD	APPR	DATE
002	AS-BUILT PER QDR 0131-87	SIGN-OFF ON RECORD					

GRAND GULF NUCLEAR STATION
UNIT 1
NUCLEAR PLANT ENGINEERING

P & I DIAGRAM
CONDENSATE SYSTEM
UNIT 1

SCALE:	DRAWING No.	REV.
NONE	M-1053D	002

MPL No. 1N19 1015M

HYBRID DFN: m1053d.dgn

NO.	DATE	DESCRIPTION	BY	ENG	CHK	APP
0	9-29-2011	.	.	.	.	.

REVISIONS

LRA-M-1053D

CAD FILE: m1053d.DGN

RASTER FILE:

D139