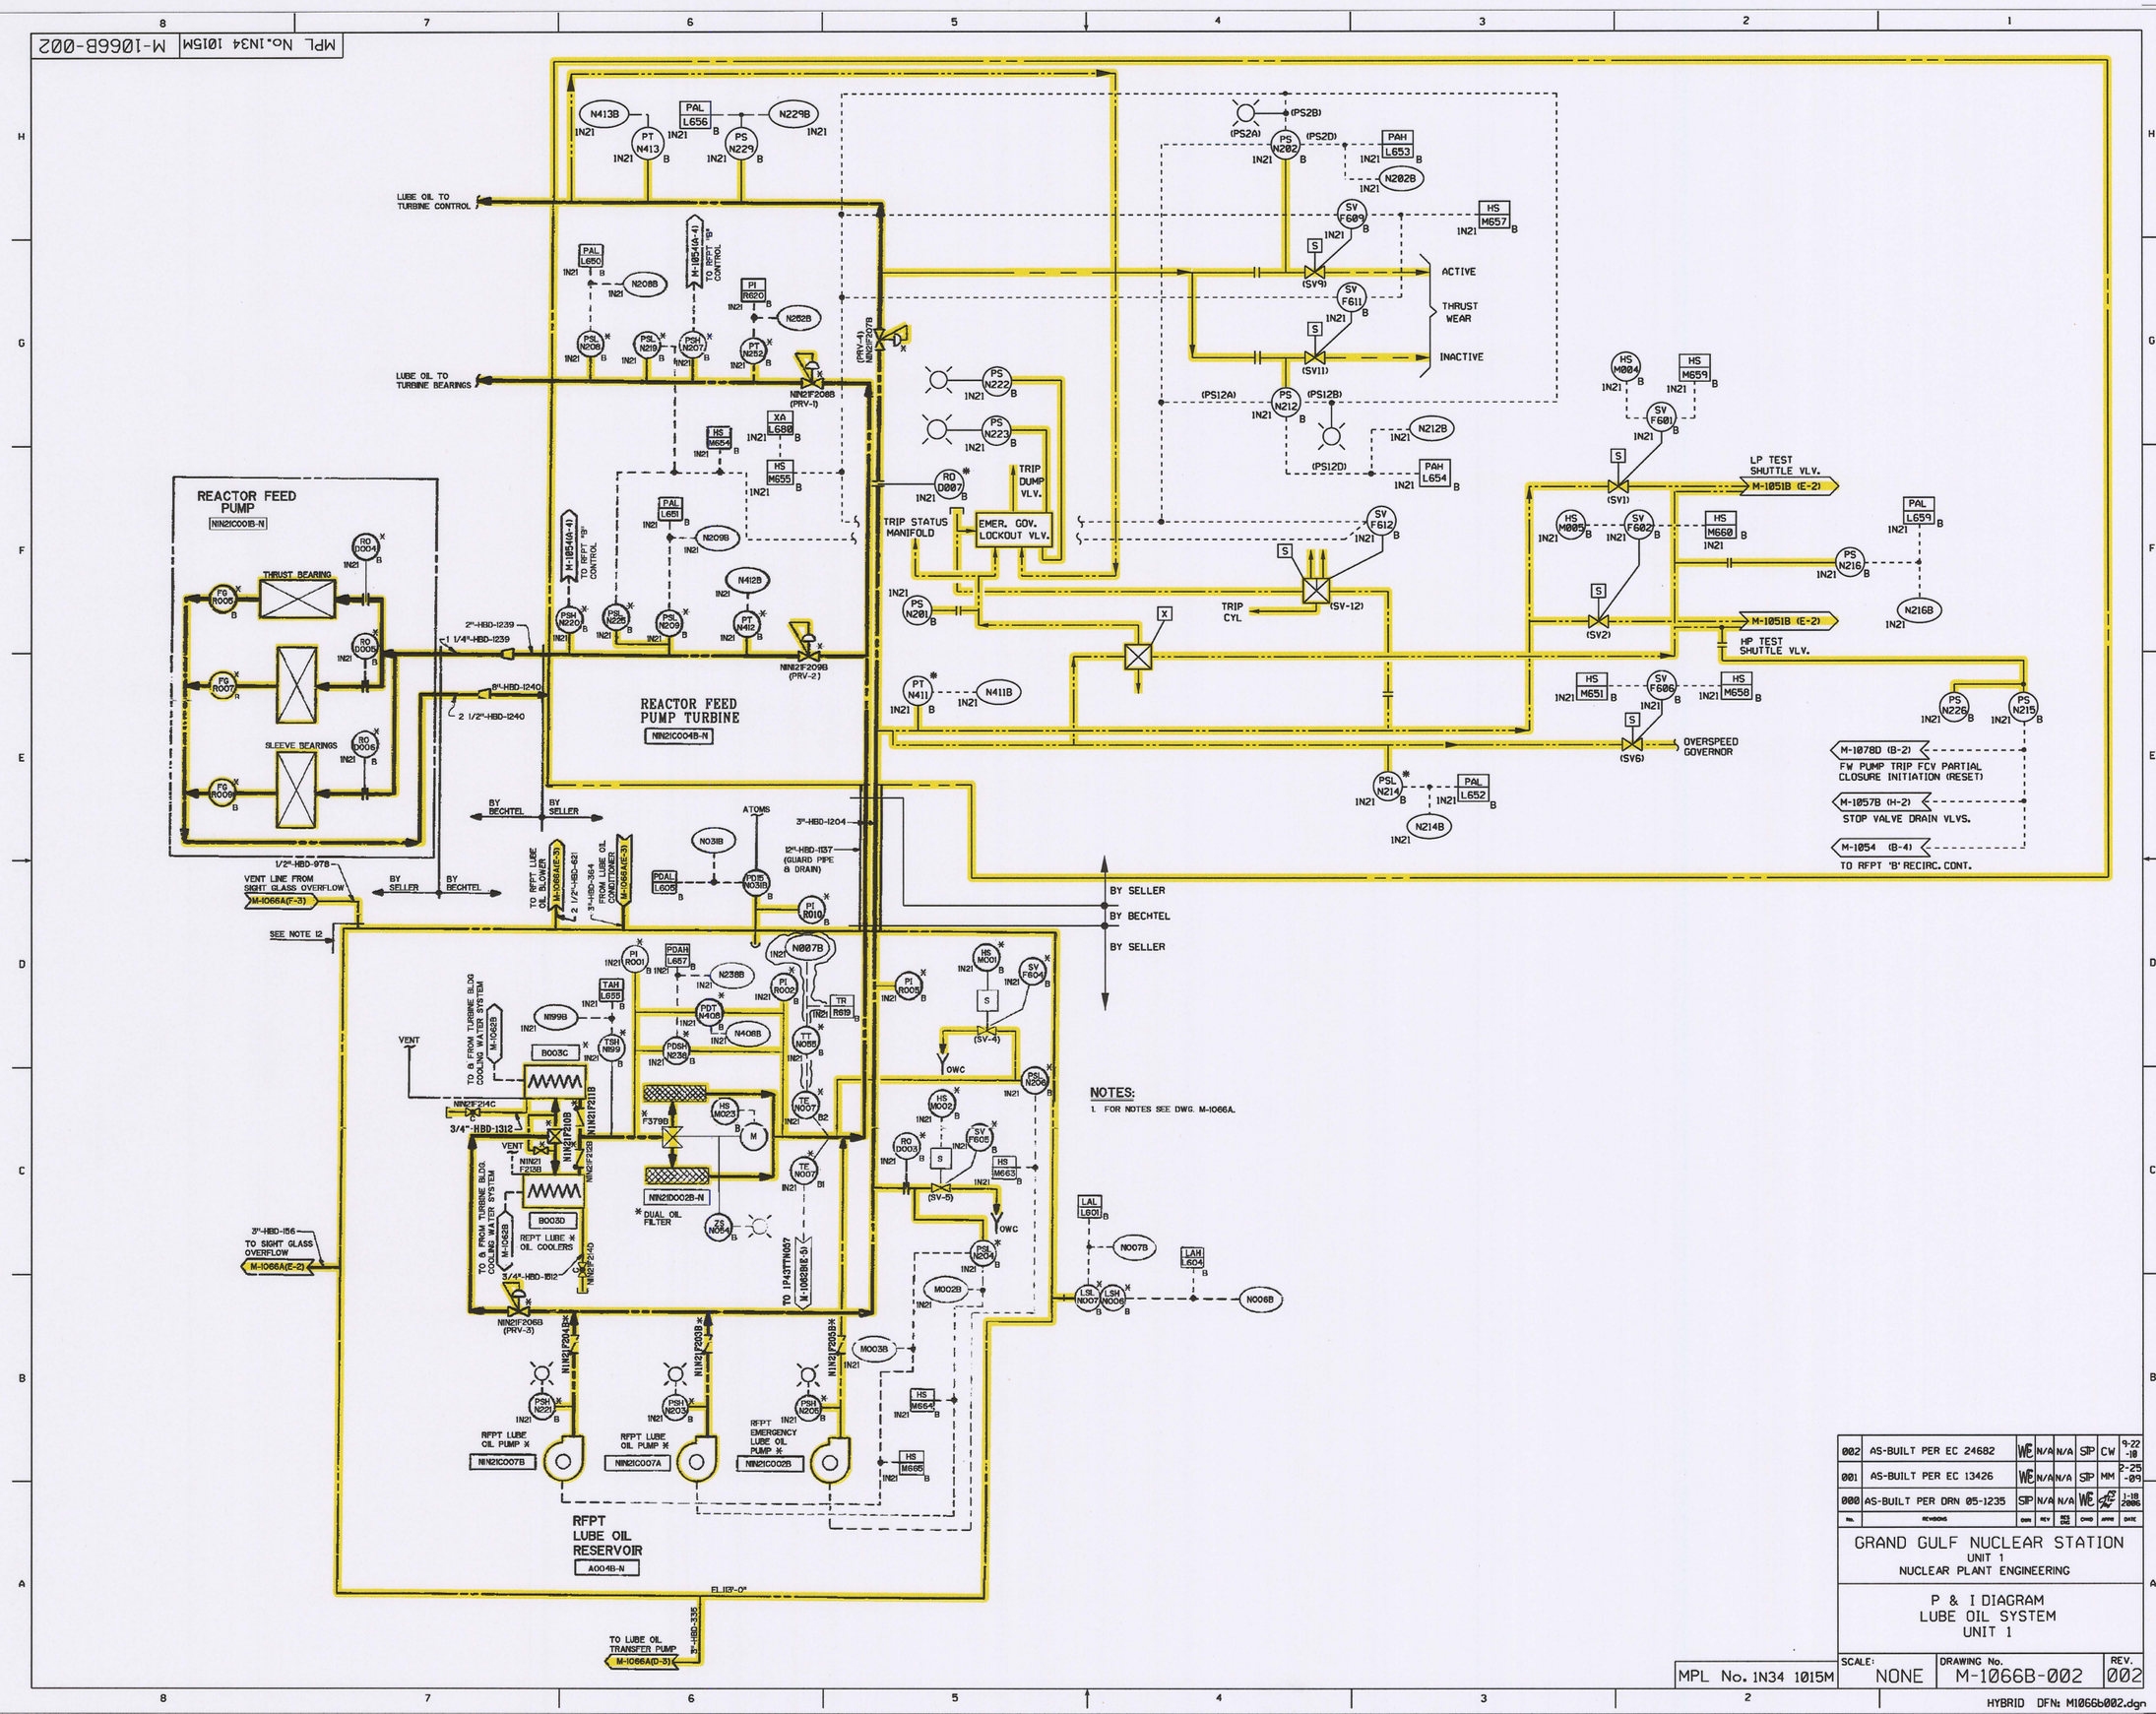

NOTES:

1. FOR NOTES SEE DWG. M-1066A.

COMPONENTS SUBJECT TO AMR

NON-SAFETY RELATED SYSTEMS & COMPONENTS AFFECTING SAFETY RELATED SYSTEMS AMM20

NO.	REVISIONS	DWN	REV	RES ENG	CHKD	APPR	DATE
002	AS-BUILT PER EC 24682	WE	N/A	N/A	STP	CW	9-22-10
001	AS-BUILT PER EC 13426	WE	N/A	N/A	STP	MM	2-25-09
000	AS-BUILT PER DRN 05-1235	STP	N/A	N/A	WE	[illegible]	1-18-2006

GRAND GULF NUCLEAR STATION
UNIT 1
NUCLEAR PLANT ENGINEERING

P & I DIAGRAM
LUBE OIL SYSTEM
UNIT 1

SCALE:	DRAWING No.	REV.
NONE	M-1066B-002	002

MPL No. 1N34 1015M

HYBRID DFN: M1066b002.dgn

NO.	DATE	DESCRIPTION	BY	ENG	CHK	APP
0	10-18-2011	.	.	.	.	.

REVISIONS

LRA-M-1066B-SH02

CAD FILE
m1066b-sh02.DGN

RASTER FILE

D176