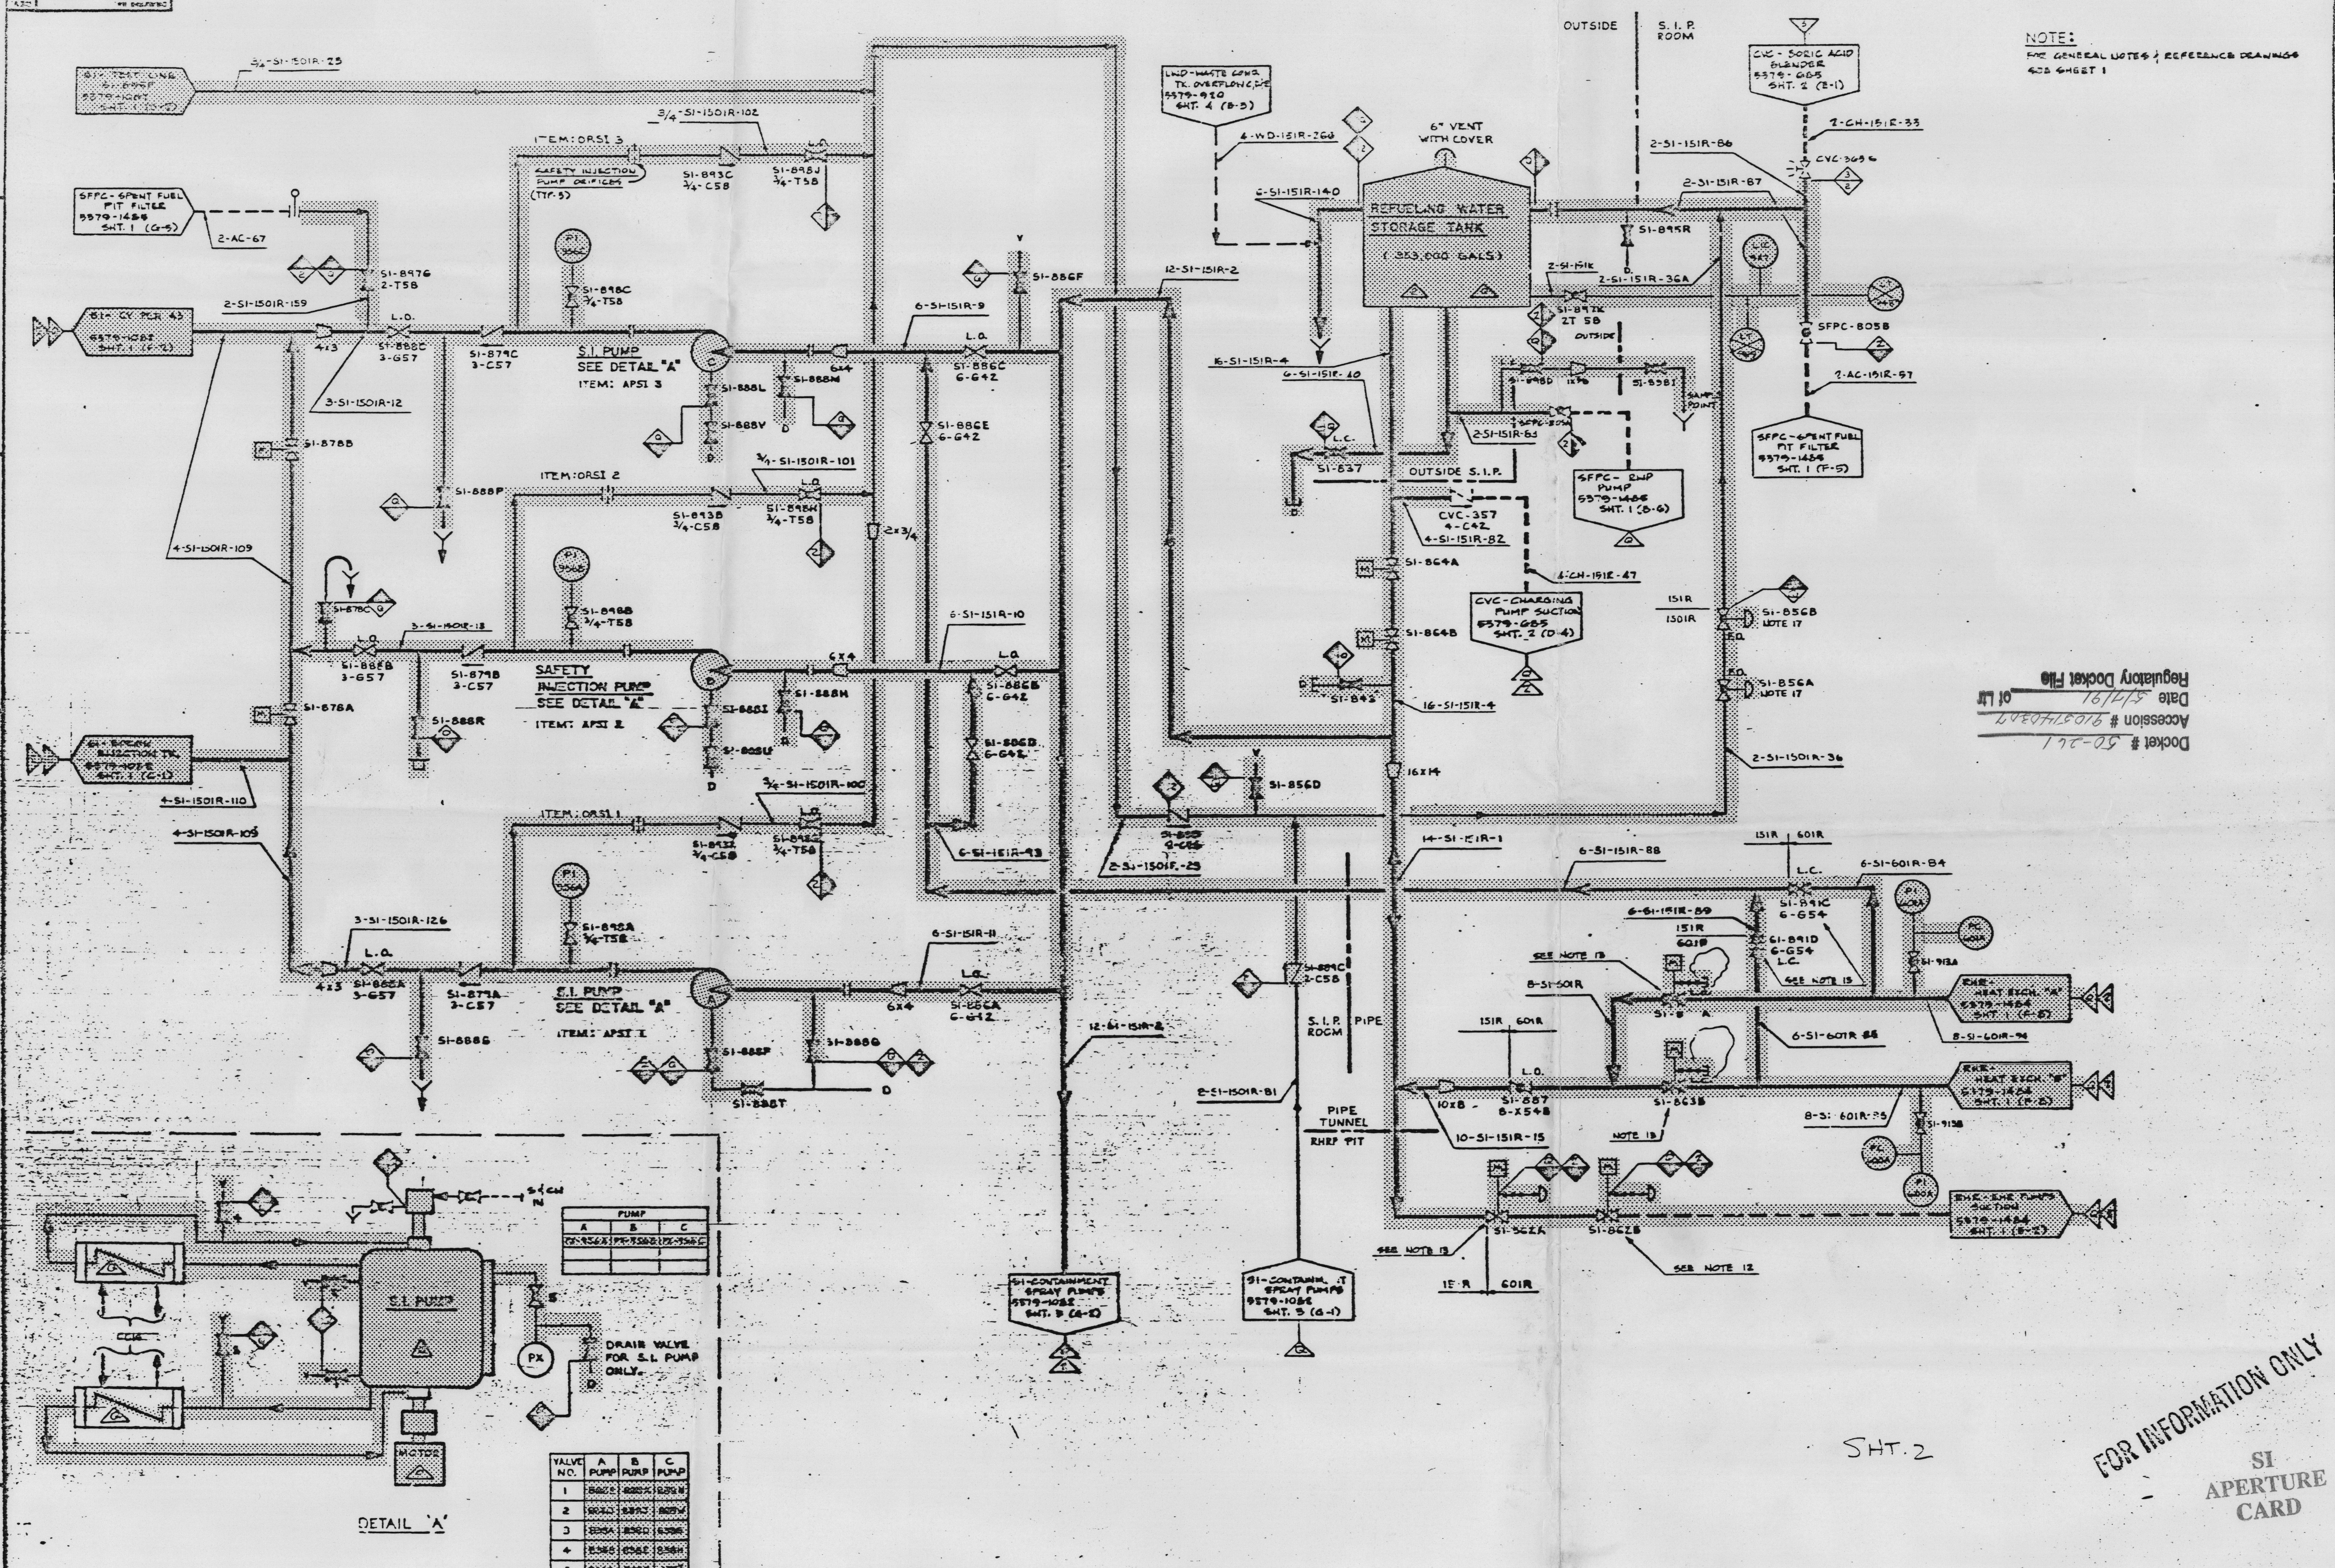

PUMP		
A	B	C
PX-956A	PX-956B	PX-956C

VALVE NO.	A PUMP	B PUMP	C PUMP
1	888E	888A	888N
2	888J	888J	888W
3	888A	888D	888E
4	888G	888E	888H
5	888G	888F	[illegible]

SHT. 2

FOR INFORMATION ONLY

SI APERTURE CARD

Regulatory Docket File
Date 5/7/91 of Ltr
Accession # 9105140347
Docket # 50-261

DRN: M. WHITE
CKD: W. JOHNSON
DSGN: AS BUILT
ENG: AS BUILT

CAROLINA POWER & LIGHT CO.
H.B. ROBINSON S.E. PLANT
UNIT - NO. 2 HARTSVILLE, S.C.

TITLE: SAFETY INJECTION SYSTEM FLOW DIAGRAM

SIZE E DRAWING NO. 5379-1082 REV. 29
SCALE NONE

9105210348