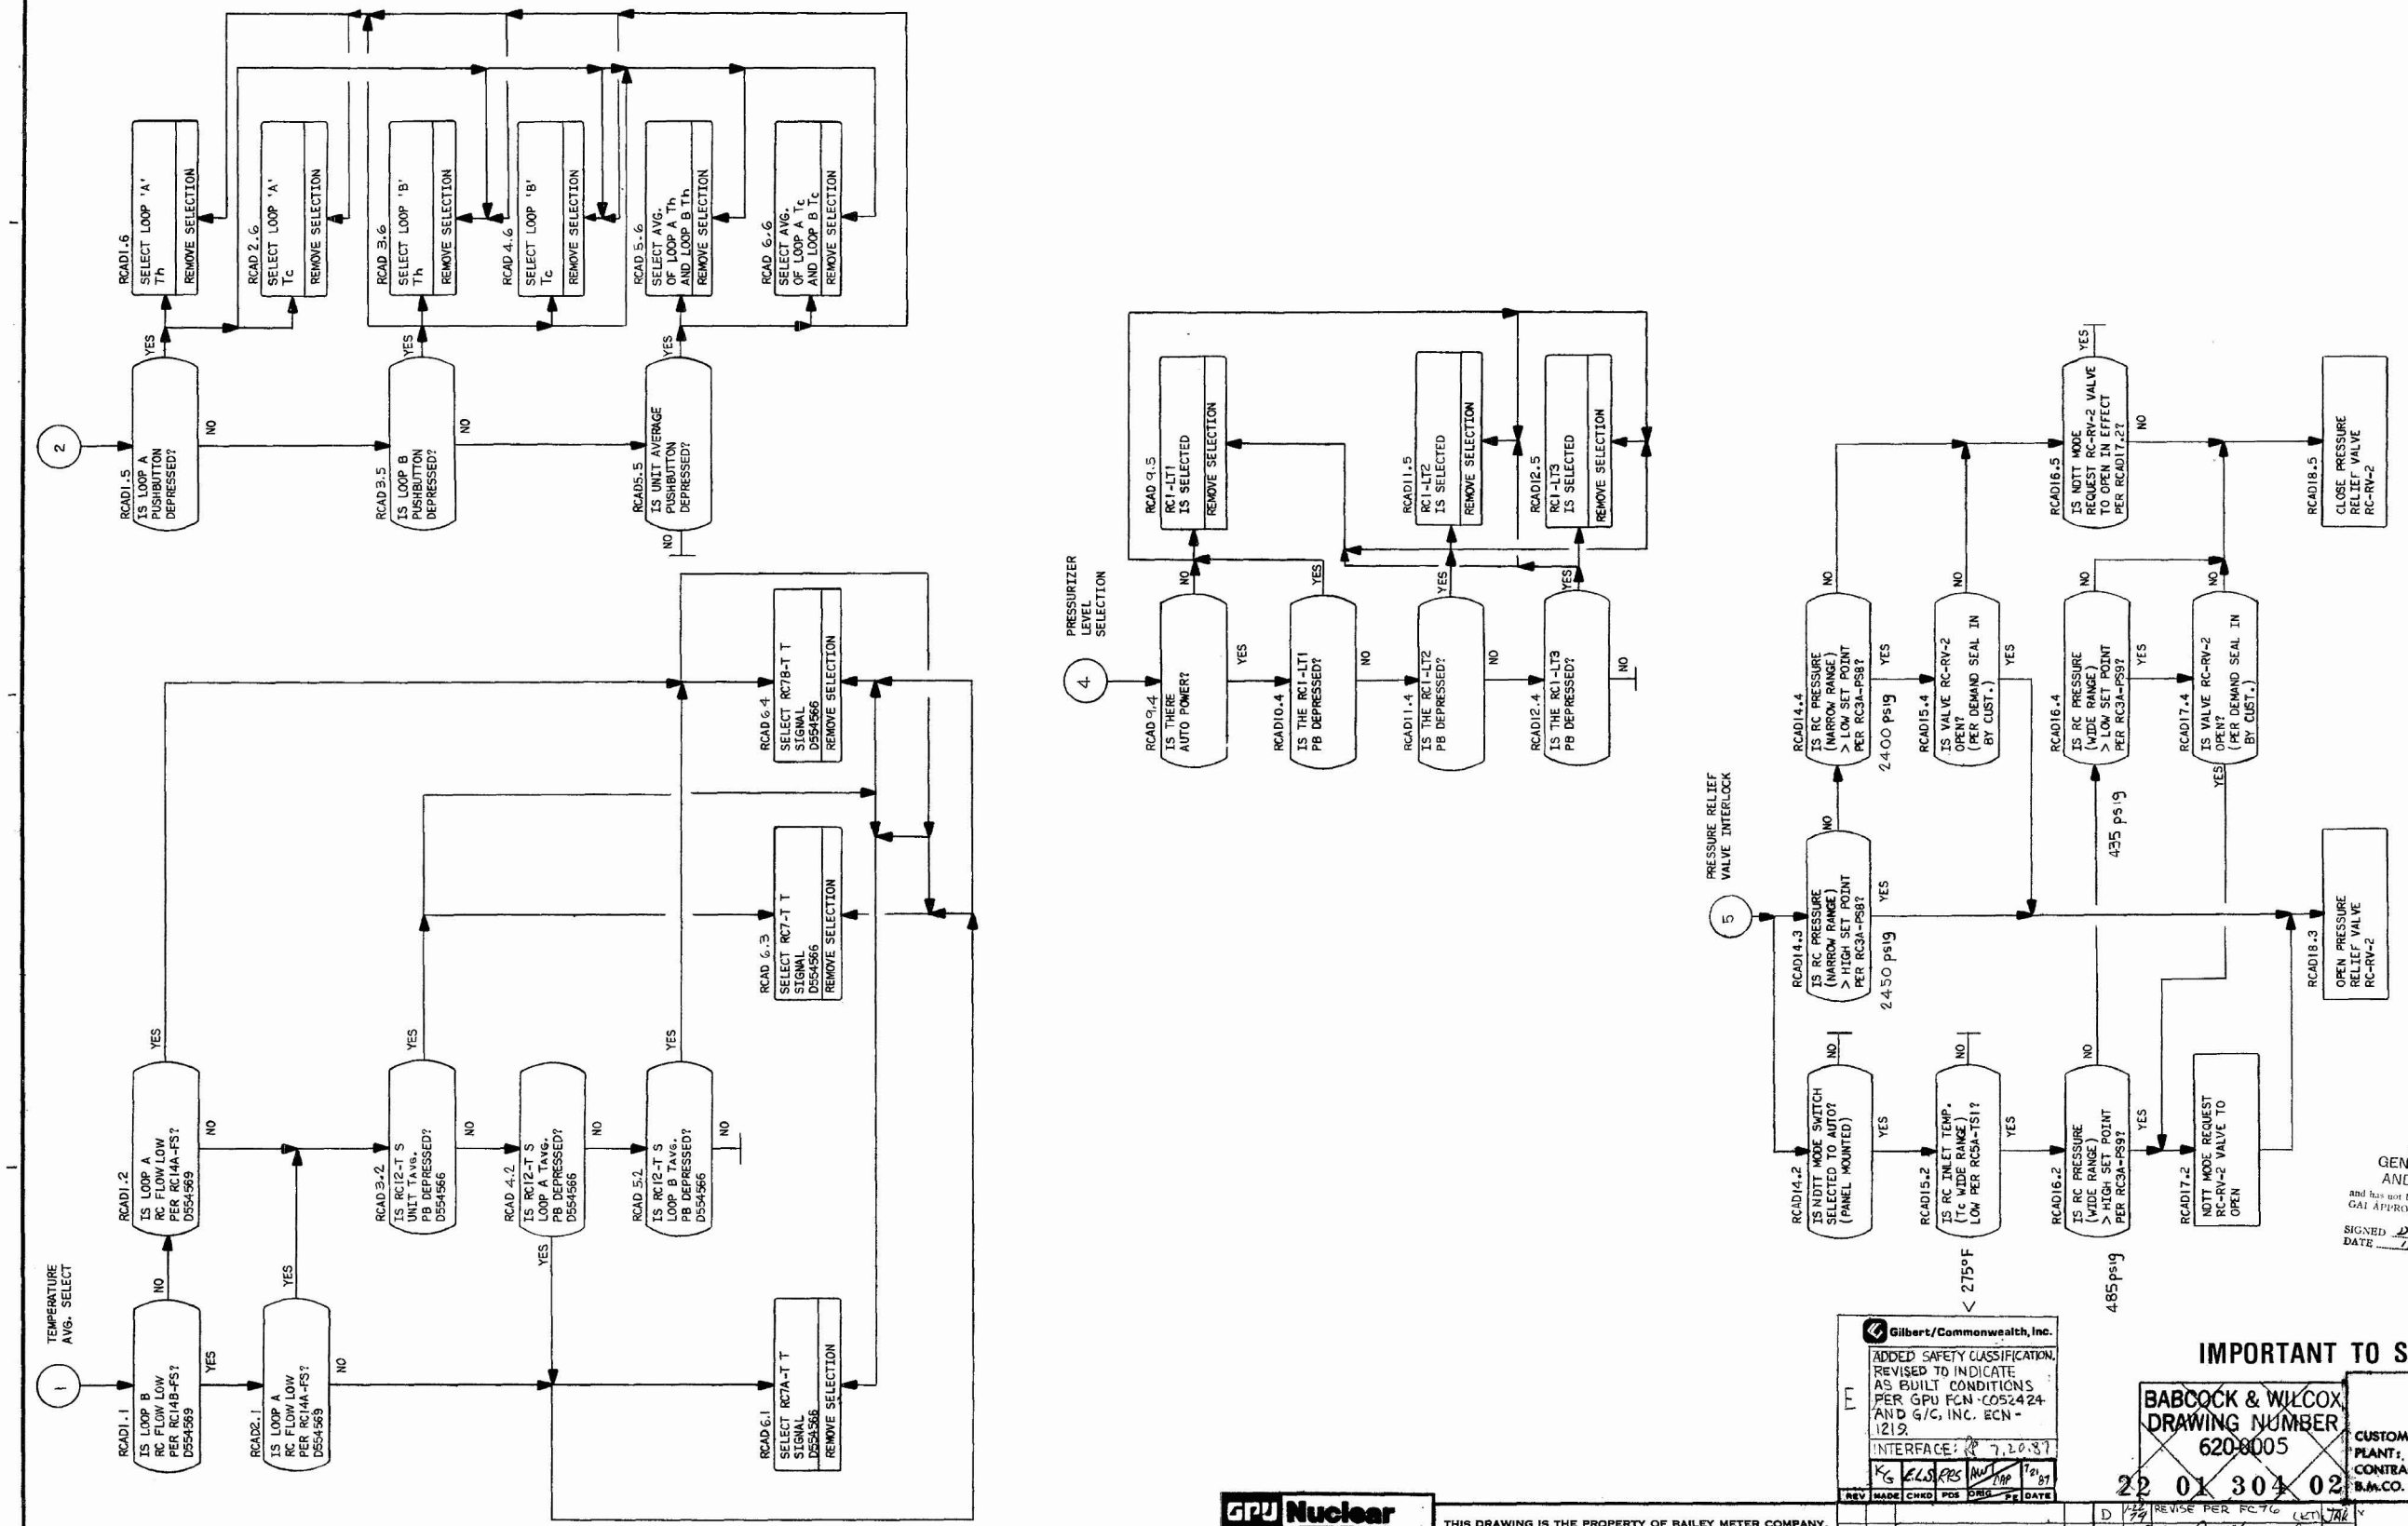

ADMIN. CHANGE-LEGIBILITY PROGRAM BY GPUN

H | EML | PE | B | 9/18/73 | REV | MADE | CHKD | POS | ORIG | PE | DATE

Gilbert/Commonwealth, Inc.

G | REVISED TO INDICATE AS BUILT CONDITIONS PER GPU DCN-C073818 & G/C, INC. ECN-1495 | INTERFACE: N/I | TAR | RJH | 7/10 | - | 9/19/73 | REV | MADE | CHKD | POS | ORIG | PE | DATE

RECEIVED
U. E. & C. INC.
JUN 21 1974
ENGINEERING DEPARTMENT

THIS DRAWING IS FOR GENERAL INFORMATION AND REFERENCE ONLY and has not been returned to the manufacturer with GAI APPROVAL or COMMENTS
SIGNED D Shelly ENGINEER
DATE 11/8/73 RKJB

0-LIH-33-2094

AS-BUILT DRAWING

IMPORTANT TO SAFETY

Gilbert/Commonwealth, Inc.

ADDED SAFETY CLASSIFICATION. REVISED TO INDICATE AS BUILT CONDITIONS PER GPU FCN-C052424 AND G/C, INC. ECN-1219.
INTERFACE: 7,20,87
KG | ELS | RBS | MAT | MP | PE | 87 DATE
REV | MADE | CHKD | POS | ORIG | PE | DATE

BABCOCK & WILCOX DRAWING NUMBER 620-0005
22 01 304 02

AUXILIARY SYSTEM
DIGITAL LOGIC
TEMPERATURE LOOP
CUSTOMER: METROPOLITAN EDISON CO.
PLANT: 3 MILE ISLAND NUCLEAR STATION
CONTRACTING ENG.: GILBERT ASSOCIATES, INC.
B.W.CO. JOB NO.: 1501 CUST. ORDER NO. A290621,620-0005

GPU Nuclear
F | ADMINISTRATIVE REV. REVISED FOR CLARITY | MJS | 7/2/87 | CHKD | APPROVED | DATE | LPF
REV | MADE | CHKD | APPROVED | DATE | LPF

THIS DRAWING IS THE PROPERTY OF BAILEY METER COMPANY. NEITHER THE DRAWING, NOR REPRODUCTIONS OF IT, NOR INFORMATION DERIVED FROM IT IS TO BE GIVEN TO OTHERS, NO USE IS TO BE MADE OF IT WHICH IS OR MAY BE INJURIOUS TO BAILEY METER COMPANY.

REV	DATE	CHANGE	APVD
D	10-4-74	REVISE PER FCN76	TAR
C	10-4-74	REV PER MP	TAR
B	6-25-69	REDRAWN	TAR

BAILEY METER COMPANY
WICKLIFFE, OHIO

DATE 6-25-69 | REV H | D556139

DWN FB | CHKD | APVD | ENGR SS