GENERAL ELECTRIC 761E791TY

ELEM DIAG
REACTOR RECIRCULATION SYSTEM

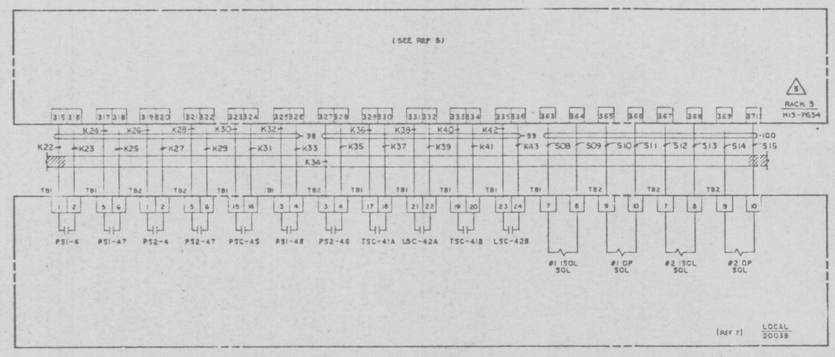

HYDRAULIC POWER UNIT
"B"
CKT 2RCS010

GE incorrectly incorporated the ckt no, please revise as shown.

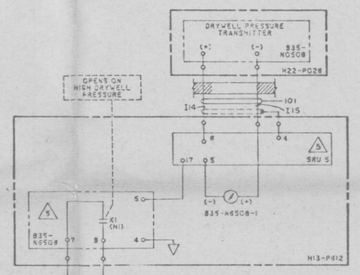

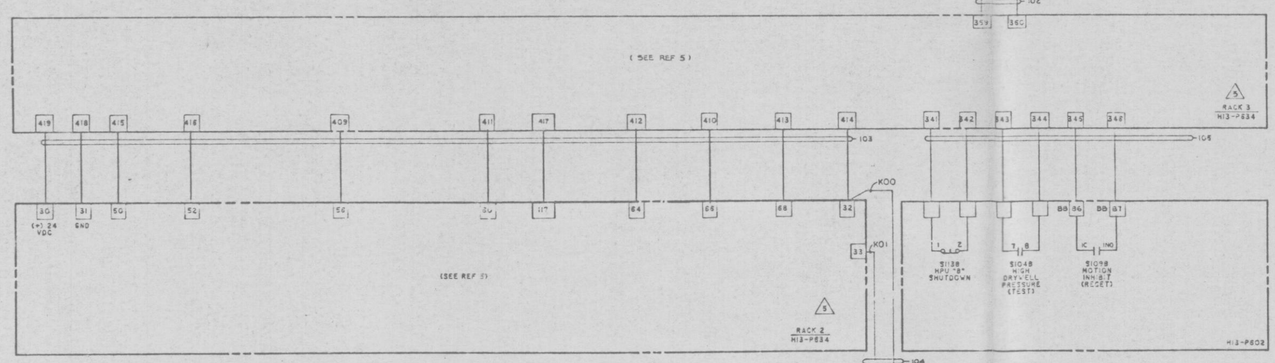

HPU CONTROL INTERFACE AND INTERLOCKS

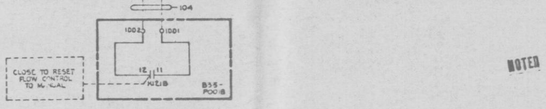

D

PRC APERTURE CARD

NOTED MAY 01 1981 G. K. Bagherian

LINE CODES: 98-105

REVISIONS		PRINTS TO
2		
1		
NEW 2-7		
CHK'D BY		

DRAWN	NED			761E791TY
CHECKED			SAN JOSE	
CARD BY: V. BURT				CI

STONE & WEBSTER ENGINEERING CORPORATION
NINE MILE POINT NUCLEAR STATION - UNIT 2
NIAGARA MOHAWK POWER CORPORATION
J.O. 12177

MANUFACTURER'S DRAWING DATA FORM

NAME: RESP. ENG. S. MEHTA (E1); RESP. D.L.S. ENG. C. LANE (E1)

✓ INSTRUCTIONS TO SUPPLIER (E2)
✓ Comments as noted
APPROVED / APPROVED AS REVISED / RELEASED FOR FABRICATION / RELEASED FOR MATERIAL PURCHASE — AS DEFINED IN SPECIFICATION
SUPPLIER TO RESUBMIT — QNTY: REVISED PRINTS; REVISED MICROFILM APERTURE CARDS
FOR REVIEW / FOR RECORD / NONE REQUIRED
NOTES:

✓ INSTRUCTIONS TO DESIGN (E1)
I-O INFORMATION ONLY
P-L PRELIMINARY LAYOUT
P-S PRODUCTION STUDIES
✓ R&C REVIEW AND COMMENT
F-D FINAL DETAILS
NEW NEW
✓ REV. REVISED

DATE TO DESIGN (C) 3/3/81 — REQUIRED RETURN DATE (E1) 3/24/81

(E1) ✓ FOR INFORMATION ONLY RETURN TO SUPPLIER NOT REQUIRED

INSTRUCTIONS TO DESIGN (CIRCLE (E1)): I-O | P-L | P-S | R&C | F-D | NEW | REV.

DESIGN ENGINEER'S DATE STAMP (D) IN: NOTED MAR 3 1981 C. A. LANE

DESIGN ENGINEER'S DATE STAMP (D) OUT: NOTED MAR 11 1981 C. A. LANE

INITIALS OF SELECTED REVIEWERS: GKB, AG, SH, EJH, JD

RESPONSIBLE ENGINEER'S DATE STAMP (E2) NOTED APR 30 1981 S. MEHTA

3 — SUPERSEDES S&W FILE NO. (E1) (25-34) (35-38): 1001 2711 3101 L029A
REMARKS (C) (LIMIT TO 22 CHARACTERS & BLANKS) (53-74): T-1076

2 — S&W EQUIP. I.D. CODE (E1) (25-36): 21ACS — AREA DESIGNATION CODES (E1) (75-80): A
MFR'S. DWG. NO. (C) (LIMIT TO 24 CHARACTERS & BLANKS) (37-60): 761E791TY, SH. 14, REV 2
MFR'S. NAME (C) (LIMIT TO 20 CHARACTERS & BLANKS) (61-80): GENERAL ELECTRIC

1 — DATE RECD (C): 03 25 81 — DWG TYPE (E1): C — (31) MAX DAYS IN DESIGN (E1): 21 — (32-33)
FUNCTIONAL TITLE (E1) (LIMIT TO 44 CHARACTERS & BLANKS) (37-80): REACTOR RECIRC SYS ED

DUP — S&W FILE NO. (E1) (11-20): 1001 2711 3101 L029B — (21-24)
JOB ORDER NO. 12177 — 00 (25-30)

DESIGN GROUP ROUTING (D)

ROUTE ✓		REQUIRED PRINT	REQUIRED MAC	RVW *
	ARCHITECTURE			
	CIVIL			
	CONCRETE			
	STEEL			
	BUILDING SERVICE			
	INSTRUMENT			
	MECHANICAL			
	PIPE SUPPORT			
	STRESS			
	MACHINE DESIGN/VESSEL			
	ELECTRICAL			
	LIGHTING			
	MODEL SHOP			
	EXTENSION OFFICE			
	CONTROL			

NOTED MAR 3 1981 C. A. LANE

(C) PROJECT CLERK
(D) RESP. DESIGN ENGINEER
(E1) RESP. ENGINEER-ON DWG RECEIPT
(E2) RESP. ENGINEER-AFTER DWG REVIEW
MAC-MICROFILM APERTURE CARD
* RVW-REVIEWER INITIALS

(M) ATTACH TO MFR'S. DRAWING