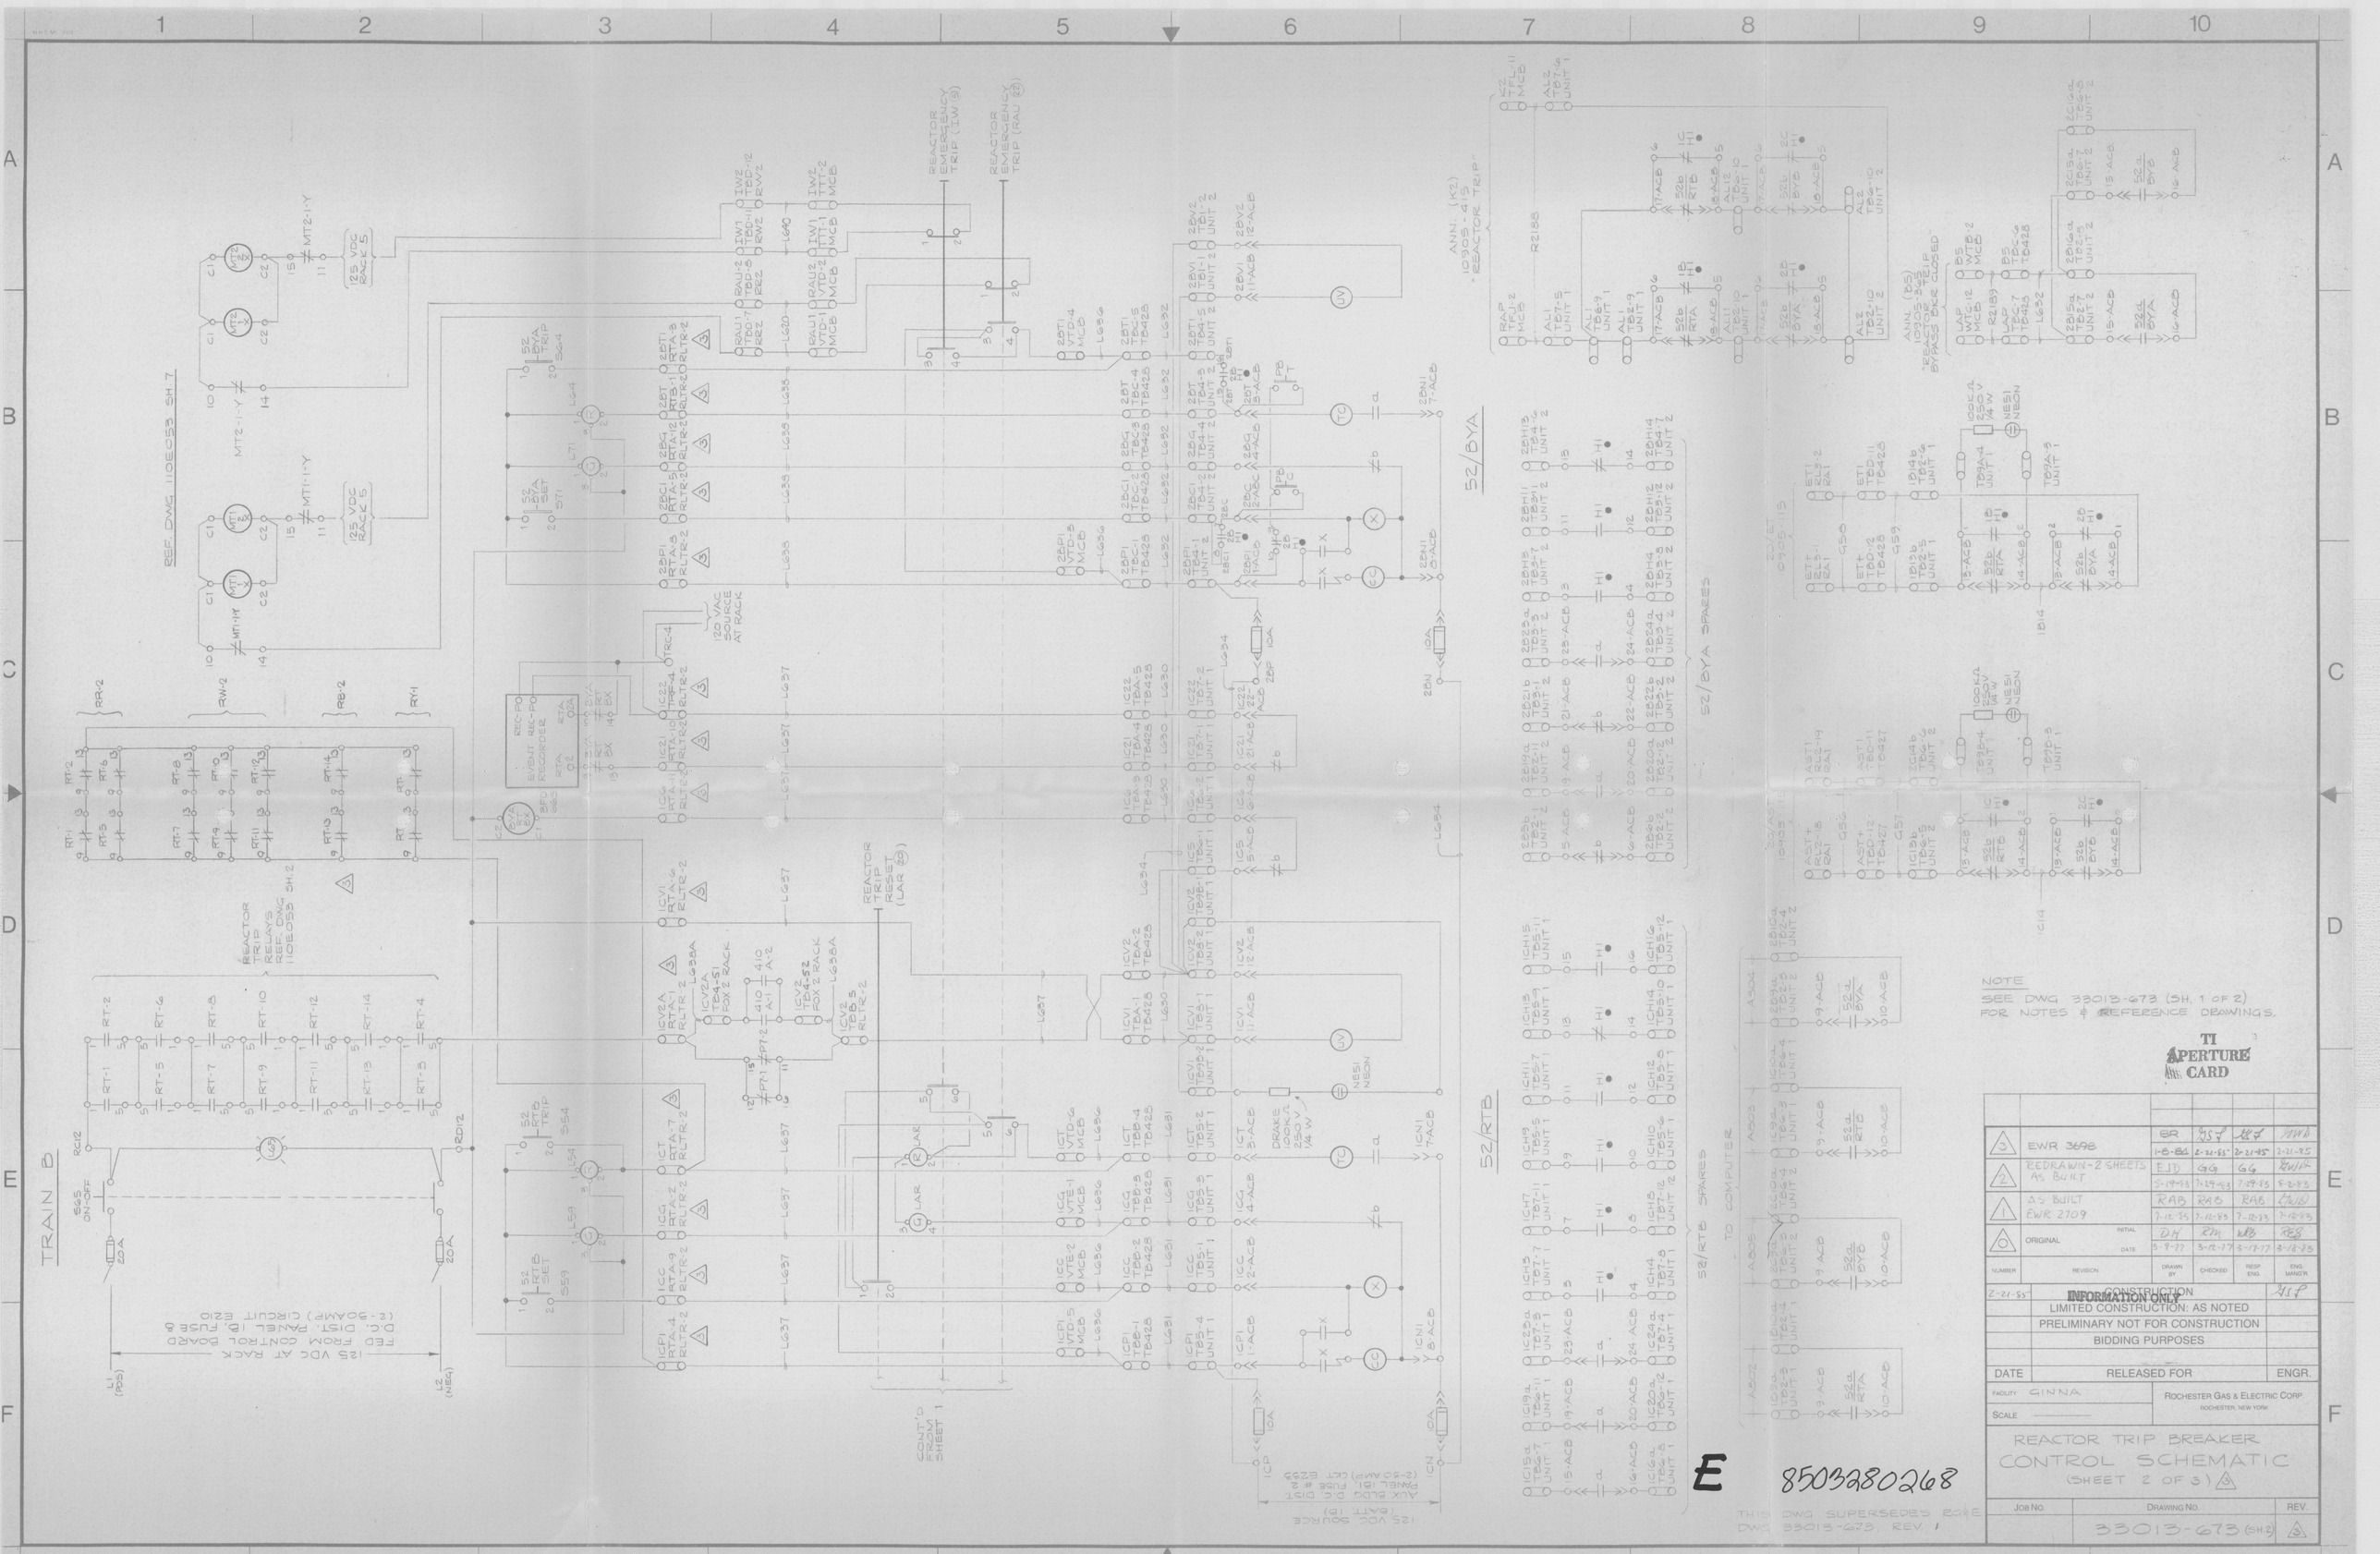


NOTE
SEE DWG 33013-673 (SH. 1 OF 2) FOR NOTES & REFERENCE DRAWINGS.

TI APERTURE CARD

| NUMBER | REVISION | DRAWN BY | CHECKED | RESP. ENG. | ENG. MANG'R. |
|---|---|---|---|---|---|
| 3 | EWR 3698 | BR 1-8-84 | GSF 2-21-85 | GSF 2-21-85 | GWD 2-21-85 |
| 2 | REDRAWN-2 SHEETS AS BUILT | EJD 5-19-83 | GG 7-29-83 | GG 7-29-83 | GWD 8-2-83 |
| 1 | AS BUILT EWR 2709 | RAB 7-12-83 | RAB 7-12-83 | RAB 7-12-83 | GWD 7-12-83 |
| 0 | ORIGINAL INITIAL / DATE | DH 3-9-77 | RM 3-12-77 | WB 3-17-77 | REG 3-18-83 |

2-21-85 CONSTRUCTION GSF

INFORMATION ONLY
LIMITED CONSTRUCTION: AS NOTED
PRELIMINARY NOT FOR CONSTRUCTION
BIDDING PURPOSES

DATE | RELEASED FOR | ENGR.

FACILITY GINNA
SCALE

ROCHESTER GAS & ELECTRIC CORP.
ROCHESTER, NEW YORK

REACTOR TRIP BREAKER
CONTROL SCHEMATIC
(SHEET 2 OF 3) 3

JOB NO. | DRAWING NO. 33013-673 (SH.2) | REV. 3

E

8503280268

THIS DWG SUPERSEDES RG&E DWG 33013-673, REV. 1