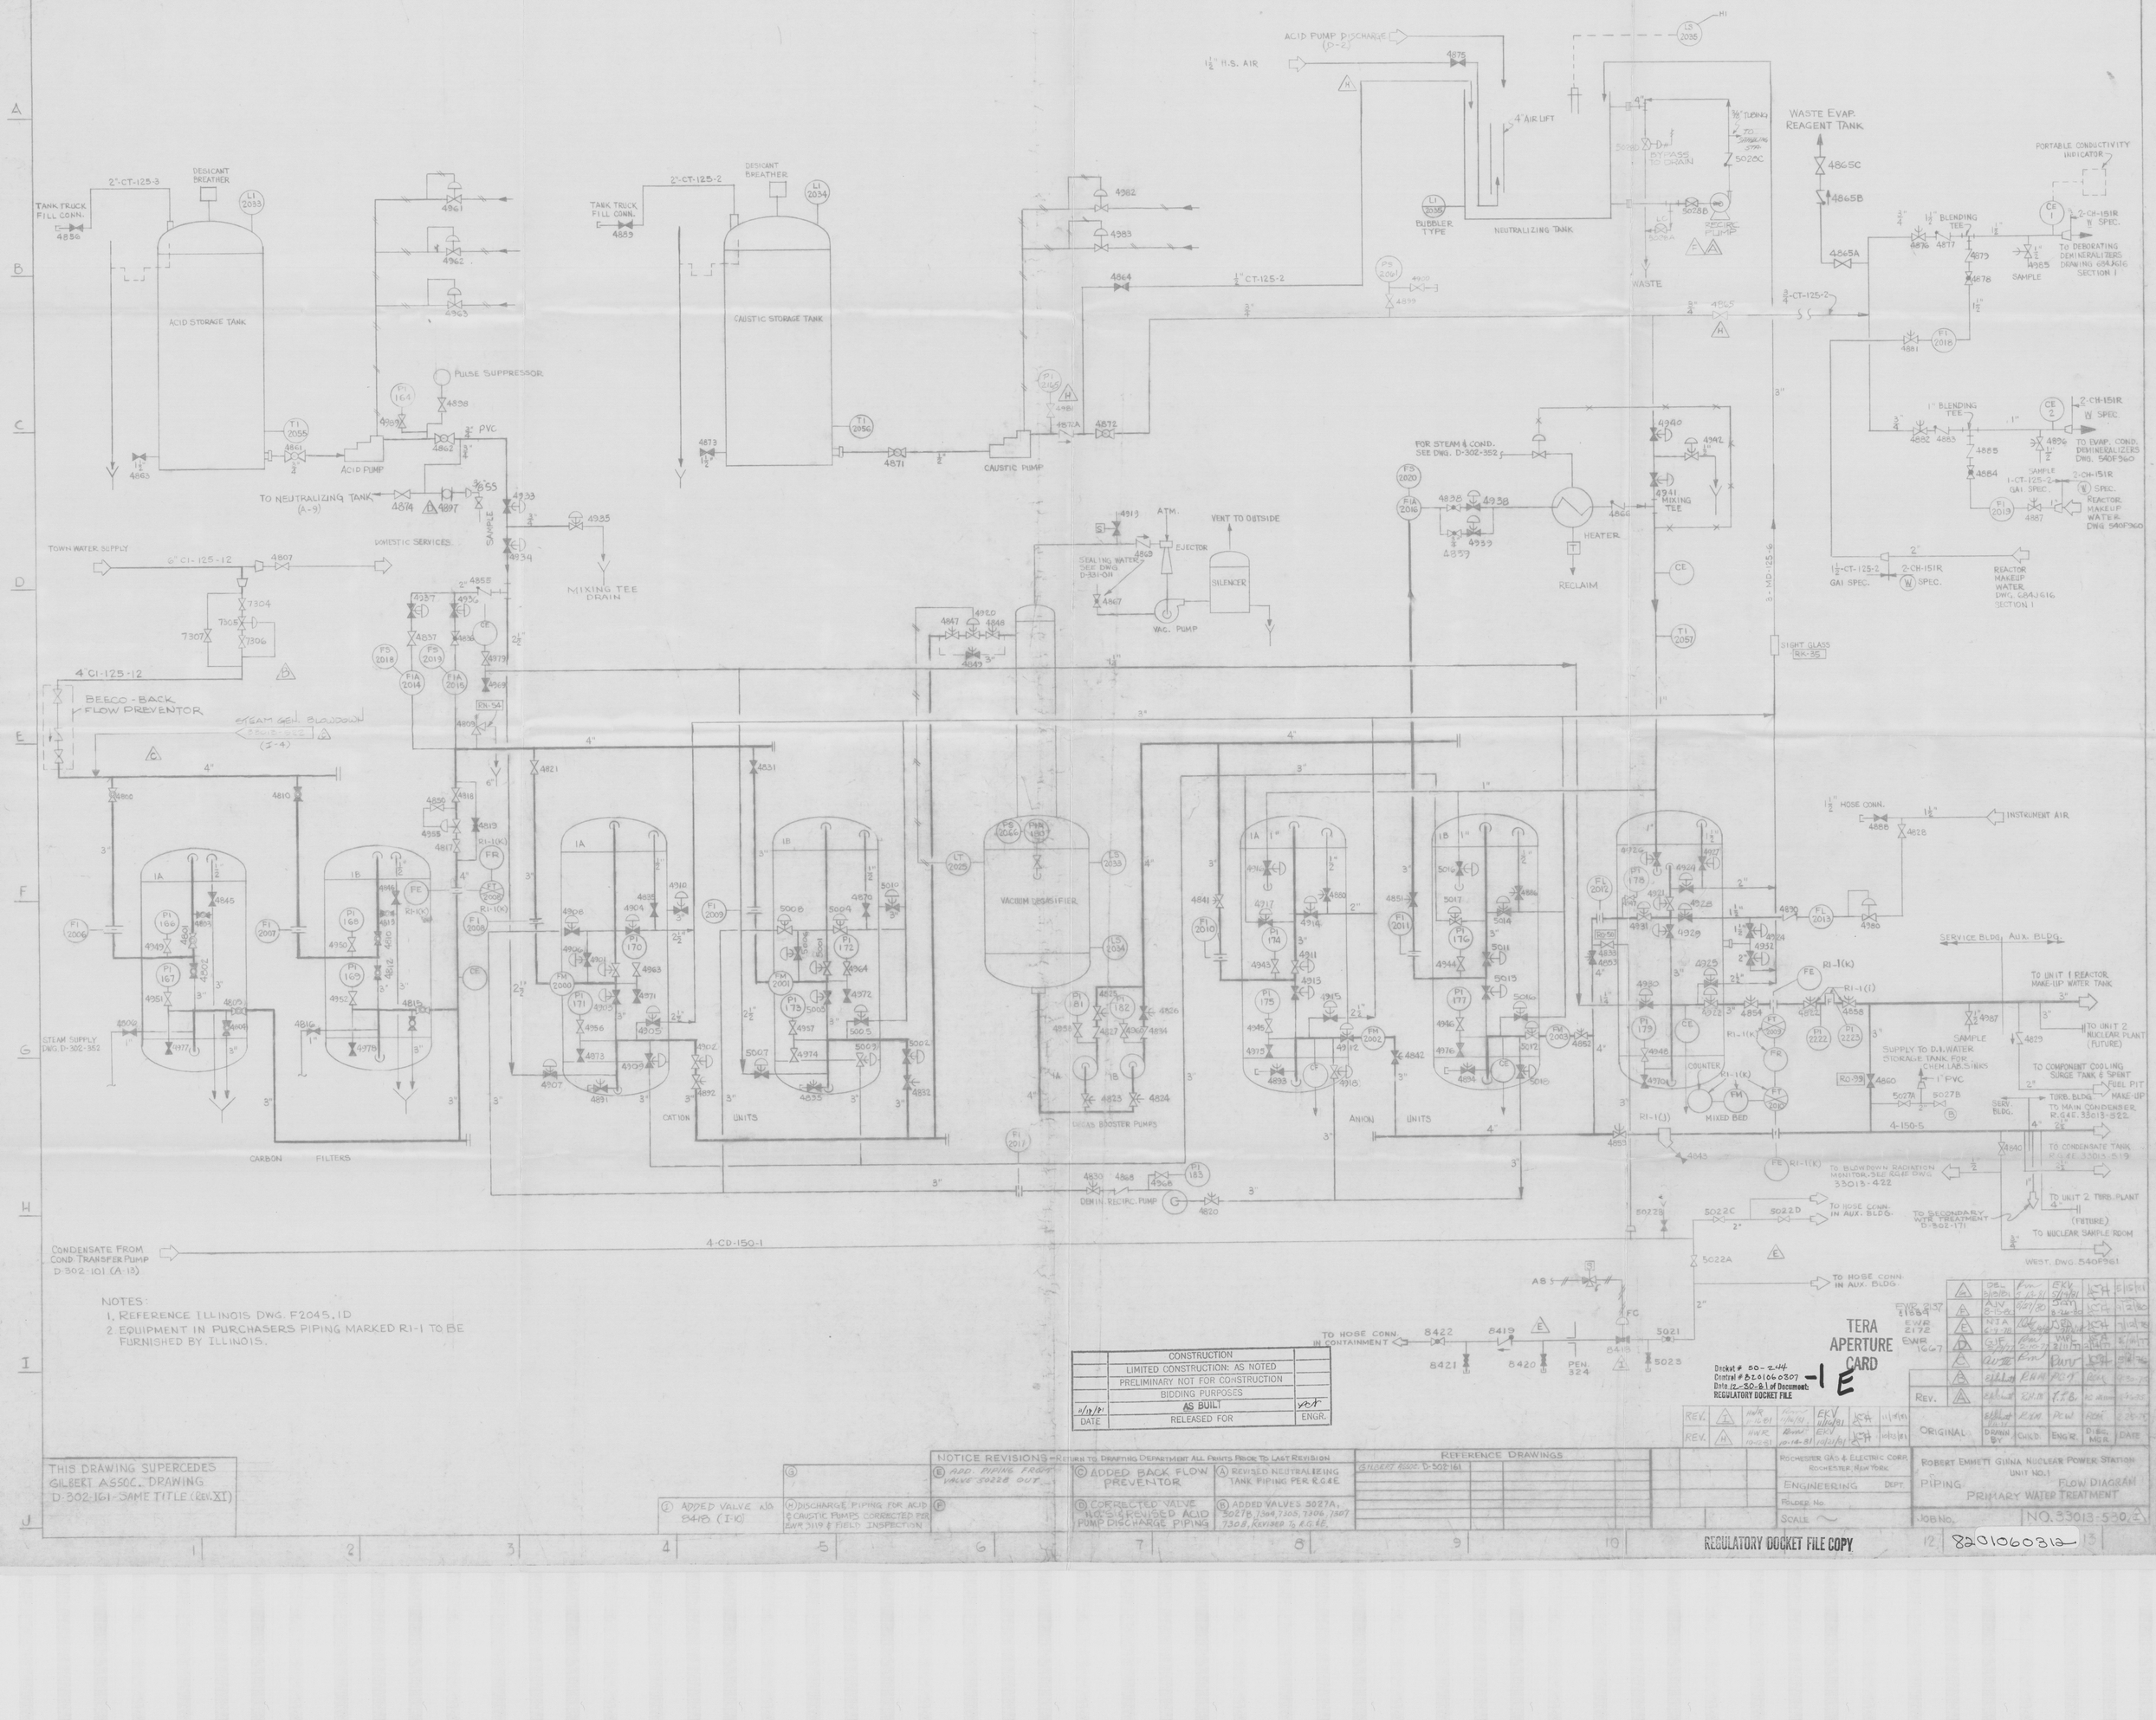

NOTES:
1. REFERENCE ILLINOIS DWG. F2045, ID
2. EQUIPMENT IN PURCHASERS PIPING MARKED RI-1 TO BE FURNISHED BY ILLINOIS.

	CONSTRUCTION	
	LIMITED CONSTRUCTION: AS NOTED	
	PRELIMINARY NOT FOR CONSTRUCTION	
	BIDDING PURPOSES	
11/19/81	AS BUILT	
DATE	RELEASED FOR	ENGR.

REV.	DESCRIPTION	DR.	CH'K.	ENG'R.	PROJ. MGR.	DATE
E	ADD. PIPING FROM VALVE 5022B OUT					
D	CORRECTED VALVE NOS. & REVISED ACID PUMP DISCHARGE PIPING					
C	ADDED BACK FLOW PREVENTOR					
B	ADDED VALVES 5027A, 5027B, 7304, 7305, 7306, 7307, 7308, REVISED TO R.G.&E.					
A	REVISED NEUTRALIZING TANK PIPING PER R.G.&E.					
REV.						
ORIGINAL		DRAWN BY	CH'K'D.	ENG'R.	DIST. MGR.	DATE

NOTICE REVISIONS - RETURN TO DRAFTING DEPARTMENT ALL PRINTS PRIOR TO LAST REVISION

(G) (F) (I) ADDED VALVE NO. 8418, (I-10) (H) DISCHARGE PIPING FOR ACID & CAUSTIC PUMPS CORRECTED PER EWR 3119 & FIELD INSPECTION

THIS DRAWING SUPERCEDES GILBERT ASSOC. DRAWING D-302-161-SAME TITLE (REV. XI)

REFERENCE DRAWINGS: GILBERT ASSOC. D-302-161

ROCHESTER GAS & ELECTRIC CORP. ROCHESTER, NEW YORK
ENGINEERING DEPT.
FOLDER No.
SCALE

ROBERT EMMETT GINNA NUCLEAR POWER STATION UNIT NO. 1
PIPING FLOW DIAGRAM PRIMARY WATER TREATMENT
JOB NO. NO. 33013-530, E

REGULATORY DOCKET FILE COPY

8201060312

TERA APERTURE CARD

Docket # 50-244
Control # 8201060307
Date: 12-30-81 of Document:
REGULATORY DOCKET FILE

-1 E