DR. NO. 1-5731

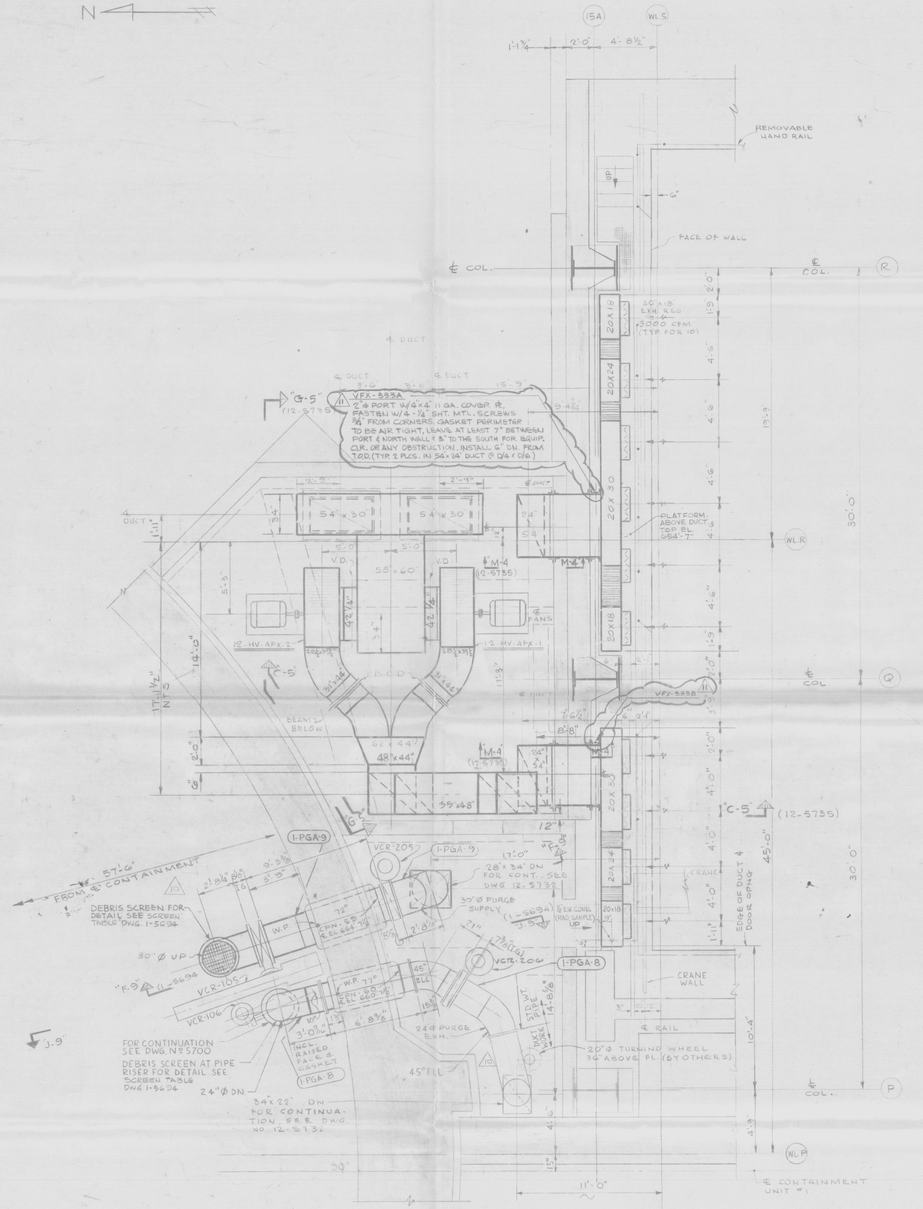

PLAN - EL. 650'-0"

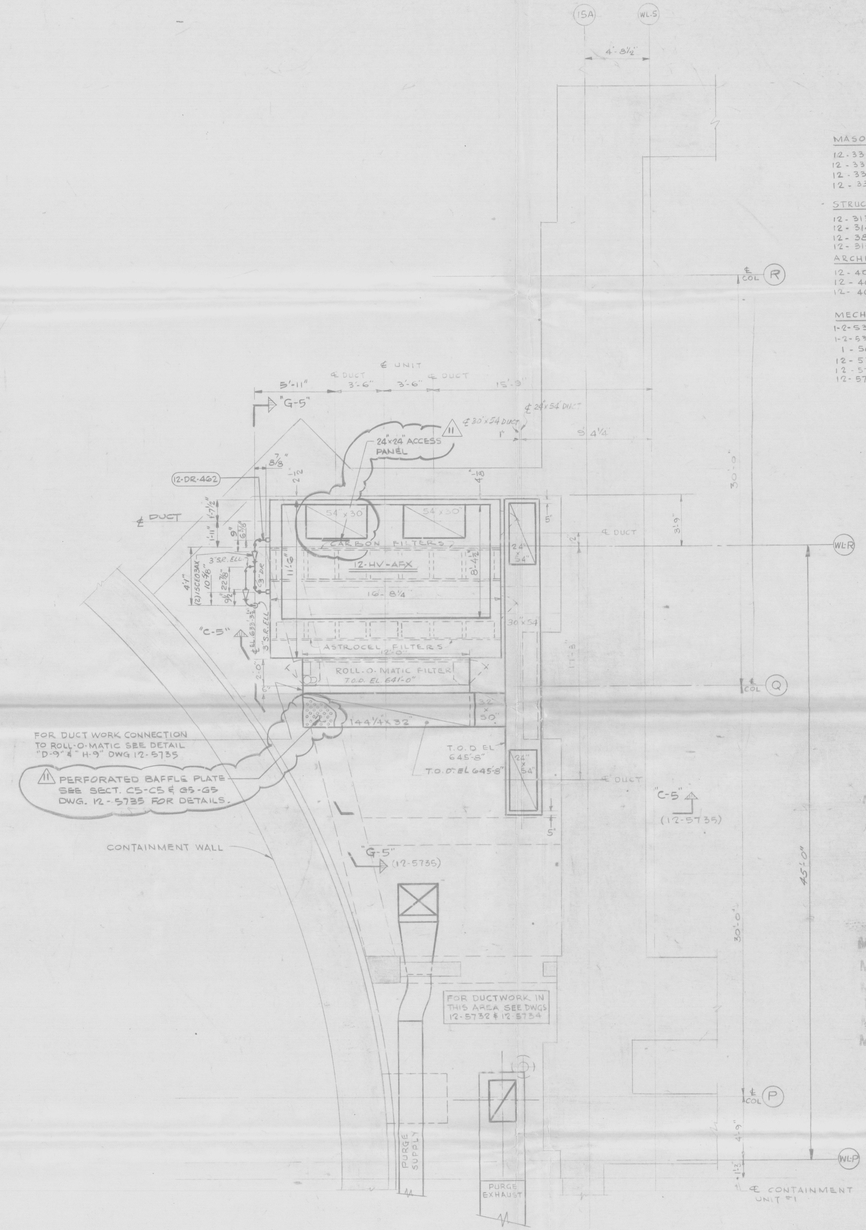

PLAN - EL. 633'-0"

GENERAL NOTES
SEE 12-5713

REFERENCE DRAWINGS

MASONRY (S&L)

12-3324 - AUX BLDG FL. PLAN - EL 633'-0 EAST PORTION
12-3330 - " " " " EL 650'-0" " "
12-3356 - " " MISC. SECTION - SHEET #5
12-3358 - " " SECTION A7-A7

STRUCTURAL

12-3139 - AUX. BLDG. VERT. BRAC. ELEV. - COL. "11B", "1" & "J"
12-3140 - " " " " COL. "16B" & TYP. BLDG. FR.
12-3809 - PURGE AIR EQUIP. & ICE MACH. RM. SECTS & DET.
12-3159-B AUX. BLDG. PLATFORM @ EL. 654'-7"

ARCHITECTURAL

12-4030 - PLANS EL 633'-0, 650'-0" EAST END AUX BLDG
12-4031 - PLAN EL 650'-0 WEST END AUX BLDG
12-4032 - ROOF PLAN - AUX. BLDG. - TURBINE ROOM

MECHANICAL

1-2-5351 - ARRT - CONT'MT & AUX BLDG FUEL HAND. AREA
1-2-5358 - " " " " " " " " SECT.
1 - 5671 - HRV - TAB. OF FANS, BLOWERS & MOTOR, DAMPERS
12-5338 - CONT'MT UNITS #1-2 PENET. DETS CONT'MT WALL
12-5720 - HRV BLDG FLOOR EL 650'-0 & EL 633'-0
12-5739 - EQUIP. ANCHOR INSERT. LOC., FL. EL 633'-0

FOR REFERENCE ONLY
NOT A CONTROLLED COPY

DATE	NO.	DESCRIPTION	APPD.
7/11/86	11	TO REFLECT AS BUILT CONDITIONS PER RFC-12-4056 PER UNIQUE #602894 ADDED TEST PORTS IN 54"x24" DUCT @ DWG & G/6 TO REFLECT AS-BUILT CONDITIONS FOR RFC DC-12-4057 PER UNIQUE #602895 ADDED ACCESS PANEL TO 54"x30" DUCT @ K/4 PER RFC EC-12-1966 THIS ISSUE IS FOR AS-BUILT INFO. ONLY. ADDED PERFORATED BAFFLE PLATE TO AFX DUCT @ K/5 PER INFO. SHOWN ON DWG. CO-1-5731-10-1 DWM/MB	JLW
6/14/82	10	PER RFC-DC-12-1827 REVISED PURGE AIR PIPING TO ACCOMMODATE SUBSTITUTE VALVES VCR-205, 206 & 105 & B/T CITIZEN'S RFC E.D.	MF
3/7/80	9	ADDED DUCTWORK OVER DUCTWORK AS PER RFC-DI-1795	MF
9-20-78	8	ADDED DEBRIS SCREEN @ B/T PER RFC DI-1354	MF
8/1/77	7	AS PER RFC-DC-12-1816-1 ADDED 3" DR. PIPING & RELATED VALVING @ K/5, K/6	MF
5-11-77	6	PER RONTEC-12-590 ADDED ℄ 65' SAMPLE CONN. (RAD. SAMPLE) @ A/7	MF
3-2-73	5	CORRECTED WALL THICK. & CONT. WORK TO SUIT 9'-9" OC.	MF
11-7-72	4	REVISED DWG. NO. 12-5731 TO 1-5731	MF
8-8-72	3	REVISED DUCT SIZES IN 'G' LEVEL (LIKE) & TO FIX POSITION (CO)	MF
6-13-72	2	REVISED & ADDED DUCTWORK PER RONTEC DWG. 590	MF
3-20-72	1	ADDED LINE DESIGNATIONS & REVISED & RELOCATED DUCTWORK D/A	MF

REVISIONS

"THIS DRAWING IS THE PROPERTY OF THE AMERICAN ELECTRIC POWER SERVICE CORP. AND IS LOANED UPON CONDITION THAT IT IS NOT TO BE REPRODUCED OR COPIED, IN WHOLE OR IN PART, OR USED FOR FURNISHING INFORMATION TO ANY PERSON WITHOUT THE WRITTEN CONSENT OF THE AEP SERVICE CORP., OR FOR ANY PURPOSE DETRIMENTAL TO THEIR INTEREST, AND IS TO BE RETURNED UPON REQUEST"

INDIANA & MICHIGAN ELECTRIC CO.
DONALD C. COOK
NUCLEAR PLANT
BRIDGMAN MICHIGAN

HEATING & VENTILATING
AUXILIARY BUILDING
FLOOR EAST 633'-0 650'-0

DR. NO. 1-5731-11

ARCH. ELEC. MECH. STR.
SCALE 1/8"=1'-0"
DR. N H
CH. (EC)
2ND LOM 10/27
DATE 10-12-71
APPROVED BY
ENGINEERING DIV.
DESIGN DIV.
AMERICAN ELECTRIC POWER SERVICE CORP.
2 BROADWAY NEW YORK

ADM DATE 1-9-85 REV. NO. 10

LIST OF OPEN RFC'S
RFC-DC-12-1316
RFC-DC-12-1607

REGULATORY DOCKET FILE COPY

Docket # 50-315
Control # 8711250124
Date 11-23-87 of Document
REGULATORY DOCKET FILE

ITT APERTURE CARD

FOR SYMBOLS, DUCTWORK AND PIPING STANDARDS SEE AEP SERVICE CORP. DWGS GEM 1404 THRU 1412

8711250169 E