


999999999999

2VBB-UPS1A LOAD LIST

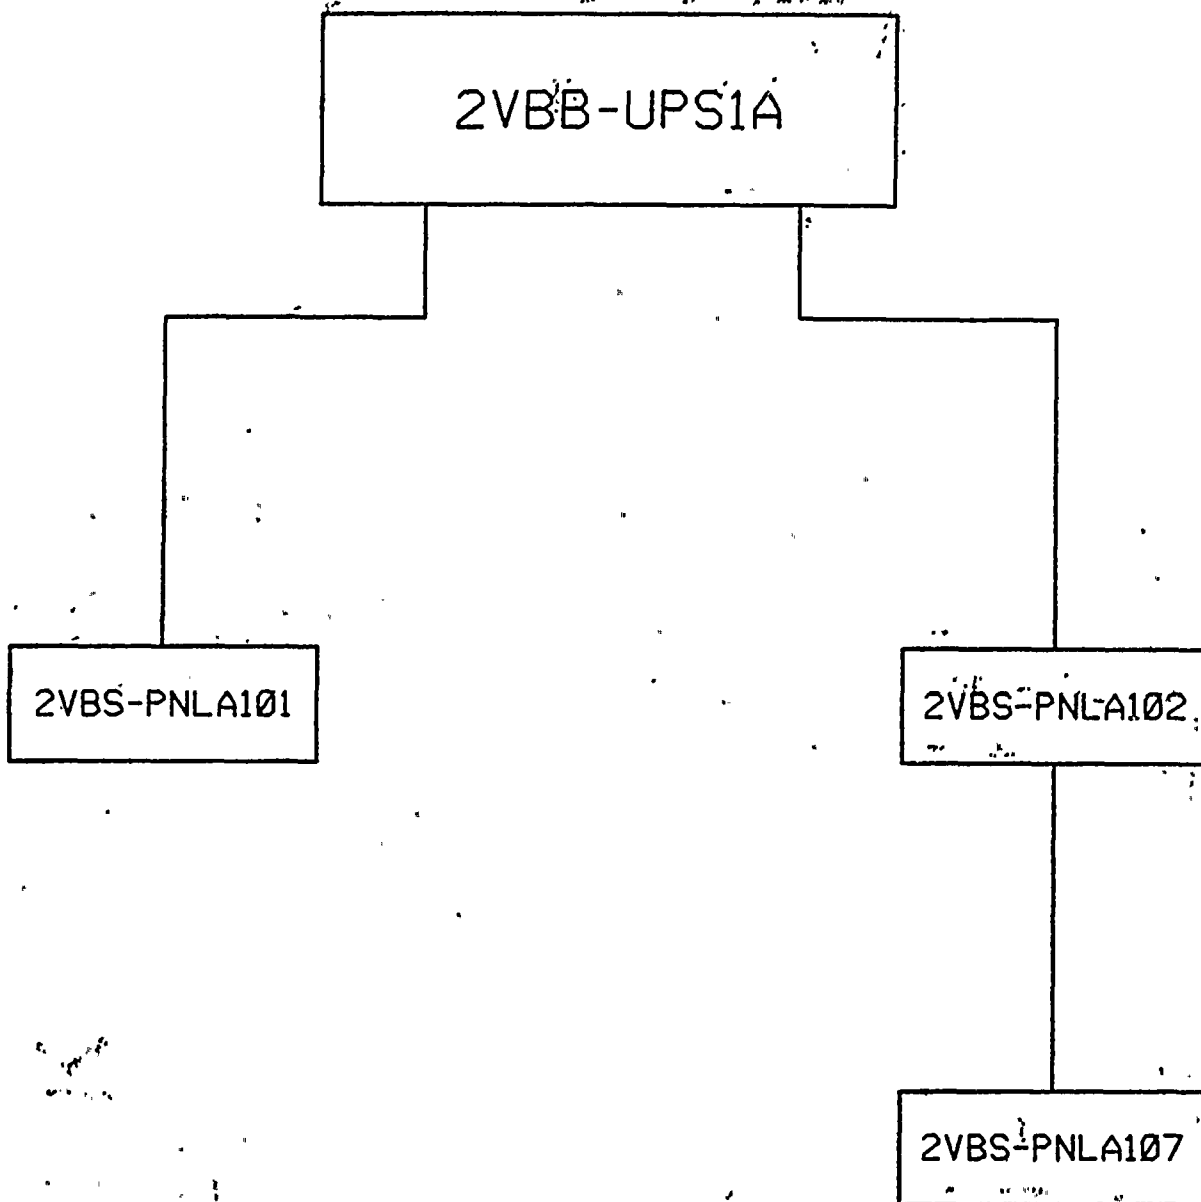

NOTE: THIS DRAWING WAS CREATED USING
COMPUTER AIDED DRAFTING
DO NOT MAKE MANUAL CHANGES

NUCLEAR NON-SAFETY RELATED

IN **NUCLEAR** **STATION** **-** **UNIT 2**
SCRIBA, N.Y.

LOAD LIST
UNINTERRUPTIBLE POWER SUPPLY
2VBB-UPS1A

SHEET 1 OF 117

SCALE NONE DRAWING NO AE-1000

1	9-11-91	JPH JEP	ORIGINAL ISSUE- AS BUILT	APB and	APP
REV	DATE	BY	DESCRIPTION	CK	APP

INDEX

PANEL	BKR. NO.	SHEET NO.
2VBS-PNLA101	1	4
	2	5
	3	6
	4	7
	5	8
	6	9
	7	10
	8	11
	9	12
	10	13
	11	14
	12	15
	13	16
	14	17-20
	15	21-24
	16	25-28
	17	29,30
	18	31,32,33
	19	34,35
	20	36,37
	21	38
	22	39
	23	40
	24	41
	25	42
	26	43
	27	44
	28	45
	29	46
	30	47
	31	48
	32	49
	33	50
	34	51
	35	52
	36	53
	37	54
	38	55

PANEL	BKR. NO.	SHEET NO.
2VBS-PNLA102	1	56,57,58
	2	59,60
	3	61
	4	62-66
	5	67-70
	6	71-74
	7	75-79
	8	80
	9	81
	10	82
	11	83
	12	84
	13	85
	14	86
	15	87
	16	88
	17	89
	18	90
	19	91
	20	92
	21	93
	22	94
	23	95
	24	96
2VBS-PNLA107	1	97
	2	98
	3	99
	4	100
	5	101
	6	102
	7	103
	8	104

(CONTINUED ON SHEET 3)

2VBB-UPS1A LOAD LIST
DWG. NO. AE-1000
SHEET 2 OF 117

INDEX (CONT'D)

PANEL	BKR. NO.	SHEET NO.
VBS-PNLA107	9	105
	10	106
	11	107
	12	108
	13	109
	14	110
	15	111
	16	112
	17	113
	18	114
	19	115
	20	116
	21	117
	22	117
	23	117
	24	117
	25	117
	26	117
	27	117
	28	117
	29	117
	30	117
	31	117
	32	117
	33	117
	34	117
	35	117
	36	117
	37	117
	38	117
	39	117
	40	117
	41	117
2VBS-PNLA107	42	117

[illegible]

2VBB-UPS1A LOAD LIST
DWG. NO. AE-100D
SHEET 3 OF 117

491 2500

100

10

1 4

1

23






■

•

22

2

4 22

4 49

•

•

•

[illegible]

61 62 63 10

UPS NO: 2VBB-UPS1A
PNL NO: 2VBS-PNLA101
BKR NO: 1
CIRCUIT NO: 2ADSN01

DRAWING REFERENCES

0007.212-001-021	0007.520-001-410
0007.212-001-031	0007.520-001-407
0007.212-001-054	EE-11J
0007.212-001-063	EE-3DS
	147D7828, SH. 2

[illegible]

UP81A

September 11, 1991

2VBB-UPS1A LOAD LIST
DWG. NO. AE-100D
SHEET 4 OF 117

1953

1	2	
---	---	---	---	---	---	---	---	---	----	----	-----

1954

1955

UPS NO: 2VBB-UPS1A
PNL NO: 2VBS-PNLA101
BKR NO: 2
CIRCUIT NO: N/A

DRAWING REFERENCES

EE-11J

FEED TO DEVICE	DEVICE LOCATION		PLANT IMPACT
	BLDG	ELEV	
SPARE			NONE

UPS1A

September 11, 1991

2VBB-UPS1A LOAD LIST
DWG. NO. AE-100D
SHEET 5 OF 117



UPS NO: 2VBB-UPS1A
PNL NO: 2VBS-PNLA101
BKR NO: 3
CIRCUIT NO: 2IHAA06

DRAWING REFERENCES

0007.521-001-731 EE-11J
EE-3DN ESK-10IHA42
ESK-10IHA43, 147D7844, SH. 2

[illegible]

UP81A

September 11, 1991

2VBB-UPS1A LOAD LIST
DWG. NO. AE-100D
SHEET 6 OF 117








DRAWING REFERENCES

7.520-001-355, 147D7848, 8H.2 ESK-11CEC01	7.520-001-357 7.520-001-347 EE-11J, EE-3DK
---	--



UP81A



2VBB-UPS1A LOAD LIST
DWG. NO. AE-100D
SHEET 7 OF 117





DRAWING REFERENCES

147D7848, SH. 2	EE-3DK
7.520-001-351	EE-11J
7.520-001-339	ESK-11CEC02
7.520-001-350	



UP81A



2VBB-UPS1A LOAD LIST
DWG. NO. AE-100D
SHEET 8 OF 117



EE-3AC
EE-11J
147D7834, SH. 2

UP81A

September 11, 1991

2VBB-UPS1A LOAD LIST
DWG. NO. AE-100D
SHEET 9 OF 117



UPS NO: 2VBB-UP81A

PNL NO: 2VBS-PNLA101

BKR NO: 7

CIRCUIT NO: 2RDSN08

DRAWING REFERENCES

7.520-001-924

EE-3AC

7.221-001-012

EE-11J

7.221-001-013

147D7834, 8H. 2

[illegible]

UP81A

September 11, 1991

2VBB-UP81A LOAD LIST

DWG. NO. AE-100D

SHEET 10 OF 117





2

EE-3BA

EE-11J

147D7845, 8H. 2

ESK-10IHA40, SH. 1&2



2VBB-UP81A LOAD LIST

DWG. NO. AE-100D

SHEET 11 OF 117





DRAWING REFERENCES

EE-3AC	EE-11J
7.520-001-933,	147D7834, SH.2
7.221-001-012	



UP81A



2VBB-UPS1A LOAD LIST
DWG. NO. AE-100D
SHEET 12 OF 117



100




































































DRAWING REFERENCES

EE-11J



2VBB-UP81A LOAD LIST

DWG. NO. AE-100D

SHEET 13 OF 117



13

14

15

16

17

18

19

20

21

22

23

24

25

26

27

28

29

30

31



DRAWING REFERENCES

EE-3DE	EE-11J
0007.520-001-350	
0007.520-001-338	
0007.520-001-337	
0007.221-001-010	
0007.221-001-011	
147D7826, SH. 2	



UP81A



2VBB-UPS1A LOAD LIST
DWG. NO. AE-100D
SHEET 14 OF 117





EE-4X, EE-11J
0007.510-001-271
0007.221-001-012
0007.221-001-038



2VBB-UPS1A LOAD LIST
DWG. NO. AE-100D
SHEET 15 OF 117



UPS NO: 2VBB-UPS1A
 PNL NO: 2VBS-PNLA101
 BKR NO: 13
 CIRCUIT NO: 2NMPN01

DRAWING REFERENCES

EE-11J	0007.224-001-070
EE-3DE	0007.224-001-055
147D7826, SH. 2	0007.224-001-021
7.520-001-350	0007.224-001-070
7.520-001-352	0007.212-001-012
7.224-001-020,035	
7.212-001-010,011,013	
1.764-001-021,026	

FEED TO DEVICE	DEVICE LOCATION		PLANT IMPACT
	BLDG	ELEV	
2CEC*PNL701 BAY A JB103	CCR	306	
C51B-W234			
2CEC*PNL603 C51-R602 C51-R603B C51-R603D C51-R603A C51-R603C B22-R613	CCR	306	LOSS OF POWER TO: SRM RECORDER IRM/APRM RECORDER IRM/APRM/RBM RECORDER IRM/APRM RECORDER IRM/APRM/RBM RECORDER JET PUMP INST RECORDER
2CEC*PNL603			LOSS OF POWER TO: APRM CHANNELS A THRU F STATUS LIGHTS, RBM CHANNELS A & B STATUS LIGHTS, FLOW UNIT A THRU D STATUS LIGHTS
2CEC*PNL602 B35-R614 G33-R613A G33-R613B	CCR	306	RECIRC FLOW RECORDER RWCU FILTER DEMIN INFLUENT RECORDER RX RECIRC INFLUENT A RECORDER
2CEC-PNL614 B22-R622	CCR	306	FEEDWATER TURBIDITY RECORDER

UPS1A

September 11, 1991

2VBB-UPS1A LOAD LIST
 DWG. NO. AE-100D
 SHEET 16 OF 117





1

EE-11J
147D7836, SH. 2
EE-3AG
EE-3A
0007.159-451-316
0007.159-451-314



2VBB-UPS1A LOAD LIST
DWG. NO. AE-100D
SHEET 17 OF 117



UPS NO: 2VBB-UPS1A
 PNL NO: 2VBS-PNL101
 BKR NO: 14

PLANT IMPACT: LOSS OF POWER TO 2CEC-PNL825

LOOP	PMS INDICATION	PMS ALARM	ERF INPUT	CR ANNUNCIATION	LOCAL ANNUNCIATION	CR INDICATION	LOCAL INDICATION	VALVE POSITION	DESCRIPTION/OTHER
2SWP-501 LSK-9-10T	X	X		X		X			DISCH BAY LEVEL
2SWP-502 LSK-9-10T	X	X		X		X			SERVICE WATER INTAKE LEVEL
2FWS-10B GE 807E160TY						X			MAIN FEEDWATER CONTROL LV10B POSITION INDICATION
2FWP-215 LSK-15-1.1B						X			FIRE HEADER DISCHARGE PRESS
2CNM-115 LSK-4-1.3K	X	X		X		X			CND BSTR PMPS SUCT HDR PR
2CNM-114 LSK-4-1.4	X	X		X		X		FO	CND PMP DISCH HDR FLOW/LOSS OF CONTROL OF FV114
2FWS-111 LSK-6-1.1F						X		FC	HIGH ENERGY FWCCU CONTROL/LOSS OF CONTROL OF HVX111, HVV111,HVZ111
2FWS-113 LSK-6-1.1F						X		FC	LOW ENERGY FWCCU CONTROL/LOSS OF CONTROL OF HVX113,HVV113
2FWS-40A LSK-6-1.1E	X					X			LOSS OF INDICATION OF REACTOR INLET PRESSURE
2FWS-109 LSK-6-1.1F	X					X			FWCCU FLOW INDICATION
2CNM-105 LSK-4-1.1J	X	X		X		X			CND PMPS DISCH HDR PRESS
2CNM-70A LSK-4-1.3K	X					X			FD WTR PMP P1A SUCT PRESS

UPS1A

September 11, 1991

2VBB-UPS1A LOAD LIST
 DWG. NO. AE-100D
 SHEET 18 OF 117

11
12
22

13

14

UPS NO: 2VBB-UPS1A
 PNL NO: 2VBS-PNLA101
 BKR NO: 14

PLANT IMPACT: LOSS OF POWER TO 2CEC-PNL825

LOOP	PMS INDICATION	PMS ALARM	ERF INPUT	CR ANNUNCIATION	LOCAL ANNUNCIATION	CR INDICATION	LOCAL INDICATION	VALVE POSITION	DESCRIPTION/OTHER
2DER-101 LSK-32-9D	X	X		X		X			DRYWELL EQUIPMENT DRAIN LEAKAGE
2FWS-55A,B GE 807E160TY						X			HIGH PRESSURE LOW FLOW CONTROL VALVE FVSSAB POSITION INDICATION.
2CCP-266 LSK-9-1D	X	X		X		X			RB CLOSE LOOP COOLING WATER FLOW TO DRYWELL UNIT COOLERS
2CNM-38A LSK-4-1.3K	X	X		X		X		FO	CONDENSATE BOOSTER PUMP P2A SUCTION FLOW; LOSS OF CONTROL OF FV38A
2CNM-68A LSK-6-3	X	X		X		X		FO	REACTOR FD PUMP 2FWS-P1A SUCTION FLOW/LOSS OF CONTROL OF 2FWR- FV2A
2CCP-135 LSK-9-1D	X	X		X					RB CLOSE LOOP COOLING WATER FLOW FROM DW UNIT COOLERS
2CNM-45A LSK-4-1.1J	X		X			X	X		CONDENSER CND1A VACUUM
2CNM-104 LSK-4-1.3K	X					X			CONDENSER BOOSTER PUMPS DISCH HDR PR
2CNM-138 LSK-4-1.3K	X					X			START-UP LVL CONTROL VALVE FLOW
2DER-123 LSK-32-9D	X	X		X		X			DW EQUIPMENT DRAIN PUMPS P3A&B FLOW

UPS1A

September 11, 1991

2VBB-UPS1A LOAD LIST
 DWG. NO. AE-100D
 SHEET 19 OF 117



UPS NO: 2VBB-UPS1A
 PNL NO: 2VBS-PNLA101
 BKR NO: 14

PLANT IMPACT: LOSS OF POWER TO 2CEC-PNL825

LOOP	PMS INDICATION	PMS ALARM	ERF INPUT	CR ANNUNCIATION	LOCAL ANNUNCIATION	CR INDICATION	LOCAL INDICATION	VALVE POSITION	DESCRIPTION/OTHER
2FWS-9A LSK-6-1.1D	X					X			2FWS-P1A PUMP DISCH PRESS
2HDL-4A LSK-4-2.1B	X					X		FC	4TH POINT HEATER 2CNM-E4A WATER LEVEL/LOSS OF CONTROL OF LV4A
2HDL-35A LSK-4-2.1C	X					X		FO	4TH POINT HEATER 2CNM-E4A DRAIN PUMP P1A FLOW/LOSS OF CONTROL OF FV35A
2HDL-41A LSK-4-2.1B	X					X			4TH POINT HEATER DRAIN PUMP P1A DISCHARGE PRESSURE
2MSS-238 PID-1G	X					X			MAIN STEAM PRESSURE INDICATION

UPS1A

September 11, 1991

2VBB-UPS1A LOAD LIST
 DWG. NO. AE-100D
 SHEET 20 OF 117





EE-11J
EE-3B
EE-3AF
0007.159-451-319
0007.159-451-317
147D7836, SH. 2



2VBB-UPS1A LOAD LIST
DWG. NO. AE-100D
SHEET 21 OF 117



UPS NO: 2VBB-UPS1A
 PNL NO: 2VBS-PNLA101
 BKR NO: 15
 PNL NO: 2VBS-PNLB101
 BKR NO: 16

PLANT IMPACT: LOSS OF POWER TO 2CEC-PNL826

LOOP	PMS INDICATION	PMS ALARM	ERF INPUT	CR ANNUNCIATION	LOCAL ANNUNCIATION	CR INDICATION	LOCAL INDICATION	VALVE POSITION	DESCRIPTION/OTHER
2CCP-126 LSK-9-L	X	X		X				FC	RB CLOSE LOOP COOLING WATER FLOW FROM REACTOR WATER CLEANUP HT EXCH. 2WCS-E3/LOSS OF CONTROL OF FV126LCW
2CCP-105 LSK-9-1L	X								RB CLOSE LOOP COOLING WATER BOOSTER PUMPS 2CCP- P3A, B & C DISCHARGE HDR FLOW
2CCP-107 LSK-9-1M	X					X			RB CLOSE LOOP COOLING WATER BOOSTER PUMPS DISCHARGE HEADER PRESSURE
2CCP-74B LSK-9-1D	X	X		X					RB CLOSE LOOP COOLING WATER FROM DRYWELL 2DRS- UC3B - TEMP
2CCP-24D LSK-9-1D	X	X		X					RB CLOSE LOOP COOLING WATER FROM DRYWELL 2DRS-UC2D- TEMP
2CCP-24B LSK-9-1D	X	X		X					RB CLOSE LOOP COOLING WATER FROM DRYWELL 2DRS-UC2B- TEMP
2CCP-30D LSK-9-1D	X	X		X					RB CLOSE LOOP COOLING WATER FROM DRYWELL 2DRS-UC1D- TEMP

UPS1A

September 11, 1991

2VBB-UPS1A LOAD LIST
 DWG. NO. AE-100D
 SHEET 22 OF 117



UPS NO: 2VBB-UPS1A
 PNL NO: 2VBS-PNLA101
 BKR NO: 15
 PNL NO: 2VBS-PNLB101
 BKR NO: 16

PLANT IMPACT: LOSS OF POWER TO 2CEC-PNL826

LOOP	PMS INDICATION	PMS ALARM	ERF INPUT	CR ANNUNCIATION	LOCAL ANNUNCIATION	CR INDICATION	LOCAL INDICATION	VALVE POSITION	DESCRIPTION/OTHER
2CCP-30B LSK-9-1D	X	X		X					RB CLOSE LOOP COOLING WATER FLOW FROM DRYWELL 2DRS- UC1B-TEMP
2CNM-70B LSK-4-1.3K	X					X			REACTOR FEEDWATER PUMP P1B SUCT. PRESS
2SFC-2B LSK-34-2B	X	X		X		X			SPENT FUEL POOL WATER LEVEL
2CCP-51B LSK-9-1D	X								RB CLOSE LOOP COOLING WATER FLOW FROM 2RCS*P1B COOLERS
2HDL-41B LSK-4-2.1B	X					X			4TH POINT HEATER NO. 2CNM-E4B DRAIN PUMP DISCHARGE PRESSURE
2CNM-68B LSK-6-3	X	X		X		X		FO	REACTOR FEED PUMP 2FWS-P1B SUCTION FLOW/LOSS OF CONTROL OF 2FWR-FV2B
2HDL-4B LSK-4-2.1B	X					X	X	FC	4TH PT HTR 2CNM-E4B WATER LEVEL/LOSS OF CONTROL OF LV4B

UPS1A

September 11, 1991

2VBB-UPS1A LOAD LIST
 DWG. NO. AE-100D
 SHEET 23 OF 117



100-100000

100-100000



UPS NO: 2VBB-UPS1A
 PNL NO: 2VBS-PNLA101
 BKR NO: 15
 PNL NO: 2VBS-PNLB101
 BKR NO: 16

PLANT IMPACT: LOSS OF POWER TO 2CEC-PNL826

LOOP	PMS INDICATION	PMS ALARM	ERF INPUT	CR ANNUNCIATION	LOCAL ANNUNCIATION	CR INDICATION	LOCAL INDICATION	VALVE POSITION	DESCRIPTION/OTHER
2CNM-45B LSK-4-1.1J	X		X			X	X		CONDENSER CND1B VACUUM
2FWS-9B LSK-6-1.1D	X					X			REACTOR FEEDWATER PUMP P1B DISCHARGE PRESSURE
2CNM-38B LSK-4-1.3K	X	X		X		X		FO	CONDENSATE BOOSTER PUMP P2B FLOW/LOSS OF CONTROL OF FV38B
2HDL-35B LSK-4-2.1C	X					X		FO	4TH POINT HEATER 2CNM-E4B DRAIN PUMP P1B FLOW/LOSS OF CONTROL OF FV35B
2FWS-40B LSK-6-1.1E	X					X			REACTOR INLET PRESSURE
2CCP-108 LSK-9-1B	X	X		X		X		FO	CLOSED LOOP COOLING SYSTEM HEAT EXCHANGE DISCHARGE TEMP/LOSS OF CONTROL OF TV108
2CCP-125 LSK-9-1A	X					X			RB CL LP COOLING HEADER PRESSURE

UPS1A

September 11, 1991

2VBB-UPS1A LOAD LIST
 DWG. NO. AE-100D
 SHEET 24 OF 117





EE-11J
EE-3C
EE-3AF
0007.159-451-332
0007.159-451-322
147D7836, SH. 2

2VBB-UPS1A LOAD LIST
DWG. NO. AE-100D
SHEET 25 OF 117



UPS NO: 2VBB-UPS1A
 PNL NO: 2VBS-PNLA101
 BKR NO: 16

PLANT IMPACT: LOSS OF POWER TO 2CEC-PNL827

LOOP	PMS INDICATION	PMS ALARM	ERF INPUT	CR ANNUNCIATION	LOCAL ANNUNCIATION	CR INDICATION	LOCAL INDICATION	VALVE POSITION	DESCRIPTION/OTHER
2CNM-68C LSK-6-3	X	X		X		X		FO	REACTOR FD PUMP 2FWS-P1C SUCTION FLOW/LOSS OF CONTROL OF 2FWR- FV2C
2CCP-24A/C LSK-9-1D	X	X		X					RB CLOSE LOOP COOLING WATER FROM DRYWELL 2DRS-UC2A/C TEMP
2CCP-30A/C LSK-4-1.3K	X	X		X					RBCLCW FROM DRYWELL 2DRS-UC1A/C TEMP
2CNM-38C, LSK-4-1.3K	X	X		X		X		FO	CNST BSTR PUMP P2C SUCTION FLOW/LOSS OF CONTROL OF FV38C
2CCP-74A LSK-9-1D	X	X		X					RB CLOSE LOOP COOLING WATER FROM DRYWELL 2DRS-UC3A TEMP
2SFC-2A LSK-34-2B	X	X		X		X			SPENT FUEL POOL WATER LEVEL
2CCP-129 LSK-9-1E	X	X		X					RB CLOSE LOOP COOLING WATER PUMP P1A, P1B, P1C DISCHARGE FLOW
2HDL-4C LSK-4-2.1B	X					X	X	FC	4TH POINT HTR 2CNM- E4C WATER LEVEL LOSS OF CONTROL OF LV4C
2HDL-35C LSK-4-2.1C	X					X		FO	4TH POINT HTR 2CNM- E4C DRAIN PUMP P1C FLOW/LOSS OF CONTROL OF FV35C

UPS1A

September 11, 1991

2VBB-UPS1A LOAD LIST
 DWG. NO. AE-100D
 SHEET 26 OF 117



UPS NO: 2VBB-UPS1A
 PNL NO: 2VBS-PNLA101
 BKR NO: 16

PLANT IMPACT: LOSS OF POWER TO 2CEC-PNL827

LOOP	PMS INDICATION	PMS ALARM	ERF INPUT	CR ANNUNCIATION	LOCAL ANNUNCIATION	CR INDICATION	LOCAL INDICATION	VALVE POSITION	DESCRIPTION/OTHER
2CCP-51A LSK-9-1D	X								RB CLOSE LOOP COOLING WATER FLOW FROM 2RCS*P1A COOLERS
2HDL-41C LSK-4-2.1B	X				X				4TH POINT HEATER NO. 2CNM-E4C DRAIN PUMP DISCHARGE PRESSURE
2CCS-149 LSK-9-7A	X				X				TB CLOSE LOOP COOLING WATER PUMP DISCHARGE HEADER PRESSURE
2CMS*178 LSK-33-2E	X				X				CONTAINMENT DW PRESSURE AROUND 12.5 TO 17 PSIA
2CMS-179 LSK-33-2E	X				X				SUPPRESSION CHAMBER PRESSURE AROUND 12.5 TO 17 PSIA
2SFC-124 LSK-34-2D					X			FC	SFPC WATER CIRC DUMP VALVE/LOSS OF CONTROL OF FV124
2SFC-104 LSK-34-2D	X				X				SFPC TOTAL FLOW
2CCS-136 LSK-9-7C	X	X		X					TB CLOSE LOOP COOLING WATER FLOW BELOW 2 PUMP LIMIT, 1 PUMP LIMIT
2FWS-9C LSK-6.1.1D	X				X				REACTOR FEED WATER PUMP P1C DISCHARGE PRESSURE
2TML-108 LSK-16-2.3	X				X				OIL TANK OIL LEVEL
2CNM-45C LSK-4-1.1J	X		X		X	X			CONDENSER 1C VACUUM

UPS1A

September 11, 1991

2VBB-UPS1A LOAD LIST
 DWG. NO. AE-100D
 SHEET 27 OF 117



UPS NO: 2VBB-UPS1A
 PNL NO: 2VBS-PNLA101
 BKR NO: 16

PLANT IMPACT: LOSS OF POWER TO 2CEC-PNL827

LOOP	PMS INDICATION	PMS ALARM	ERF INPUT	CR ANNUNCIATION	LOCAL ANNUNCIATION	CR INDICATION	LOCAL INDICATION	VALVE POSITION	DESCRIPTION/OTHER
2CNM-70C LSK-4-1.3K	X					X			REACTOR FEED WATER PUMP P1C SUCTION PRESSURE
2CCS-104 LSK-9-7B	X	X		X		X		FO	TB COOLING WATER HEAT EXCH. DISCH TEMP HIGH/LOSS OF CONTROL OF TV104

UPS1A

September 11, 1991

2VBB-UPS1A LOAD LIST
 DWG. NO. AE-100D
 SHEET 28 OF 117



10

11

UPS NO: 2VBB-UPS1A
 PNL NO: 2VBS-PNLA101
 KR NO: 17
 CIRCUIT NO: 2CECN05,
 2CECN03,
 2CECN01

DRAWING REFERENCES

LSK-3-1A	EE-11J
LSK-21-1A	147D7854, SH 2
LSK-21-1B	0007.520-001-555
LSK-21-1C	0007.520-001-545
LSK-16-8D	ESK-7CEC01
LSK-2-1.1F	0007.400-001-001
EE-3B8	0007.400-001-002

FEED TO DEVICE	DEVICE LOCATION		PLANT IMPACT
	BLDG	ELEV	
2CEC-PNL750 JB103	CCR	306	
2CEC*PNL851 PWRS1-2CECN05	CCR	306	POWER SUPPLY FOR BAILEY CHART DRIVES & RECORDERS
2CEC*PNL601 C91-R620	CCR	306	LOSS OF PERFORMANCE MONITORING SYSTEM TREND RECORDER #1 CHART DRIVE
2CEC*PNL603 C91-R621	CCR	306	LOSS OF PERFORMANCE MONITORING SYSTEM TREND RECORDER #2 CHART DRIVE
2CEC*PNL851 C91-R622	CCR	306	LOSS OF PERFORMANCE MONITORING SYSTEM TREND RECORDER #3 CHART DRIVE
2CEC*PNL851 2GMC-CR110/CR111	CCR	306	LOSS OF GENERATOR INLET CONDUCTIVITY INDICATION/ LOSS OF GENERATOR OUTLET CONDUCTIVITY INDICATION
2CEC*PNL851 2SST-CR106/ CR114/AR113	CCR	306	LOSS OF CNDS DMNRLZR SAMPLE INLET CNDT/LOSS OF CNDS DMNRLZR SAMPLE OUTLET CNDT/LOSS OF CNDS DMNRLZR SAMPLE OUTLET CNDT 02 IND
2CEC*PNL851 2SST-CR131/ AR132/AR133	CCR	306	LOSS OF COMMON 6TH PT HEATER OUTLET SAMPLE CNDT/LOSS OF COMMON 6TH PT HEATER OUTLET SAMPLE 02/LOSS OF COMMON 6TH PT HEATER OUTLET SAMPLE PH INDICATION

UPS1A

September 11, 1991

2VBB-UPS1A LOAD LIST
 DWG. NO. AE-100D
 SHEET 29 OF 117



UPS NO: 2VBB-UPS1A
 PNL NO: 2VBS-PNL101
 BKR NO: 17
 CIRCUIT NO: 2CECN05,
 2CECN03,
 2CECN01

DRAWING REFERENCES

LSK-3-1A	EE-11J
LSK-21-1A	147D7854, SH 2
LSK-21-1B	0007.520-001-555
LSK-21-1C	0007.520-001-545
LSK-16-8D	ESK-7CEC01
LSK-2-1.1F	0007.400-001-001
EE-3B8	0007.400-001-002

FEED TO DEVICE	DEVICE LOCATION		PLANT IMPACT
	BLDG	ELEV	
2CEC*PNL851 2CWS-CR103	CCR	306	LOSS OF BLOWDOWN COOLING TOWER WATER CONDUCTIVITY INDICATION
2CEC*PNL851 2CWS-AR105	CCR	306	LOSS OF BLOWDOWN COOLING TOWER WATER PH INDICATION
2CEC*PNL851 2MSS-TR24A	CCR	306	LOSS OF REHEATER E1A REHEATING STEAM SUPPLY TEMP INDICATION
2CEC*PNL851 2MSS-TR24B	CCR	306	LOSS OF REHEATER E1B REHEATING STEAM SUPPLY TEMP E1B INDICATION
2CEC-CP622 CMPTR PT CECXM01	CRR	288	CHIME FOR ALARM CONDITION

UPS1A

September 11, 1991

2VBB-UPS1A LOAD LIST
 DWG. NO. AE-100D
 SHEET 30 OF 117



2UPS NO: 2VBB-UPS1A
PNL NO: 2VBS-PNLA101
BKR NO: 18
CIRCUIT NO: 2CBA88

DRAWING REFERENCES

EE-11J
EE-3AG
0007.159-451-408
0007.159-451-407
EE-3N
147D7836 SH. 2

[illegible]

UP81A

September 11, 1991

2VBB-UPS1A LOAD LIST
DWG. NO. AE-100D
SHEET 31 OF 117



UPS NO: 2VBB-UPS1A
 PNL NO: 2VBS-PNLA101
 BKR NO: 18
 UPS NO: 2VBB-UPS1B -
 PNL NO: 2VBS-PNLB101
 BKR NO: 18

PLANT IMPACT: LOSS OF POWER TO 2CEC-PNL888

LOOP	PMS INDICATION	PMS ALARM	ERE INPUT	CR ANNUNCIATION	LOCAL ANNUNCIATION	CR INDICATION	LOCAL INDICATION	VALVE POSITION	DESCRIPTION/OTHER
2ABM-110 LSK-10-1A	X	X		X	X		X		AUX BOILERS STEAM HDR PRESS
2ABM-101 LSK-10-1A	X	X		X	X		X		AUX BOILER DEAR STEM INL PRESS
2CWS-66A,B LSK-2-1.1D		X		X					CLG TWR SCREENS WATER LVL HI
2CWS-109 LSK-2-1.1L	X	X		X				FAI	CLG TWR BASIN WTR TEMP/LOSS OF CONTROL OF MOG52A,B,C
2CWS-135 LSK-2-1.1L	X	X		X				FAI	CLG TWR BASIN WTR TEMP/LOSS OF CONTROL OF MOG52A,B,C
2CWS-136 LSK-2-1.1L	X	X		X				FAI	CLG TWR BASIN WTR TEMP/LOSS OF CONTROL OF MOG52A,B,C
2CWS-138 LSK-2-1.1D	X	X		X		X			CLG TWR FLUME WTR TEMP
2CWS-137 LSK-2-1.1L	X	X		X				FAI	CLG TWR BASIN WTR TEMP/LOSS OF CONTROL OF MOG52A,B,C
2CWS-147 LSK-9-10AC	X					X			CLG TWR BLOWDOWN FLOW/LOSS OF INDICATION ON 2SWP-FR602
2CWS-140 LSK-2-1.1D	X	X		X		X		FC	CLG TWR BASIN WTR LVL/LOSS OF CONTROL OF LV140

UPS1A

September 11, 1991

2VBB-UPS1A LOAD LIST
 DWG. NO. AE-100D
 SHEET 32 OF 117



UPS NO: 2VBB-UPS1A
 PNL NO: 2VBS-PNLA101
 BKR NO: 18
 UPS NO: 2VBB-UPS1B
 PNL NO: 2VBS-PNLB101
 BKR NO: 18

PLANT IMPACT: LOSS OF POWER TO 2CEC-PNL888

LOOP	PMS INDICATION	PMS ALARM	ERF INPUT	CR ANNUNCIATION	LOCAL ANNUNCIATION	CR INDICATION	LOCAL INDICATION	VALVE POSITION	DESCRIPTION/OTHER
2CWS-47B LSK-2-1.1D	X					X			CLG TWR RETURN FLOW TO CWS
2SST-50A,B,C LSK-4-2.1C	X	X		X	X	X			2HDL-P1A,B,C TURBIDITY SAMPLE
2SST-22A,B,C LSK-21-1A	X	X		X	X				MN COND A,B,C SHL EAST HALF CNDT
2SST-21A,B,C LSK-21-1A	X	X		X	X				MN COND A,B,C SHL WEST HALF CNDT
2SST-58A THRU J LSK-21-1E	X	X		X	X				CNDS DMNRLZR 1A THRU 1J EFFLUENT CNDT
2SST-53A,B,C LSK-21-1D	X	X		X	X				2HDL-P1A,B,C DISCH SAMPLE CNDT
2SSR-156 LSK-21-1C	X	X		X	X		X		CRD COM FLTR DISCH TURBIDITY
2SWP-512 LSK-9-10T	X					X		FO	INTAKE CHANNEL WATER TEMP LOSS OF CONTROL OF TV512
2SWP-511 LSK-9-10U	X					X			INTAKE TEMPERING WATER FLOW
2SWP-509 LSK-9-10U	X					X			JET MOTIVE PUMP FLOW
2SST-142 LSK-21-1C	X	X		X	X				COND DMNRLZR INL SAMPLE TURB
2WTS-323 LSK-13-1G	X					X			DISCH FLOW TO LAKE

UPS1A

September 11, 1991

2VBB-UPS1A LOAD LIST
 DWG. NO. AE-100D
 SHEET 33 OF 117



UPS NO: 2VBB-UPS1A
PNL NO: 2VBS-PNLA101
BKR NO: 19
CIRCUIT NO: 2RCSA19

DRAWING REFERENCES

EE-11J
EE-3DT
147D7828, SH. 2
0007.221-001-089
0007.213-001-019

[illegible]

UP81A

September 11, 1991

2VBB-UPS1A LOAD LIST
DWG. NO. AE-100D
SHEET 34 OF 117



UPS NO: 2VBB-UPS1A
 PNL NO: 2VBS-PNL101
 DIST PNL NO: 2CEC-PNL634
 BKR NO: 19

PLANT IMPACT: LOSS OF POWER TO 2CEC-PNL634

DWG. REF.
 761E79ITY
 442X559-002
 0007.221-001-089
 TL2RCS-103, TL2RCS-104
 TL2RCS-105
 LOOP

PMS INDICATION
 PMS ALARM
 ERF INPUT
 CR ANNUNCIATION
 LOCAL ANNUNCIATION
 CR INDICATION
 LOCAL INDICATION
 VALVE POSITION

DESCRIPTION/OTHER

RECP #1 FEEDS POWER SUPPLIES NEST 2,3,4,5,8,9,10						X			RCS LOAD DEMAND ERROR CONTROL INSTRUMENTATION (INOP)
RECP #1 FEEDS POWER SUPPLIES NEST 2,3,4,5,8,9,10		X			X	X			RCS MASTER CONTROL INSTRUMENTATION (FLOW CONTROL) (INOP)
RECP #1 FEEDS POWER SUPPLIES NEST 2,3,4,5,8,9,10		X			X	X			RCS NEUTRON FLUX CONTROL INSTRUMENTATION (FLOW CONTROL) (INOP)
RECP #1 FEEDS POWER SUPPLIES NEST 2,3,4,5,8,9,10								FL	RCS FLOW CONTROL LOOP "A" INSTRUMENTATION (INOP) 2RCS*HYV17A
RECP #1 FEEDS POWER SUPPLIES NEST 2,3,4,5,8,9,10								FL	2RCS*HYV17A POSITION & VELOCITY CONTROL INSTRUMENTATION (INOP)
FUSE PLATE VALIDYNE PUMP								FL	2RCS*HYV17A POSITION & VELOCITY AMP (INOP)

UPS1A

September 11, 1991

2VBB-UPS1A LOAD LIST
 DWG. NO. AE-100D
 SHEET 35 OF 117





•

EE-11J

EE-3DU

147D7828, 8H. 2

0007.221-001-099

0007.213-001-019



2VBB-UP81A LOAD LIST

DWG. NO. AB-100D

SHEET 36 OF 117

10



11

12

13



UPS NO: 2VBB-UPS1A
 PNL NO: 2VBS-PNLA101
 DIST PNL NO: 2CEC-PNL634
 BKR NO: 20

PLANT IMPACT: LOSS OF POWER TO 2CEC-PNL634

0007.221-001-116
 0007.221-001-105

LOOP	PMS INDICATION	PMS ALARM	ERF INPUT	CR ANNUNCIATION	LOCAL ANNUNCIATION	CR INDICATION	LOCAL INDICATION	VALVE POSITION	DESCRIPTION/OTHER
15A CKT BKR		X		X	X			FL	2RCS*HYV17A HYDRAULIC POWER UNIT (HPU) (INOP)
15A CKT BKR		X		X	X			FL	2RCS*HYV17A MODICON CONTROLLER FOR HPU AND ASSOCIATED INPUT (INOP)

UPS1A

September 11, 1991

2VBB-UPS1A LOAD LIST
 DWG. NO. AE-100D
 SHEET 37 OF 117



UPS NO: 2VBB-UPS1A
PNL NO: 2VBS-PNLA101
BKR NO: 21
CIRCUIT NO: N/A

DRAWING REFERENCES

EE-11J

FEED TO DEVICE	DEVICE LOCATION		PLANT IMPACT
	BLDG	ELEV	
SPARE			NONE

UPS1A

September 11, 1991

2VBB-UPS1A LOAD LIST
DWG. NO. AE-100D
SHEET 38 OF 117





DRAWING REFERENCES

ESK-108XS27	147D7834, SH. 2
0007.520-001-375	EE-11J
0007.521-001-157	ESK-108XS17
0007.227-001-003	EE-3AB
0007.227-001-014	
0007.227-001-018	

[illegible]

UP81A



2VBB-UPS1A LOAD LIST
DWG. NO. AE-100D
SHEET 39 OF 117





EE-11J



2VBB-UP81A LOAD LIST
DWG. NO. AE-100D
SHEET 40 OF 117

4

5

6

7

8

9

10

11

12

13

14

15

16

17

18

19

20

21

22

23

24

25

26

27

28

29

30





ESK-7LMS04	EE-11J
ESK-11LMS01	EE-3BE
ESK-11LMS02	147D7846, SH. 2
0007.520-001-658	0007.520-001-650
0007.520-001-649	LSK-33-1A

[illegible]

2VBB-UPS1A LOAD LIST
DWG. NO. AE-100D
SHEET 41 OF 117



147D7834, SH. 2	EE-11J
0007.227-001-003	ESK-108XS19
0007.227-001-016	EE-3AB
0007.227-001-019	0007.520-001-375
ESK-108XS28	0007.520-001-157

[illegible]

2VBB-UPS1A LOAD LIST
DWG. NO. AE-100D
SHEET 42 OF 117

47



2

3

4

5

6

7

8 9 10 



101

102

103





DRAWING REFERENCES

EE-11J
ESK-11CEC03
EE-3DK
147D7848, SH. 2
0007.520-001-350
0007.520-001-337

2VBB-UPS1A LOAD LIST
DWG. NO. AE-100D
SHEET 43 OF 117



DRAWING REFERENCES

EE-11J
ESK-11CEC04
EE-3AX
0007.520-001-354
0007.520-001-357
0007.520-001-342
147D7848, SH. 2



UP81A



2VBB-UPS1A LOAD LIST
DWG. NO. AE-100D
SHEET 44 OF 117



1

2

3

4

5

6



7

8

9

10

11

12

13





DRAWING REFERENCES

EE-11J
LSK-22-23A
EE-3DJ
147D7848, SH. 2
0007.520-001-658
0007.520-001-647
ESK-11CEC05



UP81A

2VBB-UPS1A LOAD LIST
DWG. NO. AE-100D
SHEET 45 OF 117



0
1
UPS NO: 2VBB-UPS1A
PNL NO: 2VBS-PNLA101
BKR NO: 29
CIRCUIT NO: N/A

DRAWING REFERENCES

EE-11J

FEED TO DEVICE	DEVICE LOCATION		PLANT IMPACT
	BLDG	ELEV	
SPARE			NONE

UPS1A

September 11, 1991

2VBB-UPS1A LOAD LIST
DWG. NO. AE-100D
SHEET 46 OF 117

10

11

12

13

14

15

16

17

18

19

20

21

22

23

24

25

26

27

28

29

30

31

32



DRAWING REFERENCES

ESK-7DRS01	EE-11J
ESK-7GTS04	EE-3AS
ESK-6DRS01	0007.520-001-590
ESK-6DRS02	0007.520-001-584
ESK-6DRS03	147D7857, SH. 2
ESK-6DRS04	LSK-27-15H
ESK-6DRS05	LSK-22-22



September 11, 1991

2VBB-UPS1A LOAD LIST
DWG. NO. AE-100D
SHEET 47 OF 117





INTRODUCTION

EE-11J

September 11, 1991

2VBB-UPS1A LOAD LIST
DWG. NO. AE-100D
SHEET 48 OF 117



7

101

103

104

105

106

107





DRAWING REFERENCES

EE-11J



UP81A

2VBB-UPS1A LOAD LIST
DWG. NO. AE-100D
SHEET 49 OF 117



UPS NO: 2VBB-UPS1A
PNL NO: 2VBS-PNLA101
BKR NO: 33
CIRCUIT NO: N/A

DRAWING REFERENCES

EE-11J

FEED TO DEVICE	<u>DEVICE LOCATION</u>		PLANT IMPACT
	BLDG	ELEV	
SPARE			NONE

UPS1A

September 11, 1991

2VBB-UPS1A LOAD LIST
DWG. NO. AE-100D
SHEET 50 OF 117



UPS NO: 2VBB-UPS1A
PNL NO: 2VBS-PNLA101
CRK NO: 34
CIRCUIT NO: N/A

DRAWING REFERENCES

EE-11J

FEED TO DEVICE	<u>DEVICE LOCATION</u>		PLANT IMPACT
	BLDG	ELEV	
SPARE			NONE

UPS1A

September 11, 1991

2VBB-UPS1A LOAD LIST
DWG. NO. AE-100D
SHEET 51 OF 117



EE-11J
EE-3FN
0007.330-002-022 THRU-035



2VBB-UPS1A LOAD LIST
DWG. NO. AE-100D
SHEET 52 OF 117

87





DRAWING REFERENCES

0007.221-001-012

EE-11J

0007.221-001-016

EE-3AC

0007.221-001-017

0007.522-001-407

0007.221-001-041

147D7834, SH. 2

FEED TO DEVICE

DEVICE LOCATION

PLANT IMPACT

BLDG

ELEV

2CEC*PNL709
BAY F JB401

CCR

306

C12A-W049

2CEC-PNL616

CCR

306

**LOSS OF POWER TO CONTROL ROD
DRIVE RELAY CABINET CAUSES:**

- 1) LOSS OF FULL CORE DISPLAY**
- 2) LOSS OF 4-ROD DISPLAY**
- 3) ROD WITHDRAWAL TO BE
INHIBITED**

UP81A

September 11, 1991

2VBB-UP81A LOAD LIST

DWG. NO. AE-100D

SHEET 53 OF 117



1000

1000

1000

1000



DE

0007.221-001-012
0007.221-001-017
0007.221-001-013
0007.520-001-350
0007.520-001-353



September 11, 1991

2VBB-UPS1A LOAD LIST
DWG. NO. AE-100D
SHEET 54 OF 117



DRAWING REFERENCES

EE-11J
EE-3AN
ESK-10IHA40, SH. 2
147D7851, SH. 2



UP81A



2VBB-UPS1A LOAD LIST
DWG. NO. AE-100D
SHEET 55 OF 117

2 x 1



1/2

1/2

1/2

1/2

1 1/2 1 1/2 1 1/2 1 1/2

1/2



1/2

1/2

1/2

1/2

1/2

1/2





DRAWING REFERENCES

EE-11J
EE-3CR
14707829, SH. 2
0007.520-001-420
0007.520-001-403
0007.221-001-010

[illegible]

September 11, 1991

2VBB-UPS1A LOAD LIST
DWG. NO. AE-100D
SHEET 56 OF 117

21

22

23

24

25



UPS NO: 2VBB-UPS1A
 PNL NO: 2VBS-PNL102
 BKR NO: 1
 DIST PNL NO: 2CEC-PNL613

PLANT IMPACT: LOSS OF POWER TO C12-K600

LOOP	PMS INDICATION	PMS ALARM	ERF INPUT	CR ANNUNCIATION	LOCAL ANNUNCIATION	CR INDICATION	LOCAL INDICATION	VALVE POSITION	DESCRIPTION/OTHER
24VDC PWR SUPPLY C12-K600 807E159TY						X	X		(C12-N008 DIFF PRESS XMTR) CRD DRIVE WATER DIFF PRESSURE
24VDC PWR SUPPLY C12-K600 807E159TY						X	X		(C12-N011 DIFF PRESS XMTR) CRD COOLING WTR DIFF PRESSURE
24VDC PWR SUPPLY C12-K600 807E159TY		X		X		X	X		(C12-N005 PRESS XMTR) CRD HYD SYSTEM CHARGING WATER PRESS
24VDC PWR SUPPLY C12-K600 807E159TY		X		X					(C12-N052 PRESS XMTR) CRD SCRAM VALVE PILOT AIR HDR PRESS HIGH & LOW
24VDC PWR SUPPLY C12-K600 807E159TY	X					X	X	FC	(C12-N004 FLOW XMTR) CRD HYD SYSTEM FLOW CONTROL 2RDS-FV6A & 6B

UPS1A

September 11, 1991

2VBB-UPS1A LOAD LIST
 DWG. NO. AE-100D
 SHEET 57 OF 117



UPS NO: 2VBB-UPS1A
 PNL NO: 2VBS-PNLA102
 BKR NO: 1
 DIST PNL NO: 2CEC-PNL613

PLANT IMPACT: LOSS OF POWER TO C12-K600

LOOP	PMS INDICATION	PMS ALARM	ERF INPUT	CR ANNUNCIATION	LOCAL ANNUNCIATION	CR INDICATION	LOCAL INDICATION	VALVE POSITION	DESCRIPTION/OTHER
24VDC PWR SUPPLY C12-K600 807E159TY						X			(C12-N009 FLOW XMTR) CRD COOLING WTR FLOW
24VDC PWR SUPPLY C12-K600 807E159TY						X	X		(C12-N007 FLOW XMTR) CRD DRIVE WATER FLOW
24VDC PWR SUPPLY C12-K600 791E406TY									(C12-N054A PRESS XMTR) 1ST STAGE TURBINE PRESSURE RSCS LOW POWER ALARM/SETPOINT 1 INOP
24VDC PWR SUPPLY C12-K600 791E406TY									(C12-N054B PRESS XMTR) 1ST STAGE TURBINE PRESSURE RRCS LOW POWER ALARM/SETPOINT 2 INOP

UPS1A

September 11, 1991

2VBB-UPS1A LOAD LIST
 DWG. NO. AE-100D
 SHEET 58 OF 117



UPS NO: 2VBB-UPS1A
PNL NO: 2VBS-PNLA102
BKR NO: 2
CIRCUIT NO: 2MBSN19

DRAWING REFERENCES

EE-11J
EE-3CQ
147D7829, SH. 2
0007.520-001-425
0007.520-001-424

[illegible]

UP81A

September 11, 1991

2VBB-UPS1A LOAD LIST
DWG. NO. AE-100D
SHEET 59 OF 117



UPS NO: 2VBB-UP81A
 PNL NO: 2VBS-PNLA102
 BKR NO: 2
 DIST PNL NO: 2CEC-PNL619

PLANT IMPACT: LOSS OF POWER TO B22-K615

LOOP	PMS INDICATION	PMS ALARM	REF INPUT	CR ANNUNCIATION	LOCAL ANNUNCIATION	CR INDICATION	LOCAL INDICATION	VALVE POSITION	DESCRIPTION/OTHER
FUSE B22B-F1 B22-K615 24VDC POWER SUPPLY									
(807E159TY)	X					X			LOSS OF JET PUMPS TOTAL FLOW LOOP A AND B
(807E159TY)	X					X			(B22-N034A THRU W FLOW XMTR) JET PUMP JP-1 THRU JP- 2
(807E159TY)	X					X			(B22-N033 THRU D FLOW XMTR) CALIBRATED JET PUMP FLOW JP-5, 10, 15 & 20
(807E159TY)	X					X			(B22-N032 DIFF PRESS XMTR) REACTOR CORE PLATE DIFFERENTIAL PRESSURE
B22B-F2 FUSE	X					X			TOTAL JET PUMP FLOW SUMMING LOGIC INOP

UP81A

September 11, 1991

2VBB-UP81A LOAD LIST
 DWG. NO. AE-100D
 SHEET 60 OF 117





DRAWING REFERENCES

EE-11J

UP81A

September 11, 1991

2VBB-UPS1A LOAD LIST
DWG. NO. AE-100D
SHEET 61 OF 117





DRAWING REFERENCES

EE-11J
0007.159-451-323
EE-3AJ



UP81A



2VBB-UPS1A LOAD LIST
DWG. NO. AE-100D
SHEET 62 OF 117



UPS NO: 2VBB-UPS1A
 PNL NO: 2VBS-PNLA102
 BKR NO: 4

PLANT IMPACT: LOSS OF POWER TO 2CEC-PNL884

LOOP	PMS INDICATION	PMS ALARM	ERF INPUT	CR ANNUNCIATION	LOCAL ANNUNCIATION	CR INDICATION	LOCAL INDICATION	VALVE POSITION	DESCRIPTION/OTHER
2ASS-6A LSK-3-9D	X	X		X		X			AUX. STEAM FLOW TO AIR REMOVAL SYSTEM
2MSS-103 LSK-3-1D & 1E	X								2TMS-T1 FIRST STAGE PRESSURE/GROUP 1 DRAIN VALVES
2WTS-243 LSK-13-1B	X	X		X	X		X		NEUTRALIZER TANK LEVEL HIGH/INHIBIT THE START OF REGENERATION
2DSR-68A LSK-32-6B	X	X		X			X	FO	REHEATER DRAIN RECEIVER TANK 6A WATER LEVEL, LOSS OF CONTROL OF LV- 68A
2FOF-101 LSK-15-1.2C				X			X		FUEL OIL STORAGE TANK LEVEL FIRE COMPUTER ALARM
2DSR-78A LSK-32-6E	X	X		X				FAI	SCAVENGING STEAM LINE A PRESSURE LOSS OF CONTROL OF MOV-86A
2MSS-104 LSK-3-1E	X							FO	2TMS-TI 1ST STAGE PRESSURE/LOSS OF CONTROL OF AOV85A,B,C,D, 2CNM-AOV101 AND 2CNM-AOV109
2CNS-8A LSK-4-3A	X	X	X	X		X			CNDS. STOR TK1A LEVEL

UPS1A

September 11, 1991

2VBB-UPS1A LOAD LIST
 DWG. NO. AE-100D
 SHEET 63 OF 117

17
22

18
19
20

21

22 23 24 

101
102
UPS NO: 2VBB-UPS1A
 PNL NO: 2VBS-PNLA102
 BKR NO: 4

PLANT IMPACT: LOSS OF POWER TO 2CEC-PNL884

LOOP	PMS INDICATION	PMS ALARM	ERF INPUT	CR ANNUNCIATION	LOCAL ANNUNCIATION	CR INDICATION	LOCAL INDICATION	VALVE POSITION	DESCRIPTION/OTHER
2MSS-101 LSK-3-1B, F	X								2TMS-T1 MAIN STEAM INLET HDR. PRESSURE LOSS OF 2ASS-STV112 & 2ASS-AOV145
2MSS-24A LSK-3-1A	X				X				E1A REHEATING STEAM TEMP
2DSR-103 LSK-32-6C	X								SCAVENGING STEAM HEADER PRESSURE
2MSS-22A LSK-3-1M, 3-2	X				X		FC		MS/R REGULATED STEAM PRESSURE LOSS OF CONTROL OF 2MSS- PV28A AND 29A
2CRS-1A LSK-3-2	X								HIGH PRESSURE TURBINE EXHAUST COLD REHEATER STEAM TO 2MSS-E1A SHELL PRESSURE.
2CRS-2A LSK-3-2	X								H.P. TURB. EXH. COLD REHEATER STEAM TO 2MSS-E1A SHELL PRESSURE.
2CRS-3A LSK-3-2	X								H.P. TURBINE EXH. COLD REHEATER STEAM TO 2MSS-E1A SHELL PRESSURE.
2CRS-16A LSK-3-2	X								H.P. TURB. EXH. COLD REHEATER STEAM TO 2MSS-E1A SHELL PRESSURE
2CRS-19A LSK-3-2	X				X				REHEATER A COLD REHEAT PRESSURE

UPS1A

September 11, 1991

2VBB-UPS1A LOAD LIST
 DWG. NO. AE-100D
 SHEET 64 OF 117

५३

•

3

2

10

•

2.

UPS NO: 2VBB-UP81A
 PNL NO: 2VBS-PNLA102
 BKR NO: 4

PLANT IMPACT: LOSS OF POWER TO 2CEC-PNL884

LOOP	PMS INDICATION	PMS ALARM	ERF INPUT	CR ANNUNCIATION	LOCAL ANNUNCIATION	CR INDICATION	LOCAL INDICATION	VALVE POSITION	DESCRIPTION/OTHER
2ESS-1A LSK-3-4A	X					X			6TH POINT HTR 2FWS-E6A EXTR ST. PRESS.
2ESS-4A LSK-3-4A	X								TURB. 4TH STG EXTR STEAM PRESSURE
2ESS-7A LSK-3-4G	X					X			1ST POINT HTR 2CNM-E1A SHELL PRESSURE
2ESS-12A LSK-3-4G	X						X		2ND POINT HTR 2CNM-E2A SHELL PRESSURE
2ESS-17A LSK-3-4F	X						X		3RD POINT HTR 2CNM-E3A EXTR SHELL PRESSURE
2ESS-25A LSK-3-4D	X						X		4TH POINT HTR. 2CNM-E4A EXTR. STEAM PRESSURE
2ESS-31A LSK-3-4B	X						X		5TH POINT HTR 2CNM-E5A EXTR STEAM PRESSURE
2HRS-7A LSK-3-3	X								2TMS-T2A LP TURBINE INL PRESS.FR 2MSS-E1A
2HRS-8A LSK-3-3	X								2TMS-T2A HRS FROM 2MSS-E1B
2HRS-9A LSK-3-3	X								2TMS-T2A HRS FROM 2MSS-E1B
2MSS-23A LSK-3-1A	X			X					E1A REHEATING STEAM FLOW

UP81A

September 11, 1991

2VBB-UP81A LOAD LIST
 DWG. NO. AE-100D
 SHEET 65 OF 117

11 11 11



UPS NO: 2VBB-UPS1A
 PNL NO: 2VBS-PNL102
 BKR NO: 4

PLANT IMPACT: LOSS OF POWER TO 2CEC-PNL884

LOOP	PMS INDICATION	PMS ALARM	ERF INPUT	CR ANNUNCIATION	LOCAL ANNUNCIATION	CR INDICATION	LOCAL INDICATION	VALVE POSITION	DESCRIPTION/OTHER
2MSS-52A LSK-3-1A	X			X					E1A STEAM SUPPLY PRESS
2DSM-75A LSK-32-7A	X					X	FC		MOISTURE SEP. DRAIN RECEIVER TK4A WTR LEVEL/ LOSS OF CONTROL OF LUX75A, LVY75A, LVZ75A
2DSM-78A LSK-32-7B	X	X		X		X	FO		MOIST SEP. DRAIN RECEIVER TK4A WTR LEVEL/LOSS OF CONTROL OF LV78A
2DSR-65A LSK-32-6A	X					X	FC		NORM WTR LVL DR CONTROL/LOSS OF CONTROL OF LVX65A, LVY65A, AND LVZ65A
2CMS-72A,C LSK-33-2A	X				X				CONTAINMENT DEW PT.
2CNS-130 LSK-4-3A	X								CONDENSATE DRAW OFF FLOW PRESSURE
2CNS-131 LSK-4-3A	X								NORMAL CONDENSATE MAKEUP FLOW

UPS1A

September 11, 1991

2VBB-UPS1A LOAD LIST
 DWG. NO. AE-100D
 SHEET 66 OF 117



1
2
DRAWING REFERENCES

EE-11J
0007.159-451-328
EE-3AJ

[illegible]

UP81A

September 11, 1991

2VBB-UPS1A LOAD LIST
DWG. NO. AE-100D
SHEET 67 OF 117



UPS NO: 2VBB-UPS1B
 PNL NO: 2VBS-PNLB102
 BKR NO: 4
 UPS NO: 2VBB-UPS1A
 PNL NO: 2VBS-PNLA102
 BKR NO: 5

PLANT IMPACT: LOSS OF POWER TO 2CEC-PNL885

LOOP	PMS INDICATION	PMS ALARM	ERF INPUT	CR ANNUNCIATION	LOCAL ANNUNCIATION	CR INDICATION	LOCAL INDICATION	VALVE POSITION	DESCRIPTION/OTHER
2CNS-8B LSK-4-3A	X	X	X	X		X			CNDS STOR TK1B LEVEL
2CNS-114 LSK-4-3B	X	X		X		X			CNDS XFR HDR FLOW HIGH/INHIBIT AUTO START OF 2CNS-P1A OR 2CNS-P1B
2CNS-102 LSK-4-3E	X					X			COND HOT WELL LEVEL
2ESS-25B LSK-3-4D	X						X		4TH PT HTR EXTR ST PRESS
2ESS-17B LSK-3-4F	X						X		3RD PT HTR EXTR ST PRESS
2ESS-12B LSK-3-4G	X						X		2ND PT HTR SHELL PRESS
2MSS-52B LSK-3-1A	X					X			E1B STEAM SUPPLY PRESS
2MSS-24B LSK-3-1A	X					X			E1B REHEATING STEAM TEMP
2MSS-23B LSK-3-1A	X			X					E1B REHEATING STEAM FLOW
2ESS-4B LSK-3-4A	X								TURB 4TH STG EXTR ST PRESS
2ESS-31B LSK-3-4B	X						X		5TH PT HTR 2CNM-ESB EXTR ST. PRESS
2MSS-22B LSK-3-1A	X					X			MS/R REGULATED STEAM PRESS/LOSS OF CONTROL OF REHEAT CONTROL VALVES PV28B&PV29B FC

UPS1A

September 11, 1991

2VBB-UPS1A LOAD LIST
 DWG. NO. AE-100D
 SHEET 68 OF 117

1

1 6

1
2

3

4

11

12

13

14

15

16

17

18

19

20

21

22



UPS NO: 2VBB-UPS1B
 PNL NO: 2VBS-PNLB102
 BKR NO: 4
 UPS NO: 2VBB-UPS1A
 PNL NO: 2VBS-PNLA102
 BKR NO: 5

PLANT IMPACT: LOSS OF POWER TO 2CEC-PNL885

PNL NO: 2VBS-PNLB102
BKR NO: 4
UPS NO: 2VBB-UP81A
PNL NO: 2VBS-PNLA102
BKR NO: 5

LOOP	<div>PMS INDICATION</div> <div>PMS ALARM</div> <div>ERF INPUT</div> <div>CR ANNUNCIATION</div> <div>LOCAL ANNUNCIATION</div> <div>CR INDICATION</div> <div>LOCAL INDICATION</div> <div>VALVE POSITION</div>								DESCRIPTION/OTHER
2HRS-7B LSK-3-3	X								2TMS-T2B LP TURBINE INL PRESS FR 2MSS-E1A
2HRS-8B LSK-3-3	X								2TMS-T2B HRS FROM 2MSS-E1A
2HRS-9B LSK-3-3	X								2TMS-T2B HRS FROM 2MSS-E1B
2ASS-6B LSK-3-9D	X	X		X		X			AUX. STM FLOW TO AIR REMOVAL
2DSR-68B LSK-32-6B	X	X		X			X	FO	DRAIN RECEIVER HIGH LEVEL/LOSS OF CONTROL OF LV68B
2DSR-65B LSK-32-6A	X						X	FC	NORM WTR LVL DR CONTROL/LOSS OF CNTRL OF LVX65B, LVY65B AND LVZ65B
2DSM-75B LSK-32-7A	X						X		MOISTURE SEP. DRAIN RECEIVER TK4B WTR LEVEL
2DSM-78B LSK-32-7B	X	X		X			X	FO	MOIST SEP DR RCVR TK4B WTR LEVEL/LOSS OF CONTROL OF LV78B
2DSR-78B LSK-32-6E	X	X		X				FAI	SCAVENGING STEAM LINE B PRESSURE/LOSS OF CONTROL OF MOV 86B
2ESS-7B LSK-3-4G	X					X			1ST PT HTR 2CNM- E1B SHELL PRESS
2ESS-1B LSK-3-4A	X					X			6TH PT HTR 2FWS- E6B EXTR ST. PRESS

UPS1A

September 11, 1991

2VBB-UPS1A LOAD LIST
 DWG. NO. AE-100D
 SHEET 69 OF 117



UPS NO: 2VBB-UPS1B
 PNL NO: 2VBS-PNLB102
 BKR NO: 4
 UPS NO: 2VBB-UPS1A -
 PNL NO: 2VBS-PNLA102
 BKR NO: 5

PLANT IMPACT: LOSS OF POWER TO 2CEC-PNL885

LOOP	PMS INDICATION	PMS ALARM	ERF INPUT	CR ANNUNCIATION	LOCAL ANNUNCIATION	CR INDICATION	LOCAL INDICATION	VALVE POSITION	DESCRIPTION/OTHER
2CRS-103 LSK-3-1M, 3-2	X					X		FC	REHEATER 1B SHELL PRESSURE/LOSS OF CONTROL OF PV28A, PV28B, PV29A & PV29B
2CRS-1B LSK-3-2	X								HIGH PRESSURE TURBINE EXH. COLD REHEATER STEAM TO 2MSS-E1B SHELL PRESSURE.
2CRS-2B LSK-3-2	X								HP TURB EXH COLD REHEATER STEAM TO 2MSS-E1B SHELL PRESSURE.
2CRS-3B LSK-3-2	X								HP TURB EXH COLD REHEATER STEAM TO 2MSS-E1B SHELL PRESSURE.
2CRS-16B LSK-3-2	X								HP TURB EXH. COLD REHEATER STEAM TO 2MSS-E1B SHELL PRESS.
2CRS-19B LSK-3-2	X					X			REHEATER B COLD REHEAT PRESS.
2CMS-72B,D LSK-33-2A	X					X			CONTAINMENT DEW POINT

UPS1A

September 11, 1991

2VBB-UPS1A LOAD LIST
 DWG. NO. AE-100D
 SHEET 70 OF 117





DRAWING REFERENCES

EE-11J
0007.159-451-331
EE-3AK

[illegible]

UP81A

September 11, 1991

2VBB-UPS1A LOAD LIST
DWG. NO. AE-100D
SHEET 71 OF 117



100

101

102

103

104

105

106

107

108

UPS NO: 2VBB-UPS1A
 PNL NO: 2VBS-PNLA102
 SKR NO: 6

PLANT IMPACT: LOSS OF POWER TO 2CEC-PNL886

LOOP	PMS INDICATION	PMS ALARM	ERF INPUT	CR ANNUNCIATION	LOCAL ANNUNCIATION	CR INDICATION	LOCAL INDICATION	VALVE POSITION	DESCRIPTION/OTHER
2AAS-113 LSK-12-9B	X	X		X		X			BRTHG AIR HDR PRESS
2ARC-20B LSK-5-1B	X	X		X					AIR REMOVAL PUMP-1B SEAL WTR TEMP HI
2ASS-116 LSK-3-9D	X	X		X		X			CLN STM REBLR STM PRESS
2ASS-122 LSK-3-9D	X	X		X		X			AIR EJECTOR 2A STM PRESS
2ASS-127 LSK-3-9D	X	X		X			X		OFFGAS STM PRESS
2CMS-72E,F LSK-33-2A	X					X			CONTAINMENT DEW POINT
2CMS-168 LSK-33-2D	X					X			SUPPR CHAMBER PRESS NORM
2CND-267 LSK-4-7D	X	X		X	X		X		LOW CONDUCTIVITY WASTE TK13 LEVEL
2CND-281 LSK-4-7C	X						X		NEUTRALIZING TK12 LEVEL
2CPS-102 LSK-22-23A	X	X		X		X			ENABLES 2CPS-FN1 (DISCH TO STOP PERMISSIVES DRYWELL)
2CPS-103 LSK-22-23A	X	X		X		X			ENABLES 2CPS-FN1 (DISCH TO STOP PERMISSIVES SUPPR PL)
2CPS-125 LSK-22-23A						X		FC	PRIMARY CONTAINMENT PRESS N2 INLET FLOW/LOSS OF CONTROL OF FV125
2CPS-126 LSK-22-23A	X	X		X		X			PRIMARY CONTAINMENT INLET NITROGEN FLOW

UPS1A

September 11, 1991

2VBB-UPS1A LOAD LIST
 DWG. NO. AE-100D
 SHEET 72 OF 117

1

1-10-10

1

1

1

1

1

1-10-10

1

1



UPS NO: 2VBB-UP81A
 PNL NO: 2VBS-PNLA102
 BKR NO: 6

PLANT IMPACT: LOSS OF POWER TO 2CEC-PNL886

LOOP	PMS INDICATION	PMS ALARM	ERF INPUT	CR ANNUNCIATION	LOCAL ANNUNCIATION	CR INDICATION	LOCAL INDICATION	VALVE POSITION	DESCRIPTION/OTHER
2CPS-127 LSK-22-23A	X	X		X		X			PRIMARY CONTAINMENT INLET NITROGEN PRESS
2GSN-138 LSK-14-1F		X		X		X			PRIMARY CONTAINMENT N2 PURGE TEMP LOW
2HRS-7C LSK-3-3	X								2TMS-T2C LP TURB INL FR 2MSS-E1A
2HRS-8C LSK-3-3	X								2TMS-T2C HRS FROM 2MSS-E1A
2HRS-9C LSK-3-3	X								2TMS-T2C HRS FROM 2MSS-E1B
2IAS-101 LSK-12-1E	X	X		X		X			INSTR AIR HDR PRESS
2IAS-178 LSK-12-1C, 1F	X	X		X		X			ADS CPRSR RCVR TANK *TK4 PRESSURE HIGH
2IAS-183 LSK-12-1C	X	X		X		X			ADS CPRSR RCVR TANK *TK5 PRESSURE HIGH
2MWS-114 LSK-9-15, 13-1B	X	X		X	X	X			DMNRLZD WTR TK 1A OR 1B LVL
2MWS-116 LSK-9-15	X	X		X		X	X		DMNRLZD WTR PMP DISCH FL
2SSR-124 LSK-21-2B	X	X		X	X	X			CRD PUMP DISCH CNDT SAMPLE
2SSR-125 LSK-21-2B	X	X		X	X	X			CRD PUMP DISCH O2 SAMPLE
2SST-106 LSK-21-1A	X	X		X	X	X			COND DMNRLZR INL CNDT SAMPLE
2SST-113 LSK-21-1B	X	X		X	X	X			COND DEMIN OUT O2 SAMPLE

UP81A

September 11, 1991

2VBB-UP81A LOAD LIST
 DWG. NO. AE-100D
 SHEET 73 OF 117



UPS NO: 2VBB-UPS1A
 PNL NO: 2VBS-PNLA102
 BKR NO: 6

PLANT IMPACT: LOSS OF POWER TO 2CEC-PNL886

LOOP	PMS INDICATION	PMS ALARM	ERF INPUT	CR ANNUNCIATION	LOCAL ANNUNCIATION	CR INDICATION	LOCAL INDICATION	VALVE POSITION	DESCRIPTION/OTHER
2SST-114 LSK-21-1B	X	X		X	X	X			COND DMNRLZR OUT CNDT SAMPLE
2SST-131 LSK-21-1B	X	X		X	X	X			COM 6TH PT HTR OUT CNDT SAMPLE
2SST-132 LSK-21-1C	X	X		X	X	X			COM 6TH PT HTR OUT O2 SAMPLE
2SST-133 LSK-21-1C	X	X		X	X	X			COM 6TH PT HTR OUT PH SAMPLE
2TML-132 LSK-16-2.1	X					X		FO	OIL CLRS OUTLET OIL TEMP/LOSS OF CONTROL OF 2CCS- TV43A AND 2CCS- TV43B
2ESS-1C LSK-3-4A	X						X		6TH PT HTR 2FWS-E6C EXTR STM PRESSURE
2ESS-7C LSK-3-4G	X						X		1ST PT HTR 2CNM-E1C SHELL PRESSURE
2ESS-12C LSK-3-4G	X						X		2ND PT HTR 2CNM-E2C SHELL PRESSURE
2ESS-17C LSK-3-4F	X						X		3RD PT HTR 2CNM-E3C EXTR STM PRESSURE
2ESS-25C LSK-3-4D	X						X		4TH PT HTR 2CNM-E4C EXTR STM PRESSURE
2ESS-31C LSK-3-4B	X						X		5TH PT HTR 2CNM-E5C EXTR STEAM PRESSURE

UPS1A

September 11, 1991

2VBB-UPS1A LOAD LIST
 DWG. NO. AE-100D
 SHEET 74 OF 117





EE-11J

0007.15

0007.159-451-334



September 11, 1991





UPS NO: 2VBB-UPS1A
 PNL NO: 2VBS-PNLA102
 BKR NO: 7
 UPS NO: 2VBB-UPS1B
 PNL NO: 2VBS-PNLB102
 BKR NO: 6

PLANT IMPACT: LOSS OF POWER TO 2CEC-PNL887

LOOP	PMS INDICATION	PMS ALARM	ERF INPUT	CR ANNUNCIATION	LOCAL ANNUNCIATION	CR INDICATION	LOCAL INDICATION	VALVE POSITION	DESCRIPTION/OTHER
2ARC-20A LSK-5-1B	X	X		X					AIR REM PP1A SEAL W TEMP H
2CNM-137						X			2FWS-P1A,B,C STARTUP BYPASS VALVE POSITION INDICATION
2CWS-47A LSK-2-1.1D	X					X			CLG TWR RETURN FLOW A
2DFR-106 LSK-23-6C	X	X		X		X			DRYWELL FLOOR DRAIN LEAKAGE TANK LEVEL
2DFR-137 LSK-23-6C	X	X		X		X			DW FL DR PUMPS P1A & P1B FLOW
2FWS-64A/B LSK-6-1.1H						X			FEEDWATER INLET TEMP TO REACTOR LINE A/B
2GMC-110 LSK-16-6C, 8D	X					X			GENERATOR INLET CONDUCTIVITY
2GMC-111 LSK-16-6C, 8D	X					X			GENERATOR OUTLET CONDUCTIVITY
2GMC-134 LSK-16-8C	X					X		FO	ALT COOLER AIR OUTLET TEMP, LOSE CONTROL OF TURBINE BLDG. CLOSED LOOP COOLING WATER VALVE 2CCS-TV32A AND B

UPS1A

September 11, 1991

2VBB-UPS1A LOAD LIST
 DWG. NO. AE-100D
 SHEET 76 OF 117

2

2

2

2

2

2

2

2

2

2



UPS NO: 2VBB-UPS1A
 PNL NO: 2VBS-PNL102
 BKR NO: 7
 UPS NO: 2VBB-UPS1B
 PNL NO: 2VBS-PNL102
 BKR NO: 6

PLANT IMPACT: LOSS OF POWER TO 2CEC-PNL887

LOOP	PMS INDICATION	PMS ALARM	ERF INPUT	CR ANNUNCIATION	LOCAL ANNUNCIATION	CR INDICATION	LOCAL INDICATION	VALVE POSITION	DESCRIPTION/OTHER
2GMH-105 LSK-16-7C	X					X			GENERATOR GAS PURITY
2GMH-117 LSK-16-7A	X					X			GENERATOR GAS PRESS
2GMH-156 LSK-16-7A						X		F0	H2 COLD GAS TEMP/TBCLC FLOW MODULATING VALVE 2CCS-TV109
2GML-103 LSK-16-10	X	X		X					GEN LEADS CLR RETURN AIR TEMP

UPS1A

September 11, 1991

2VBB-UPS1A LOAD LIST
 DWG. NO. AE-100D
 SHEET 77 OF 117



1
2
3
4
5



6
7
8
9
10
11
12



UPS NO: 2VBB-UPS1A
 PNL NO: 2VBS-PNLA102
 BKR NO: 7
 UPS NO: 2VBB-UPS1B
 PNL NO: 2VBS-PNLB102
 BKR NO: 6

PLANT IMPACT: LOSS OF POWER TO 2CEC-PNL887

LOOP	PMS INDICATION	PMS ALARM	ERF INPUT	CR ANNUNCIATION	LOCAL ANNUNCIATION	CR INDICATION	LOCAL INDICATION	VALVE POSITION	DESCRIPTION/OTHER
2GMO-103 LSK-16-6	X					X			HYDRAUL SEAL OIL BRG 9 PRESS
2GMO-104 LSK-16-6	X					X			HYDRAUL SEAL BRG 10 PRESS
2LOS-126 LSK-16-3	X	X		X	X		X		DIRTY OIL STOR TK2 LEVEL/STOP LUBE OIL XFER PUMP P2
2LOS-127 LSK-16-3	X	X		X	X		X		CLEAN OIL STOR TK1 LEVEL/STOP LUBE OIL XFER PUMP P2
2TME-15A,B LSK-16-1.1A	X					X			2TME-E1A & E1B REBLR DISCH STEAM PRESS
2TME-103 LSK-16-1.1B	X					X		FAI	E1A & E1B DISCH HDR PRESS/LOSS OF CONTROL OF 2TME- MOV110, 2TME- SOV121
2TME-107 LSK-16-1.1B	X					X		FAI	E1A & B STEM SEAL RED PRESS/LOSS OF CONTROL OF 2TME- MOV110, 2TME- SOV121
2TME-108 LSK-16-1.1D	X					X			STEAM SEAL EXHAUST VACUUM
2TMI-127 LSK-16-9	X					X			EXH HOOD A TURBINE END TEMP
2TMI-128 LSK-16-9	X					X			EXH HOOD B TURBINE TEMP
2TMI-129 LSK-16-9	X					X			EXH HOOD C TURBINE TEMP

UPS1A

September 11, 1991

2VBB-UPS1A LOAD LIST
 DWG. NO. AE-100D
 SHEET 78 OF 117

12

13
14
15
16
17

18
19
20
21
22
23



PLANT IMPACT: LOSS OF POWER TO 2CEC-PNL887

	DESCRIPTION
PMS INDICATION	
PMS ALARM	
ERF INPUT	
CR ANNUNCIATION	
LOCAL ANNUNCIATION	
CR INDICATION	
LOCAL INDICATION	
VALVE POSITION	

UP81A

2VBB-UPS1A LOAD LIST
DWG. NO. AE-100D
SHEET 79 OF 117

1

2

3

4

5

6

7

8

9

10

11

12

13

14

15

16

17

18

19

20

21

22

23

24

25

26

27

28

29

30

31

32

33

34

35





DRAWING REFERENCES

EE-11J
EE-14C
EE-14B
0001.040-209-078
0001.040-209-022

September 11, 1991

2VBB-UPS1A LOAD LIST
DWG. NO. AE-100D
SHEET 80 OF 117



DRAWING REFERENCES

EE-11J
EE-14C
EE-14B
0001.040-209-078
0001.040-209-022

[illegible]

September 11, 1991

2VBB-UPS1A LOAD LIST
DWG. NO. AE-100D
SHEET 81 OF 117

100-100000



DRAWING REFERENCES
944E995 (C88)
EE-11J
EE-35D
0007.511-414-479, 480

EE-11J

0007.511-414-479, 480

September 11, 1991

2VBB-UPS1A LOAD LIST
DWG. NO. AE-100D
SHEET 82 OF 117





EE-11J

EE-11J



2VBB-UPS1A LOAD LIST
DWG. NO. AE-100D
SHEET 83 OF 117





DRAWING REFERENCES

EE-11J



September 11, 1991

2VBB-UPS1A LOAD LIST
DWG. NO. AE-100D
SHEET 84 OF 117

1

2

DRAWING REFERENCES

EE-3TK
EE-11J
LOOP-2RMS-201
LSK-22-IT



September 11, 1991

2VBB-UPS1A LOAD LIST
DWG. NO. AE-100D
SHEET 85 OF 117

4

5

6

7

8

9

10

11

12

13

14

15 16 17 

1

2

3

4

5

6

7

8

9

10

11

12

13

14

15

16

17

18

19

20



LJ

EE-11J
EE-3TA



September 11, 1991

2VBB-UPS1A LOAD LIST
DWG. NO. AE-100D
SHEET 86 OF 117

1





!

EE-11J



September 11, 1991

2VBB-UPS1A LOAD LIST
DWG. NO. AE-100D
SHEET 87 OF 117





DRAWING REFERENCES

EE-11J

September 11, 1991

2VBB-UP81A LOAD LIST





DRAWING REFERENCES

EE-11J



September 11, 1991

2VBB-UPS1A LOAD LIST
DWG. NO. AE-100D
SHEET 89 OF 117



UPS NO: 2VBB-UPS1A
PNL NO: 2VBS-PNLA102
BKR NO: 18
CIRCUIT NO: N/A

DRAWING REFERENCES

EE-11J

FEED TO DEVICE	<u>DEVICE LOCATION</u>		PLANT IMPACT
	BLDG	ELEV	
SPARE			NONE

UPS1A

September 11, 1991

2VBB-UPS1A LOAD LIST
DWG. NO. AE-100D
SHEET 90 OF 117







DRAWING REFERENCES

EE-11J



September 11, 1991

2VBB-UPS1A LOAD LIST
DWG. NO. AE-100D
SHEET 91 OF 117





DRAWING REFERENCES

EE-3TF
EE-11J
LSK-22-IT

1990



September 11, 1991

2VBB-UPS1A LOAD LIST
DWG. NO. AE-100D
SHEET 92 OF 117



100
101
102
103
104
105



DRAWING REFERENCES

EE-11J

September 11, 1991

2VBB-UPS1A LOAD LIST
DWG. NO. AE-100D
SHEET 93 OF 117





DRAWING REFERENCES

EE-3TF
EE-11J
LSK-22-IT

[illegible]

September 11, 1991

2VBB-UPS1A LOAD LIST
DWG. NO. AE-100D
SHEET 94 OF 117



100














DRAWING REFERENCES

EE-11J
EE-11GH



September 11, 1991

2VBB-UPS1A LOAD LIST
DWG. NO. AE-100D
SHEET 95 OF 117



UPS NO: 2VBB-UPS1A
PNL NO: 2VBS-PNLA102
BKR NO: 24
CIRCUIT NO: N/A

DRAWING REFERENCES

EE-11J

[illegible]

UP81A

September 11, 1991

2VBB-UP81A LOAD LIST
DWG. NO. AE-100D
SHEET 96 OF 117





DRAWING REFERENCES

EE-11GH
EE-3NN



September 11, 1991

2VBB-UPS1A LOAD LIST
DWG. NO. AE-100D
SHEET 97 OF 117





EE-11GH
EE-3NN



2VBB-UPS1A LOAD LIST
DWG. NO. AE-100D
SHEET 98 OF 117





EE-11GH
EE-3NN



2VBB-UPS1A LOAD LIST
DWG. NO. AE-100D
SHEET 99 OF 117



DRAWING REFERENCES

EE-11GH
EE-3NN



September 11, 1991

2VBB-UPS1A LOAD LIST
DWG. NO. AE-100D
SHEET 100 OF 117

82

1

2

3

4

5

6

7

8

9

10

11

12

13

14

15

16

17

18

19

20

21

22

23

24

25

26

27

28

29

30

31

32

33

34

35

36

37

38

39

40

41

42

43

44



CIRCUIT NO: 2LWBNNK585

EE-3NN



UPS NO: 2VBB-UPS1A
PNL NO: 2VBS-PNLA102
BKR NO: 23

DRAWING REFERENCES

EE-11GH
EE-3NN

[illegible]

JP81A

September 11, 1991

2VBB-UPS1A LOAD LIST
DWG. NO. AE-100D
SHEET 102 OF 117



12





DRAWING REFERENCES

EE-11GH

September 11, 1991

2VBB-UPS1A LOAD LIST
DWG. NO. AE-100D
SHEET 103 OF 117



DRAWING REFERENCES

EE-11GH

September 11, 1991

2VBB-UPS1A LOAD LIST
DWG. NO. AE-100D
SHEET 104 OF 117


























































































EE-11GH
EE-3NN



2VBB-UPS1A LOAD LIST
DWG. NO. AE-100D
SHEET 105 OF 117

10

11

12

13

14

15

16

17

18

19



EE-11GH



2VBB-UPS1A LOAD LIST
DWG. NO. AE-100D
SHEET 106 OF 117





EE-11GH
EE-3NN



2VBB-UPS1A LOAD LIST
DWG. NO. AE-100D
SHEET 107 OF 117





EE-11GH
EE-3NN



2VBB-UPS1A LOAD LIST
DWG. NO. AE-100D
SHEET 108 OF 117



**EE-11GH**

2VBB-UPS1A LOAD LIST
DWG. NO. AE-100D
SHEET 109 OF 117








DRAWING REFERENCES

EE-11GH



September 11, 1991

2VBB-UP81A LOAD LIST
DWG. NO. AE-100D
SHEET 110 OF 117




CIRCUIT NO: 2LW8HNK579

EE-3NC

[illegible]

September 11, 1991

2VBB-UPS1A LOAD LIST
DWG. NO. AE-100D
SHEET 111 OF 117

 



EE-11GH
EE-3NE



2VBB-UPS1A LOAD LIST
DWG. NO. AE-100D
SHEET 112 OF 117





EE-11GH
EE-3NN



2VBB-UPS1A LOAD LIST
DWG. NO. AE-100D
SHEET 113 OF 117





EE-11GH
EE-3NN



2VBB-UPS1A LOAD LIST
DWG. NO. AE-100D
SHEET 114 OF 117



EE-11GH
EE-3NA



2VBB-UPS1A LOAD LIST
DWG. NO. AE-100D
SHEET 115 OF 117









DRAWING REFERENCES

EE-11GH
EE-3NB

[illegible]

UP81A

September 11, 1991

2VBB-UPS1A LOAD LIST
DWG. NO. AE-100D
SHEET 116 OF 117


















UPS NO: 2VBB-UPS1A
PNL NO: 2VBS-PNLA102
BKR NO: 23
DIST PNL NO: 2VBS-PNLA107
BKR NO: 21 THROUGH 42
CIRCUIT NO: N/A

DRAWING REFERENCES

EE-11GH

FEED TO DEVICE	DEVICE LOCATION		PLANT IMPACT
	BLDG	ELEV	
SPARE			NONE

UPS1A

September 11, 1991

2VBB-UPS1A LOAD LIST
DWG. NO. AE-100D
SHEET 117 OF 117

1
2
