



9999999999

# 2VBB-UPS1B LOAD LIST

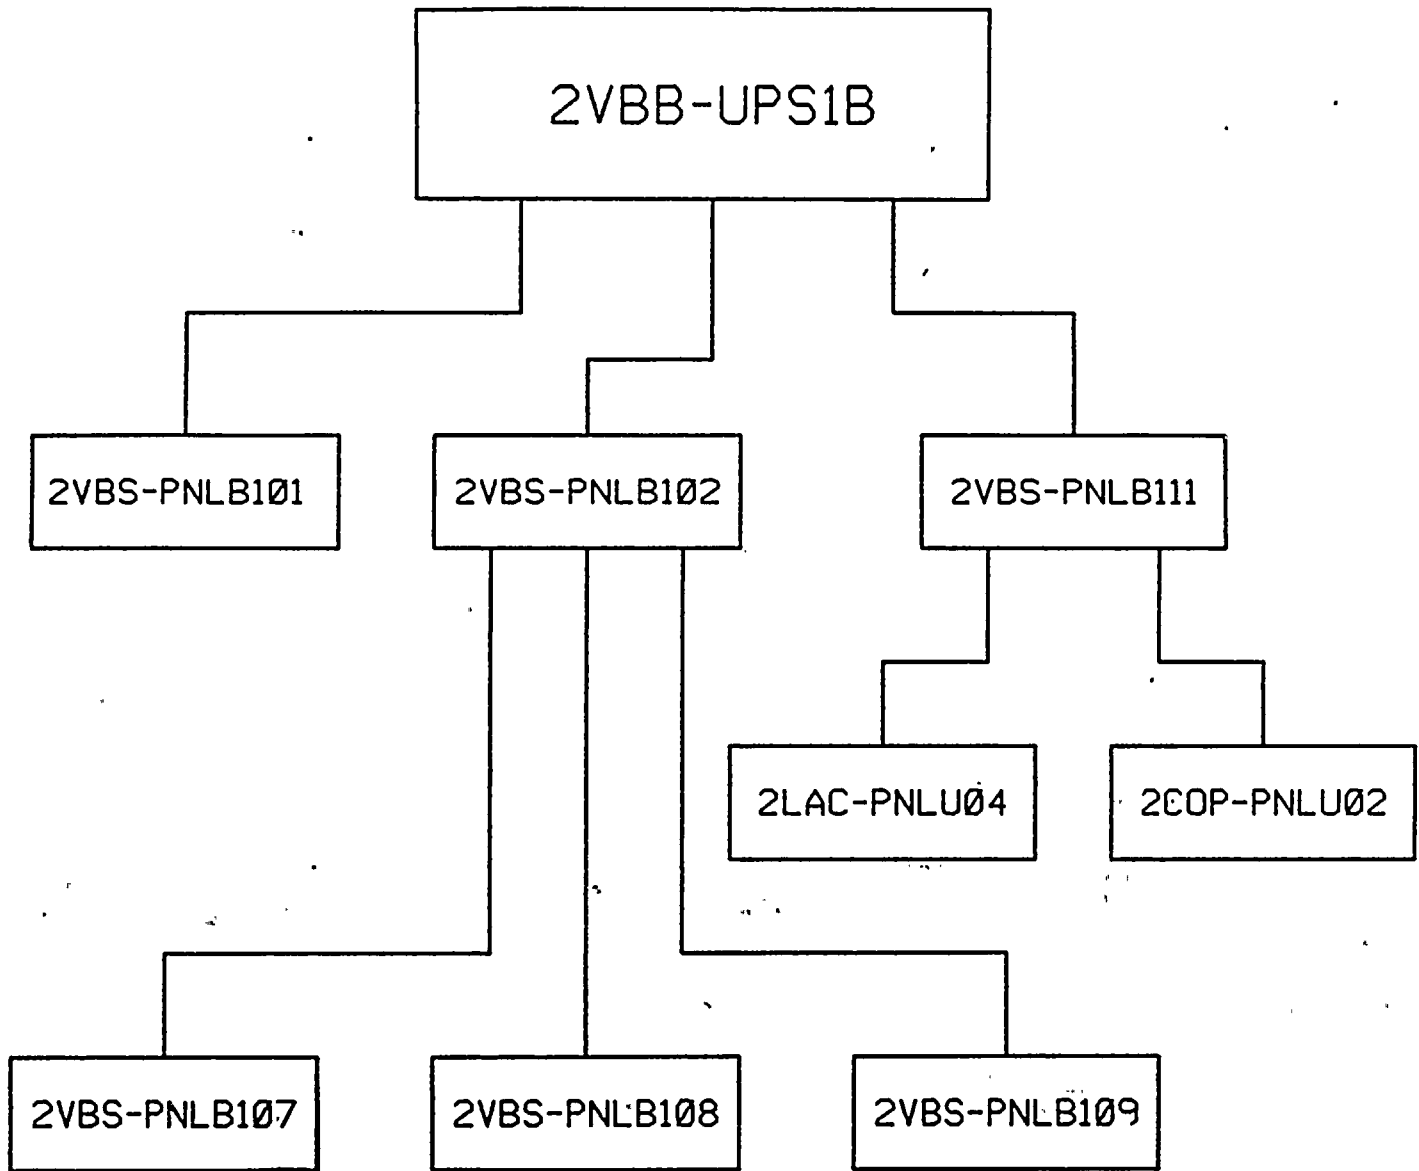

NOTE: THIS DRAWING WAS CREATED USING  
COMPUTER AIDED DRAFTING  
DO NOT MAKE MANUAL CHANGES

NUCLEAR NON-SAFETY RELATED

	NINE MILE POINT NUCLEAR STATION - UNIT 2 SCRUBA, N.Y.	
	LOAD LIST	
	UNINTERRUPTIBLE POWER SUPPLY	
	2VBB-UPS1B	
SCALE NONE		DRAWING NO AE-100E

1	9-91	JPH	ORIGINAL ISSUE- AS BUILT	5-25	Aug
PK	DATE	BY	DESCRIPTION	CK	APP



# INDEX

PANEL	BKR. NO.	SHEET NO.
BS-PNLB101 ↓	1	5
	2	6
	3	7
	4	8
	5	9,10
	6	11,12
	7	13
	8	14
	9	15,16,17
	10	18
	11	19
	12	20
	13	21
	14	22
	15	23-31
	16	32
	17	33
	18	34
	19	35
	20	36
	21	37,38
	22	39-42
	23	43
	24	44,45
	25	46
	26	47,48,49
	27	50
	28	51
	29	52
	30	53
	31	54
	32	55
	33	56
	34	57
	35	58
	36	59
	37	60
2VBS-PNLB101	38	61

PANEL	BKR. NO.	SHEET NO.
2VBS-PNLB101	39	62,63
2VBS-PNLB101	40	64
2VBS-PNLB102 ↓	1	65
	2	66
	3	67,68,69
	4	70
	5	71
	6	72
	7	73,74,75
	8	76
	9	77
	10	78
	11	79
	12	80
	13	81
	14	82
	15	83
	16	84
	17	85
	18	86
	19	87
	20	88
	21	89
	22	90
	23	91
	24	92
2VBS-PNLB107 ↓	1	93
	2	94
	3	95
	4	96
	5	97

(CONTINUED ON SHEET 3)

2VBB-UPS1B LOAD LIST  
DWG. NO. AE-100E  
SHEET 2 OF 228



# INDEX

PANEL	BKR. NO.	SHEET NO.
1VBS-PNLB107 ↓	6	98
	7	99
	8	100
	9	101
	10	102
	11	103
	12	104
	13	105
	14	106
	15	107
	16	108
	17	109
	18	110
	19	111
	20	112,113
	21	115-119
	22	121
	23	122
	24	123
	25	124
	26	125
	27	126
	28	127
	NOTES	128
	2VBS-PNLB108	1
		129
		2
		130
		3
		131
		4
		132
		5
		133
		6
		134
		7
		135
		8
		136
		9
		137
		10
		138
		11
		139
		12
		140
		13
		141
2VBS-PNLB107		
2VBS-PNLB107		
2VBS-PNLB108		
2VBS-PNLB108		

PANEL	BKR. NO.	SHEET NO.
2VBS-PNL108 ↓	14	142
	15	143
	16	144
	17	145
	18	146
	19	147
	20	148
	21	149
	22	150
	23	151
	24	152
	25	153
	26	154
	27	155
	28	156
	NOTES	157
	2VBS-PNL109	1
		158
		2
		159
		3
		160
		4
		161
		5
		162
		6
		163
		7
		164
		8
		165
		9
		166
		10
		167
		11
		168
		12
		169
		13
		170
		14
		171
		15
		172
		16
		173
2VBS-PNL108		
2VBS-PNL108		
2VBS-PNL109		

(CONTINUED ON SHEET 4)

2VBB-UPS1B LOAD LIST  
DWG. NO. AE-100E  
SHEET 3 OF 228



# INDEX

PANEL	BKR. NO.	SHEET NO.
2VBS-PNL109	17	174
	18	175
	19	176
	20	177
	21	178
	22	179
	23	180
	24	181
	25	182
	26	183
	27	184
	28	185
	NOTES	186
2VBS-PNLB11	1	187
	2	188
	3	189
	4	190
	5	191
	6	192
	7	193
	8	194
	9	195
	10	196
	11	197
	12	198
	13	199
	14	200
	15	201
	16	202
	17	203
	18	204
	19	205
	20	206
	21	207
	22	208
	23	209
	24	210

PANEL	BKR. NO.	SHEET NO.
2VBS-PNLB11	25	211
	26	212
	27	213
	28	214
	29	215
	30	216
	31	217
	32	218
	33	219
	34	220
	35	221
	36	222
	37	223
	38	224
	39	225
	40	226
	41	227
	42	228

2VBB-UPS1B LOAD LIST  
DWG. NO. AE-100E  
SHEET 4 OF 228



1  
2  
1

2

**BKR NO: 1**  
**CIRCUIT NO: N/A**

EE-011Y  
EE-002R  
0007.370-002-006  
0007.370-002-010

[illegible]

**September 10, 1991**

2VBB-UPS1B LOAD LIST  
DWG. NO. AE-100E  
SHEET 5 OF 228



1  
2  
**BKR NO: 2**  
**CIRCUIT NO: N/A**

**EE-11Y**  
**EE-3ET**  
**0007.520-001-555**  
**0007.520-001-544**

[illegible]

**September 10, 1991**

2VBB-UP81B LOAD LIST  
DWG. NO. AE-100E  
SHEET 6 OF 228



20

21

22

23

24

25

26

27

28

29

30



BKR NO: 3  
CIRCUIT NO: 2TMIN10

### DRAWING REFERENCES

EE-11Y  
ESK 7CEC14  
LSK 16-07  
LSK 16-09

[illegible]

**JP81B**

**September 10, 1991**

2VBB-UPS1B LOAD LIST  
DWG. NO. AE-100E  
SHEET 7 OF 228



1

2

3KR NO: 4  
CIRCUIT NO: 2IHAN06

EE-11Y  
ESK-10IHA42, 43  
EE-3DN  
147D7844, SH. 2

[illegible]

**September 10, 1991**

2VBB-UPS1B LOAD LIST  
DWG. NO. AE-100E  
SHEET 8 OF 228







### DRAWING REFERENCES

EE-11Y, EE-3DU,  
ESK-10IHA40  
147D7838 SH. 2  
442X559 (0007.221-001-116 & 105)  
761E79ITY SH.4 (0007.223-001-019)



**September 10, 1991**

2VBB-UPS1B LOAD LIST  
DWG. NO. AE-100E  
SHEET 9 OF 228

11  
12  
13  
14  
15

16  
17  
18  
19  
20  
21  
22  
23  
24  
25

26  
27  
28  
29  
30



0007.221-001-116  
0007.221-001-105

11 NL634	DESCRIPTION
PMS INDICATION	
PMS ALARM	
ERF INPUT	
CR ANNUNCIATION	
LOCAL ANNUNCIATION	
CR INDICATION	
LOCAL INDICATION	
VALVE POSITION	

UPSI B  
September 10, 1991

2VBB-UPS1B LOAD LIST  
DWG. NO. AE-100E  
SHEET 10 OF 228



1

2

### DRAWING REFERENCES

EE-11Y  
EE-3DU  
147D7828  
0007.213-001-019  
0007.221-001-108



**September 10, 1991**

2VBB-UPS1B LOAD LIST  
DWG. NO. AE-100E  
SHEET 11 OF 228



1/2

3

4

5

6

7

8

9

10

11

12

13

14

15

16

17

18

19



UPS NO: 2VBB-UPS1B  
 PNL NO: 2VBS-PNLB101  
 DIST PNL NO: 2CEC-PNL634  
 BKR NO: 6

PLANT IMPACT: LOSS OF POWER TO 2CEC-PNL634

761E791ITY  
 442X559-003  
 0007.221-001-108

LOOP	PMS INDICATION	PMS ALARM	ERF INPUT	CR ANNUNCIATION	LOCAL ANNUNCIATION	CR INDICATION	LOCAL INDICATION	VALVE POSITION	DESCRIPTION/OTHER
FUSE L2 AND N2 0.25A SLOW BURN		X		X					RCS FLUX ESTIMATOR (INOP) TIMER & COUNTER POWER SUPPLY (24VDC) RCS FLOW CONTROL
RECP. #2 FEEDS POWER SUPPLIES NEST 2,3,4,5,8,9,10									RCS FLUX ESTIMATOR INSTRUMENTATION RCS FLOW CONTROL (INOP)
RECP. #2 FEEDS POWER SUPPLIES NEST 2,3,4,5,8,9,10		X		X		X		FL	RCS FLOW CONTROL LOOP B INSTRUMENTATION 2RCS*HYV17B (INOP)
RECP. #2 FEEDS POWER SUPPLIES NEXT 2,3,4,5,8,9,10		X		X		X		FL	2RCS*HYV17B POSITION & VELOCITY CONTROL INSTRUMENTATION (INOP)
RECP. #2 FEEDS POWER SUPPLIES NEXT 2,3,4,5,8,9,10									RCS PUMP B SUCT. TEMP VS. DOME PRESSURE CAVITATION INTERLOCK (INOP)
FUSE PLATE VALIDINE AMP								FL	2RCS*FYV17B POSITION & VELOCITY AMP (INOP)

UPS1B

September 10, 1991

2VBB-UPS1B LOAD LIST  
 DWG. NO. AE-100E  
 SHEET 12 OF 228




























### DRAWING REFERENCES

EE-11Y  
0007.213-001-019  
0007.213-001-027  
147D7828  
0007.213-001-025



**September 10, 1991**

2VBB-UPS1B LOAD LIST  
DWG. NO. AE-100E  
SHEET 13 OF 228



1  
2  
### DRAWING REFERENCES

EE-11Y  
0007.213-001-019  
147D7828  
0007.213-001-022  
0007.213-001-025



**September 10, 1991**

2VBB-UPS1B LOAD LIST  
DWG. NO. AE-100E  
SHEET 14 OF 228

h



### DRAWING REFERENCES

EE-11Y  
EE-3DT  
0007.520-001-393  
0007.520-001-394  
0007.520-001-396  
0007.520-001-397  
0007.520-001-399  
0007.520-001-400  
0007.520-001-401  
0007.213-001-020  
0007.213-001-024  
0007.213-001-025  
0007.213-001-028  
0007.213-001-029  
147D7828



**September 10, 1991**

2VBB-UPS1B LOAD LIST  
DWG. NO. AE-100E  
SHEET 15 OF 228



1

2

3

4

5

6

7

8

9

10

11

12

13

14

15

16

UPS NO: 2VBB-UPS1B  
 PNL NO: 2VBS-PNLB101  
 DIST PNL NO: 2CEC-PNL612  
 BKRR NO: 9

PLANT IMPACT: LOSS OF POWER TO 2CEC-PNL612

LOOP	PMS INDICATION	PMS ALARM	ERF INPUT	CR ANNUNCIATION	LOCAL ANNUNCIATION	CR INDICATION	LOCAL INDICATION	VALVE POSITION	DESCRIPTION/OTHER
B35A-F103 B35-K600 (24VDC POWR)						X			(B35-N005A,B,C,D PRESSURE XMTR) RCS PUMP A&B SEAL WATER PRESSURE
(GE DRAWINGS #761E791TY)						X			(B35-N015A&B DIFF PRESS XMTR) RCS PUMP A&B
(GE DRAWINGS #761E791TY)		X		X		X			(B35-N040 PRESSURE XMTR) RX DOME PRESSURE
(GE DRAWINGS #761E791TY)		X		X					RX VESSEL BOTTOM DRAIN LINE TEMP "A"
GE DRAWINGS #761E791TY)						X		FL	(B35-N050A&B PRESSURE XMTR) DRYWELL PRESSURE RCS FCV A&B MOTION INHIBIT LOGIC ACTUATED
(GE DRAWINGS #761E791TY)	X	X		X					RX VESSEL BOTTOM DRAIN LINE TEMP "B"
(GE DRAWINGS #761E791TY)		X		X					RCS PUMP "A" SUCTION TEMP VS. RX DOME TEMP
(GE DRAWINGS #761E791TY)	X	X		X					RX DOME PRESSURE
(GE DRAWINGS #761E791TY)									RCS PUMP A SUCT TEMP VS. DOME PRESSURE RCS THERMAL SHOCK INTERLOCKS INOP

UPS1B

September 10, 1991

2VBB-UPS1B LOAD LIST  
 DWG. NO. AE-100E  
 SHEET 16 OF 228


[illegible]

14

3



•

2

2



UPS NO: 2VBB-UPS1B  
 PNL NO: 2VBS-PNLB101  
 DIST PNL NO: 2CEC-PNL612  
 BKR NO: 9

PLANT IMPACT: LOSS OF POWER TO 2CEC-PNL612

LOOP	PMS INDICATION	PMS ALARM	ERF INPUT	CR ANNUNCIATION	LOCAL ANNUNCIATION	CR INDICATION	LOCAL INDICATION	VALVE POSITION	DESCRIPTION/OTHER
(GE DRAWINGS #761E791TY)		X		X					RCS PUMP "B" SUCTION TEMP VS. RX DOME TEMP
(GE DRAWINGS #761E791TY)									RCS PUMP B SUCT. TEMP VS. DOME PRESSURE RCS THERMAL SHOCK INTERLOCKS INOP
(GE DRAWINGS #761E791TY)									RCS PUMP A VS. PUMP B SUCT. TEMP RCS THERMAL SHOCK INTERLOCKS INOP
(GE DRAWINGS #761E791TY)									VESSEL BOTTOM DRAIN "A" VS. DOME PRESSURE RCS THERMAL SHOCK INTERLOCKS INOP
(GE DRAWINGS #761E791TY)									VESSEL BOTTOM DRAIN "B" VS. DOME PRESSURE RCS THERMAL SHOCK INTERLOCKS INOP
B35A-F104									RCS THERMAL SHOCK INTERLOCKS (LFMG SET "A" & B TRANSFER LOGIC) INOP
B35A-F1	X								RCS PUMP A & B SUCT. TEMP.

UPS1B

September 10, 1991

2VBB-UPS1B LOAD LIST  
 DWG. NO. AE-100E  
 SHEET 17 OF 228

10  
 11  
3 4 5 

4 CVA

BKR NO: 10  
CIRCUIT NO: 2IHAB02

EE-11Y  
ESK-10IHA40  
D-1034-913  
EE-3BA  
14707845, SH. 2

[illegible]

**September 10, 1991**

2VBB-UPS1B LOAD LIST  
DWG. NO. AE-100E  
SHEET 18 OF 228

1

2

3

4

5

6

7

8

9

10

11

12

13

14

15

16

17

18 19 20 

101 102 103 



3KR NO: 11  
CIRCUIT NO: 2IHAB06

EE-11Y  
EE-3DN  
ESK-101HA42  
0007.521-001-261  
147D7844

[illegible]

**September 10, 1991**

2VBB-UPS1B LOAD LIST  
DWG. NO. AE-100E  
SHEET 19 OF 228



BKR NO: 12  
CIRCUIT NO: 2RDSN11

**EE-11Y**  
**EE-3DE**  
**147D7826**  
**0007.520-001-353**  
**0007.520-001-350**  
**0007.520-001-339**  
**0007.221-001-012**  
**0007.221-001-017**  
**0007.221-001-038**

[illegible]

**September 10, 1991**

2VBB-UPS1B LOAD LIST  
DWG. NO. AE-100E  
SHEET 20 OF 228







### DRAWING REFERENCES

EE-11Y  
EE-3DE  
147D7826  
0007.520-001-314  
0007.241-001-007  
0007.520-001-298



September 10, 1991

2VBB-UPS1B LOAD LIST  
DWG. NO. AE-100E  
SHEET 21 OF 228



KR NO: 14  
CIRCUIT NO: 2M88N21

### DRAWING REFERENCES

EE-11Y  
EE-3DS  
0007.520-001-410  
0007.520-001-407  
0007.520-001-409  
147D7828

[illegible]

**VP81B**

September 10, 1991

2VBB-UPS1B LOAD LIST  
DWG. NO. AE-100E  
SHEET 22 OF 228



**BKR NO: 15**  
**CIRCUIT NO: 2FW8N34**

### DRAWING REFERENCES

EE-11Y  
EE-3DU  
0007.520-001-401  
0007.520-001-400  
0007.520-001-357  
0007.520-001-355  
0007.222-001-005  
0007.520-001-348  
0007.222-001-004  
147D7828

[illegible]

**UP81B**

**September 10, 1991**

2VBB-UPS1B LOAD LIST  
DWG. NO. AE-100E  
SHEET 23 OF 228



100-100














UPS NO: 2VBB-UP81B  
 PNL NO: 2VBS-PNLB101  
 DIST PNL NO: 2CEC-PNL612  
 KR NO: 15

PLANT IMPACT: LOSS OF POWER TO 2CEC-PNL612

LOOP	PMS INDICATION	PMS ALARM	ERF INPUT	CR ANNUNCIATION	LOCAL ANNUNCIATION	CR INDICATION	LOCAL INDICATION	VALVE POSITION	DESCRIPTION/OTHER
C33A-F1 C33-K612 (24VDC PWR)	X					X			(C33-N007 PRESS XMTR) TURBINE STEAM FLOW (INOP)
GE DRAWING 807E160TY	X					X			(C33-N008A PRESS XMTR) RX PRESSURE SIGNAL TO RCS DIFF TEMP CAVITATION INTERLOCK (INOP)
GE DRAWING 807E160TY	X					X			(C33-N008C PRESS XMTR) RX PRESSURE SIGNAL TO RCS DIFF TEMP CAVITATION INTERLOCK (INOP)
GE DRAWING 807E160TY	X					X			(C33-N003D FLOW XMTR) (FEEDWATER CONTROL) MAIN STEAM LINE D (INOP)
GE DRAWING 807E160TY	X					X			(C33-N002A FLOW XMTR) (FEEDWATER CONTROL) FEEDWATER LINE "A" FLOW (INOP)
GE DRAWING 807E160TY	X	X		X		X			(C33-N005 PRESS XMTR) RX PRESS (INOP)
GE DRAWING 807E160TY	X	X		X		X			(C33-N004A LEVEL XMTR) (INOP) RX WATER LEVEL NARROW RANGE "A"

UP81B

September 10, 1991

2VBB-UP81B LOAD LIST  
 DWG. NO. AE-100E  
 SHEET 24 OF 228



1  
2  
UPS NO: 2VBB-UPS1B  
 PNL NO: 2VBS-PNLB101  
 DIST PNL NO: 2CEC-PNL612  
 BKR NO: 15

PLANT IMPACT: LOSS OF POWER TO 2CEC-PNL612

LOOP	PMS INDICATION	PMS ALARM	ERF INPUT	CR ANNUNCIATION	LOCAL ANNUNCIATION	CR INDICATION	LOCAL INDICATION	VALVE POSITION	DESCRIPTION/OTHER
GE DRAWING 807E160TY									STARTUP VALVES TRANSFER TO MANUAL (HALF TRIP) FEEDWATER PUMP/ TURBINE (HALF TRIP)
GE DRAWING 807E160TY	X	X		X		X			FEEDWATER CONTROL 3 ELEMENT CONTROL (INOP)
GE DRAWING 807E160TY						X	FL		2FWS-LV10A
GE DRAWING 807E160TY						X			AUTO/MANUAL TRANSFER (INOP) 2FWS-LV10B (CONTROL STATUS)
GE DRAWING 807E160TY									FEEDWATER CONTROL SINGLE ELEMENT CONTROL (INOP)
GE DRAWING 807E160TY						X			MASTER CONTROLLER 2FWS-LV10A, B & C (INOP)
GE DRAWING 807E160TY									FEEDWATER CONTROL SETPOINT SETDOWN (INOP)
GE DRAWING 761E791TY SH 9									RX PRESSURE VS. VESSEL BOTTOM DRAIN "B" TEMP RCS THERMAL SHOCK INTERLOCKS (INOP)
GE DRAWING 761E791TY SH 9									RX PRESSURE VS. RCS PUMP B SUCT. TEMP RCS THERMAL SHOCK INTERLOCKS (INOP)

UPS1B

September 10, 1991

2VBB-UPS1B LOAD LIST  
 DWG. NO. AE-100E  
 SHEET 25 OF 228



UPS NO: 2VBB-UP81B  
 PNL NO: 2VBS-PNLB101  
 DIST PNL NO: 2CEC-PNL612  
 BKR NO: 15

PLANT IMPACT: LOSS OF POWER TO 2CEC-PNL612

LOOP	PMS INDICATION	PMS ALARM	ERF INPUT	CR ANNUNCIATION	LOCAL ANNUNCIATION	CR INDICATION	LOCAL INDICATION	VALVE POSITION	DESCRIPTION/OTHER
C33A-F4						X			STARTUP VALVES TRANSFER TO MANUAL (HALF TRIP) FEEDWATER PUMP/TURBINE (HALF TRIP)
C33A-F7 C33-K611 (24VDC PWR)	X	X		X		X			(C33-N003A FLOW XMTR) (FEEDWATER CONTROL) STEAM FLOW LINE "A" (INOP)
C33A-F7 C33-K611 (24VDC PWR)	X	X		X		X			(C33-N003B FLOW XMTR) (FEEDWATER CONTROL) STEAM FLOW LINE "B" (INOP)
C33A-F7 C33-K611 (24VDC PWR)	X	X		X		X			(C33-N003C FLOW XMTR) (FEEDWATER CONTROL) STEAM FLOW LINE "C" (INOP)
C33A-F7 C33-K611 (24VDC PWR)								FL	LOW PRESSURE START- UP 2CNM-LV137
C33A-F7 C33-K611 (24VDC PWR)								FL	HIGH PRESSURE START-UP 2FWS-LV55A
C33A-F7 C33-K611 (24VDC PWR)								FL	HIGH PRESSURE START-UP 2FWS-LV55B
C33A-F7 C33-K611 (24VDC PWR)									FEEDWATER CONTROL SETPOINT SETDOWN (INOP)
C33A-F7 C33-K611 (24VDC PWR)									RCS LOW Rx WATER LEVEL 3 & 4 TRIP

UP81B  
 September 10, 1991

2VBB-UP81B LOAD LIST  
 DWG. NO. AE-100E  
 SHEET 26 OF 228



UPS NO: 2VBB-UPS1B  
 PNL NO: 2VBS-PNLB101  
 DIST PNL NO: 2CEC-PNL612  
 KR NO: 15

PLANT IMPACT: LOSS OF POWER TO 2CEC-PNL612

LOOP	PMS INDICATION	PMS ALARM	ERF INPUT	CR ANNUNCIATION	LOCAL ANNUNCIATION	CR INDICATION	LOCAL INDICATION	VALVE POSITION	DESCRIPTION/OTHER
C33A-F7 C33-K611 (24VDC PWR)							FL		2FWS-LV10C
C33A-F7 C33-K611 (24VDC PWR)							FL		2FWS-LV10B
C33A-F7 C33-K611 (24VDC PWR)									FEEDWATER CONTROL START-UP VALVE (HIGH PRESSURE) MASTER CONTROLLER (INOP)
C33A-F7 C33-K611 (24VDC PWR)					X				FEEDWATER CONTROL TOTAL MAIN STEAM FLOW (INOP)
C33A-F7 C33-K611 (24VDC PWR)					X				Rx WATER LEVEL UPSET RANGE (INOP)
C33A-F7 C33-K611 (24VDC PWR)					X				Rx WATER LEVEL NARROW RANGE (INOP)
C33A-F7 C33-K611 (24VDC PWR)					X				FEEDWATER CONTROL TOTAL FEEDWATER FLOW (INOP)
C33A-F7 C33-K611 (24VDC PWR)					X				TURBINE STEAM FLOW (INOP)
C33A-F7 C33-K611 (24VDC PWR)					X				FEEDWATER CONTROL Rx PRESSURE (INOP)
C33A-F7 C33-K611 (24VDC PWR)									FEEDWATER CONTROL Rx WATER LEVEL 3&4 RCS TRIP INPUT "A" & "B" (INOP)

UPS1B

September 10, 1991

2VBB-UPS1B LOAD LIST  
 DWG. NO. AE-100E  
 SHEET 27 OF 228



UPS NO: 2VBB-UPS1B  
 PNL NO: 2VBS-PNLB101  
 DIST PNL NO: 2CEC-PNL612  
 BKR NO: 15

PLANT IMPACT: LOSS OF POWER TO 2CEC-PNL612

LOOP	PMS INDICATION	PMS ALARM	ERF INPUT	CR ANNUNCIATION	LOCAL ANNUNCIATION	CR INDICATION	LOCAL INDICATION	VALVE POSITION	DESCRIPTION/OTHER
C33A-F7 C33-K611 (24VDC PWR)						X			FEEDWATER CONTROL (INOP) FEEDWATER FLOW SIGNAL LINE "A"
C33A-F8 C33-K612 (24VDC PWR)	X	X		X					RX WATER LEVEL 4&7 NARROW RANGE (INOP)
C33A-F8 C33-K612 (24VDC PWR)	X	X		X					RX PRESSURE HIGH (INOP)
C33A-F8 C33-K612 (24VDC PWR)									FEEDWATER CONTROL 3 ELEMENT CONTROL (INOP)
C33A-F8 C33-K612 (24VDC PWR)		X		X					FEEDWATER CONTROL TOTAL MAIN STEAM FLOW (INOP)
C33A-F8 C33-K612 (24VDC PWR)									FEEDWATER CONTROL LOW POWER TRIP INPUT TO REACTOR MANUAL CONTROL (INOP)
C33A-F8 C33-K612 (24VDC PWR)	X					X			FEEDWATER CONTROL MAIN STEAM FLOW LINE "D" (INOP)
C33A-F8 C33-K612 (24VDC PWR)									FEEDWATER CONTROL LOW FEEDWATER FLOW TRIP INPUT TO RCS PUMP "A" & "B" NPSH & POWER INTERLOCKS
C33A-F8 C33-K612 (24VDC PWR)									2FWS-LV10C AUTO CONTROL (INOP)

UPS1B

September 10, 1991

2VBB-UPS1B LOAD LIST  
 DWG. NO. AE-100E  
 SHEET 28 OF 228





UPS NO: 2VBB-UPS1B  
 PNL NO: 2VBS-PNLB101  
 DIST PNL NO: 2CEC-PNL612  
 BKR NO: 15

PLANT IMPACT: LOSS OF POWER TO 2CEC-PNL612

LOOP	PMS INDICATION	PMS ALARM	ERF INPUT	CR ANNUNCIATION	LOCAL ANNUNCIATION	CR INDICATION	LOCAL INDICATION	VALVE POSITION	DESCRIPTION/OTHER
C33A-F8 C33-K612 (24VDC PWR)						X			FEEDWATER CONTROL (INOP) TOTAL FEEDWATER FLOW
C33A-F8 C33-K612 (24VDC PWR)							FL		2FWS-LV10C
C33A-F8 CEE-K612 (24VDC PWR)						X			A/M TRANSFER (INOP) 2CNM-LV137
C33A-F8 C33-K612 (24VDC PWR)						X			FEEDWATER CONTROL HIGH PRESS/LOW FLOW MASTER CONTROLLER A/M TRANSFER (INOP)
C33A-F8 C33-K612 (24VDC PWR)						X			A/M TRANSFER (INOP) 2FWS-LV55A
C33A-F8 C33-K612 (24VDC PWR)						X			A/M TRANSFER (INOP) 2FWS-LV55B
C33A-F9						X			FEEDWATER PUMP CAVITATION INTLK LV10 LIMITER LOGIC (INOP)
C33A-F10						X			FEEDWATER CONTROL SETPOINT SETDOWN LOGIC (INOP)
C33A-F11									LOW FEEDWATER FLOW RCS RUNBACK A&B LOGIC ACTUATED
C33A-F13									2FWS-LV55A, 2FWS- LV55B, 2CNM-LV137 TRANSFER TO MANUAL

UPS1B

September 10, 1991

2VBB-UPS1B LOAD LIST  
 DWG. NO. AE-100E  
 SHEET 29 OF 228





**PLANT IMPACT: LOSS OF POWER TO 2CEC-PNL612**

	DESCRIPTION
01	PMS INDICATION
NL612	PMS ALARM
-	ERF INPUT
	CR ANNUNCIATION
	LOCAL ANNUNCIATION
	CR INDICATION
	LOCAL INDICATION
	VALVE POSITION

[illegible]

**September 10, 1991**

2VBB-UPS1B LOAD LIST  
DWG. NO. AE-100E  
SHEET 30 OF 228



UPS NO: 2VBB-UP81B  
 PNL NO: 2VBS-PNLB101  
 DIST PNL NO: 2CEC\*PNL603  
 BKR NO: 15

PLANT IMPACT: LOSS OF POWER TO 2CEC\*PNL603

LOOP	PMS INDICATION	PMS ALARM	ERF INPUT	CR ANNUNCIATION	LOCAL ANNUNCIATION	CR INDICATION	LOCAL INDICATION	VALVE POSITION	DESCRIPTION/OTHER
C33A-F2A					X				2FWS-LV10A (STATUS)
C33A-F2B					X				2FWS-LV10B (STATUS)
C33A-F2C					X				2FWS-LV10C (STATUS)
C33A-F3A	X			X					2FWS-LV10A CONTROL SIGNAL FAILURE AND ACTUATOR TROUBLE/RESET (INOP)
C33A-F3B	X			X					2FWS-LV10B CONTROL SIGNAL FAILURE AND ACTUATOR TROUBLE/RESET (INOP)
C33A-F3C	X			X					2FWS-LV10C CONTROL SIGNAL FAILURE AND ACTUATOR TROUBLE/RESET (INOP)

UP81B

September 10, 1991

2VBB-UP81B LOAD LIST  
 DWG. NO. AE-100E  
 SHEET 31 OF 228



100





















BKR NO: 16  
CIRCUIT NO: 2CECB26

EE-11Y  
EE-EAG  
EE-3B  
0007.159-451-317  
0007.159-451-319  
147D7836

UP81B  
September 10, 1991

2VBB-UPS1B LOAD LIST  
DWG. NO. AE-100E  
SHEET 32 OF 228



12

13

14

15

16

17

18

19

20

21

22



UPS NO: 2VBB-UPS1B  
PNL NO: 2VBS-PNLB101

PKR NO: 17  
CIRCUIT NO: 2WCSN25

DRAWING REFERENCES

147D7830  
EE-11Y  
EE-3CV  
0007.520-001-446  
0007.520-001-462  
0007.224-001-003  
0007.224-001-006

FEED TO DEVICE	DEVICE LOCATION		PLANT IMPACT
	BLDG	ELEV	
2CEC*PNL705 JB402	CCR	306	
E31A-W049 2CEC-PNL632	CCR	306	POWER FAILURE TO ANALOG ISOLATOR ASSEMBLY AT13 & AT12
2WCS-FI602 (G33-R602)	CCR	306	LOSS OF RWCU SYSTEM DUMP FLOW INDICATION
G33-R609	CCR	306	LOSS OF RWCU SYSTEM INLET FLOW INDICATION
MSSFA101			LOSS OF RWCU SYSTEM PMS FLOW INDICATION

UPS1B

September 10, 1991

2VBB-UPS1B LOAD LIST  
DWG. NO. AE-100E  
SHEET 33 OF 228



BKR NO: 18  
CIRCUIT NO: 2CECB88

147D7836  
EE-11Y  
EE-AG  
EE-3N  
0007.159-451-407  
0007.159-451-408

[illegible]

**September 10, 1991**

2VBB-UPS1B LOAD LIST  
DWG. NO. AE-100E  
SHEET 34 OF 228



KR NO: 19  
CIRCUIT NO: N/A

## EE-11Y

[illegible]

**September 10, 1991**

2VBB-UPS1B LOAD LIST  
DWG. NO. AE-100E  
SHEET 35 OF 228

1

2

UPS NO: 2VBB-UPS1B  
PNL NO: 2VBS-PNLB101

DRAWING REFERENCES  
EE-11Y

BRK NO: 20  
CIRCUIT NO: N/A

FEED TO DEVICE	<u>DEVICE LOCATION</u>		PLANT IMPACT
	BLDG	ELEV	
SPARE			

UPS1B  
September 10, 1991

2VBB-UPS1B LOAD LIST  
DWG. NO. AE-100E  
SHEET 36 OF 228





UPS NO: 2VBB-UPS1B  
 PNL NO: 2VBS-PNLB101  
 BKR NO: 21  
 CIRCUIT NO: 2CECNO6, 2CECN04, 2CECNO2

DRAWING REFERENCES

EE-11Y  
 ESK-7CEC01  
 LSK-32-09D  
 LSK-23-06C  
 LSK-09-01D  
 LSK-21-02B  
 ESK-7CEC14, SH. 1  
 LSK-33-02A  
 LSK-22-22  
 EE-3BE  
 147D7846, SH. 2

FEED TO DEVICE	DEVICE LOCATION		PLANT IMPACT
	BLDG	ELEV	
2CEC*PNL741 JB103	CCR	306	
2CEC-W056 2CEC*PNL873 PWS2-CECN06	CCR	306	POWER SUPPLY FOR CHART DRIVES & RECORDERS
2CEC*PNL873 2DER-FR101	CCR	306	LOSS OF DW EQUIP. DRAINS LEAK RATE RECORDER INDICATION
2CEC*PNL873 2DER-LR101/FR123	CCR	306	LOSS OF DW EQUIP DRN TANK 2DER-TK1 LEVEL RECORDER. LOSS OF DW EQUIP DRN PMP 3A/B FLOW RECORDER.
2CEC*PNL873 2DFR-FR106	CCR	306	LOSS OF DW FLR DRN LEAK RATE RECORDER.
2CEC*PNL873 2DFR-LR106/FR137	CCR	306	LOSS OF DW FLR DRN TANK 2DER-TK1 LVL RECORDER. LOSS OF DW FLR DRN P1A/B PUMP FLOW RATE RECORDER.
2CEC*PNL873 2CCP-FR266	CCR	306	LOSS OF RBCLCW FLOW TO DW UNIT COOLERS RECORDER.
2CEC*PNL603 2SSR-CR124/AR125	CCR	306	LOSS OF CRD PUMP DISCH SAMPLE CONDUCTIVITY RECORDER/LOSS OF CRD PUMP DISCH SAMPLE 02 CONC RECORDER
2CEC*PNL873 2CEC-LU101	CCR	306	LOSS OF DW FLR & EQP DRN LEAK RATE PROG CONTROLLER

UPS1B

September 10, 1991

2VBB-UPS1B LOAD LIST  
 DWG. NO. AE-100E  
 SHEET 37 OF 228

1

2

3

4

5

6

7

8

9

10

11

12

13

14

15

16

17

18

19

20




## DRAWING REFERENCES

EE-11Y  
ESK-7CEC01  
LSK-32-09D  
LSK-23-06C  
LSK-09-01D  
LSK-21-02B  
ESK-7CEC14, SH. 1  
LSK-33-02A  
LSK-22-22  
EE-3BE  
147D7846, SH. 2



**September 10, 1991**

2VBB-UPS1B LOAD LIST  
DWG. NO. AE-100E  
SHEET 38 OF 228



1  
2  
UPS NO: 2VBB-UPS1B  
 PNL NO: 2VBS-PNLB101  
 BKR NO: 22  
 CIRCUIT NO: 288TN54 -

DRAWING REFERENCES

ESK-788T01	PID-17A	EE-11Y
ESK-788T02	PID-17C	EE-3HE
ESK-788T03	PID-17E	0007.511-989-029
ESK-788T10	PID-17F	0007.511-989-030
LSK-21-1D	LSK-21-1G	

FEED TO DEVICE	DEVICE LOCATION		PLANT IMPACT
	BLDG	ELEV	
2SST-IPNL154	HB	250	LOSS OF POWER TO TURBINE PLANT SAMPLE PANEL 2SST-IPNL154 SEE ATTACHED

UPS1B

September 10, 1991

2VBB-UPS1B LOAD LIST  
 DWG. NO. AE-100E  
 SHEET 39 OF 228



UPS NO: 2VBB-UPS1B  
 PNL NO: 2VBS-PNLB101  
 BKR NO: 22

PLANT IMPACT: LOSS OF POWER TO 2SST-IPNL154

LOOP	PMS INDICATION	PMS ALARM	ERF INPUT	CR ANNUNCIATION	LOCAL ANNUNCIATION	CR INDICATION	LOCAL INDICATION	VALVE POSITION	DESCRIPTION/OTHER
2SST-122 LSK-21-1D		X		X	X			FC	LOW PRESSURE FDW HTR SAMPLE TEMP/LOSS OF CONTROL OF AOV151
2SST-126 LSK-21-1D		X		X	X			FC	6TH PT FDW HTR DISCHARGE SAMPLE TEMP/LOSS OF CONTROL OF AOV152
2SST-118 LSK-21-1D		X		X	X			FC	4TH PT FDW HTR SAMPLE TEMP/LOSS OF CONTROL OF AOV23A/B/C
2SST-156 LSK-21-1D		X		X	X			FC	AUX BOILER STM HDR SAMPLE TEMP/LOSS OF CONTROL OF AOV177
2SST-52A/B/C LSK-21-1D		X		X	X			FC	HTR DRAIN PUMP P1A/B/C DISCH SAMPLE TEMP/LOSS OF CONTROL OF AOV44A/B/C
2SST-136 LSK-21-1D		X		X	X			FC	MAIN STEAM SAMPLE TEMP/LOSS OF CONTROL OF AOV173
2SST-153 LSK-21-1D		X		X	X			FC	CLEAN STEAM REBOILER 2TME-E1A BLOWDOWN SAMPLE TEMP/LOSS OF CONTROL OF AOV174
2SST-165 LSK-21-1D		X		X	X			FC	CLEAN STEAM REBOILER 2TME-E1B BLOWDOWN SAMPLE TEMP/LOSS OF CONTROL OF AOV175

UPS1B

September 10, 1991

2VBB-UPS1B LOAD LIST  
 DWG. NO. AE-100E  
 SHEET 40 OF 228





UPS NO: 2VBB-UP81B  
 PNL NO: 2VBS-PNLB101  
 BKR NO: 22

PLANT IMPACT: LOSS OF POWER TO 2SST-IPNL154

LOOP	PMS INDICATION	PMS ALARM	ERF INPUT	CR ANNUNCIATION	LOCAL ANNUNCIATION	CR INDICATION	LOCAL INDICATION	VALVE POSITION	DESCRIPTION/OTHER
2SST-283 LSK-21-1D		X		X	X				AUX BOILER FEEDPUMP DISCH HDR SAMPLE TEMP/LOSS OF CONTROL OF AOV176
2SST-291 LSK-21-1G		X		X	X			FC	5TH PT HTR DRAIN DISCH SAMPLE TEMP/LOSS OF CONTROL OF AOV61A/B/C
2SST-295 LSK-21-1G		X		X	X			FC	6TH PT HTR DRAIN DISCH SAMPLE TEMP/LOSS OF CONTROL OF AOV62A/B/C
2SST-299 LSK-21-1G		X		X	X			FC	MOISTURE SEP DRAIN RCVR SAMPLE TEMP/LOSS OF CONTROL OF AOV63A/B
2SST-303 LSK-21-1G		X		X	X			FC	MOISTURE SEP DRAIN RCVR SAMPLE TEMP/LOSS OF CONTROL OF AOV64A/B
2SST-L PID-17A							X		COND DMNRLZR INLET SMPLG TEMP IND/LOSS OF TI104
2SST-L PID-17A							X		COND DMNRLZR OUTLET SMPLG TEMP IND/LOSS OF TI110
2SST-L PID-17A							X		COM 6TH PT HTR SMPLG TEMP IND/LOSS OF TI127

UP81B

September 10, 1991

2VBB-UP81B LOAD LIST  
 DWG. NO. AE-1008  
 SHEET 41 OF 228



UPS NO: 2VBB-UP81B  
 PNL NO: 2VBS-PNLB101  
 BKR NO: 22

PLANT IMPACT: LOSS OF POWER TO 2SST-IPNL154

LOOP	PMS INDICATION	PMS ALARM	ERF INPUT	CR ANNUNCIATION	LOCAL ANNUNCIATION	CR INDICATION	LOCAL INDICATION	VALVE POSITION	DESCRIPTION/OTHER
2SST-L PID-17C						X			2HDL-P1A/B/C DISCH SMPLG TEMP IND/LOSS OF TI55A/B/C
2SST-K PID-17E,F						X			MN COND A/B/C SHL WEST SMPLG TEMP IND/LOSS OF TI17A/B/C
2SST-K PID-17E,F						X			MN COND A/B/C SHL EAST SMPLG TEMP IND/LOSS OF TI18A/B/C



UPS NO: 2VBB-UPS1B  
PNL NO: 2VBS-PNLB101

BKR NO: 23  
CIRCUIT NO: 28XSN10

DRAWING REFERENCES

EE-11Y  
ESK-108XS01  
ESK-108XS14

FEED TO DEVICE	DEVICE LOCATION		PLANT IMPACT
	BLDG	ELEV	
GETARS	CCR	306	LOSS OF GETARS

UPS1B  
September 10, 1991

2VBB-UPS1B LOAD LIST  
DWG. NO. AE-100E  
SHEET 43 OF 228



UPS NO: 2VBB-UPS1B  
PNL NO: 2VBS-PNLB101

BKR NO: 24  
CIRCUIT NO: 28STN84

DRAWING REFERENCES

PID-17D  
EE-11Y  
EE-3HE  
0007.510-989-031  
ESK-0788T03

FEED TO DEVICE	DEVICE LOCATION		PLANT IMPACT
	BLDG	ELEV	
2SST-IPNL284 (TB-8, TB-9)	TB	250	LOSS OF TURBINE PLANT SAMPLE PANEL 2SST-IPNL284 INSTRUMENTATION, ANNUNCIATION AND POWER. SEE ATTACHMENT.

UPS1B  
September 10, 1991

2VBB-UPS1B LOAD LIST  
DWG. NO. AE-100E  
SHEET 44 OF 228



1000

1

1000

1

1

1000

1

1



UPS NO: 2VBB-UP81B  
PNL NO: 2VB8-PNLB101

PLANT IMPACT: LOSS OF POWER TO 2SST-IPNL284

SKR NO: 24

LOOP	PMS INDICATION	PMS ALARM	ERF INPUT	CR ANNUNCIATION	LOCAL ANNUNCIATION	CR INDICATION	LOCAL INDICATION	VALVE POSITION	DESCRIPTION/OTHER
2SST-C PID-17D						X			COND DMNRLZR 1A OUTLET SMPLG TEMP IND/LOSS OF TI10A
2SST-C PID-17D						X			COND DMNRLZR 1B OUTLET SMPLG TEMP IND/LOSS OF TI10B
2SST-C PID-17D						X			COND DMNRLZR 1C OUTLET SMPLG TEMP IND/LOSS OF TI10C
2SST-C PID-17D						X			COND DMNRLZR 1D OUTLET SMPLG TEMP IND/LOSS OF TI10D
2SST-C PID-17D						X			COND DMNRLZR 1E OUTLET SMPLG TEMP IND/LOSS OF TI10E
2SST-C PID-17D						X			COND DMNRLZR 1F OUTLET SMPLG TEMP IND/LOSS OF TI10F
2SST-C PID-17D						X			COND DMNRLZR 1G OUTLET SMPLG TEMP IND/LOSS OF TI10G
2SST-C PID-17D						X			COND DMNRLZR 1H OUTLET SMPLG TEMP IND/LOSS OF TI10H
2SST-C PID-17D						X			COND DMNRLZR 1J OUTLET SMPLG TEMP IND/LOSS OF TI10J
2SST-286 PID-17D		X		X	X		X	FC	TURB GEN GLND SEAL & EXHST STM SMPLG TEMP/LOSS OF CONTROL OF AOV287

UP81B

September 10, 1991

2VBB-UP81B LOAD LIST  
DWG. NO. AE-100E  
SHEET 45 OF 228



UPS NO: 2VBB-UPS1B  
PNL NO: 2VBS-PNLB101

DRAWING REFERENCES

EE-11Y  
ESK-10SXS18

BKR NO: 25  
CIRCUIT NO: 2SXS11

FEED TO DEVICE	DEVICE LOCATION		PLANT IMPACT
	BLDG	ELEV	
GETARS	CCR	306	LOSS OF GETARS

UPS1B

September 10, 1991

2VBB-UPS1B LOAD LIST  
DWG. NO. AE-100B  
SHEET 46 OF 228



UPS NO: 2VBB-UPS1B  
PNL NO: 2VBS-PNLB101

BKR NO: 26  
CIRCUIT NO: 2SSTN85

DRAWING REFERENCES

EE-11Y	PID-17A
EE-3HF	PID-17C
0007.510-989-105	PID-17D
0007.510-989-105	PID-17E
0007.510-989-108	PID-17F
0007.510-989-109	
0007.510-989-106	

FEED TO DEVICE	DEVICE LOCATION		PLANT IMPACT
	BLDG	ELEV	
2SST-IPNL285 PTB3-1, PTB3-2	TB	250	LOSS OF POWER TO PANEL 2SST-IPNL285 (TURBINE PLANT SAMPLE PANEL) RESULTING IN LOSS OF CONDUCTIVITY CELL ANNUNCIATION & INDICATION. SEE ATTACHMENT.

UPS1B

September 10, 1991

2VBB-UPS1B LOAD LIST  
DWG. NO. AE-100E  
SHEET 47 OF 228



1

2

3

4

5

6

7

8

9

10

UPS NO: 2VBB-UPS1B  
PNL NO: 2VBS-PNLB101

PLANT IMPACT: LOSS OF POWER TO 2SST-IPNL285

BKR NO: 26

LOOP	PMS INDICATION	PMS ALARM	ERF INPUT	CR ANNUNCIATION	LOCAL ANNUNCIATION	CR INDICATION	LOCAL INDICATION	VALVE POSITION	DESCRIPTION/OTHER
2SST-113 LSK-21-1B		X		X	X	X	X		CNDS DMNRLZR OUTLET SAMPLE OXYGEN IND/LOSS OF AIT113
2SST-132 LSK-21-1C		X		X	X	X	X		COM 6TH PT HTR OUTLET SAMPLE OXYGEN IND/LOSS OF AIT132
2SST-133 LSK-21-1C		X		X	X	X	X		COM 6TH PT HTR OUTLET SAMPLE PH IND/LOSS OF AIT133
2SST-131 LSK-21-1B		X		X	X	X	X		COM 6TH PT HTR OUTLET SAMPLE CNDT IND/LOSS OF CIT131
2SST-114 LSK-21-1B		X		X	X	X	X		CNDS DMNRLZR OUTLET SAMPLE CNDT IND/LOSS OF CIT114
2SST-106 LSK-21-1A		X		X	X	X	X		CNDS DMNRLZR INLET SAMPLE CNDT IND/LOSS OF CIT106
2SST-53 LSK-21-1D		X		X	X		X		LP FDW HTR DRN PUMP 1A/1B/1C SMPL CNDT IND/LOSS OF CIT53A/B/C
2SST-22 LSK-21-1A		X		X	X		X		MN COND A/B/C SHELL EAST HLF CNDT IND/LOSS OF CIT22A/B/C
2SST-21 LSK-21-1A		X		X	X		X		MN COND A/B/C SHELL WEST HLF CNDT IND/LOSS OF CIT21A/B/C

UPS1B

September 10, 1991

2VBB-UPS1B LOAD LIST  
DWG. NO. AE-100E  
SHEET 48 OF 228



6  
17  
18

19

20  
21  
22  
23

24

25

26

27

28

29

30





UPS NO: 2VBB-UPS1B  
PNL NO: 2VBS-PNLB101

PLANT IMPACT: LOSS OF POWER TO 2SST-IPNL285

BKR NO: 26

LOOP	PMS INDICATION	PMS ALARM	ERE INPUT	CR ANNUNCIATION	LOCAL ANNUNCIATION	CR INDICATION	LOCAL INDICATION	VALVE POSITION	DESCRIPTION/OTHER
2SST-58 LSK-21-1E		X		X	X		X		CNDS DMNRLZR 1A THRU 1J EFFLUENT CNDT IND/LOSS OF CIT58A THRU 58J
2SST-50 LSK-21-1D		X		X	X	X	X		LP FDW HTR DRN PUMP 1A/1B/1C SMPL TURBIDITY IND/LOSS OF AIT50A/B/C
2SST-142 LSK-21-1C		X		X	X	X	X		CNDS DMNRLZR INLET SAMPLE TURBIDITY IND/LOSS OF AIT142

UPS1B

September 10, 1991

2VBB-UPS1B LOAD LIST  
DWG. NO. AE-100E  
SHEET 49 OF 228



UPS NO: 2VBB-UPS1B  
PNL NO: 2VBS-PNLB101

DRAWING REFERENCES

EE-11Y  
ESK-108X816

BRK NO: 27  
CIRCUIT NO: 28X8N08

FEED TO DEVICE	DEVICE LOCATION		PLANT IMPACT
	BLDG	ELEV	
GETARS	CCR	306	LOSS OF GETARS

UPS1B

September 10, 1991

2VBB-UPS1B LOAD LIST  
DWG. NO. AE-100E  
SHEET 50 OF 228



UPS NO: 2VBB-UPS1B  
PNL NO: 2VBS-PNLB101

DRAWING REFERENCES

EE-11Y  
ESK-108XS15

BKR NO: 28  
CIRCUIT NO: 28XSN07

FEED TO DEVICE	DEVICE LOCATION		PLANT IMPACT
	BLDG	ELEV	
GETARS	CCR	306	LOSS OF GETARS

UPS1B

September 10, 1991

2VBB-UPS1B LOAD LIST  
DWG. NO. AE-100E  
SHEET 51 OF 228



UPS NO: 2VBB-UPS1B  
PNL NO: 2VBS-PNLB101  
BKR NO: 29  
CIRCUIT NO: N/A

DRAWING REFERENCES  
EE-11Y

FEED TO DEVICE	<u>DEVICE LOCATION</u>		PLANT IMPACT
	BLDG	ELEV	
SPARE			

UPS1B  
September 10, 1991

2VBB-UPS1B LOAD LIST  
DWG. NO. AE-100E  
SHEET 52 OF 228





UPS NO: 2VBB-UPS1B  
PNL NO: 2VBS-PNLB101  
BKR NO: 30  
CIRCUIT NO: N/A

DRAWING REFERENCES  
EE-11Y

FEED TO DEVICE	<u>DEVICE LOCATION</u>		PLANT IMPACT
	BLDG	ELEV	
SPARE			

UPS1B  
September 10, 1991

2VBB-UPS1B LOAD LIST  
DWG. NO. AE-100E  
SHEET 53 OF 228

1

2

UPS NO: 2VBB-UPS1B  
PNL NO: 2VBS-PNLB101  
BKR NO: 31  
CIRCUIT NO: N/A

DRAWING REFERENCES  
EE-11Y

FEED TO DEVICE	DEVICE LOCATION		PLANT IMPACT
	BLDG	ELEV	
SPARE			

UPS1B  
September 10, 1991

2VBB-UPS1B LOAD LIST  
DWG. NO. AE-100E  
SHEET 54 OF 228



UPS NO: 2VBB-UPS1B  
PNL NO: 2VBS-PNLB101  
BKR NO: 32  
CIRCUIT NO: N/A

DRAWING REFERENCES  
EE-11Y

FEED TO DEVICE	DEVICE LOCATION		PLANT IMPACT
	BLDG	ELEV	
SPARE			

UPS1B

September 10, 1991

2VBB-UPS1B LOAD LIST  
DWG. NO. AE-100E  
SHEET 55 OF 228



UPS NO: 2VBB-UPS1B  
PNL NO: 2VBS-PNLB101  
BKR NO: 33  
CIRCUIT NO: N/A

DRAWING REFERENCES  
EE-11Y

FEED TO DEVICE	DEVICE LOCATION		PLANT IMPACT
	BLDG	ELEV	
SPARE			

UPS1B

September 10, 1991

2VBB-UPS1B LOAD LIST  
DWG. NO. AE-100E  
SHEET 56 OF 228



1  
2  
3  
4  
5  
6  
7  
8  
9  
10



UPS NO: 2VBB-UP81B  
PNL NO: 2VBS-PNLB101  
BKR NO: 34  
CIRCUIT NO: N/A

DRAWING REFERENCES  
EE-11Y

FEED TO DEVICE	DEVICE LOCATION		PLANT IMPACT
	BLDG	ELEV	
SPARE			

UP81B  
September 10, 1991

2VBB-UP81B LOAD LIST  
DWG. NO. AE-100E  
SHEET 57 OF 228



1

2

3

4

5

6

7

8

9

10



11



UPS NO: 2VBB-UPS1B  
PNL NO: 2VBS-PNLB101  
BKR NO: 35  
CIRCUIT NO: N/A

DRAWING REFERENCES  
EE-11Y

FEED TO DEVICE	DEVICE LOCATION		PLANT IMPACT
	BLDG	ELEV	
SPARE			

UPS1B

September 10, 1991

2VBB-UPS1B LOAD LIST  
DWG. NO. AE-100E  
SHEET 58 OF 228



UPS NO: 2VBB-UPS1B  
PNL NO: 2VBS-PNLB101  
BKR NO: 36  
CIRCUIT NO: N/A

DRAWING REFERENCES  
EE-11Y

FEED TO DEVICE	DEVICE LOCATION		PLANT IMPACT
	BLDG	ELEV	
SPARE			

UPS1B

September 10, 1991

2VBB-UPS1B LOAD LIST  
DWG. NO. AE-100E  
SHEET 59 OF 228



BKR NO: 37  
CIRCUIT NO: 2IHAN02

EE-11Y  
ESK-10IHA40  
EE-3BA  
147D7845

UP81B  
September 10, 1991

2VBB-UPS1B LOAD LIST  
DWG. NO. AE-100E  
SHEET 60 OF 228





PNL NO: 2VB8-PNLB101

### DRAWING REFERENCES

**EE-11Y**

**ESK-10IHA40**

**ABKR NO: 38**

**CIRCUIT NO: 2IHAB07**

[illegible]

**UP81B**

**September 10, 1991**

## 2VBB-UP81B LOAD LIST

**DWG. NO. AE-100B**

**SHEET 61 OF 228**



UPS NO: 2VBB-UPS1B  
PNL NO: 2VBS-PNLB101

DRAWING REFERENCES

BKR NO: 39  
CIRCUIT NO: 2SWPN52

EE-11Y  
ESK-7SWP30 THRU 36  
LSK 9-10AB  
ESK 11SWP03

FEED TO DEVICE	DEVICE LOCATION		PLANT IMPACT
	BLDG	ELEV	
2SWP-MOV583	TB	319	2HVT-UC222B OUTLET VAC BKR. LOSS OF INDICATION LIGHTS. FAIL AS IS.
2SWP-MOV586	TB	329	2HVT-UC221A&B, UC219 AND UC220 OUTLET VAC BKR. LOSS OF INDICATING LIGHTS. FAIL AS IS.
2SWP-MOV596	TB	303	CHILLER BUILDING VAC BKR. LOSS OF INDICATION LIGHTS. FAIL AS IS.
2SWP-MOV584	TB	319	2HVR-UC222C OUTLET VAC BKR. LOSS OF INDICATION LIGHTS. FAIL AS IS.
2SWP-MOV587	TB	280	2HVT-UC216B OUTLET VAC BKR. LOSS OF INDICATION LIGHTS. FAIL AS IS.
2SWP-MOV597	TB	301	CHILLER BUILDING VAC BKR. LOSS OF INDICATION LIGHTS. FAIL AS IS.
2SWP-MOV585	TB	320	2HVT-UC222A OUTLET VAC BKR. LOSS OF INDICATION LIGHTS. FAIL AS IS.
2SWP-MOV588	TB	303	2HVT-UC225 OUTLET VAC BKR. LOSS OF INDICATION LIGHTS. FAIL AS IS.
2SWP-MOV589	TB	323	2HVT-UC223A OUTLET VAC BKR. LOSS OF INDICATION LIGHTS. FAIL AS IS.
2SWP-MOV591	TB	322	2HVT-UC222D OUTLET VAC BKR. LOSS OF INDICATION LIGHTS. FAIL AS IS.

UPS1B

September 10, 1991

2VBB-UPS1B LOAD LIST  
DWG. NO. AE-100E  
SHEET 62 OF 228



UPS NO: 2VBB-UPS1B  
PNL NO: 2VBS-PNLB101

DRAWING REFERENCES

BKR NO: 39  
CIRCUIT NO: 2SWPN52

EE-11Y  
ESK-78WP30 THRU 36  
LSK 9-10AB  
ESK 118WP03

FEED TO DEVICE	DEVICE LOCATION		PLANT IMPACT
	BLDG	ELEV	
2SWP-MOV592	TB	319	2HVT-UC222E OUTLET VAC BKR. LOSS OF INDICATION LIGHTS. FAIL AS IS
2SWP-MOV590	TB	329	2HVT-UC223B OUTLET VAC BKR. LOSS OF INDICATION LIGHTS. FAIL AS IS.
2SWP-MOV593	TB	319	2HVT-UC223F OUTLET VAC BKR. LOSS OF INDICATION LIGHTS. FAIL AS IS.
2SWP-MOV594	TB	294	2HVT-UC218E OUTLET VAC BKR. LOSS OF INDICATION LIGHTS. FAIL AS IS.
2SWP-MOV598	SC	312	REACTOR BUILDING VAC BKR. LOSS OF INDICATION LIGHTS. FAIL AS IS.
2SWP-MOV595	SC	296	2HVT-UC217B OUTLET VAC BKR. LOSS OF INDICATION LIGHTS. FAIL AS IS.
2SWP-MOV582	SC	312	REACTOR BUILDING VAC BKR. LOSS OF INDICATION LIGHTS. FAIL AS IS.

UPS1B

September 10, 1991

2VBB-UPS1B LOAD LIST  
DWG. NO. AE-100E  
SHEET 63 OF 228



UPS NO: 2VBB-UPS1B  
PNL NO: 2VBS-PNLB101  
BKR NO: 40  
CIRCUIT NO: N/A

DRAWING REFERENCES  
EE-11Y

FEED TO DEVICE	<u>DEVICE LOCATION</u>		PLANT IMPACT
	BLDG	ELEV	
SPARE			

UPS1B

September 10, 1991

2VBB-UPS1B LOAD LIST  
DWG. NO. AE-100E  
SHEET 64 OF 228





UPS NO: 2VBB-UPS1B  
PNL NO: 2VBS-PNLB102  
BKR NO: 1  
CIRCUIT NO: N/A

### DRAWING REFERENCES

**EE-11Y 147D7829**

**EE-3CR**

**7.520-001-402**

[illegible]

**UP81B**

**September 10, 1991**

## 2VBB-UP81B LOAD LIST

DWG. NO. AE-100E

**SHEET 65 OF 228**

1

2

3

4

5

6

7

8

9

10

11

12

13

14

15

16

17

EE-11Y  
E&DCR Z21002C  
E&DCR Z21003  
N2OP-763



2VBB-UPS1B LOAD LIST  
DWG. NO. AE-100E  
SHEET 66 OF 228

1

2

3

4

5

6

7

8

9

10

11

UPS NO: 2VBB-UPS1B  
 PNL NO: 2VBS-PNLB102  
 BKR NO: 3  
 CIRCUIT NO: 2WCSN21

DRAWING REFERENCES

147D7829  
 7.212-001-012  
 EE-11Y  
 EE-3CR  
 7.520-001-402  
 7.520-001-403  
 7.224-001-035  
 7.224-001-020  
 1.764-001-021

FEED TO DEVICE	DEVICE LOCATION		PLANT IMPACT
	BLDG	ELEV	
2CEC*PNL704 JB406	CCR	306	
G33A-W022 2CEC-PNL613	CCR	306	
G33A-W001 2CEC*PNL602	CCR	306	
C51-W264 2CEC*PNL603	CCR	306	
B22A-W025 2CEC-PNL619	CCR	306	
B22A-W014 2CEC-PNL614	CCR	306	
K600-2WCSN21 120V PWR SUPPLY	CCR	306	PWR SUPPLY TO K1A & K1B-2WCSN21 VIA G33A-F4
K1A-2WCSN21 RELAY	CCR	306	LOSS OF ALARM RELAY PUMP INLET TEMP RWCU PUMP SEAL GLAND PLATE
K1B-2WCSN21 RELAY	CCR	306	LOSS OF ALARM RELAY PUMP INLET TEMP RWCU PUMP SEAL GLAND PLATE. SEE ATTACHED.

UPS1B

September 10, 1991

2VBB-UPS1B LOAD LIST  
 DWG. NO. AE-100E  
 SHEET 67 OF 228



1  
2  
UPS NO: 2VBB-UPS1B  
 PNL NO: 2VBS-PNLB102  
 BKR NO: 3

PLANT IMPACT: LOSS OF POWER TO: POWER SUPPLY G33-K600

LOOP	PMS INDICATION	PMS ALARM	ERF INPUT	CR ANNUNCIATION	LOCAL ANNUNCIATION	CR INDICATION	LOCAL INDICATION	VALVE POSITION	DESCRIPTION/OTHER
G33-R613A						X			RECORDER FOR RX WTR CLNUP FLTR DEMIN INFLUENT
G33-R613B						X			RECORDER FOR RX RECIRC INFLUENT A
G33-K601						X			CLEANUP SYS TEMP INDICATION
G33-N602	X	X		X		X	X		CONDUCTIVITY ALARM SWITCH FOR FLTR DEMIN INFLUENT
G33-N603A	X	X		X	X	X	X		CONDUCTIVITY ALARM FLTR A DEMIN EFFLUENT
G33-N603B	X	X		X	X	X	X		CONDUCTIVITY ALARM FLTR B DEMIN EFFLUENT
G33-N603C	X	X		X	X	X	X		CONDUCTIVITY ALARM FLTR C DEMIN EFFLUENT
G33-N603D	X	X		X	X	X	X		CONDUCTIVITY ALARM FLTR D DEMIN EFFLUENT
G33-SRU1						X			BOTTOM HEAD DRAIN FLOW INDICATION
G33-SRU1						X			REGEN HT EX INLET PRESS INDICATION
G33-R606								FC	2WCS-FV135 DUMP VLV MANUAL CONTROL
B22-K616		X		X		X			HEAD STUD CORE TEMP

UPS1B

September 10, 1991

2VBB-UPS1B LOAD LIST  
 DWG. NO. AE-100E  
 SHEET 68 OF 228





UPS NO: 2VBB-UPS1B  
 PNL NO: 2VBS-PNLB102  
 BKR NO: 3

PLANT IMPACT: LOSS OF POWER TO: POWER SUPPLY G33-K600

LOOP	PMS INDICATION	PMS ALARM	ERF INPUT	CR ANNUNCIATION	LOCAL ANNUNCIATION	CR INDICATION	LOCAL INDICATION	VALVE POSITION	DESCRIPTION/OTHER
B22-N606	X	X		X		X			FW TURBIDITY SWITCH-ALARM
B22-SRU1						X			B22-R605 SHUTDOWN RANGE REACTOR VESSEL LEVEL IND
B22-K617		X		X		X			BOTTOM HEAD TEMP
B22-K618		X		X		X			SHELL FLANGE TEMP
B22-K620		X		X		X			BOTTOM HEAD DRAIN TEMP
B22-N648		X		X		X			TEMP SWITCH FOR HEAD STUD CORE
B22-N649		X		X		X			TEMP SWITCH FOR BOTTOM HEAD
B22-N650		X		X		X			TEMP SWITCH FOR SHELL FLANGE
B22-N652		X		X		X			TEMP SWITCH FOR BOTTOM HEAD DRAIN
B22-R622						X			FW TURBIDITY RECORDER
B35-R614						X			RECIRC FLOW RECORDER
C51-R602						X			SRM RECORDER
C51-R603A						X			IRM/APRM RECORDER
C51-R603B						X			IRM/APRM RECORDER
C51-R603C						X			IRM/APRM/RBM RECORDER
C51-R603D						X			IRM/APRM/RBM RECORDER

UPS1B

September 10, 1991

2VBB-UPS1B LOAD LIST  
 DWG. NO. AE-100E  
 SHEET 69 OF 228

1  
2  
EE-11Y  
EE-3AJ  
7.159-451-328  
7.159-451-327



2VBB-UPS1B LOAD LIST  
DWG. NO. AE-100E  
SHEET 70 OF 228





EE-11Y  
7.511-414-168

**7.511-414-168**

**SHEET 71 OF 228**





EE-11Y  
7.159-451-334



2VBB-UPS1B LOAD LIST  
DWG. NO. AE-100E  
SHEET 72 OF 228



1

2

3

4

5

6

7

8

9

10

11

12

13

14





### DRAWING REFERENCES

EE-11Y  
EE-3HH  
7.511-989-110  
7.511-989-111

[illegible]

September 10, 1991

2VBB-UPS1B LOAD LIST  
DWG. NO. AE-100E  
SHEET 73 OF 228



5

4

3

2

1

0

9

UPS NO: 2VBB-UPS1B  
 PNL NO: 2VBS-PNLB102  
 BKR NO: 7

PLANT IMPACT: LOSS OF POWER TO: 2SSR-INPL145

PMS INDICATION  
 PMS ALARM  
 ERF INPUT  
 CR ANNUNCIATION  
 LOCAL ANNUNCIATION  
 CR INDICATION  
 LOCAL INDICATION  
 VALVE POSITION

LOOP									DESCRIPTION/OTHER
2SSR-124 LSK-21-2B	X	X		X	X	X	X		CONTROL ROD DRIVE PUMP DISCH SAMPLE CONDUCTIVITY
2SSR-113 LSK-21-2A	X	X		X	X	X	X		REACTOR RECIRC INFLUENT A SAMPLE CONDUCTIVITY
2SSR-6A, B, C, D LSK-21-2A	X	X		X	X	X	X		RWCU FILTER DEMIN 4A, B, C, D OUTLET CONDUCTIVITY
2SSR-106 LSK-21-2A	X			X		X	X		RWCU FILTER DEMIN INFLUENT SAMPLE CONDUCTIVITY
2SFC-146 LSK-34-2D	X	X		X	X		X		SPENT FUEL POOL COOLING POOL CONDUCTIVITY
2SSR-AIT125 LSK-21-2B	X	X		X	X		X		CONTROL ROD DRIVE PUMP DISCH SAMPLE OXYGEN CONCENTRATION
2SSR-AIT14B LSK-21-2C	X	X		X	X	X	X		REACTOR RECIRC INFLUENT A SAMPLE OXYGEN
2SSR-AIT130 LSK-21-2B	X	X		X	X	X	X		RWCU FILTER DEMIN INFLUENT SAMPLE OXYGEN CONCENTRATION
2SSR-AIT156 LSK-21-2C	X	X		X	X		X		CONTROL ROD DRIVE COMMON FLTR DISCH TURBIDITY
2SSR-TIS9A, B LSK-21-2D		X		X	X		X		RHS HT EXCH E1A, 1B DISCH SAMPLE TEMP

UPS1B

September 10, 1991

2VBB-UPS1B LOAD LIST  
 DWG. NO. AE-100E  
 SHEET 74 OF 228



42

2

4

0

8

2

6

PLANT IMPACT: LOSS OF POWER TO: 288R-IPNL145

**BKR NO: 7**

DESCRIPTION	LOCATION	STATUS	REMARKS
PMS INDICATION			
PMS ALARM			
ERF INPUT			
CR ANNUNCIATION			
LOCAL ANNUNCIATION			
CR INDICATION			
LOCAL INDICATION			
VALVE POSITION			

[illegible]

2VBB-UPS1B LOAD LIST  
DWG. NO. AE-100E  
SHEET 75 OF 228





1470-7827, SH 2  
EE-3CM, 3LM  
EE-11Y  
400B07-001, SH.4&6  
400B07-002, SH.4&6  
400B07-003, SH. 4&6  
400B07-004, SH. 4&6



2VBB-UPS1B LOAD LIST  
DWG. NO. AE-100E  
SHEET 76 OF 228





UPS NO: 2VBB-UPS1B  
PNL NO: 2VBS-PNLB102  
BKR NO: 9  
CIRCUIT NO: N/A

DRAWING REFERENCES  
EE-11Y

FEED TO DEVICE	<u>DEVICE LOCATION</u>		PLANT IMPACT
	BLDG	ELEV	
SPARE			

UPS1B  
September 10, 1991

2VBB-UPS1B LOAD LIST  
DWG. NO. AE-100E  
SHEET 77 OF 228





EE-1A, 3ER,	EE-11Y
EE-27B, 402R	EE-3AW
ESK-7DRS01	
ESK-11DRS01	
ESK-6DRS01,2,3&4	



2VBB-UPS1B LOAD LIST  
DWG. NO. AE-100E  
SHEET 78 OF 228



UPS NO: 2VBB-UPS1B  
PNL NO: 2VBS-PNLB102  
BKR NO: 11  
CIRCUIT NO: N/A

DRAWING REFERENCES  
EE-11Y

FEED TO DEVICE	DEVICE LOCATION		PLANT IMPACT
	BLDG	ELEV	
SPARE			

UPS1B  
September 10, 1991

2VBB-UPS1B LOAD LIST  
DWG. NO. AE-100E  
SHEET 79 OF 228



1  
2  
UPS NO: 2VBB-UPS1B  
PNL NO: 2VBS-PNLB102  
BKR NO: 12  
CIRCUIT NO: N/A

DRAWING REFERENCES  
EE-11Y

FEED TO DEVICE	DEVICE LOCATION		PLANT IMPACT
	BLDG	ELEV	
SPARE			

UPS1B

September 10, 1991

2VBB-UPS1B LOAD LIST  
DWG. NO. AE-100E  
SHEET 80 OF 228



1  
2  
3

4  
5  
6  
7  
8





UPS NO: 2VBB-UPS1B  
PNL NO: 2VBS-PNLB102  
BKR NO: 13  
CIRCUIT NO: N/A

DRAWING REFERENCES  
EE-11Y

FEED TO DEVICE	DEVICE LOCATION		PLANT IMPACT
	BLDG	ELEV	
SPARE			

UPS1B  
September 10, 1991

2VBB-UPS1B LOAD LIST  
DWG. NO. AE-100E  
SHEET 81 OF 228



UPS NO: 2VBB-UPS1B  
PNL NO: 2VBS-PNLB102  
BKR NO: 14  
CIRCUIT NO: N/A

DRAWING REFERENCES  
EE-11Y

FEED TO DEVICE	DEVICE LOCATION		PLANT IMPACT
	BLDG	ELEV	
SPARE			



UPS NO: 2VBB-UPS1B  
PNL NO: 2VBS-PNLB102  
BKR NO: 15  
CIRCUIT NO: N/A

DRAWING REFERENCES  
EE-11Y

FEED TO DEVICE	DEVICE LOCATION		PLANT IMPACT
	BLDG	ELEV	
SPARE			

UPS1B

September 10, 1991

2VBB-UPS1B LOAD LIST  
DWG. NO. AE-100E  
SHEET 83 OF 228



UPS NO: 2VBB-UPS1B  
PNL NO: 2VBS-PNLB102  
BKR NO: 16  
CIRCUIT NO: N/A

DRAWING REFERENCES  
EE-11Y

FEED TO DEVICE	DEVICE LOCATION		PLANT IMPACT
	BLDG	ELEV	
SPARE			

UPS1B

September 10, 1991

2VBB-UPS1B LOAD LIST  
DWG. NO. AE-100E  
SHEET 84 OF 228





UPS NO: 2VBB-UPS1B  
PNL NO: 2VBS-PNLB102  
BKR NO: 17  
CIRCUIT NO: N/A

DRAWING REFERENCES  
EE-11Y

FEED TO DEVICE	DEVICE LOCATION		PLANT IMPACT
	BLDG	ELEV	
SPARE			

UPS1B  
September 10, 1991

2VBB-UPS1B LOAD LIST  
DWG. NO. AE-100E  
SHEET 85 OF 228



UPS NO: 2VBB-UPS1B  
PNL NO: 2VBS-PNLB102  
BKR NO: 18  
CIRCUIT NO: N/A

DRAWING REFERENCES  
EE-11Y

FEED TO DEVICE	DEVICE LOCATION		PLANT IMPACT
	BLDG	ELEV	
SPARE			

UPS1B

September 10, 1991

2VBB-UPS1B LOAD LIST  
DWG. NO. AE-100E  
SHEET 86 OF 228



5  
8  
2  
4  
3

UPS NO: 2VBB-UPS1B  
PNL NO: 2VBS-PNLB102  
BKR NO: 19  
CIRCUIT NO: N/A

DRAWING REFERENCES  
EE-11Y

FEED TO DEVICE	<u>DEVICE LOCATION</u>		PLANT IMPACT
	BLDG	ELEV	
SPARE			

UPS1B  
September 10, 1991

2VBB-UPS1B LOAD LIST  
DWG. NO. AE-100E  
SHEET 87 OF 228



UPS NO: 2VBB-UPS1B  
PNL NO: 2VBS-PNLB102  
BKR NO: 20  
CIRCUIT NO: N/A

DRAWING REFERENCES  
EE-11Y

FEED TO DEVICE	DEVICE LOCATION		PLANT IMPACT
	BLDG	ELEV	
SPARE			

UPS1B  
September 10, 1991

2VBB-UPS1B LOAD LIST  
DWG. NO. AE-100E  
SHEET 88 OF 228



1  
2  
**CIRCUIT NO:N/A**

## EE-118

**EE-11Y**

[illegible]

**September 10, 1991**

2VBB-UPS1B LOAD LIST  
DWG. NO. AE-100E  
SHEET 89 OF 228



1

2

3

4

5

6

7

8

9

10

11

12

13

14

15

16

17

UPS NO: 2VBB-UPS1B  
PNL NO: 2VBS-PNLB102  
BKR NO: 22  
CIRCUIT NO: N/A

### DRAWING REFERENCES

**EE-118**

**EE-11Y**

[illegible]

**UP81B**

**September 10, 1991**

2VBB-UPS1B LOAD LIST  
DWG. NO. AE-100E  
SHEET 90 OF 228



1  
2  
### DRAWING REFERENCES

EE-118

**EE-11Y**



## 2VBB-UP81B LOAD LIST

**DWG. NO. AE-100E**

**SHEET 91 OF 228**



101

102

## DRAWING REFERENCES

**EE-11Y**

**September 10, 1991**

2VBB-UP81B LOAD LIST  
DWG. NO. AE-100E  
SHEET 92 OF 228



1

2

3

4

5

6

7

8

9







EE-118  
EE-3LE  
LSK-22-3M



2VBB-UPS1B LOAD LIST  
DWG. NO. AE-100E  
SHEET 93 OF 228



2  
3

4

5

6

7



8

9

10

11





EE-118  
EE-3LE  
LSK-22-5R



2VBB-UPS1B LOAD LIST  
DWG. NO. AE-100E  
SHEET 94 OF 228





EE-118  
EE-3LE  
LSK-22-5R



2VBB-UPS1B LOAD LIST  
DWG. NO. AE-100E  
SHEET 95 OF 228



1

2

3

4

5

6

7

8

9

10

11



EE-118  
EE-3LE  
LSK-9-7E



2VBB-UPS1B LOAD LIST  
DWG. NO. AE-100E  
SHEET 96 OF 228



20

21

22

23

24

25

26

27

28

29

30

31





EE-118  
EE-3LE  
LSK-22-5R



2VBB-UPS1B LOAD LIST  
DWG. NO. AE-100E  
SHEET 97 OF 228



1  
2  
EE-118  
EE-3LE  
LSK-22-5R



2VBB-UPS1B LOAD LIST  
DWG. NO. AE-100E  
SHEET 98 OF 228



22

23

24

25

26

27

28

29

30

31

32

33

34

35

36

37

38

39

40

41

42

43

44

45

46

47



EE-118  
EE-3LE  
LSK-22-5R



2VBB-UPS1B LOAD LIST  
DWG. NO. AE-100E  
SHEET 99 OF 228





EE-118  
EE-3TR  
LSK-31-1.21D



2VBB-UPS1B LOAD LIST  
DWG. NO. AE-100E  
SHEET 100 OF 228






EE-118  
EE-3LE  
LSK-22-5R

2VBB-UPS1B LOAD LIST  
DWG. NO. AE-100E  
SHEET 101 OF 228



1  
2  
EE-118  
EE-3LE  
LSK-22-5R



2VBB-UPS1B LOAD LIST  
DWG. NO. AE-100E  
SHEET 102 OF 228

27

28

29

30

31

32

33

34

35

36

37

38

39

40

41

### DRAWING REFERENCES

EE-118  
EE-3LF  
LSK-22-5R



**September 11, 1991**

2VBB-UPS1B LOAD LIST  
DWG. NO. AE-100E  
SHEET 103 OF 228



1  
2  
EE-118  
EE-3LF  
LSK-22-5R



2VBB-UPS1B LOAD LIST  
DWG. NO. AE-100E  
SHEET 104 OF 228







EE-118  
EE-3RV  
LSK-22-5R



2VBB-UPS1B LOAD LIST  
DWG. NO. AE-100E  
SHEET 105 OF 228





EE-118  
EE-3TM  
LSK-31-3A



2VBB-UPS1B LOAD LIST  
DWG. NO. AE-100E  
SHEET 106 OF 228



12

13

14

15

16

17

18

19

20

21

22

EE-118  
EE-3TM  
LSK-31-3A



2VBB-UPS1B LOAD LIST  
DWG. NO. AE-100E  
SHEET 107 OF 228



1

2

3

4

5

6

7

8

9

10

11



12

13

14

15



BKR NO: 21  
 LIST PNL NO: 2VBS-PNLB107  
 BKR NO: 16  
 CIRCUIT NO: 2RU195

### DRAWING REFERENCES

EE-118  
EE-3TP  
LSK-22-58

[illegible]

UP81B

**September 11, 1991**

2VBB-UPS1B LOAD LIST  
DWG. NO. AE-100E  
SHEET 108 OF 228







EE-118  
EE-3TP  
LSK-22-58



2VBB-UPS1B LOAD LIST  
DWG. NO. AE-100E  
SHEET 109 OF 228





EE-118  
EE-3TP  
LSK-22-58



2VBB-UPS1B LOAD LIST  
DWG. NO. AE-100E  
SHEET 110 OF 228



8

10

12

14

16

18

20

22

24

26

28



EE-118  
EE-3TP  
LSK-22-58



2VBB-UPS1B LOAD LIST  
DWG. NO. AE-100E  
SHEET 111 OF 228



5-28-

1

2

3

4

5

6



### DRAWING REFERENCES

EE-118  
EE-3TA  
16.230-001-021  
16.230-001-022  
16.230-001-023



**September 11, 1991**

2VBB-UP81B LOAD LIST  
DWG. NO. AE-100E  
SHEET 112 OF 228



1  
2  
UPS NO: 2VBB-UPS1B  
 PNL NO: 2VBS-PNLB102  
 DIST PNL NO: 2VBS-PNLB107  
 BKR NO: 20

PLANT IMPACT: LOSS OF POWER TO 2SSP-IPNL102

LOOP	PMS INDICATION	PMS ALARM	ERF INPUT	CR ANNUNCIATION	LOCAL ANNUNCIATION	CR INDICATION	LOCAL INDICATION	VALVE POSITION	DESCRIPTION/OTHER
2SSP-FI104						X			RHR SYSTEM SAMPLE RETURN FLOW
2SSP-PI1661						X			REACTOR COOLANT SAMPLE INLET PRESSURE
2SSP-PI1662						X			GAS COLLECTION CHAMBER PRESSURE
2SSP-PI1708						X			GAS SAMPLE BOTTLE PRESSURE
2SSP-TI1660						X			REACTOR COOLANT SAMPLE INLET TEMP
2SSP-TI1724						X			SAMPLE GAS INLET TEMP.
2SSP-CI1663						X			REACTOR COOLANT SAMPLE INLET CONDUCTIVITY
2SSP-RI1507						X			SAMPLE AREA RADIATION
2SSP-RI1665						X			SAMPLE RETURN RADIATION
2SSP-RI1704						X			IODINE CARTRIDGE RADIATION
2SSP-LS1717						X			GAS COOLER TRAP LEVEL

UPS1B

September 11, 1991

2VBB-UPS1B LOAD LIST  
 DWG. NO. AE-100E  
 SHEET 113 OF 228



THIS SHEET LEFT INTENTIONALLY BLANK

UPS1B

September 11, 1991

2VBB-UPS1B LOAD LIST  
DWG. NO. AE-100E  
SHEET 114 OF 228





### DRAWING REFERENCES

EE-118  
EE-3TA  
EE-11FQ, ESK-7GSN01, LSK-14-1F



**September 11, 1991**

2VBB-UPS1B LOAD LIST  
DWG. NO. AE-100E  
SHEET 115 OF 228



THIS SHEET LEFT INTENTIONALLY BLANK

UPS1B

September 11, 1991

2VBB-UPS1B LOAD LIST  
DWG. NO. AE-100E  
SHEET 116 OF 228





UPS NO: 2VBB-UPS1B  
PNL NO: 2VBS-PNLB102  
BKR NO: 21  
DIST PNL NO: 2VBS-PNLB107  
BKR NO: 21  
CIRCUIT NO: 2GSMN02

### DRAWING REFERENCES

EE-118  
EE-3TA  
EE-11FL, ESK-7MWS02, LSK-9-15

[illegible]

UP81B

September 11, 1991

2VBB-UPS1B LOAD LIST  
DWG. NO. AE-100E  
SHEET 117 OF 228



THIS SHEET LEFT INTENTIONALLY BLANK

UPS1B

September 11, 1991

2VBB-UPS1B LOAD LIST  
DWG. NO. AE-100E  
SHEET 118 OF 228





EE-118  
EE-3TA  
EE-11FL, ESK-78SR02, LSK-21-2C



2VBB-UPS1B LOAD LIST  
DWG. NO. AE-100E  
SHEET 119 OF 228



THIS SHEET LEFT INTENTIONALLY BLANK

UPS1B

September 11, 1991

2VBB-UPS1B LOAD LIST  
DWG. NO. AE-100E  
SHEET 120 OF 228







### DRAWING REFERENCES

ESK-6HVW10  
LSK-22-5E  
EE-118  
EE-3TA



**September 11, 1991**

2VBB-UPS1B LOAD LIST  
DWG. NO. AE-100E  
SHEET 121 OF 228



1  
2  
1 2 



1  
2  
1 2 



1  
2  
### DRAWING REFERENCES

**EE-118**



**September 11, 1991**

2VBB-UPS1B LOAD LIST  
DWG. NO. AE-100E  
SHEET 122 OF 228





### DRAWING REFERENCES

**EE-118**



**September 11, 1991**

2VBB-UPS1B LOAD LIST  
DWG. NO. AE-100E  
SHEET 123 OF 228



**EE-118**

2VBB-UPS1B LOAD LIST  
DWG. NO. AE-100E  
SHEET 124 OF 228



1  
2  
1  
2  
**EE-118**



2VBB-UPS1B LOAD LIST  
DWG. NO. AE-100E  
SHEET 125 OF 228



**EE-118**



2VBB-UPS1B LOAD LIST  
DWG. NO. AE-100E  
SHEET 126 OF 228



10

11

12

13

14

15

16

17

18

19

20

21

22

23

24

25

26

27

28

29

30

31

32

33

34

35

36

37

38

39

40

41

42





### DRAWING REFERENCES

EE-118

**September 11, 1991**

2VBB-UPS1B LOAD LIST  
DWG. NO. AE-100E  
SHEET 127 OF 228



2

3

4



NOTES:

1. Lose local horns, alarms & indicators.
2. Lose annunciator window & computer pt in control room.
3. RMS computer will have indication of microprocessor failure.
4. Lose local annunciator window.
5. Lose local recorders.

UPS1B

September 11, 1991

2VBB-UPS1B LOAD LIST  
DWG. NO. AE-100E  
SHEET 128 OF 228



1  
2  
1  
2  
1  
2  
EE-118  
EE-3RT  
LSK-22-3M



2VBB-UPS1B LOAD LIST  
DWG. NO. AE-100E  
SHEET 129 OF 228





EE-118  
EE-3RT  
LSK-22-3M



2VBB-UPS1B LOAD LIST  
DWG. NO. AE-100E  
SHEET 130 OF 228



1  
2  
100

101  
EE-118  
EE-3RT  
LSK-22-3M



2VBB-UPS1B LOAD LIST  
DWG. NO. AE-100E  
SHEET 131 OF 228

1  
2  
### DRAWING REFERENCES

EE-118

EE-3RT

**L8K-22-3M**



**September 11, 1991**

2VBB-UPS1B LOAD LIST  
DWG. NO. AE-100E  
SHEET 132 OF 228





### DRAWING REFERENCES

EE-118

EE-3RT

LSK-22-3M



**September 11, 1991**

2VBB-UPS1B LOAD LIST  
DWG. NO. AE-100E  
SHEET 133 OF 228





EE-118  
EE-3RT  
LSK-22-3M



2VBB-UPS1B LOAD LIST  
DWG. NO. AE-100E  
SHEET 134 OF 228



1  
2  
EE-118  
EE-3RT  
LSK-22-3M



2VBB-UPS1B LOAD LIST  
DWG. NO. AE-100E  
SHEET 135 OF 228





EE-118  
EE-3RT  
LSK-22-3M



2VBB-UPS1B LOAD LIST  
DWG. NO. AE-100E  
SHEET 136 OF 228



EE-118  
EE-3RT  
LSK-22-3M



2VBB-UPS1B LOAD LIST  
DWG. NO. AE-100E  
SHEET 137 OF 228















EE-118  
EE-3RT  
LSK-22-3M



**September 11, 1991**

2VBB-UPS1B LOAD LIST  
DWG. NO. AE-100E  
SHEET 138 OF 228





EE-118  
EE-3RT  
LSK-22-3M

[illegible]

2VBB-UPS1B LOAD LIST  
DWG. NO. AE-100E  
SHEET 139 OF 228





EE-118  
EE-3RT  
LSK-22-3M



2VBB-UPS1B LOAD LIST  
DWG. NO. AE-100E  
SHEET 140 OF 228

100-60000-1

1

100-60000-1

1





EE-118  
EE-3RT  
LSK-22-3M



2VBB-UPS1B LOAD LIST  
DWG. NO. AE-100E  
SHEET 141 OF 228



EE-118  
EE-3RT  
LSK-22-3M



2VBB-UPS1B LOAD LIST  
DWG. NO. AE-100E  
SHEET 142 OF 228

[illegible][illegible]




### DRAWING REFERENCES

EE-118

EE-3RT

**LSK-22-3M**



**September 11, 1991**

2VBB-UPS1B LOAD LIST  
DWG. NO. AE-100E  
SHEET 143 OF 228





EE-118  
EE-3RT  
LSK-22-3M



2VBB-UPS1B LOAD LIST  
DWG. NO. AE-100E  
SHEET 144 OF 228

1  
2  
1  
2  
1  
2  
1  
2  
EE-118  
EE-3RT  
LSK-22-3M



2VBB-UPS1B LOAD LIST  
DWG. NO. AE-100E  
SHEET 145 OF 228





EE-118  
EE-3RT  
LSK-22-3M



2VBB-UPS1B LOAD LIST  
DWG. NO. AE-100E  
SHEET 146 OF 228





EE-118  
EE-3RT  
LSK-22-3M



2VBB-UPS1B LOAD LIST  
DWG. NO. AE-100E  
SHEET 147 OF 228



EE-118  
EE-3RU  
LSK-22-9.1J



2VBB-UPS1B LOAD LIST  
DWG. NO. AE-100E  
SHEET 148 OF 228

6.6

1000
















### DRAWING REFERENCES

EE-118

EE-3RU

**LSK-22-9.1J**

**September 11, 1991**

## 2VBB-UP81B LOAD LIST

DWG. NO. AE-100E

**SHEET 149 OF 228**



1. 1A  
R01

1. 1A  
R01



1. 1A  
R01





EE-118  
EE-3TQ  
LSK-31-4F



2VBB-UPS1B LOAD LIST  
DWG. NO. AE-100E  
SHEET 151 OF 228

1234

1234

EE-118  
EE-3TQ  
LSK-31-4F



2VBB-UPS1B LOAD LIST  
DWG. NO. AE-100E  
SHEET 152 OF 228

25

25

.

1. 2. 

EE-118  
EE-3TR  
LSK-2-1.1J

2VBB-UPS1B LOAD LIST  
DWG. NO. AE-100E  
SHEET 153 OF 228





## EE-118

EE-3TP

**LSK-22-3Q**



**September 11, 1991**

DWG. NO. AE-100E

**SHEET 154 OF 228**





## EE-118



2VBB-UPS1B LOAD LIST  
DWG. NO. AE-100E  
SHEET 155 OF 228

1

2

3

4

5

6

7

8

9

10

11

12

13 14 15 

101

102

## EE-118



2VBB-UPS1B LOAD LIST  
DWG. NO. AE-100E  
SHEET 156 OF 228

100-111-10



NOTES:

1. LOSS OF LOCAL HORNS, ALARMS & INDICATORS
2. LOSS OF ANNUNCIATOR WINDOW & COMPTR PT IN CONTROL ROOM
3. RMS COMPUTER WILL HAVE INDICATION OF MICROPROCESSOR FAILURE
4. VALVE 20FG-AOV103 (OFFGAS TO THE STACK LINE) WILL LOSE THE AUTOMATIC CLOSE FUNCTION ON HIGH RADIATION
5. LOSS OF LOCAL ANNUNCIATOR WINDOW

UPS1B

September 11, 1991

2VBB-UPS1B LOAD LIST  
DWG. NO. AE-100E  
SHEET 157 OF 228





DIST PNL NO: 2VBS-PNLB109  
BKR NO: 1  
CIRCUIT NO: 2RU108

### DRAWING REFERENCES

EE-118  
LSK-22-1R  
EE-3LF

[illegible]

**UP81B**

**September 11, 1991**

2VBB-UPS1B LOAD LIST  
DWG. NO. AE-100E  
SHEET 158 OF 228

12.




• •

•

2

4

EE-118  
LSK-22-1R  
EE-3LF



2VBB-UPS1B LOAD LIST  
DWG. NO. AE-100E  
SHEET 159 OF 228





EE-118  
LSK-22-1R  
EE-3LF

2VBB-UPS1B LOAD LIST  
DWG. NO. AE-100E  
SHEET 160 OF 228



1  
2  
1  
2  
1  
2  
1  
2  
1  
2  
EE-118  
EE-3LF  
LSK-22-1R



2VBB-UPS1B LOAD LIST  
DWG. NO. AE-100E  
SHEET 161 OF 228

58

1

2

3

4

5

6

7

8

9

10

11

12

13

14

15



### DRAWING REFERENCES

EE-118  
LSK-22-1R  
EE-3LF



2VBB-UPS1B LOAD LIST  
DWG. NO. AE-100E  
SHEET 162 OF 228

100%

































































### DRAWING REFERENCES

EE-118  
LSK-22-1R  
EE-3LF



**September 11, 1991**

2VBB-UPS1B LOAD LIST  
DWG. NO. AE-100E  
SHEET 163 OF 228



EE-118  
LSK-22-1R  
EE-3LF



2VBB-UPS1B LOAD LIST  
DWG. NO. AE-100E  
SHEET 164 OF 228





EE-118  
LSK-22-1R  
EE-3RS

2VBB-UPS1B LOAD LIST  
DWG. NO. AE-100E  
SHEET 165 OF 228

10

11

12

13

14

15

16

17

18

19

20

21

22

23

24

25

26

27

28

29

30

31

32

33

34





EE-118  
LSK-R22-1R  
EE-3TM



2VBB-UPS1B LOAD LIST  
DWG. NO. AE-100E  
SHEET 166 OF 228

10

11

12

13

14

15

16

17

18

19

20

21

22

23

24

25

26

EE-118  
LSK-22-1R  
EE-3RS



2VBB-UPS1B LOAD LIST  
DWG. NO. AE-100E  
SHEET 167 OF 228





### DRAWING REFERENCES

EE-118  
LSK-22-1R  
EE-3R8

**September 11, 1991**

2VBB-UPS1B LOAD LIST  
DWG. NO. AE-100E  
SHEET 168 OF 228



### DRAWING REFERENCES

EE-118  
LSK-22-1R  
EE-3R8



**September 11, 1991**

2VBB-UPS1B LOAD LIST  
DWG. NO. AE-100E  
SHEET 169 OF 228

20

1

2

3

4

5

6

7

8

9

10

11

12 13 14 

101

102

103

104

105

106

107

108

109

110

111

112

113

114

115

116

117

118

119

120





## DRAWING REFERENCES

EE-118  
LSK-22-1R  
EE-3RS



**September 11, 1991**

2VBB-UPS1B LOAD LIST  
DWG. NO. AE-100E  
SHEET 170 OF 228

2

1

2

3

4

5

6

7

8

9

10

11

12

13

14

15

16

17

18



EE-118  
LSK-22-1R  
EE-3RV



2VBB-UPS1B LOAD LIST  
DWG. NO. AE-100E  
SHEET 171 OF 228

12

1


































EE-118  
LSK-22-1R  
EE-3R8



2VBB-UPS1B LOAD LIST  
DWG. NO. AE-100E  
SHEET 172 OF 228



1992



6

•

1 2 1

9. 10. 90

2

4

2

14








EE-118  
LSK-22-1R  
EE-3R8

2VBB-UPS1B LOAD LIST  
DWG. NO. AE-100E  
SHEET 173 OF 228





### DRAWING REFERENCES

EE-118  
LSK-22-1R  
EE-3RS



**September 11, 1991**

2VBB-UPS1B LOAD LIST  
DWG. NO. AE-100E  
SHEET 174 OF 228



EE-118  
LSK-22-1R  
EE-3RU



2VBB-UPS1B LOAD LIST  
DWG. NO. AE-100E  
SHEET 175 OF 228

1

2

3

4

5

6

7

8

9

10

11

12

13

EE-118  
LSK-22-1R  
EE-3RU



2VBB-UPS1B LOAD LIST  
DWG. NO. AE-100E  
SHEET 176 OF 228

1  
2  
1  
2  
### DRAWING REFERENCES

EE-118  
LSK-22-1R  
EE-3RS



**September 11, 1991**

2VBB-UP81B LOAD LIST  
DWG. NO. AE-100E  
SHEET 177 OF 228

10















































EE-118  
LSK-27-15G  
EE-3TQ



2VBB-UPS1B LOAD LIST  
DWG. NO. AE-100E  
SHEET 178 OF 228





### DRAWING REFERENCES

EE-118  
LSK-22-3M  
EE-3RU

[illegible]

**September 11, 1991**

2VBB-UPS1B LOAD LIST  
DWG. NO. AE-100E  
SHEET 179 OF 228

2011-12-12

1

2

3

4

5

6

7

8

9

10

11

12

13

14



EE-118  
LSK-9-1H  
EE-3TR




2VBB-UPS1B LOAD LIST  
DWG. NO. AE-100E  
SHEET 180 OF 228





EE-118  
LSK-9-1H  
EE-3TR



2VBB-UPS1B LOAD LIST  
DWG. NO. AE-100E  
SHEET 181 OF 228





### DRAWING REFERENCES

EE-118  
LSK-34-2G  
EE-3TR



**September 11, 1991**

2VBB-UPS1B LOAD LIST  
DWG. NO. AE-100E  
SHEET 182 OF 228



EE-118  
EE-3TP  
LSK-22-18



2VBB-UPS1B LOAD LIST  
DWG. NO. AE-100E  
SHEET 183 OF 228



DIST PNL NO: 2VBS-PNLB109  
BKR NO: 27  
CIRCUIT NO: 2RU237

EE-118  
EE-3TP  
LSK-22-18

UP81B  
September 11, 1991

2VBB-UPS1B LOAD LIST  
DWG. NO. AE-100E  
SHEET 184 OF 228





EE-118  
EE-3TP  
LSK-22-18

*[Circular stamp]*



2VBB-UPS1B LOAD LIST  
DWG. NO. AE-100E  
SHEET 185 OF 228





NOTES:

1. LOSE LOCAL HORNS, ALARMS AND INDICATORS
2. LOSE ANNUNCIATOR WINDOW AND COMPUTER PT. IN CONTROL ROOM
3. RMS COMPUTER WILL HAVE INDICATION OF MICROPROCESSOR FAILURE

UPS1B

September 11, 1991

2VBB-UPS1B LOAD LIST  
DWG. NO. AE-100E  
SHEET 186 OF 228



1  
2  
UPS NO: 2VBB-UPS1B  
PNL NO: 2VBS-PNLB111

DRAWING REFERENCES

EE-11BK

BKR NO: 1  
CIRCUIT NO: N/A

| FEED TO DEVICE | DEVICE LOCATION |      | PLANT IMPACT                  |
|----------------|-----------------|------|-------------------------------|
|                | BLDG            | ELEV |                               |
| RADIAX SYSTEM  |                 |      | PARTIAL LOSS OF RADIAX SYSTEM |
|                |                 |      |                               |
|                |                 |      |                               |
UPS1B  
September 10, 1991

2VBB-UPS1B LOAD LIST  
DWG. NO. AE-100E  
SHEET 187 OF 228



1  
2  
UPS NO: 2VBB-UP81B  
PNL NO: 2VBS-PNLB111

### DRAWING REFERENCES

EE-11BK

**BKR NO: 2**  
**CIRCUIT NO: N/A**

[illegible]

**UP81B**

**September 10, 1991**

2VBB-UPS1B LOAD LIST  
DWG. NO. AE-100E  
SHEET 188 OF 228



UPS NO: 2VBB-UPS1B  
PNL NO: 2VBS-PNLB111

### DRAWING REFERENCES

**EE-11BK**

BKR NO: 3  
CIRCUIT NO: N/A

[illegible]

**UP81B**

**September 10, 1991**

2VBB-UP81B LOAD LIST  
DWG. NO. AE-100E  
SHEET 189 OF 228



1

2

3

4

5

6

7

8

9

10

11

12

13

14

15

16

17

18

19





UPS NO: 2VBB-UP81B  
PNL NO: 2VBS-PNLB111

### DRAWING REFERENCES

**EE-11BK**

**BKR NO: 4**  
**CIRCUIT NO: N/A**

[illegible]

**UP81B**

**September 10, 1991**

2VBB-UPS1B LOAD LIST  
DWG. NO. AE-100E  
SHEET 190 OF 228



1  
2  
UP8 NO: 2VBB-UP81B  
PNL NO: 2VBS-PNLB111

### DRAWING REFERENCES

**EE-11BK**

BKR NO: 5  
CIRCUIT NO: N/A

[illegible]

**UP81B**

**September 10, 1991**

2VBB-UPS1B LOAD LIST  
DWG. NO. AE-100E  
SHEET 191 OF 228

1  
2  
100  




UP8 NO: 2VBB-UP81B  
PNL NO: 2VBS-PNLB111

### DRAWING REFERENCES

**EE-11BK**

BKR NO: 7  
CIRCUIT NO: N/A

[illegible]

**UP81B**

**September 10, 1991**

2VBB-UP81B LOAD LIST  
DWG. NO. AE-100E  
SHEET 193 OF 228





UPS NO: 2VBB-UP81B  
PNL NO: 2VBS-PNLB111

### DRAWING REFERENCES

**EE-11BK**

BKR NO: 8  
CIRCUIT NO: N/A

[illegible]

**UP81B**

**September 10, 1991**

2VBB-UPS1B LOAD LIST  
DWG. NO. AE-100E  
SHEET 194 OF 228



### DRAWING REFERENCES

**EE-11BK**

**BKR NO: 9**  
**CIRCUIT NO: N/A**

[illegible]

**UP81B**

**September 10, 1991**

2VBB-UPS1B LOAD LIST  
DWG. NO. AE-100E  
SHEET 195 OF 228

1 2 3 4 5 6 7 8 9 10 11 12

13 14 15 16 17 18 19 20 21 22 23 24

25 26 27 28 29 30 31 32 33 34 35 36

UPS NO: 2VBB-UPS1B  
PNL NO: 2VBS-PNLB111

### DRAWING REFERENCES

**EE-11BK**

BKR NO: 10  
CIRCUIT NO: N/A

[illegible]

**UP81B**

**September 10, 1991**

2VBB-UP81B LOAD LIST  
DWG. NO. AE-100E  
SHEET 196 OF 228



UPS NO: 2VBB-UP81B  
PNL NO: 2VBS-PNLB111

### DRAWING REFERENCES

**EE-11BK**

BKR NO: 11  
CIRCUIT NO: N/A

[illegible]

**UP81B**

**September 10, 1991**

2VBB-UPS1B LOAD LIST  
DWG. NO. AE-100E  
SHEET 197 OF 228



1






































UPS NO: 2VBB-UPS1B  
PNL NO: 2VBS-PNLB111

### DRAWING REFERENCES

**EE-11BK**

BOOK NO: 12  
CIRCUIT NO: N/A

[illegible]

**UP81B**

**September 10, 1991**

2VBB-UPS1B LOAD LIST  
DWG. NO. AE-100E  
SHEET 198 OF 228



UPS NO: 2VBB-UPS1B  
PNL NO: 2VBS-PNLB111

### DRAWING REFERENCES

**EE-11BK**

BKR NO: 13  
CIRCUIT NO: N/A

[illegible]

**UP81B**

**September 10, 1991**

2VBB-UPS1B LOAD LIST  
DWG. NO. AE-100E  
SHEET 199 OF 228



23

10

75



7

6



UP8 NO: 2VBB-UP81B  
PNL NO: 2VBS-PNLB111

### DRAWING REFERENCES

**EE-11BK**

BKR NO: 14  
CIRCUIT NO: N/A

[illegible]

**UP81B**

**September 10, 1991**

2VBB-UP81B LOAD LIST  
DWG. NO. AE-100E  
SHEET 200 OF 228

1  
2  
## DRAWING REFERENCES

**EE-11BK**

BKR NO: 15  
CIRCUIT NO: N/A

[illegible]

**UP81B**

**September 10, 1991**

2VBB-UPS1B LOAD LIST  
DWG. NO. AE-100E  
SHEET 201 OF 228





UPS NO: 2VBB-UP81B  
PNL NO: 2VBS-PNLB111

### DRAWING REFERENCES

EE-11BK

BKR NO: 16  
CIRCUIT NO: N/A

[illegible]

**UP81B**

**September 10, 1991**

2VBB-UP81B LOAD LIST  
DWG. NO. AE-100E  
SHEET 202 OF 228



1  
2  
UPS NO: 2VBB-UP81B  
PNL NO: 2VBS-PNLB111

### DRAWING REFERENCES

**EE-11BK**

BKR NO: 17  
CIRCUIT NO: N/A

[illegible]

**UP81B**

**September 10, 1991**

2VBB-UPS1B LOAD LIST  
DWG. NO. AE-100E  
SHEET 203 OF 228

1  
2  
1  
2  
100

UPS NO: 2VBB-UP81B  
PNL NO: 2VBS-PNLB111

### DRAWING REFERENCES

**EE-11BK**

IR NO: 18  
CIRCUIT NO: N/A

[illegible]

**UP81B**

September '10, 1991

2VBB-UPS1B LOAD LIST  
DWG. NO. AE-100E  
SHEET 204 OF 228



UPS NO: 2VBB-UPS1B  
PNL NO: 2VBS-PNLB111

### DRAWING REFERENCES

**EE-11BK**

BKR NO: 20  
CIRCUIT NO: N/A

[illegible]

**UP81B**

**September 10, 1991**

2VBB-UPS1B LOAD LIST  
DWG. NO. AE-100E  
SHEET 206 OF 228





UPS NO: 2VBB-UPS1B  
PNL NO: 2VBS-PNLB111

DRAWING REFERENCES

EE-11BK

BKR NO: 21  
CIRCUIT NO: N/A

| FEED TO DEVICE | DEVICE LOCATION |      | PLANT IMPACT                  |
|----------------|-----------------|------|-------------------------------|
|                | BLDG            | ELEV |                               |
| RADIAX SYSTEM  |                 |      | PARTIAL LOSS OF RADIAX SYSTEM |
|                |                 |      |                               |
|                |                 |      |                               |
UPS1B

September 10, 1991

2VBB-UPS1B LOAD LIST  
DWG. NO. AE-100E  
SHEET 207 OF 228



4 3 2 1 P P 6 2 2 2

2 2 2 2

2 2 2

UPS NO: 2VBB-UPS1B  
PNL NO: 2VBS-PNLB111

### DRAWING REFERENCES

**EE-11BK**

BKR NO: 22  
CIRCUIT NO: N/A

[illegible]

**UP81B**

**September 10, 1991**

2VBB-UPS1B LOAD LIST  
DWG. NO. AE-100E  
SHEET 208 OF 228

1 2 

1 2 

UPS NO: 2VBB-UP81B  
PNL NO: 2VBS-PNLB111

### DRAWING REFERENCES

**EE-11BK**

BKR NO: 23  
CIRCUIT NO: N/A

[illegible]

**UP81B**

**September 10, 1991**

2VBB-UPS1B LOAD LIST  
DWG. NO. AE-100E  
SHEET 209 OF 228



UPS NO: 2VBB-UP81B  
PNL NO: 2VBS-PNLB111

### DRAWING REFERENCES

EE-11BK

BKR NO: 24  
CIRCUIT NO: N/A

[illegible]

**UP81B**

**September 10, 1991**

2VBB-UPS1B LOAD LIST  
DWG. NO. AE-100E  
SHEET 210 OF 228



5  
4  
3  
2  
1



4  
3  
2  
1





UPS NO: 2VBB-UP81B  
PNL NO: 2VBS-PNLB111

### DRAWING REFERENCES

**EE-11BK**

BKR NO: 25  
CIRCUIT NO: N/A

[illegible]

**UP81B**

**September 10, 1991**

2VBB-UPS1B LOAD LIST  
DWG. NO. AE-100E  
SHEET 211 OF 228



UPS NO: 2VBB-UPS1B  
PNL NO: 2VBS-PNLB111

### DRAWING REFERENCES

**EE-11BK**

BKR NO: 26  
CIRCUIT NO: N/A

[illegible]

**UP81B**

**September 10, 1991**

2VBB-UPS1B LOAD LIST  
DWG. NO. AE-100E  
SHEET 212 OF 228



UP8 NO: 2VBB-UP81B  
PNL NO: 2VBS-PNLB111

### DRAWING REFERENCES

**EE-11BK**

BKR NO: 27  
CIRCUIT NO: N/A

[illegible]

**UP81B**

**September 10, 1991**

2VBB-UP81B LOAD LIST  
DWG. NO. AE-100E  
SHEET 213 OF 228



100

• 4.4.2.2



























PKR NO: 28  
CIRCUIT NO: N/A

**EE-11BK**

UP81B  
September 10, 1991

2VBB-UPS1B LOAD LIST  
DWG. NO. AE-100E  
SHEET 214 OF 228



21  
22  
23  
24  
25  
26  
27  
28



29  
30  
31  
32  
33





UPS NO: 2VBB-UP81B  
PNL NO: 2VBS-PNLB111

### DRAWING REFERENCES

**EE-11BK**

BKR NO: 29  
CIRCUIT NO: N/A

UP81B  
September 10, 1991

2VBB-UP81B LOAD LIST  
DWG. NO. AE-100E  
SHEET 215 OF 228

75  
 76  
 77  
 78  
 79  
 80  
 81  
 82  
 83







UPS NO: 2VBB-UP81B  
PNL NO: 2VBS-PNLB111

### DRAWING REFERENCES

**EE-11BK**

BKR NO: 30  
CIRCUIT NO: N/A

[illegible]

**UP81B**

**September 10, 1991**

2VBB-UPS1B LOAD LIST  
DWG. NO. AE-100E  
SHEET 216 OF 228


1000

UPS NO: 2VBB-UPS1B  
PNL NO: 2VBS-PNLB111

### DRAWING REFERENCES

**EE-11BK**

PKR NO: 31  
CIRCUIT NO: N/A

[illegible]

**UP81B**

**September 10, 1991**

2VBB-UPS1B LOAD LIST  
DWG. NO. AE-100E  
SHEET 217 OF 228



UPS NO: 2VBB-UPS1B  
PNL NO: 2VBS-PNLB111

DRAWING REFERENCES

EE-11BK

BKR NO: 32  
CIRCUIT NO: N/A

| FEED TO DEVICE | DEVICE LOCATION |      | PLANT IMPACT                  |
|----------------|-----------------|------|-------------------------------|
|                | BLDG            | ELEV |                               |
| RADIAX SYSTEM  |                 |      | PARTIAL LOSS OF RADIAX SYSTEM |
|                |                 |      |                               |
|                |                 |      |                               |
UPS1B

September 10, 1991

2VBB-UPS1B LOAD LIST  
DWG. NO. AE-100E  
SHEET 218 OF 228



1  
2  
UPS NO: 2VBB-UPS1B  
PNL NO: 2VBS-PNLB111

### DRAWING REFERENCES

EE-11BK  
E&DCR Y03801D

BKR NO: 33  
CIRCUIT NO: N/A

[illegible]

**UP81B**

**September 10, 1991**

2VBB-UPS1B LOAD LIST  
DWG. NO. AE-100E  
SHEET 219 OF 228



UPS NO: 2VBB-UPS1B  
PNL NO: 2VBS-PNLB111

DRAWING REFERENCES

EE-11BK  
EE-11X

BKR NO: 34  
CIRCUIT NO: N/A

| FEED TO DEVICE | DEVICE LOCATION |      | PLANT IMPACT |
|----------------|-----------------|------|--------------|
|                | BLDG            | ELEV |              |
| 2LAC-PNLU04    | CCR             | 261  | N/A          |
|                |                 |      |              |
|                |                 |      |              |
UPS1B

September 10, 1991

2VBB-UPS1B LOAD LIST  
DWG. NO. AE-100E  
SHEET 220 OF 228



UPS NO: 2VBB-UP81B  
PNL NO: 2VBS-PNLB111

### DRAWING REFERENCES

BKR NO: 35  
CIRCUIT NO: N/A

EE-11BK  
E&DCR Y03801D

[illegible]

UPS1B

September 10, 1991

2VBB-UPS1B LOAD LIST  
DWG. NO. AE-100E  
SHEET 221 OF 228









BKR NO: 36  
CIRCUIT NO: N/A

EE-11BK  
EE-11X

UP81B  
September 10, 1991

2VBB-UPS1B LOAD LIST  
DWG. NO. AE-100E "  
SHEET 222 OF 228





UPS NO: 2VBB-UPS1B  
PNL NO: 2VBS-PNLB111

### DRAWING REFERENCES

BKR NO: 37  
CIRCUIT NO: N/A

EE-11BK  
E&DCR Y03801D

[illegible]

UP81B  
September 10, 1991

2VBB-UP81B LOAD LIST  
DWG. NO. AE-100E  
SHEET 223 OF 228



**BKR NO: 38**  
**CIRCUIT NO: N/A**

EE-11BK  
EE-11X

[illegible]

**September 10, 1991**

2VBB-UPS1B LOAD LIST  
DWG. NO. AE-100E  
SHEET 224 OF 228



1  
2  






UPS NO: 2VBB-UPS1B  
PNL NO: 2VBS-PNLB111

### DRAWING REFERENCES

**EE-11BK**

BKR NO: 39  
CIRCUIT NO: N/A

[illegible]

**UP81B**

**September 10, 1991**

2VBB-UPS1B LOAD LIST  
DWG. NO. AE-100E  
SHEET 225 OF 228





UPS NO: 2VBB-UP81B  
PNL NO: 2VBS-PNLB111

### DRAWING REFERENCES

**EE-11BK**

BKR NO: 40  
CIRCUIT NO: N/A

[illegible]

UP81B  
September 10, 1991

2VBB-UPS1B LOAD LIST  
DWG. NO. AE-100E  
SHEET 226 OF 228





UP8 NO: 2VBB-UP81B  
PNL NO: 2VBS-PNLB111

### DRAWING REFERENCES

**EE-11BK**

BKR NO: 41  
CIRCUIT NO: N/A

[illegible]

**UP81B**

**September 10, 1991**

2VBB-UPS1B LOAD LIST  
DWG. NO. AE-100E  
SHEET 227 OF 228




UPS NO: 2VBB-UPS1B  
PNL NO: 2VBS-PNLB111

### DRAWING REFERENCES

**EE-11BK**

BKR NO: 42  
CIRCUIT NO: N/A

[illegible]

**UP81B**

**September 10, 1991**

2VBB-UPS1B LOAD LIST  
DWG. NO. AE-100E  
SHEET 228 OF 228

