


999999999999

67-627-91

# 2VBB-UPS1A LOAD LIST

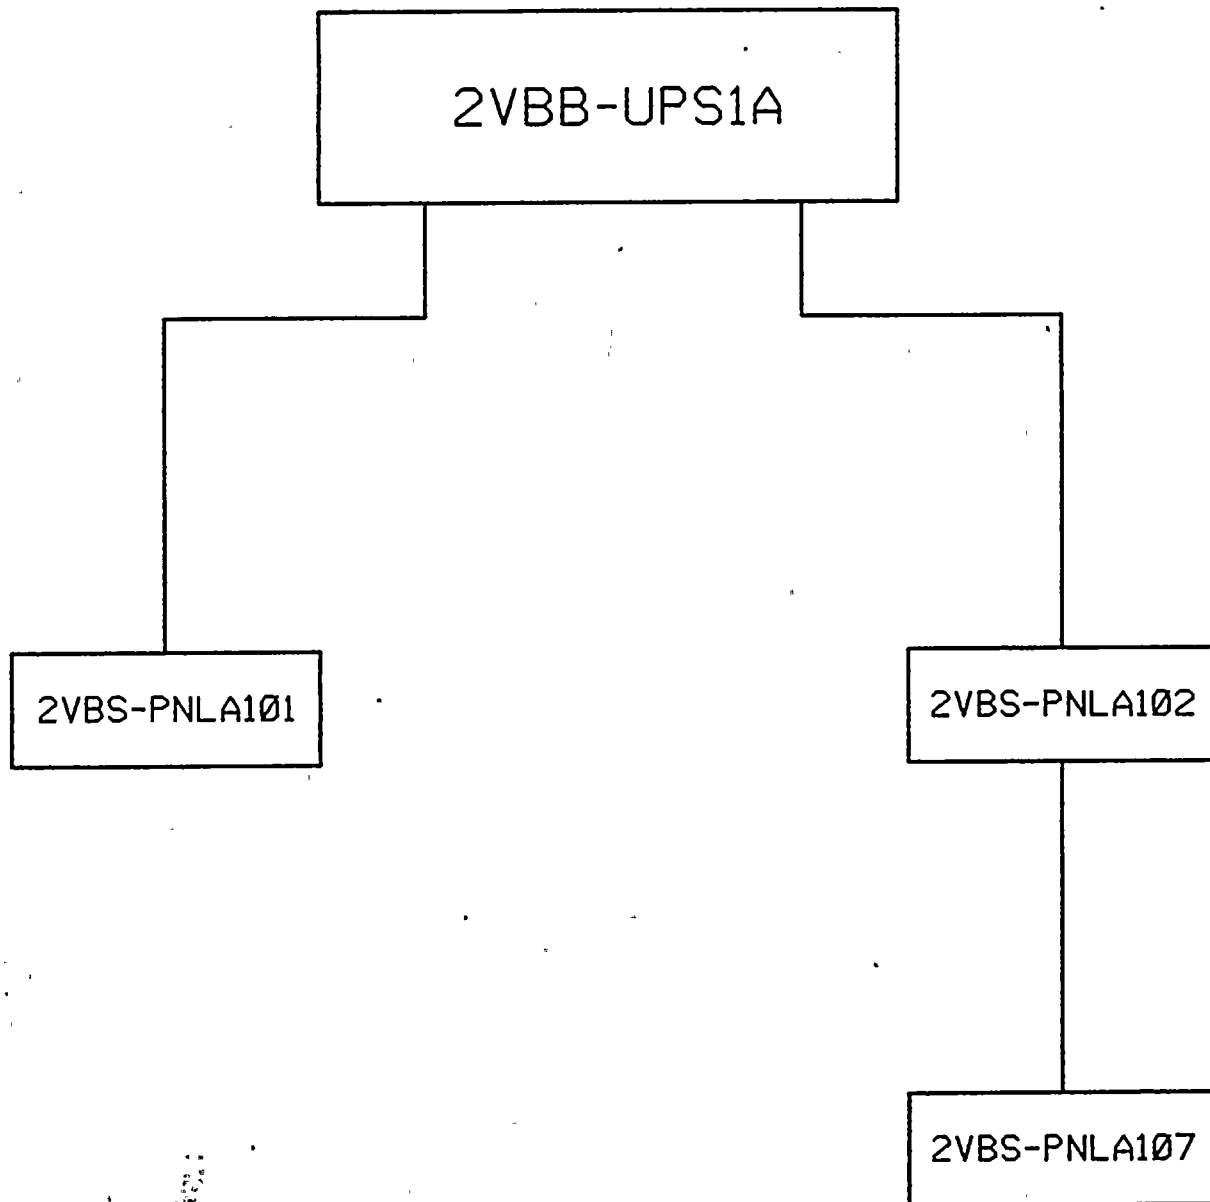

NOTE: THIS DRAWING WAS CREATED USING  
COMPUTER AIDED DRAFTING  
DO NOT MAKE MANUAL CHANGES

NUCLEAR NON-SAFETY RELATED

<b>NY</b>	<b>NIAGARA</b>	NINE MILE POINT
	<b>MOHAWK</b>	NUCLEAR STATION - UNIT 2
		SCRIBA, N.Y.
LOAD LIST		
UNINTERRUPTIBLE POWER SUPPLY		
2VBB-UPS1A		
SHEET 1 OF 117		
SCALE	DRAWING NO	
NONE		AE-100D

1	9-11-91	JPH JBP	ORIGINAL ISSUE- AS BUILT.	Rev and	Aug
MR	DATE	BY	MF	CK	APP

02



# INDEX

PANEL	BKR. NO.	SHEET NO.
2VBS-PNLA101 ↓	1	4
	2	5
	3	6
	4	7
	5	8
	6	9
	7	10
	8	11
	9	12
	10	13
	11	14
	12	15
	13	16
	14	17-20
	15	21-24
	16	25-28
	17	29,30
	18	31,32,33
	19	34,35
	20	36,37
	21	38
	22	39
	23	40
	24	41
	25	42
	26	43
	27	44
	28	45
	29	46
	30	47
	31	48
	32	49
	33	50
	34	51
	35	52
	36	53
	37	54
	38	55
2VBS-PNLA101 ↓		

PANEL	BKR. NO.	SHEET NO.
2VBS-PNLA102 ↓	1	56,57,58
	2	59,60
	3	61
	4	62-66
	5	67-70
	6	71-74
	7	75-79
	8	80
	9	81
	10	82
	11	83
	12	84
	13	85
	14	86
	15	87
	16	88
	17	89
	18	90
	19	91
	20	92
	21	93
	22	94
	23	95
	24	96
2VBS-PNLA102 ↓		
2VBS-PNLA107 ↓	1	97
	2	98
	3	99
	4	100
	5	101
	6	102
	7	103
	8	104
2VBS-PNLA107 ↓		

(CONTINUED ON SHEET 3)

2VBB-UPS1A LOAD LIST  
DWG. NO. AE-100D  
SHEET 2 OF 117





## INDEX (CONT'D)

PANEL	BKR. NO.	SHEET NO.
2VBS-PNLA107	9	105
	10	106
	11	107
	12	108
	13	109
	14	110
	15	111
	16	112
	17	113
	18	114
	19	115
	20	116
	21	117
	22	117
	23	117
	24	117
	25	117
	26	117
	27	117
	28	117
	29	117
	30	117
	31	117
	32	117
	33	117
	34	117
	35	117
	36	117
	37	117
	38	117
	39	117
	40	117
	41	117
	42	117

↓

2VBS-PNLA107

2VBB-UPS1A LOAD LIST  
 DWG. NO. AE-100D  
 SHEET 3 OF 117

2VBB-UPS1A LOAD LIST  
DWG. NO. AE-100D  
SHEET 3 OF 117

1  
2  
3  
4  
5  
6  
7

### DRAWING REFERENCES

0007.520-001-410  
0007.520-001-407  
EE-11J  
EE-3DS  
147D7828, SH. 2

[illegible]

2VBB-UPS1A LOAD LIST  
DWG. NO. AE-100D  
SHEET 4 OF 117

**September 11, 1991**

1. 2. 

UPS NO: 2VBB-UPS1A  
PNL NO: 2VBS-PNLA101  
BKR NO: 2  
CIRCUIT NO: N/A

DRAWING REFERENCES

EE-11J

| FEED TO DEVICE | DEVICE LOCATION |      | PLANT IMPACT |
|----------------|-----------------|------|--------------|
|                | BLDG            | ELEV |              |
| SPARE          |                 |      | NONE         |
|                |                 |      |              |
|                |                 |      |              |
UPS1A

September 11, 1991

2VBB-UPS1A LOAD LIST  
DWG. NO. AE-100D  
SHEET 5 OF 117

27

28

29

30

31

32

33

34

35

36

37

38

39

40

41

42

43

44

45

46

47

48

49

50

51

52

53

54

UPS NO: 2VBB-UPS1A  
 PNL NO: 2VBS-PNL101  
 BKR NO: 3  
 CIRCUIT NO: 2IHAA06

DRAWING REFERENCES

0007.521-001-731 EE-11J  
 EE-3DN ESK-10IHA42  
 ESK-10IHA43, 147D7844, SH. 2

| FEED TO DEVICE                      | DEVICE LOCATION |      | PLANT IMPACT   |
|-------------------------------------|-----------------|------|--|
|                                     | BLDG            | ELEV |  |
| 2CEC-PNL739<br>BAY A<br>JB103       | CRR             | 288  |  |
| 2IHA-W854                           |                 |      |  |
| 2CEC-PNL630<br>A8CB2-1A<br>A8CB2-2A | CRR             | 288  | LOSS OF CONTROL ROOM<br>ANNUNCIATORS AT 2CEC*PNL601,<br>602, 603 AND LOSS OF ASSOCIATED<br>COMPUTER ALARM POINTS |
|                                     |                 |      |  |
|                                     |                 |      |  |
UPS1A

September 11, 1991

2VBB-UPS1A LOAD LIST  
 DWG. NO. AE-100D  
 SHEET 6 OF 117

20  
41  
52  
6  
40  
12  
25  
1  
1  
12  
12



UPS NO: 2VBB-UPS1A  
PNL NO: 2VBS-PNLA101  
BKR NO: 4  
CIRCUIT NO: 2CECN14

### DRAWING REFERENCES

|   |  |
|---|--|
| 7.520-001-355,<br>147D7848, SH.2<br>ESK-11CEC01 | 7.520-001-357<br>7.520-001-347<br>EE-11J, EE-3DK |
|---|--|

[illegible]

**UP81A**

**September 11, 1991**

2VBB-UPS1A LOAD LIST  
DWG. NO. AE-100D  
SHEET 7 OF 117



### DRAWING REFERENCES

EE-3DK  
EE-11J  
ESK-11CEC02

[illegible]

**UP81A**

**September 11, 1991**

2VBB-UPS1A LOAD LIST  
DWG. NO. AE-100D  
SHEET 8 OF 117

1000





























### DRAWING REFERENCES

EE-3AC  
EE-11J  
147D7834, SH. 2

[illegible]

**UP81A**

**September 11, 1991**

2VBB-UPS1A LOAD LIST  
DWG. NO. AE-100D  
SHEET 9 OF 117



**CIRCUIT NO: 2RD8N08**

### DRAWING REFERENCES

**7.221-001-013**

**147D7834, SH. 2**

[illegible]

**UP81A**

**September 11, 1991**

**SHEET 10 OF 117**

12

13

14

15

16

17

18

19

20

21

22



### DRAWING REFERENCES

EE-3BA  
EE-11J  
147D7845, SH. 2  
ESK-10IHA40, SH. 1&2

[illegible]

**UP81A**

**September 11, 1991**

2VBB-UPS1A LOAD LIST  
DWG. NO. AE-100D  
SHEET 11 OF 117

12

13

14

15

16

17

18

19

20

21

22

23

24

25

26

27

28

### DRAWING REFERENCES

EE-11J

## PLANT IMPACT

2VBB-UPS1A LOAD LIST  
DWG. NO. AE-100D  
SHEET 12 OF 117

**September 11, 1991**

2



2



•

2

✱

UPS NO: 2VBB-UPS1A  
PNL NO: 2VBS-PNLA101  
BKR NO: 10  
CIRCUIT NO: N/A

**DRAWING REFERENCES**  
**EE-11J**

[illegible]

**UP81A**

**September 11, 1991**

2VBB-UPS1A LOAD LIST  
DWG. NO. AE-100D  
SHEET 13 OF 117

11 11 11


















UPS NO: 2VBB-UPS1A  
PNL NO: 2VBS-PNLA101  
BKR NO: 11  
CIRCUIT NO: 2RDSN04

### DRAWING REFERENCES

EE-3DE      EE-11J  
0007.520-001-350  
0007.520-001-338  
0007.520-001-337  
0007.221-001-010  
0007.221-001-011  
147D7826, SH. 2

[illegible]

**UP81A**

**September 11, 1991**

2VBB-UPS1A LOAD LIST  
DWG. NO. AE-100D  
SHEET 14 OF 117



















### DRAWING REFERENCES

EE-4X, EE-11J  
0007.510-001-271  
0007.221-001-012  
0007.221-001-038

[illegible]

**UP81A**

**September 11, 1991**

2VBB-UPS1A LOAD LIST  
DWG. NO. AE-100D  
SHEET 15 OF 117



UPS NO: 2VBB-UPS1A  
 PNL NO: 2VBS-PNLA101  
 BKR NO: 13  
 CIRCUIT NO: 2NMPN01

DRAWING REFERENCES

|                       |                  |
|-----------------------|------------------|
| EE-11J                | 0007.224-001-070 |
| EE-3DE                | 0007.224-001-055 |
| 147D7826, SH. 2       | 0007.224-001-021 |
| 7.520-001-350         | 0007.224-001-070 |
| 7.520-001-352         | 0007.212-001-012 |
| 7.224-001-020,035     |                  |
| 7.212-001-010,011,013 |                  |
| 1.764-001-021,026     |                  |

| FEED TO DEVICE  | DEVICE LOCATION |      | PLANT IMPACT  |
|---|-----------------|------|---|
|   | BLDG            | ELEV |   |
| 2CEC*PNL701<br>BAY A JB103  | CCR             | 306  |   |
| C51B-W234   |                 |      |   |
| 2CEC*PNL603<br>C51-R602<br>C51-R603B<br>C51-R603D<br>C51-R603A<br>C51-R603C<br>B22-R613 | CCR             | 306  | LOSS OF POWER TO:<br>SRM RECORDER<br>IRM/APRM RECORDER<br>IRM/APRM/RBM RECORDER<br>IRM/APRM RECORDER<br>IRM/APRM/RBM RECORDER<br>JET PUMP INST RECORDER |
| 2CEC*PNL603   |                 |      | LOSS OF POWER TO:<br>APRM CHANNELS A THRU F STATUS<br>LIGHTS, RBM CHANNELS A & B<br>STATUS LIGHTS, FLOW UNIT A THRU<br>D STATUS LIGHTS                  |
| 2CEC*PNL602<br>B35-R614<br>G33-R613A<br>G33-R613B                                       | CCR             | 306  | RECIRC FLOW RECORDER<br>RWCU FILTER DEMIN INFLUENT<br>RECORDER<br>RX RECIRC INFLUENT A RECORDER   |
| 2CEC-PNL614<br>B22-R622   | CCR             | 306  | FEEDWATER TURBIDITY RECORDER  |

UPS1A

September 11, 1991

2VBB-UPS1A LOAD LIST  
 DWG. NO. AE-100D  
 SHEET 16 OF 117



UPS NO: 2VBB-UP81A  
PNL NO: 2VBS-PNLA101  
BKR NO: 14  
CIRCUIT NO: 2CECA25

### DRAWING REFERENCES

EE-11J  
147D7836, SH. 2  
EE-3AG  
EE-3A  
0007.159-451-316  
0007.159-451-314

[illegible]

**UP81A**

**September 11, 1991**

2VBB-UPS1A LOAD LIST  
DWG. NO. AE-100D  
SHEET 17 OF 117



UPS NO: 2VBB-UPS1A  
 PNL NO: 2VBS-PNLA101  
 BKR NO: 14

PLANT IMPACT: LOSS OF POWER TO 2CEC-PNL825

| LOOP                     | PMS INDICATION | PMS ALARM | ERF INPUT | CR ANNUNCIATION | LOCAL ANNUNCIATION | CR INDICATION | LOCAL INDICATION | VALVE POSITION | DESCRIPTION/OTHER   |
|--------------------------|----------------|-----------|-----------|-----------------|--------------------|---------------|------------------|----------------|---|
| 2SWP-501<br>LSK-9-10T    | X              | X         |           | X               |                    | X             |                  |                | DISCH BAY LEVEL   |
| 2SWP-502<br>LSK-9-10T    | X              | X         |           | X               |                    | X             |                  |                | SERVICE WATER<br>INTAKE LEVEL   |
| 2FWS-10B<br>GE 807E160TY |                |           |           |                 |                    | X             |                  |                | MAIN FEEDWATER<br>CONTROL LV10B<br>POSITION INDICATION                      |
| 2FWP-215<br>LSK-15-1.1B  |                |           |           |                 |                    | X             |                  |                | FIRE HEADER<br>DISCHARGE PRESS  |
| 2CNM-115<br>LSK-4-1.3K   | X              | X         |           | X               |                    | X             |                  |                | CND BSTR PMPS SUCT<br>HDR PR  |
| 2CNM-114<br>LSK-4-1.4    | X              | X         |           | X               |                    | X             |                  | FO             | CND PMP DISCH HDR<br>FLOW/LOSS OF<br>CONTROL OF FV114                       |
| 2FWS-111<br>LSK-6-1.1F   |                |           |           |                 |                    | X             |                  | FC             | HIGH ENERGY FWCCU<br>CONTROL/LOSS OF<br>CONTROL OF HVX111,<br>HVV111,HVZ111 |
| 2FWS-113<br>LSK-6-1.1F   |                |           |           |                 |                    | X             |                  | FC             | LOW ENERGY FWCCU<br>CONTROL/LOSS OF<br>CONTROL OF<br>HVX113,HVV113          |
| 2FWS-40A<br>LSK-6-1.1E   | X              |           |           |                 |                    | X             |                  |                | LOSS OF INDICATION<br>OF REACTOR INLET<br>PRESSURE                          |
| 2FWS-109<br>LSK-6-1.1F   | X              |           |           |                 |                    | X             |                  |                | FWCCU FLOW<br>INDICATION  |
| 2CNM-105<br>LSK-4-1.1J   | X              | X         |           | X               |                    | X             |                  |                | CND PMPS DISCH HDR<br>PRESS   |
| 2CNM-70A<br>LSK-4-1.3K   | X              |           |           |                 |                    | X             |                  |                | FD WTR PMP P1A SUCT<br>PRESS  |

UPS1A

September 11, 1991

2VBB-UPS1A LOAD LIST  
 DWG. NO. AE-100D  
 SHEET 18 OF 117

20

4

4

6

10

11

12

13

14

15

16

17

18

19

20

21



UPS NO: 2VBB-UPS1A  
 PNL NO: 2VBS-PNL101  
 BKR NO: 14

PLANT IMPACT: LOSS OF POWER TO 2CEC-PNL825

| LOOP                       | PMS INDICATION | PMS ALARM | ERF INPUT | CR ANNUNCIATION | LOCAL ANNUNCIATION | CR INDICATION | LOCAL INDICATION | VALVE POSITION | DESCRIPTION/OTHER   |
|----------------------------|----------------|-----------|-----------|-----------------|--------------------|---------------|------------------|----------------|---|
| 2DER-101<br>LSK-32-9D      | X              | X         |           | X               |                    | X             |                  |                | DRYWELL EQUIPMENT<br>DRAIN LEAKAGE  |
| 2FWS-55A,B<br>GE 807E160TY |                |           |           |                 |                    | X             |                  |                | HIGH PRESSURE LOW<br>FLOW CONTROL VALVE<br>FVSSAB POSITION<br>INDICATION.       |
| 2CCP-266<br>LSK-9-1D       | X              | X         |           | X               |                    | X             |                  |                | RB CLOSE LOOP<br>COOLING WATER FLOW<br>TO DRYWELL UNIT<br>COOLERS               |
| 2CNM-38A<br>LSK-4-1.3K     | X              | X         |           | X               |                    | X             |                  | FO             | CONDENSATE BOOSTER<br>PUMP P2A SUCTION<br>FLOW; LOSS OF<br>CONTROL OF FV38A     |
| 2CNM-68A<br>LSK-6-3        | X              | X         |           | X               |                    | X             |                  | FO             | REACTOR FD PUMP<br>2FWS-P1A SUCTION<br>FLOW/LOSS OF<br>CONTROL OF 2FWR-<br>FV2A |
| 2CCP-135<br>LSK-9-1D       | X              | X         |           | X               |                    |               |                  |                | RB CLOSE LOOP<br>COOLING WATER FLOW<br>FROM DW UNIT<br>COOLERS                  |
| 2CNM-45A<br>LSK-4-1.1J     | X              |           | X         |                 |                    | X             | X                |                | CONDENSER CND1A<br>VACUUM   |
| 2CNM-104<br>LSK-4-1.3K     | X              |           |           |                 |                    | X             |                  |                | CONDENSER BOOSTER<br>PUMPS DISCH HDR PR   |
| 2CNM-138<br>LSK-4-1.3K     | X              |           |           |                 |                    | X             |                  |                | START-UP LVL<br>CONTROL VALVE FLOW  |
| 2DER-123<br>LSK-32-9D      | X              | X         |           | X               |                    | X             |                  |                | DW EQUIPMENT DRAIN<br>PUMPS P3A&B FLOW  |

UPS1A

September 11, 1991

2VBB-UPS1A LOAD LIST  
 DWG. NO. AE-100D  
 SHEET 19 OF 117



UPS NO: 2VBB-UP81A  
 PNL NO: 2VBS-PNLA101  
 BKR NO: 14

PLANT IMPACT: LOSS OF POWER TO 2CEC-PNL825

| LOOP                   | PMS INDICATION | PMS ALARM | ERF INPUT | CR ANNUNCIATION | LOCAL ANNUNCIATION | CR INDICATION | LOCAL INDICATION | VALVE POSITION | DESCRIPTION/OTHER   |
|------------------------|----------------|-----------|-----------|-----------------|--------------------|---------------|------------------|----------------|---|
| 2FWS-9A<br>LSK-6-1.1D  | X              |           |           |                 |                    | X             |                  |                | 2FWS-P1A PUMP DISCH PRESS   |
| 2HDL-4A<br>LSK-4-2.1B  | X              |           |           |                 |                    | X             |                  | FC             | 4TH POINT HEATER<br>2CNM-E4A WATER<br>LEVEL/LOSS OF<br>CONTROL OF LV4A          |
| 2HDL-35A<br>LSK-4-2.1C | X              |           |           |                 |                    | X             |                  | FO             | 4TH POINT HEATER<br>2CNM-E4A DRAIN PUMP<br>P1A FLOW/LOSS OF<br>CONTROL OF FV35A |
| 2HDL-41A<br>LSK-4-2.1B | X              |           |           |                 |                    | X             |                  |                | 4TH POINT HEATER<br>DRAIN PUMP P1A<br>DISCHARGE PRESSURE                        |
| 2MSS-238<br>PID-1G     | X              |           |           |                 |                    | X             |                  |                | MAIN STEAM PRESSURE<br>INDICATION   |

UP81A

September 11, 1991

2VBB-UP81A LOAD LIST  
 DWG. NO. AE-100D  
 SHEET 20 OF 117



### DRAWING REFERENCES

EE-11J  
EE-3B  
EE-3AF  
0007.159-451-319  
0007.159-451-317  
147D7836, SH. 2

[illegible]

**UP81A**

**September 11, 1991**

2VBB-UPS1A LOAD LIST  
DWG. NO. AE-100D  
SHEET 21 OF 117



UPS NO: 2VBB-UPS1A  
 PNL NO: 2VBS-PNLA101  
 BKR NO: 15  
 PNL NO: 2VBS-PNLB101  
 BKR NO: 16

PLANT IMPACT: LOSS OF POWER TO 2CEC-PNL826

| LOOP                 | PMS INDICATION | PMS ALARM | ERE INPUT | CR ANNUNCIATION | LOCAL ANNUNCIATION | CR INDICATION | LOCAL INDICATION | VALVE POSITION | DESCRIPTION/OTHER   |
|----------------------|----------------|-----------|-----------|-----------------|--------------------|---------------|------------------|----------------|---|
| 2CCP-126<br>LSK-9-L  | X              | X         |           | X               |                    |               |                  | FC             | RB CLOSE LOOP<br>COOLING WATER FLOW<br>FROM REACTOR WATER<br>CLEANUP HT EXCH.<br>2WCS-E3/LOSS OF<br>CONTROL OF FV126LCW |
| 2CCP-105<br>LSK-9-1L | X              |           |           |                 |                    |               |                  |                | RB CLOSE LOOP<br>COOLING WATER<br>BOOSTER PUMPS 2CCP-<br>P3A, B & C DISCHARGE<br>HDR FLOW                               |
| 2CCP-107<br>LSK-9-1M | X              |           |           |                 |                    | X             |                  |                | RB CLOSE LOOP<br>COOLING WATER<br>BOOSTER PUMPS<br>DISCHARGE HEADER<br>PRESSURE   |
| 2CCP-74B<br>LSK-9-1D | X              | X         |           | X               |                    |               |                  |                | RB CLOSE LOOP<br>COOLING WATER FROM<br>DRYWELL 2DRS-<br>UC3B - TEMP   |
| 2CCP-24D<br>LSK-9-1D | X              | X         |           | X               |                    |               |                  |                | RB CLOSE LOOP<br>COOLING WATER FROM<br>DRYWELL 2DRS-UC2D-<br>TEMP   |
| 2CCP-24B<br>LSK-9-1D | X              | X         |           | X               |                    |               |                  |                | RB CLOSE LOOP<br>COOLING WATER FROM<br>DRYWELL 2DRS-UC2B-<br>TEMP   |
| 2CCP-30D<br>LSK-9-1D | X              | X         |           | X               |                    |               |                  |                | RB CLOSE LOOP<br>COOLING WATER FROM<br>DRYWELL 2DRS-UC1D-<br>TEMP   |

UPS1A

September 11, 1991

2VBB-UPS1A LOAD LIST  
 DWG. NO. AE-100D  
 SHEET 22 OF 117

10  
11  
UPS NO: 2VBB-UPS1A  
 PNL NO: 2VBS-PNLA101  
 BKR NO: 15  
 PNL NO: 2VBS-PNLB101  
 BKR NO: 16

PLANT IMPACT: LOSS OF POWER TO 2CEC-PNL826

| LOOP                   | PMS INDICATION | PMS ALARM | ERF INPUT | CR ANNUNCIATION | LOCAL ANNUNCIATION | CR INDICATION | LOCAL INDICATION | VALVE POSITION | DESCRIPTION/OTHER  |
|------------------------|----------------|-----------|-----------|-----------------|--------------------|---------------|------------------|----------------|--|
| 2CCP-30B<br>LSK-9-1D   | X              | X         |           | X               |                    |               |                  |                | RB CLOSE LOOP<br>COOLING WATER FLOW<br>FROM DRYWELL 2DRS-<br>UC1B-TEMP           |
| 2CNM-70B<br>LSK-4-1.3K | X              |           |           |                 |                    | X             |                  |                | REACTOR FEEDWATER<br>PUMP P1B SUCT.<br>PRESS                                     |
| 2SFC-2B<br>LSK-34-2B   | X              | X         |           | X               |                    | X             |                  |                | SPENT FUEL POOL<br>WATER LEVEL   |
| 2CCP-51B<br>LSK-9-1D   | X              |           |           |                 |                    |               |                  |                | RB CLOSE LOOP<br>COOLING WATER FLOW<br>FROM 2RCS*P1B<br>COOLERS                  |
| 2HDL-41B<br>LSK-4-2.1B | X              |           |           |                 |                    | X             |                  |                | 4TH POINT HEATER<br>NO. 2CNM-E4B DRAIN<br>PUMP DISCHARGE<br>PRESSURE             |
| 2CNM-68B<br>LSK-6-3    | X              | X         |           | X               |                    | X             |                  | FO             | REACTOR FEED PUMP<br>2FWS-P1B SUCTION<br>FLOW/LOSS OF<br>CONTROL OF<br>2FWR-FV2B |
| 2HDL-4B<br>LSK-4-2.1B  | X              |           |           |                 |                    | X             | X                | FC             | 4TH PT HTR 2CNM-E4B<br>WATER LEVEL/LOSS OF<br>CONTROL OF LV4B                    |

UPS1A

September 11, 1991

2VBB-UPS1A LOAD LIST  
 DWG. NO. AE-100D  
 SHEET 23 OF 117



UPS NO: 2VBB-UP81A  
 PNL NO: 2VBS-PNLA101  
 BKR NO: 15  
 PNL NO: 2VBS-PNLB101  
 BKR NO: 16

PLANT IMPACT: LOSS OF POWER TO 2CEC-PNL826

| LOOP                   | PMS INDICATION | PMS ALARM | ERF INPUT | CR ANNUNCIATION | LOCAL ANNUNCIATION | CR INDICATION | LOCAL INDICATION | VALVE POSITION | DESCRIPTION/OTHER  |
|------------------------|----------------|-----------|-----------|-----------------|--------------------|---------------|------------------|----------------|--|
| 2CNM-45B<br>LSK-4-1.1J | X              |           | X         |                 |                    | X             | X                |                | CONDENSER CND1B<br>VACUUM  |
| 2FWS-9B<br>LSK-6-1.1D  | X              |           |           |                 |                    | X             |                  |                | REACTOR FEEDWATER<br>PUMP P1B DISCHARGE<br>PRESSURE  |
| 2CNM-38B<br>LSK-4-1.3K | X              | X         |           | X               |                    | X             |                  | FO             | CONDENSATE BOOSTER<br>PUMP P2B FLOW/LOSS<br>OF CONTROL OF FV38B                              |
| 2HDL-35B<br>LSK-4-2.1C | X              |           |           |                 |                    | X             |                  | FO             | 4TH POINT HEATER<br>2CNM-E4B DRAIN PUMP<br>P1B FLOW/LOSS OF<br>CONTROL OF FV35B              |
| 2FWS-40B<br>LSK-6-1.1E | X              |           |           |                 |                    | X             |                  |                | REACTOR INLET<br>PRESSURE  |
| 2CCP-108<br>LSK-9-1B   | X              | X         |           | X               |                    | X             |                  | FO             | CLOSED LOOP COOLING<br>SYSTEM HEAT<br>EXCHANGE DISCHARGE<br>TEMP/LOSS OF<br>CONTROL OF TV108 |
| 2CCP-125<br>LSK-9-1A   | X              |           |           |                 |                    | X             |                  |                | RB CL LP COOLING<br>HEADER PRESSURE  |

UP81A

September 11, 1991

2VBB-UP81A LOAD LIST  
 DWG. NO. AE-100D  
 SHEET 24 OF 117



### DRAWING REFERENCES

EE-11J  
EE-3C  
EE-3AF  
0007.159-451-332  
0007.159-451-322  
147D7836, SH. 2

[illegible]

**UP81A**

**September 11, 1991**

2VBB-UPS1A LOAD LIST  
DWG. NO. AE-100D  
SHEET 25 OF 117

[illegible]

14

1. 44  
2. 44

4



UPS NO: 2VBB-UPS1A  
 PNL NO: 2VBS-PNLA101  
 BKR NO: 16










PLANT IMPACT: LOSS OF POWER TO 2CEC-PNL827

| LOOP                     | PMS INDICATION | PMS ALARM | ERF INPUT | CR ANNUNCIATION | LOCAL ANNUNCIATION | CR INDICATION | LOCAL INDICATION | VALVE POSITION | DESCRIPTION/OTHER   |
|--------------------------|----------------|-----------|-----------|-----------------|--------------------|---------------|------------------|----------------|---|
| 2CNM-68C<br>LSK-6-3      | X              | X         |           | X               |                    | X             |                  | FO             | REACTOR FD PUMP<br>2FWS-P1C SUCTION<br>FLOW/LOSS OF<br>CONTROL OF 2FWR-<br>FV2C |
| 2CCP-24A/C<br>LSK-9-1D   | X              | X         |           | X               |                    |               |                  |                | RB CLOSE LOOP<br>COOLING WATER FROM<br>DRYWELL 2DRS-UC2A/C<br>TEMP              |
| 2CCP-30A/C<br>LSK-4-1.3K | X              | X         |           | X               |                    |               |                  |                | RBCLCW FROM DRYWELL<br>2DRS-UC1A/C TEMP   |
| 2CNM-38C,<br>LSK-4-1.3K  | X              | X         |           | X               |                    | X             |                  | FO             | CNST BSTR PUMP P2C<br>SUCTION FLOW/LOSS<br>OF CONTROL OF FV38C                  |
| 2CCP-74A<br>LSK-9-1D     | X              | X         |           | X               |                    |               |                  |                | RB CLOSE LOOP<br>COOLING WATER FROM<br>DRYWELL 2DRS-UC3A<br>TEMP                |
| 2SFC-2A<br>LSK-34-2B     | X              | X         |           | X               |                    | X             |                  |                | SPENT FUEL POOL<br>WATER LEVEL  |
| 2CCP-129<br>LSK-9-1E     | X              | X         |           | X               |                    |               |                  |                | RB CLOSE LOOP<br>COOLING WATER PUMP<br>P1A, P1B, P1C<br>DISCHARGE FLOW          |
| 2HDL-4C<br>LSK-4-2.1B    | X              |           |           |                 |                    | X             | X                | FC             | 4TH POINT HTR 2CNM-<br>E4C WATER LEVEL<br>LOSS OF CONTROL OF<br>LV4C            |
| 2HDL-35C<br>LSK-4-2.1C   | X              |           |           |                 |                    | X             |                  | FO             | 4TH POINT HTR 2CNM-<br>E4C DRAIN PUMP P1C<br>FLOW/LOSS OF<br>CONTROL OF FV35C   |

UPS1A

September 11, 1991

2VBB-UPS1A LOAD LIST  
 DWG. NO. AE-100D  
 SHEET 26 OF 117




UPS NO: 2VBB-UPS1A  
 PNL NO: 2VBS-PNLA101  
 BKR NO: 16

PLANT IMPACT: LOSS OF POWER TO 2CEC-PNL827

| LOOP                   | PMS INDICATION | PMS ALARM | ERF INPUT | CR ANNUNCIATION | LOCAL ANNUNCIATION | CR INDICATION | LOCAL INDICATION | VALVE POSITION | DESCRIPTION/OTHER  |
|------------------------|----------------|-----------|-----------|-----------------|--------------------|---------------|------------------|----------------|--|
| 2CCP-51A<br>LSK-9-1D   | X              |           |           |                 |                    |               |                  |                | RB CLOSE LOOP<br>COOLING WATER FLOW<br>FROM 2RCS*P1A<br>COOLERS            |
| 2HDL-41C<br>LSK-4-2.1B | X              |           |           |                 | X                  |               |                  |                | 4TH POINT HEATER<br>NO. 2CNM-E4C DRAIN<br>PUMP DISCHARGE<br>PRESSURE       |
| 2CCS-149<br>LSK-9-7A   | X              |           |           |                 | X                  |               |                  |                | TB CLOSE LOOP<br>COOLING WATER PUMP<br>DISCHARGE HEADER<br>PRESSURE        |
| 2CMS*178<br>LSK-33-2E  | X              |           |           |                 | X                  |               |                  |                | CONTAINMENT DW<br>PRESSURE AROUND<br>12.5 TO 17 PSIA                       |
| 2CMS-179<br>LSK-33-2E  | X              |           |           |                 | X                  |               |                  |                | SUPPRESSION CHAMBER<br>PRESSURE AROUND<br>12.5 TO 17 PSIA                  |
| 2SFC-124<br>LSK-34-2D  |                |           |           |                 | X                  |               |                  | FC             | SFPC WATER CIRC<br>DUMP VALVE/LOSS OF<br>CONTROL OF FV124                  |
| 2SFC-104<br>LSK-34-2D  | X              |           |           |                 | X                  |               |                  |                | SFPC TOTAL FLOW  |
| 2CCS-136<br>LSK-9-7C   | X              | X         |           | X               |                    |               |                  |                | TB CLOSE LOOP<br>COOLING WATER FLOW<br>BELOW 2 PUMP LIMIT,<br>1 PUMP LIMIT |
| 2FWS-9C<br>LSK-6.1.1D  | X              |           |           |                 | X                  |               |                  |                | REACTOR FEED WATER<br>PUMP P1C DISCHARGE<br>PRESSURE                       |
| 2TML-108<br>LSK-16-2.3 | X              |           |           |                 | X                  |               |                  |                | OIL TANK OIL LEVEL   |
| 2CNM-45C<br>LSK-4-1.1J | X              |           | X         |                 | X                  | X             |                  |                | CONDENSER 1C VACUUM  |

UPS1A

September 11, 1991

2VBB-UPS1A LOAD LIST  
 DWG. NO. AE-100D  
 SHEET 27 OF 117



UPS NO: 2VBB-UPS1A  
 PNL NO: 2VBS-PNLA101  
 BKR NO: 16

PLANT IMPACT: LOSS OF POWER TO 2CEC-PNL827

| LOOP                   | PMS INDICATION | PMS ALARM | ERF INPUT | CR ANNUNCIATION | LOCAL ANNUNCIATION | CR INDICATION | LOCAL INDICATION | VALVE POSITION | DESCRIPTION/OTHER   |
|------------------------|----------------|-----------|-----------|-----------------|--------------------|---------------|------------------|----------------|---|
| 2CNM-70C<br>LSK-4-1.3K | X              |           |           |                 |                    | X             |                  |                | REACTOR FEED WATER<br>PUMP PIC SUCTION<br>PRESSURE                            |
| 2CCS-104<br>LSK-9-7B   | X              | X         |           | X               |                    | X             |                  | FO             | TB COOLING WATER<br>HEAT EXCH. DISCH<br>TEMP HIGH/LOSS OF<br>CONTROL OF TV104 |

UPS1A

September 11, 1991

2VBB-UPS1A LOAD LIST  
 DWG. NO. AE-100D  
 SHEET 28 OF 117

1

2

3

4

5

6

7

8

9

10

11

12

13

14

15

UPS NO: 2VBB-UPS1A  
 PNL NO: 2VBS-PNLA101  
 BKR NO: 17  
 CIRCUIT NO: 2CECN05,  
 2CECN03,  
 2CECN01

# DRAWING REFERENCES

|            |                  |
|------------|------------------|
| LSK-3-1A   | EE-11J           |
| LSK-21-1A  | 147D7854, SH 2   |
| LSK-21-1B  | 0007.520-001-555 |
| LSK-21-1C  | 0007.520-001-545 |
| LSK-16-8D  | ESK-7CEC01       |
| LSK-2-1.1F | 0007.400-001-001 |
| EE-3B8     | 0007.400-001-002 |

| FEED TO DEVICE                            | DEVICE LOCATION |      | PLANT IMPACT  |
|---|-----------------|------|---|
|   | BLDG            | ELEV |   |
| 2CEC-PNL750<br>JB103                      | CCR             | 306  |   |
| 2CEC*PNL851<br>PWR51-2CECN05              | CCR             | 306  | POWER SUPPLY FOR BAILEY CHART<br>DRIVES & RECORDERS   |
| 2CEC*PNL601<br>C91-R620                   | CCR             | 306  | LOSS OF PERFORMANCE MONITORING<br>SYSTEM TREND RECORDER #1 CHART<br>DRIVE   |
| 2CEC*PNL603<br>C91-R621                   | CCR             | 306  | LOSS OF PERFORMANCE MONITORING<br>SYSTEM TREND RECORDER #2 CHART<br>DRIVE   |
| 2CEC*PNL851<br>C91-R622                   | CCR             | 306  | LOSS OF PERFORMANCE MONITORING<br>SYSTEM TREND RECORDER #3 CHART<br>DRIVE   |
| 2CEC*PNL851<br>2GMC-CR110/CR111           | CCR             | 306  | LOSS OF GENERATOR INLET<br>CONDUCTIVITY INDICATION/<br>LOSS OF GENERATOR OUTLET<br>CONDUCTIVITY INDICATION  |
| 2CEC*PNL851<br>2SST-CR106/<br>CR114/AR113 | CCR             | 306  | LOSS OF CNDS DMNRLZR SAMPLE<br>INLET CNDT/LOSS OF CNDS DMNRLZR<br>SAMPLE OUTLET CNDT/LOSS OF CNDS<br>DMNRLZR SAMPLE OUTLET CNDT 02<br>IND                             |
| 2CEC*PNL851<br>2SST-CR131/<br>AR132/AR133 | CCR             | 306  | LOSS OF COMMON 6TH PT HEATER<br>OUTLET SAMPLE CNDT/LOSS OF<br>COMMON 6TH PT HEATER OUTLET<br>SAMPLE 02/LOSS OF COMMON 6TH PT<br>HEATER OUTLET SAMPLE PH<br>INDICATION |

UPS1A

September 11, 1991

2VBB-UPS1A LOAD LIST  
 DWG. NO. AE-100D  
 SHEET 29 OF 117



UPS NO: 2VBB-UPS1A  
 PNL NO: 2VBS-PNLA101  
 BKR NO: 17  
 CIRCUIT NO: 2CECN05,  
 2CECN03,  
 2CECN01

DRAWING REFERENCES

|            |                  |
|------------|------------------|
| LSK-3-1A   | EE-11J           |
| LSK-21-1A  | 147D7854, SH 2   |
| LSK-21-1B  | 0007.520-001-555 |
| LSK-21-1C  | 0007.520-001-545 |
| LSK-16-8D  | ESK-7CEC01       |
| LSK-2-1.1F | 0007.400-001-001 |
| EE-3B8     | 0007.400-001-002 |

| FEED TO DEVICE                 | DEVICE LOCATION |      | PLANT IMPACT   |
|--------------------------------|-----------------|------|--|
|                                | BLDG            | ELEV |  |
| 2CEC*PNL851<br>2CWS-CR103      | CCR             | 306  | LOSS OF BLOWDOWN COOLING TOWER<br>WATER CONDUCTIVITY INDICATION    |
| 2CEC*PNL851<br>2CWS-AR105      | CCR             | 306  | LOSS OF BLOWDOWN COOLING TOWER<br>WATER PH INDICATION              |
| 2CEC*PNL851<br>2MSS-TR24A      | CCR             | 306  | LOSS OF REHEATER E1A REHEATING<br>STEAM SUPPLY TEMP INDICATION     |
| 2CEC*PNL851<br>2MSS-TR24B      | CCR             | 306  | LOSS OF REHEATER E1B REHEATING<br>STEAM SUPPLY TEMP E1B INDICATION |
| 2CEC-CP622<br>CMPTR PT CECXM01 | CRR             | 288  | CHIME FOR ALARM CONDITION  |
|                                |                 |      |  |
|                                |                 |      |  |
|                                |                 |      |  |
|                                |                 |      |  |

UPS1A

September 11, 1991

2VBB-UPS1A LOAD LIST  
 DWG. NO. AE-100D  
 SHEET 30 OF 117

100  
101  
## DRAWING REFERENCES

EE-11J  
EE-3AG  
0007.159-451-408  
0007.159-451-407  
EE-3N  
147D7836 SH. 2

[illegible]

2VBB-UPS1A LOAD LIST  
DWG. NO. AE-100D  
SHEET 31 OF 117

**September 11, 1991**

1

2

3

4

5

6

7

8

UPS NO: 2VBB-UPS1A  
 PNL NO: 2VBS-PNLA101  
 BKR NO: 18  
 UPS NO: 2VBB-UPS1B  
 PNL NO: 2VBS-PNLB101  
 BKR NO: 18

PLANT IMPACT: LOSS OF POWER TO 2CEC-PNL888

| LOOP                     | PMS INDICATION | PMS ALARM | ERF INPUT | CR ANNUNCIATION | LOCAL ANNUNCIATION | CR INDICATION | LOCAL INDICATION | VALVE POSITION | DESCRIPTION/OTHER   |
|--------------------------|----------------|-----------|-----------|-----------------|--------------------|---------------|------------------|----------------|---|
| 2ABM-110<br>LSK-10-1A    | X              | X         |           | X               | X                  |               | X                |                | AUX BOILERS STEAM<br>HDR PRESS                                  |
| 2ABM-101<br>LSK-10-1A    | X              | X         |           | X               | X                  |               | X                |                | AUX BOILER DEAR<br>STEM INL PRESS                               |
| 2CWS-66A,B<br>LSK-2-1.1D |                | X         |           | X               |                    |               |                  |                | CLG TWR SCREENS<br>WATER LVL HI                                 |
| 2CWS-109<br>LSK-2-1.1L   | X              | X         |           | X               |                    |               |                  | FAI            | CLG TWR BASIN WTR<br>TEMP/LOSS OF<br>CONTROL OF<br>MOG52A,B,C   |
| 2CWS-135<br>LSK-2-1.1L   | X              | X         |           | X               |                    |               |                  | FAI            | CLG TWR BASIN WTR<br>TEMP/LOSS OF<br>CONTROL OF<br>MOG52A,B,C   |
| 2CWS-136<br>LSK-2-1.1L   | X              | X         |           | X               |                    |               |                  | FAI            | CLG TWR BASIN WTR<br>TEMP/LOSS OF<br>CONTROL OF<br>MOG52A,B,C   |
| 2CWS-138<br>LSK-2-1.1D   | X              | X         |           | X               |                    | X             |                  |                | CLG TWR FLUME WTR<br>TEMP                                       |
| 2CWS-137<br>LSK-2-1.1L   | X              | X         |           | X               |                    |               |                  | FAI            | CLG TWR BASIN WTR<br>TEMP/LOSS OF<br>CONTROL OF<br>MOG52A,B,C   |
| 2CWS-147<br>LSK-9-10AC   | X              |           |           |                 |                    | X             |                  |                | CLG TWR BLOWDOWN<br>FLOW/LOSS OF<br>INDICATION ON<br>2SWP-FR602 |
| 2CWS-140<br>LSK-2-1.1D   | X              | X         |           | X               |                    | X             |                  | FC             | CLG TWR BASIN WTR<br>LVL/LOSS OF<br>CONTROL OF LV140            |

UPS1A

September 11, 1991

2VBB-UPS1A LOAD LIST  
 DWG. NO. AE-100D  
 SHEET 32 OF 117



UPS NO: 2VBB-UPS1A  
 PNL NO: 2VBS-PNLA101  
 BKR NO: 18  
 UPS NO: 2VBB-UPS1B  
 PNL NO: 2VBS-PNLB101  
 BKR NO: 18

PLANT IMPACT: LOSS OF POWER TO 2CEC-PNL888

| LOOP                         | PMS INDICATION | PMS ALARM | ERF INPUT | CR ANNUNCIATION | LOCAL ANNUNCIATION | CR INDICATION | LOCAL INDICATION | VALVE POSITION | DESCRIPTION/OTHER  |
|------------------------------|----------------|-----------|-----------|-----------------|--------------------|---------------|------------------|----------------|--|
| 2CWS-47B<br>LSK-2-1.1D       | X              |           |           |                 |                    | X             |                  |                | CLG TWR RETURN<br>FLOW TO CWS                            |
| 2SST-50A,B,C<br>LSK-4-2.1C   | X              | X         |           | X               | X                  | X             |                  |                | 2HDL-P1A,B,C<br>TURBIDITY SAMPLE                         |
| 2SST-22A,B,C<br>LSK-21-1A    | X              | X         |           | X               | X                  |               |                  |                | MN COND A,B,C SHL<br>EAST HALF CNDT                      |
| 2SST-21A,B,C<br>LSK-21-1A    | X              | X         |           | X               | X                  |               |                  |                | MN COND A,B,C SHL<br>WEST HALF CNDT                      |
| 2SST-58A THRU J<br>LSK-21-1E | X              | X         |           | X               | X                  |               |                  |                | CNDS DMNRLZR 1A<br>THRU 1J EFFLUENT<br>CNDT              |
| 2SST-53A,B,C<br>LSK-21-1D    | X              | X         |           | X               | X                  |               |                  |                | 2HDL-P1A,B,C DISCH<br>SAMPLE CNDT                        |
| 2SSR-156<br>LSK-21-1C        | X              | X         |           | X               | X                  |               | X                |                | CRD COM FLTR DISCH<br>TURBIDITY                          |
| 2SWP-512<br>LSK-9-10T        | X              |           |           |                 |                    | X             |                  | FO             | INTAKE CHANNEL<br>WATER TEMP LOSS OF<br>CONTROL OF TV512 |
| 2SWP-511<br>LSK-9-10U        | X              |           |           |                 |                    | X             |                  |                | INTAKE TEMPERING<br>WATER FLOW                           |
| 2SWP-509<br>LSK-9-10U        | X              |           |           |                 |                    | X             |                  |                | JET MOTIVE PUMP<br>FLOW                                  |
| 2SST-142<br>LSK-21-1C        | X              | X         |           | X               | X                  |               |                  |                | COND DMNRLZR INL<br>SAMPLE TURB                          |
| 2WTS-323<br>LSK-13-1G        | X              |           |           |                 |                    | X             |                  |                | DISCH FLOW TO LAKE                                       |

UPS1A

September 11, 1991

2VBB-UPS1A LOAD LIST  
 DWG. NO. AE-100D  
 SHEET 33 OF 117



UPS NO: 2VBB-UPS1A  
PNL NO: 2VBS-PNLA101  
BKR NO: 19  
CIRCUIT NO: 2RCSA19

### DRAWING REFERENCES

EE-11J  
EE-3DT  
147D7828, SH. 2  
0007.221-001-089  
0007.213-001-019

[illegible]

**UP81A**

**September 11, 1991**

2VBB-UPS1A LOAD LIST  
DWG. NO. AE-100D  
SHEET 34 OF 117





UPS NO: 2VBB-UPS1A  
 PNL NO: 2VBS-PNLA101  
 DIST PNL NO: 2CEC-PNL634  
 BKR NO: 19

PLANT IMPACT: LOSS OF POWER TO 2CEC-PNL634

DWG. REF.  
 761E79ITY  
 442X559-002  
 0007.221-001-089  
 TL2RCS-103, TL2RCS-104  
 TL2RCS-105  
 LOOP

PMS INDICATION  
 PMS ALARM  
 ERF INPUT  
 CR ANNUNCIATION  
 LOCAL ANNUNCIATION  
 CR INDICATION  
 LOCAL INDICATION  
 VALVE POSITION

DESCRIPTION/OTHER

|   |  |   |  |  |   |   |  |    |  |
|---|--|---|--|--|---|---|--|----|--|
| RECP #1 FEEDS<br>POWER SUPPLIES<br>NEST<br>2,3,4,5,8,9,10 |  |   |  |  |   | X |  |    | RCS LOAD DEMAND<br>ERROR CONTROL<br>INSTRUMENTATION<br>(INOP)              |
| RECP #1 FEEDS<br>POWER SUPPLIES<br>NEST<br>2,3,4,5,8,9,10 |  | X |  |  | X | X |  |    | RCS MASTER CONTROL<br>INSTRUMENTATION<br>(FLOW CONTROL)<br>(INOP)          |
| RECP #1 FEEDS<br>POWER SUPPLIES<br>NEST<br>2,3,4,5,8,9,10 |  | X |  |  | X | X |  |    | RCS NEUTRON FLUX<br>CONTROL<br>INSTRUMENTATION<br>(FLOW CONTROL)<br>(INOP) |
| RECP #1 FEEDS<br>POWER SUPPLIES<br>NEST<br>2,3,4,5,8,9,10 |  |   |  |  |   |   |  | FL | RCS FLOW CONTROL<br>LOOP "A"<br>INSTRUMENTATION<br>(INOP) 2RCS*HYV17A      |
| RECP #1 FEEDS<br>POWER SUPPLIES<br>NEST<br>2,3,4,5,8,9,10 |  |   |  |  |   |   |  | FL | 2RCS*HYV17A<br>POSITION & VELOCITY<br>CONTROL<br>INSTRUMENTATION<br>(INOP) |
| FUSE PLATE<br>VALIDYNE PUMP                               |  |   |  |  |   |   |  | FL | 2RCS*HYV17A<br>POSITION & VELOCITY<br>AMP (INOP)                           |
|   |  |   |  |  |   |   |  |    |  |
|   |  |   |  |  |   |   |  |    |  |
|   |  |   |  |  |   |   |  |    |  |
|   |  |   |  |  |   |   |  |    |  |
|   |  |   |  |  |   |   |  |    |  |

UPS1A

September 11, 1991

2VBB-UPS1A LOAD LIST  
 DWG. NO. AE-100D  
 SHEET 35 OF 117

1

2

3

4

5

6

7

8

9

10

11

12

13

14

15

16

17

18

19

20

21

22

23

24

25

## DRAWING REFERENCES

EE-11J  
EE-3DU  
147D7828, SH. 2  
0007.221-001-099  
0007.213-001-019

[illegible]

**UP81A**

September 11, 1991

2VBB-UPS1A LOAD LIST  
DWG. NO. AE-100D  
SHEET 36 OF 117

1. 1. 1.

2.

3.

4. 1. 1.

5. 1. 1.

6. 1. 1.

7. 1. 1.

8. 1. 1.

9. 1. 1.

10. 1. 1.

11. 1. 1.

**PLANT IMPACT: LOSS OF POWER TO 2CEC-PNL634**

| 01<br>NL634        | DESCRIPTION |
|--------------------|-------------|
| PMS INDICATION     |             |
| PMS ALARM          |             |
| ERF INPUT          |             |
| CR ANNUNCIATION    |             |
| LOCAL ANNUNCIATION |             |
| CR INDICATION      |             |
| LOCAL INDICATION   |             |
| VALVE POSITION     |             |

**DESCRIPTION/OTHER**[illegible]

2VBB-UPS1A LOAD LIST  
DWG. NO. AE-100D  
SHEET 37 OF 117

**September 11, 1991**

27

6. 1. 18

2. 1. 18

UPS NO: 2VBB-UPS1A  
PNL NO: 2VBS-PNLA101  
BKR NO: 21  
CIRCUIT NO: N/A

### DRAWING REFERENCES

**EE-11J**

[illegible]

**UP81A**

**September 11, 1991**

2VBB-UPS1A LOAD LIST  
DWG. NO. AE-100D  
SHEET 38 OF 117

10. 10. 10.

11.

12.

13.

14.

15.

16.

17.

18.

19.

20.

21.

22.

23.

24.



UPS NO: 2VBB-UP81A  
PNL NO: 2VBS-PNLA101  
BKR NO: 22  
CIRCUIT NO: 28X8N09

### DRAWING REFERENCES

|                  |                 |
|------------------|-----------------|
| ESK-108XS27      | 147D7834, SH. 2 |
| 0007.520-001-375 | EE-11J          |
| 0007.521-001-157 | ESK-108XS17     |
| 0007.227-001-003 | EE-3AB          |
| 0007.227-001-014 |                 |
| 0007.227-001-018 |                 |

[illegible]

**UP81A**

**September 11, 1991**

2VBB-UPS1A LOAD LIST  
DWG. NO. AE-100D  
SHEET 39 OF 117

100

100

100

UPS NO: 2VBB-UPS1A  
PNL NO: 2VBS-PNLA101  
BKR NO: 23  
CIRCUIT NO: N/A

DRAWING REFERENCES

EE-11J

| FEED TO DEVICE | <u>DEVICE LOCATION</u> |      | PLANT IMPACT |
|----------------|------------------------|------|--------------|
|                | BLDG                   | ELEV |              |
| SPARE          |                        |      | NONE         |
|                |                        |      |              |
|                |                        |      |              |
UPS1A

September 11, 1991

2VBB-UPS1A LOAD LIST  
DWG. NO. AE-100D  
SHEET 40 OF 117

2  
3  
## DRAWING REFERENCES

|                  |                  |
|------------------|------------------|
| ESK-7LMS04       | EE-11J           |
| ESK-11LMS01      | EE-3BE           |
| ESK-11LMS02      | 147D7846, SH. 2  |
| 0007.520-001-658 | 0007.520-001-650 |
| 0007.520-001-649 | LSK-33-1A        |

[illegible]

2VBB-UPS1A LOAD LIST  
DWG. NO. AE-100D  
SHEET 41 OF 117

**September 11, 1991**



UPS NO: 2VBB-UPS1A  
 PNL NO: 2VBS-PNLA101  
 BKR NO: 25  
 CIRCUIT NO: 2SXS12

DRAWING REFERENCES

|                  |                  |
|------------------|------------------|
| 147D7834, SH. 2  | EE-11J           |
| 0007.227-001-003 | ESK-108XS19      |
| 0007.227-001-016 | EE-3AB           |
| 0007.227-001-019 | 0007.520-001-375 |
| ESK-108XS28      | 0007.520-001-157 |

| FEED TO DEVICE                     | DEVICE LOCATION |      | PLANT IMPACT   |
|------------------------------------|-----------------|------|--|
|                                    | BLDG            | ELEV |  |
| 2CEC*PNL709<br>BAY E JB306         | CCR             | 306  |  |
| C88A-W061                          |                 |      |  |
| 2CEC-PNL610                        | CCR             | 306  |  |
| C88A-J1220 (AW)<br>C88A-J1118 (AU) | CCR             | 306  | LOSS OF POWER TO OPTICAL XMTR<br>(GETARS) 2SXS-MUX18 AND MUX29 |
|                                    |                 |      |  |
|                                    |                 |      |  |
UPS1A

September 11, 1991

2VBB-UPS1A LOAD LIST  
 DWG. NO. AE-100D  
 SHEET 42 OF 117

100  
101  
UPS NO: 2VBB-UPS1A  
PNL NO: 2VBS-PNLA101  
BKR NO: 26  
CIRCUIT NO: 2RPSN11

### DRAWING REFERENCES

EE-11J  
ESK-11CEC03  
EE-3DK  
147D7848, SH. 2  
0007.520-001-350  
0007.520-001-337

[illegible]

**UP81A**

September 11, 1991

2VBB-UPS1A LOAD LIST  
DWG. NO. AE-100D  
SHEET 43 OF 117



UPS NO: 2VBB-UPS1A  
PNL NO: 2VBS-PNLA101  
BKR NO: 27  
CIRCUIT NO: 2RPSN02

### DRAWING REFERENCES

EE-11J  
ESK-11CEC04  
EE-3AX  
0007.520-001-354  
0007.520-001-357  
0007.520-001-342  
147D7848, SH. 2

[illegible]

**UP81A**

**September 11, 1991**

2VBB-UPS1A LOAD LIST  
DWG. NO. AE-100D  
SHEET 44 OF 117

1. 2. 3. 4. 5.

6.

7.

8. 9. 10.

11.

12.

13.

14. 15.

16. 17. 18. 19. 20.

21.

22.

23.

24.

25.

26.

27.

28.

29.

30.

31.

32.

33.

34.

35.

36.

UPS NO: 2VBB-UPS1A  
PNL NO: 2VBS-PNLA101  
BKR NO: 28  
CIRCUIT NO: 2CPSN09

## DRAWING REFERENCES

EE-11J  
LSK-22-23A  
EE-3DJ  
147D7848, SH. 2  
0007.520-001-658  
0007.520-001-647  
ESK-11CEC05

[illegible]

**UP81A**

**September 11, 1991**

2VBB-UPS1A LOAD LIST  
DWG. NO. AE-100D  
SHEET 45 OF 117









UPS NO: 2VBB-UPS1A  
PNL NO: 2VBS-PNLA101  
BKR NO: 30  
CIRCUIT NO: 2DR8N01  
2GT8N01

### DRAWING REFERENCES

|            |                  |
|------------|------------------|
| ESK-7DRS01 | EE-11J           |
| ESK-7GTS04 | EE-3AS           |
| ESK-6DRS01 | 0007.520-001-590 |
| ESK-6DRS02 | 0007.520-001-584 |
| ESK-6DRS03 | 147D7857, SH. 2  |
| ESK-6DRS04 | LSK-27-15H       |
| ESK-6DRS05 | LSK-22-22        |

[illegible]

**UP81A**

**September 11, 1991**

2VBB-UPS1A LOAD LIST  
DWG. NO. AE-100D  
SHEET 47 OF 117



2VBB-UPS1A LOAD LIST  
DWG. NO. AE-100D  
SHEET 48 OF 117

1

2

3

4

5

6

7

8

9

10

11

UPS NO: 2VBB-UPS1A  
PNL NO: 2VBS-PNLA101  
BKR NO: 32  
CIRCUIT NO: N/A

DRAWING REFERENCES

EE-11J

| FEED TO DEVICE | DEVICE LOCATION |      | PLANT IMPACT |
|----------------|-----------------|------|--------------|
|                | BLDG            | ELEV |              |
| SPARE          |                 |      | NONE         |
|                |                 |      |              |
|                |                 |      |              |
UPS1A

September 11, 1991

2VBB-UPS1A LOAD LIST  
DWG. NO. AE-100D  
SHEET 49 OF 117



### DRAWING REFERENCES

EE-11J

[illegible]

**UP81A**

**September 11, 1991**

2VBB-UPS1A LOAD LIST  
DWG. NO. AE-100D  
SHEET 50 OF 117

1000

1000



**CIRCUIT NO: N/A**

**EE-11J**

**NONE**

**SHEET 51 OF 117**



UPS NO: 2VBB-UPS1A  
 PNL NO: 2VBS-PNLA101  
 BKR NO: 35  
 CIRCUIT NO: N/A

DRAWING REFERENCES

EE-11J  
 EE-3FN  
 0007.330-002-022 THRU-035

| FEED TO DEVICE                        | DEVICE LOCATION |      | PLANT IMPACT  |
|---------------------------------------|-----------------|------|---|
|                                       | BLDG            | ELEV |   |
| 2CEC-PNL738<br>(PULL THRU)            | CRR             | 288  |   |
| 2EHC-W117<br>2EHC-W115                | CRR             | 288  |   |
| 2CEC-PNL848<br>BAY F<br>(EHC CABINET) | CRR             | 288  |   |
| S1 SWITCH BOX                         | CRR             | 288  | LOSS OF THE LOAD REFERENCE<br>MOTOR, THE 1ST STAGE PRESSURE<br>POTENTIOMETER MOTOR, FAST ACTING<br>SOLENOID VALVES. POWER SUPPLY<br>REDUNDANCY PROVIDED BY MAGNETIC<br>GENERATOR.<br>NOTE: MAY CAUSE TURBINE TRIP |
|                                       |                 |      |   |
|                                       |                 |      |   |
UPS1A  
 September 11, 1991

2VBB-UPS1A LOAD LIST  
 DWG. NO. AE-100D  
 SHEET 52 OF 117

100

100

100

100

### DRAWING REFERENCES

|                  |                  |
|------------------|------------------|
| 0007.221-001-012 | EE-11J           |
| 0007.221-001-016 | EE-3AC           |
| 0007.221-001-017 | 0007.522-001-407 |
| 0007.221-001-041 | 147D7834, SH. 2  |

[illegible]

2VBB-UPS1A LOAD LIST  
DWG. NO. AE-100D  
SHEET 53 OF 117

September 11, 1991

1940

1940

UPS NO: 2VBB-UPS1A  
PNL NO: 2VBS-PNLA101  
BKR NO: 37  
CIRCUIT NO: 2RDSN05

### DRAWING REFERENCES

|                  |                 |
|------------------|-----------------|
| 0007.221-001-012 | EE-11J          |
| 0007.221-001-017 | EE-3DE          |
| 0007.221-001-013 | 147D7826, SH. 2 |
| 0007.520-001-350 |                 |
| 0007.520-001-353 |                 |

[illegible]

**UP81A**

September 11, 1991

2VBB-UPS1A LOAD LIST  
DWG. NO. AE-100D  
SHEET 54 OF 117

1000




















UPS NO: 2VBB-UPS1A  
PNL NO: 2VBS-PNLA101  
BKR NO: 38  
CIRCUIT NO: 2IHAA07

### DRAWING REFERENCES

**EE-11J****EE-3AN**

ESK-10IHA40, SH. 2

**147D7851, SH. 2**

[illegible]

**UP81A**

**September 11, 1991**

2VBB-UPS1A LOAD LIST  
DWG. NO. AE-100D  
SHEET 55 OF 117

1000






















**DRAWING REFERENCES**  
**EE-11J**  
**EE-3CR**  
**14707829, SH. 2**  
**0007.520-001-420**  
**0007.520-001-403**  
**0007.221-001-010**

[illegible]

2VBB-UPS1A LOAD LIST  
DWG. NO. AE-100D  
SHEET 56 OF 117

**September 11, 1991**



UPS NO: 2VBB-UPS1A  
 PNL NO: 2VBS-PNLA102  
 BKR NO: 1  
 DIST PNL NO: 2CEC-PNL613

PLANT IMPACT: LOSS OF POWER TO C12-K600

| LOOP   | PMS INDICATION | PMS ALARM | ERF INPUT | CR ANNUNCIATION | LOCAL ANNUNCIATION | CR INDICATION | LOCAL INDICATION | VALVE POSITION | DESCRIPTION/OTHER  |
|--|----------------|-----------|-----------|-----------------|--------------------|---------------|------------------|----------------|--|
| 24VDC PWR<br>SUPPLY<br>C12-K600<br>807E159TY |                |           |           |                 |                    | X             | X                |                | (C12-N008 DIFF<br>PRESS XMTR) CRD<br>DRIVE WATER DIFF<br>PRESSURE                |
| 24VDC PWR<br>SUPPLY<br>C12-K600<br>807E159TY |                |           |           |                 |                    | X             | X                |                | (C12-N011 DIFF<br>PRESS XMTR) CRD<br>COOLING WTR DIFF<br>PRESSURE                |
| 24VDC PWR<br>SUPPLY<br>C12-K600<br>807E159TY |                | X         |           | X               |                    | X             | X                |                | (C12-N005 PRESS<br>XMTR) CRD HYD<br>SYSTEM CHARGING<br>WATER PRESS               |
| 24VDC PWR<br>SUPPLY<br>C12-K600<br>807E159TY |                | X         |           | X               |                    |               |                  |                | (C12-N052 PRESS<br>XMTR) CRD SCRAM<br>VALVE PILOT AIR<br>HDR PRESS HIGH &<br>LOW |
| 24VDC PWR<br>SUPPLY<br>C12-K600<br>807E159TY | X              |           |           |                 |                    | X             | X                | FC             | (C12-N004 FLOW<br>XMTR) CRD HYD<br>SYSTEM FLOW<br>CONTROL 2RDS-FV6A<br>& 6B      |

UPS1A

September 11, 1991

2VBB-UPS1A LOAD LIST  
 DWG. NO. AE-100D  
 SHEET 57 OF 117

2

2500 3 24

21

UPS NO: 2VBB-UPS1A  
 PNL NO: 2VBS-PNLA102  
 BKR NO: 1  
 DIST PNL NO: 2CEC-PNL613

PLANT IMPACT: LOSS OF POWER TO C12-K600

| LOOP   | PMS INDICATION | PMS ALARM | ERF INPUT | CR ANNUNCIATION | LOCAL ANNUNCIATION | CR INDICATION | LOCAL INDICATION | VALVE POSITION | DESCRIPTION/OTHER   |
|--|----------------|-----------|-----------|-----------------|--------------------|---------------|------------------|----------------|---|
| 24VDC PWR<br>SUPPLY<br>C12-K600<br>807E159TY |                |           |           |                 |                    | X             |                  |                | (C12-N009 FLOW<br>XMTR) CRD COOLING<br>WTR FLOW   |
| 24VDC PWR<br>SUPPLY<br>C12-K600<br>807E159TY |                |           |           |                 |                    | X             | X                |                | (C12-N007 FLOW<br>XMTR) CRD DRIVE<br>WATER FLOW   |
| 24VDC PWR<br>SUPPLY<br>C12-K600<br>791E406TY |                |           |           |                 |                    |               |                  |                | (C12-N054A PRESS<br>XMTR) 1ST STAGE<br>TURBINE PRESSURE<br>RSCS LOW POWER<br>ALARM/SETPOINT 1<br>INOP |
| 24VDC PWR<br>SUPPLY<br>C12-K600<br>791E406TY |                |           |           |                 |                    |               |                  |                | (C12-N054B PRESS<br>XMTR) 1ST STAGE<br>TURBINE PRESSURE<br>RRCS LOW POWER<br>ALARM/SETPOINT 2<br>INOP |

UPS1A

September 11, 1991

2VBB-UPS1A LOAD LIST  
 DWG. NO. AE-100D  
 SHEET 58 OF 117





**BKR NO: 2**  
**CIRCUIT NO: 2M88N19**

EE-11J  
EE-3CQ  
147D7829, SH. 2  
0007.520-001-425  
0007.520-001-424

[illegible]

**September 11, 1991**

2VBB-UPS1A LOAD LIST  
DWG. NO. AE-100D  
SHEET 59 OF 117

4. 1

2. 1

3. 1

5. 1

6. 1

7. 1

8. 1

UPS NO: 2VBB-UPS1A  
 PNL NO: 2VBS-PNLA102  
 BKR NO: 2  
 DIST PNL NO: 2CEC-PNL619

PLANT IMPACT: LOSS OF POWER TO B22-K615

| LOOP  | PMS INDICATION | PMS ALARM | ERF INPUT | CR ANNUNCIATION | LOCAL ANNUNCIATION | CR INDICATION | LOCAL INDICATION | VALVE POSITION | DESCRIPTION/OTHER  |
|---|----------------|-----------|-----------|-----------------|--------------------|---------------|------------------|----------------|--|
| FUSE B22B-F1<br>B22-K615<br>24VDC POWER<br>SUPPLY |                |           |           |                 |                    |               |                  |                |  |
| (807E159TY)                                       | X              |           |           |                 | X                  |               |                  |                | LOSS OF JET PUMPS<br>TOTAL FLOW LOOP A<br>AND B                                    |
| (807E159TY)                                       | X              |           |           |                 | X                  |               |                  |                | (B22-N034A THRU W<br>FLOW XMTR) JET<br>PUMP JP-1 THRU JP-<br>2                     |
| (807E159TY)                                       | X              |           |           |                 | X                  |               |                  |                | (B22-N033 THRU D<br>FLOW XMTR)<br>CALIBRATED JET<br>PUMP FLOW JP-5,<br>10, 15 & 20 |
| (807E159TY)                                       | X              |           |           |                 | X                  |               |                  |                | (B22-N032 DIFF<br>PRESS XMTR)<br>REACTOR CORE PLATE<br>DIFFERENTIAL<br>PRESSURE    |
| B22B-F2 FUSE                                      | X              |           |           |                 | X                  |               |                  |                | TOTAL JET PUMP<br>FLOW SUMMING LOGIC<br>INOP                                       |

UPS1A

September 11, 1991

2VBB-UPS1A LOAD LIST  
 DWG. NO. AE-100D  
 SHEET 60 OF 117

1  
2  
2VBB-UPS1A LOAD LIST  
DWG. NO. AE-100D  
SHEET 61 OF 117

11  
12

13  
14

15

16

17

18

19

20

21

22

23

24

25

26

27

### DRAWING REFERENCES

EE-11J  
0007.159-451-323  
EE-3AJ

[illegible]

**UP81A**

**September 11, 1991**

2VBB-UPS1A LOAD LIST  
DWG. NO. AE-100D  
SHEET 62 OF 117

100

1

100

1

1

1

1

1

1

1

1

1

1



UPS NO: 2VBB-UPS1A  
 PNL NO: 2VBS-PNLA102  
 BKR NO: 4

PLANT IMPACT: LOSS OF POWER TO 2CEC-PNL884

| LOOP                      | PMS INDICATION | PMS ALARM | ERF INPUT | CR ANNUNCIATION | LOCAL ANNUNCIATION | CR INDICATION | LOCAL INDICATION | VALVE POSITION | DESCRIPTION/OTHER  |
|---------------------------|----------------|-----------|-----------|-----------------|--------------------|---------------|------------------|----------------|--|
| 2ASS-6A<br>LSK-3-9D       | X              | X         |           | X               |                    | X             |                  |                | AUX. STEAM FLOW TO<br>AIR REMOVAL SYSTEM   |
| 2MSS-103<br>LSK-3-1D & 1E | X              |           |           |                 |                    |               |                  |                | 2TMS-T1 FIRST<br>STAGE<br>PRESSURE/GROUP 1<br>DRAIN VALVES   |
| 2WTS-243<br>LSK-13-1B     | X              | X         |           | X               | X                  |               | X                |                | NEUTRALIZER TANK<br>LEVEL HIGH/INHIBIT<br>THE START OF<br>REGENERATION                                 |
| 2DSR-68A<br>LSK-32-6B     | X              | X         |           | X               |                    |               | X                | FO             | REHEATER DRAIN<br>RECEIVER TANK 6A<br>WATER LEVEL, LOSS<br>OF CONTROL OF LV-<br>68A                    |
| 2FOF-101<br>LSK-15-1.2C   |                |           |           | X               |                    |               | X                |                | FUEL OIL STORAGE<br>TANK LEVEL<br>FIRE COMPUTER<br>ALARM   |
| 2DSR-78A<br>LSK-32-6E     | X              | X         |           | X               |                    |               |                  | FAI            | SCAVENGING STEAM<br>LINE A PRESSURE<br>LOSS OF CONTROL OF<br>MOV-86A                                   |
| 2MSS-104<br>LSK-3-1E      | X              |           |           |                 |                    |               |                  | FO             | 2TMS-TI 1ST STAGE<br>PRESSURE/LOSS OF<br>CONTROL OF<br>AOV85A,B,C,D,<br>2CNM-AOV101 AND<br>2CNM-AOV109 |
| 2CNS-8A<br>LSK-4-3A       | X              | X         | X         | X               |                    | X             |                  |                | CNDS. STOR TK1A<br>LEVEL   |

UPS1A

September 11, 1991

2VBB-UPS1A LOAD LIST  
 DWG. NO. AE-100D  
 SHEET 63 OF 117



UPS NO: 2VBB-UPS1A  
 PNL NO: 2VBS-PNLA102  
 BKR NO: 4

PLANT IMPACT: LOSS OF POWER TO 2CEC-PNL884

| LOOP                      | PMS INDICATION | PMS ALARM | ERF INPUT | CR ANNUNCIATION | LOCAL ANNUNCIATION | CR INDICATION | LOCAL INDICATION | VALVE POSITION | DESCRIPTION/OTHER   |
|---------------------------|----------------|-----------|-----------|-----------------|--------------------|---------------|------------------|----------------|---|
| 2MSS-101<br>LSK-3-1B, F   | X              |           |           |                 |                    |               |                  |                | 2TMS-T1 MAIN STEAM<br>INLET HDR. PRESSURE<br>LOSS OF 2ASS-STV112<br>& 2ASS-AOV145         |
| 2MSS-24A<br>LSK-3-1A      | X              |           |           |                 | X                  |               |                  |                | E1A REHEATING STEAM<br>TEMP   |
| 2DSR-103<br>LSK-32-6C     | X              |           |           |                 |                    |               |                  |                | SCAVENGING STEAM<br>HEADER PRESSURE   |
| 2MSS-22A<br>LSK-3-1M, 3-2 | X              |           |           |                 | X                  |               |                  | FC             | MS/R REGULATED<br>STEAM PRESSURE LOSS<br>OF CONTROL OF 2MSS-<br>PV28A AND 29A             |
| 2CRS-1A<br>LSK-3-2        | X              |           |           |                 |                    |               |                  |                | HIGH PRESSURE<br>TURBINE EXHAUST<br>COLD REHEATER STEAM<br>TO 2MSS-E1A SHELL<br>PRESSURE. |
| 2CRS-2A<br>LSK-3-2        | X              |           |           |                 |                    |               |                  |                | H.P. TURB. EXH.<br>COLD REHEATER STEAM<br>TO 2MSS-E1A SHELL<br>PRESSURE.                  |
| 2CRS-3A<br>LSK-3-2        | X              |           |           |                 |                    |               |                  |                | H.P. TURBINE EXH.<br>COLD REHEATER STEAM<br>TO 2MSS-E1A SHELL<br>PRESSURE.                |
| 2CRS-16A<br>LSK-3-2       | X              |           |           |                 |                    |               |                  |                | H.P. TURB. EXH.<br>COLD REHEATER STEAM<br>TO 2MSS-E1A SHELL<br>PRESSURE                   |
| 2CRS-19A<br>LSK-3-2       | X              |           |           |                 |                    | X             |                  |                | REHEATER A COLD<br>REHEAT PRESSURE  |

UPS1A

September 11, 1991

2VBB-UPS1A LOAD LIST  
 DWG. NO. AE-100D  
 SHEET 64 OF 117

100-100










UPS NO: 2VBB-UPS1A  
 PNL NO: 2VBS-PNLA102  
 BKR NO: 4

PLANT IMPACT: LOSS OF POWER TO 2CEC-PNL884

| LOOP                 | PMS INDICATION | PMS ALARM | ERF INPUT | CR ANNUNCIATION | LOCAL ANNUNCIATION | CR INDICATION | LOCAL INDICATION | VALVE POSITION | DESCRIPTION/OTHER                            |
|----------------------|----------------|-----------|-----------|-----------------|--------------------|---------------|------------------|----------------|--|
| 2ESS-1A<br>LSK-3-4A  | X              |           |           |                 |                    | X             |                  |                | 6TH POINT HTR 2FWS-E6A EXTR ST. PRESS.       |
| 2ESS-4A<br>LSK-3-4A  | X              |           |           |                 |                    |               |                  |                | TURB. 4TH STG EXTR STEAM PRESSURE            |
| 2ESS-7A<br>LSK-3-4G  | X              |           |           |                 |                    | X             |                  |                | 1ST POINT HTR 2CNM-E1A SHELL PRESSURE        |
| 2ESS-12A<br>LSK-3-4G | X              |           |           |                 |                    |               | X                |                | 2ND POINT HTR 2CNM-E2A SHELL PRESSURE        |
| 2ESS-17A<br>LSK-3-4F | X              |           |           |                 |                    |               | X                |                | 3RD POINT HTR 2CNM-E3A EXTR SHELL PRESSURE   |
| 2ESS-25A<br>LSK-3-4D | X              |           |           |                 |                    |               | X                |                | 4TH POINT HTR. 2CNM-E4A EXTR. STEAM PRESSURE |
| 2ESS-31A<br>LSK-3-4B | X              |           |           |                 |                    |               | X                |                | 5TH POINT HTR 2CNM-E5A EXTR STEAM PRESSURE   |
| 2HRS-7A<br>LSK-3-3   | X              |           |           |                 |                    |               |                  |                | 2TMS-T2A LP TURBINE INL PRESS.FR 2MSS-E1A    |
| 2HRS-8A<br>LSK-3-3   | X              |           |           |                 |                    |               |                  |                | 2TMS-T2A HRS FROM 2MSS-E1B                   |
| 2HRS-9A<br>LSK-3-3   | X              |           |           |                 |                    |               |                  |                | 2TMS-T2A HRS FROM 2MSS-E1B                   |
| 2MSS-23A<br>LSK-3-1A | X              |           |           | X               |                    |               |                  |                | E1A REHEATING STEAM FLOW                     |

UPS1A

September 11, 1991

2VBB-UPS1A LOAD LIST  
 DWG. NO. AE-100D  
 SHEET 65 OF 117

5000-0000

5000-0000

UPS NO: 2VBB-UPS1A  
 PNL NO: 2VBS-PNL102  
 BKR NO: 4

PLANT IMPACT: LOSS OF POWER TO 2CEC-PNL884

| LOOP                    | PMS INDICATION | PMS ALARM | ERF INPUT | CR ANNUNCIATION | LOCAL ANNUNCIATION | CR INDICATION | LOCAL INDICATION | VALVE POSITION | DESCRIPTION/OTHER  |
|-------------------------|----------------|-----------|-----------|-----------------|--------------------|---------------|------------------|----------------|--|
| 2MSS-52A<br>LSK-3-1A    | X              |           |           | X               |                    |               |                  |                | E1A STEAM SUPPLY PRESS   |
| 2DSM-75A<br>LSK-32-7A   | X              |           |           |                 |                    |               | X                | FC             | MOISTURE SEP. DRAIN RECEIVER TK4A WTR LEVEL/ LOSS OF CONTROL OF LUX75A, LVY75A, LVZ75A |
| 2DSM-78A<br>LSK-32-7B   | X              | X         |           | X               |                    |               | X                | FO             | MOIST SEP. DRAIN RECEIVER TK4A WTR LEVEL/LOSS OF CONTROL OF LV78A                      |
| 2DSR-65A<br>LSK-32-6A   | X              |           |           |                 |                    |               | X                | FC             | NORM WTR LVL DR CONTROL/LOSS OF CONTROL OF LVX65A, LVY65A, AND LVZ65A                  |
| 2CMS-72A,C<br>LSK-33-2A | X              |           |           |                 |                    | X             |                  |                | CONTAINMENT DEW PT.  |
| 2CNS-130<br>LSK-4-3A    | X              |           |           |                 |                    |               |                  |                | CONDENSATE DRAW OFF FLOW PRESSURE  |
| 2CNS-131<br>LSK-4-3A    | X              |           |           |                 |                    |               |                  |                | NORMAL CONDENSATE MAKEUP FLOW  |

UPS1A

September 11, 1991

2VBB-UPS1A LOAD LIST  
 DWG. NO. AE-100D  
 SHEET 66 OF 117

11  
12  
DRAWING REFERENCES  
EE-11J  
0007.159-451-328  
EE-3AJ

[illegible]

2VBB-UPS1A LOAD LIST  
DWG. NO. AE-100D  
SHEET 67 OF 117

**September 11, 1991**

100

101

102

103

104

105

106

107

108

109

110

111

112

113

114

115

116

117

118

119

120

100

UPS NO: 2VBB-UPS1B  
 PNL NO: 2VBS-PNLB102  
 BKR NO: 4  
 UPS NO: 2VBB-UPS1A  
 PNL NO: 2VBS-PNLA102  
 BKR NO: 5

PLANT IMPACT: LOSS OF POWER TO 2CEC-PNL885

| LOOP                 | PMS INDICATION | PMS ALARM | ERF INPUT | CR ANNUNCIATION | LOCAL ANNUNCIATION | CR INDICATION | LOCAL INDICATION | VALVE POSITION | DESCRIPTION/OTHER   |
|----------------------|----------------|-----------|-----------|-----------------|--------------------|---------------|------------------|----------------|---|
| 2CNS-8B<br>LSK-4-3A  | X              | X         | X         | X               |                    | X             |                  |                | CNDS STOR TK1B<br>LEVEL   |
| 2CNS-114<br>LSK-4-3B | X              | X         |           | X               |                    | X             |                  |                | CNDS XFR HDR FLOW<br>HIGH/INHIBIT AUTO<br>START OF 2CNS-P1A<br>OR 2CNS-P1B                  |
| 2CNS-102<br>LSK-4-3E | X              |           |           |                 |                    | X             |                  |                | COND HOT WELL LEVEL   |
| 2ESS-25B<br>LSK-3-4D | X              |           |           |                 |                    |               | X                |                | 4TH PT HTR EXTR ST<br>PRESS   |
| 2ESS-17B<br>LSK-3-4F | X              |           |           |                 |                    |               | X                |                | 3RD PT HTR EXTR ST<br>PRESS   |
| 2ESS-12B<br>LSK-3-4G | X              |           |           |                 |                    |               | X                |                | 2ND PT HTR SHELL<br>PRESS   |
| 2MSS-52B<br>LSK-3-1A | X              |           |           |                 |                    | X             |                  |                | E1B STEAM SUPPLY<br>PRESS   |
| 2MSS-24B<br>LSK-3-1A | X              |           |           |                 |                    | X             |                  |                | E1B REHEATING STEAM<br>TEMP   |
| 2MSS-23B<br>LSK-3-1A | X              |           |           | X               |                    |               |                  |                | E1B REHEATING STEAM<br>FLOW   |
| 2ESS-4B<br>LSK-3-4A  | X              |           |           |                 |                    |               |                  |                | TURB 4TH STG EXTR<br>ST PRESS   |
| 2ESS-31B<br>LSK-3-4B | X              |           |           |                 |                    |               | X                |                | 5TH PT HTR 2CNM-ESB<br>EXTR ST. PRESS   |
| 2MSS-22B<br>LSK-3-1A | X              |           |           |                 |                    | X             |                  |                | MS/R REGULATED<br>STEAM PRESS/LOSS OF<br>CONTROL OF REHEAT<br>CONTROL VALVES<br>PV28B&PV29B |
|                      |                |           |           |                 |                    |               |                  | FC             |   |

UPS1A

September 11, 1991

2VBB-UPS1A LOAD LIST  
 DWG. NO. AE-100D  
 SHEET 68 OF 117

3  
 1  
 2  
UPS NO: 2VBB-UPS1B  
 PNL NO: 2VBS-PNLB102  
 BKR NO: 4  
 UPS NO: 2VBB-UPS1A  
 PNL NO: 2VBS-PNLA102  
 BKR NO: 5

PLANT IMPACT: LOSS OF POWER TO 2CEC-PNL885

| LOOP                  | PMS INDICATION | PMS ALARM | ERF INPUT | CR ANNUNCIATION | LOCAL ANNUNCIATION | CR INDICATION | LOCAL INDICATION | VALVE POSITION | DESCRIPTION/OTHER   |
|-----------------------|----------------|-----------|-----------|-----------------|--------------------|---------------|------------------|----------------|---|
| 2HRS-7B<br>LSK-3-3    | X              |           |           |                 |                    |               |                  |                | 2TMS-T2B LP<br>TURBINE INL PRESS<br>FR 2MSS-E1A                             |
| 2HRS-8B<br>LSK-3-3    | X              |           |           |                 |                    |               |                  |                | 2TMS-T2B HRS FROM<br>2MSS-E1A   |
| 2HRS-9B<br>LSK-3-3    | X              |           |           |                 |                    |               |                  |                | 2TMS-T2B HRS FROM<br>2MSS-E1B   |
| 2ASS-6B<br>LSK-3-9D   | X              | X         |           | X               |                    | X             |                  |                | AUX. STM FLOW TO<br>AIR REMOVAL   |
| 2DSR-68B<br>LSK-32-6B | X              | X         |           | X               |                    |               | X                | FO             | DRAIN RECEIVER<br>HIGH LEVEL/LOSS OF<br>CONTROL OF LV68B                    |
| 2DSR-65B<br>LSK-32-6A | X              |           |           |                 |                    |               | X                | FC             | NORM WTR LVL DR<br>CONTROL/LOSS OF<br>CNTRL OF LVX65B,<br>LVY65B AND LVZ65B |
| 2DSM-75B<br>LSK-32-7A | X              |           |           |                 |                    |               | X                |                | MOISTURE SEP.<br>DRAIN RECEIVER<br>TK4B WTR LEVEL                           |
| 2DSM-78B<br>LSK-32-7B | X              | X         |           | X               |                    |               | X                | FO             | MOIST SEP DR RCVR<br>TK4B WTR<br>LEVEL/LOSS OF<br>CONTROL OF LV78B          |
| 2DSR-78B<br>LSK-32-6E | X              | X         |           | X               |                    |               |                  | FAI            | SCAVENGING STEAM<br>LINE B<br>PRESSURE/LOSS OF<br>CONTROL OF MOV 86B        |
| 2ESS-7B<br>LSK-3-4G   | X              |           |           |                 |                    | X             |                  |                | 1ST PT HTR 2CNM-<br>E1B SHELL PRESS   |
| 2ESS-1B<br>LSK-3-4A   | X              |           |           |                 |                    | X             |                  |                | 6TH PT HTR 2FWS-<br>E6B EXTR ST. PRESS                                      |

UPS1A

September 11, 1991

2VBB-UPS1A LOAD LIST  
 DWG. NO. AE-100D  
 SHEET 69 OF 117



UPS NO: 2VBB-UPS1B  
 PNL NO: 2VBS-PNLB102  
 BKR NO: 4  
 UPS NO: 2VBB-UPS1A  
 PNL NO: 2VBS-PNLA102  
 BKR NO: 5

PLANT IMPACT: LOSS OF POWER TO 2CEC-PNL885

| LOOP                      | PMS INDICATION | PMS ALARM | ERF INPUT | CR ANNUNCIATION | LOCAL ANNUNCIATION | CR INDICATION | LOCAL INDICATION | VALVE POSITION | DESCRIPTION/OTHER  |
|---------------------------|----------------|-----------|-----------|-----------------|--------------------|---------------|------------------|----------------|--|
| 2CRS-103<br>LSK-3-1M, 3-2 | X              |           |           |                 |                    | X             |                  | FC             | REHEATER 1B SHELL<br>PRESSURE/LOSS OF<br>CONTROL OF PV28A,<br>PV28B, PV29A &<br>PV29B  |
| 2CRS-1B<br>LSK-3-2        | X              |           |           |                 |                    |               |                  |                | HIGH PRESSURE<br>TURBINE EXH. COLD<br>REHEATER STEAM TO<br>2MSS-E1B SHELL<br>PRESSURE. |
| 2CRS-2B<br>LSK-3-2        | X              |           |           |                 |                    |               |                  |                | HP TURB EXH COLD<br>REHEATER STEAM TO<br>2MSS-E1B SHELL<br>PRESSURE.                   |
| 2CRS-3B<br>LSK-3-2        | X              |           |           |                 |                    |               |                  |                | HP TURB EXH COLD<br>REHEATER STEAM TO<br>2MSS-E1B SHELL<br>PRESSURE.                   |
| 2CRS-16B<br>LSK-3-2       | X              |           |           |                 |                    |               |                  |                | HP TURB EXH. COLD<br>REHEATER STEAM TO<br>2MSS-E1B SHELL<br>PRESS.                     |
| 2CRS-19B<br>LSK-3-2       | X              |           |           |                 |                    | X             |                  |                | REHEATER B COLD<br>REHEAT PRESS.   |
| 2CMS-72B,D<br>LSK-33-2A   | X              |           |           |                 |                    | X             |                  |                | CONTAINMENT DEW<br>POINT   |

UPS1A

September 11, 1991

2VBB-UPS1A LOAD LIST  
 DWG. NO. AE-100D  
 SHEET 70 OF 117

1111


































### DRAWING REFERENCES

EE-11J  
0007.159-451-331  
EE-3AK

[illegible]

**UP81A**

**September 11, 1991**

2VBB-UPS1A LOAD LIST  
DWG. NO. AE-100D  
SHEET 71 OF 117



UPS NO: 2VBB-UPS1A  
 PNL NO: 2VBS-PNLA102  
 BKR NO: 6

PLANT IMPACT: LOSS OF POWER TO 2CEC-PNL886

| LOOP                    | PMS INDICATION | PMS ALARM | ERF INPUT | CR ANNUNCIATION | LOCAL ANNUNCIATION | CR INDICATION | LOCAL INDICATION | VALVE POSITION | DESCRIPTION/OTHER   |
|-------------------------|----------------|-----------|-----------|-----------------|--------------------|---------------|------------------|----------------|---|
| 2AAS-113<br>LSK-12-9B   | X              | X         |           | X               |                    | X             |                  |                | BRTHG AIR HDR PRESS   |
| 2ARC-20B<br>LSK-5-1B    | X              | X         |           | X               |                    |               |                  |                | AIR REMOVAL PUMP-1B<br>SEAL WTR TEMP HI                                   |
| 2ASS-116<br>LSK-3-9D    | X              | X         |           | X               |                    | X             |                  |                | CLN STM REBLR STM<br>PRESS  |
| 2ASS-122<br>LSK-3-9D    | X              | X         |           | X               |                    | X             |                  |                | AIR EJECTOR 2A STM<br>PRESS   |
| 2ASS-127<br>LSK-3-9D    | X              | X         |           | X               |                    |               | X                |                | OFFGAS STM PRESS  |
| 2CMS-72E,F<br>LSK-33-2A | X              |           |           |                 |                    | X             |                  |                | CONTAINMENT DEW<br>POINT  |
| 2CMS-168<br>LSK-33-2D   | X              |           |           |                 |                    | X             |                  |                | SUPPR CHAMBER PRESS<br>NORM   |
| 2CND-267<br>LSK-4-7D    | X              | X         |           | X               | X                  |               | X                |                | LOW CONDUCTIVITY<br>WASTE TK13 LEVEL                                      |
| 2CND-281<br>LSK-4-7C    | X              |           |           |                 |                    |               | X                |                | NEUTRALIZING TK12<br>LEVEL  |
| 2CPS-102<br>LSK-22-23A  | X              | X         |           | X               |                    | X             |                  |                | ENABLES 2CPS-FN1<br>(DISCH TO STOP<br>PERMISSIVES<br>DRYWELL)             |
| 2CPS-103<br>LSK-22-23A  | X              | X         |           | X               |                    | X             |                  |                | ENABLES 2CPS-FN1<br>(DISCH TO STOP<br>PERMISSIVES SUPPR<br>PL)            |
| 2CPS-125<br>LSK-22-23A  |                |           |           |                 |                    | X             |                  |                | PRIMARY CONTAINMENT<br>PRESS N2 INLET<br>FLOW/LOSS OF<br>CONTROL OF FV125 |
| 2CPS-126<br>LSK-22-23A  | X              | X         |           | X               |                    | X             |                  | FC             | PRIMARY CONTAINMENT<br>INLET NITROGEN FLOW                                |

UPS1A

September 11, 1991

2VBB-UPS1A LOAD LIST

DWG. NO. AE-100D

SHEET 72 OF 117



UPS NO: 2VBB-UPS1A  
 PNL NO: 2VBS-PNL1A102  
 BKR NO: 6

PLANT IMPACT: LOSS OF POWER TO 2CEC-PNL886

| LOOP                        | PMS INDICATION | PMS ALARM | ERF INPUT | CR ANNUNCIATION | LOCAL ANNUNCIATION | CR INDICATION | LOCAL INDICATION | VALVE POSITION | DESCRIPTION/OTHER                              |
|-----------------------------|----------------|-----------|-----------|-----------------|--------------------|---------------|------------------|----------------|--|
| 2CPS-127<br>LSK-22-23A      | X              | X         |           | X               |                    | X             |                  |                | PRIMARY CONTAINMENT<br>INLET NITROGEN<br>PRESS |
| 2GSN-138<br>LSK-14-1F       |                | X         |           | X               |                    | X             |                  |                | PRIMARY CONTAINMENT<br>N2 PURGE TEMP LOW       |
| 2HRS-7C<br>LSK-3-3          | X              |           |           |                 |                    |               |                  |                | 2TMS-T2C LP TURB<br>INL FR 2MSS-E1A            |
| 2HRS-8C<br>LSK-3-3          | X              |           |           |                 |                    |               |                  |                | 2TMS-T2C HRS FROM<br>2MSS-E1A                  |
| 2HRS-9C<br>LSK-3-3          | X              |           |           |                 |                    |               |                  |                | 2TMS-T2C HRS FROM<br>2MSS-E1B                  |
| 2IAS-101<br>LSK-12-1E       | X              | X         |           | X               |                    | X             |                  |                | INSTR AIR HDR PRESS                            |
| 2IAS-178<br>LSK-12-1C, 1F   | X              | X         |           | X               |                    | X             |                  |                | ADS CPRSR RCVR TANK<br>*TK4 PRESSURE HIGH      |
| 2IAS-183<br>LSK-12-1C       | X              | X         |           | X               |                    | X             |                  |                | ADS CPRSR RCVR TANK<br>*TK5 PRESSURE HIGH      |
| 2MWS-114<br>LSK-9-15, 13-1B | X              | X         |           | X               | X                  | X             |                  |                | DMNRLZD WTR TK 1A<br>OR 1B LVL                 |
| 2MWS-116<br>LSK-9-15        | X              | X         |           | X               |                    | X             | X                |                | DMNRLZD WTR PMP<br>DISCH FL                    |
| 2SSR-124<br>LSK-21-2B       | X              | X         |           | X               | X                  | X             |                  |                | CRD PUMP DISCH CNDT<br>SAMPLE                  |
| 2SSR-125<br>LSK-21-2B       | X              | X         |           | X               | X                  | X             |                  |                | CRD PUMP DISCH 02<br>SAMPLE                    |
| 2SST-106<br>LSK-21-1A       | X              | X         |           | X               | X                  | X             |                  |                | COND DMNRLZR INL<br>CNDT SAMPLE                |
| 2SST-113<br>LSK-21-1B       | X              | X         |           | X               | X                  | X             |                  |                | COND DEMIN OUT 02<br>SAMPLE                    |

UPS1A

September 11, 1991

2VBB-UPS1A LOAD LIST  
 DWG. NO. AE-100D  
 SHEET 73 OF 117

1-1

1-2

1-3

1-4

1-5

UPS NO: 2VBB-UPS1A  
 PNL NO: 2VBS-PNLA102  
 BKR NO: 6

PLANT IMPACT: LOSS OF POWER TO 2CEC-PNL886

| LOOP                   | PMS INDICATION | PMS ALARM | ERF INPUT | CR ANNUNCIATION | LOCAL ANNUNCIATION | CR INDICATION | LOCAL INDICATION | VALVE POSITION | DESCRIPTION/OTHER   |
|------------------------|----------------|-----------|-----------|-----------------|--------------------|---------------|------------------|----------------|---|
| 2SST-114<br>LSK-21-1B  | X              | X         |           | X               | X                  | X             |                  |                | COND DMNRLZR OUT<br>CNDT SAMPLE   |
| 2SST-131<br>LSK-21-1B  | X              | X         |           | X               | X                  | X             |                  |                | COM 6TH PT HTR OUT<br>CNDT SAMPLE   |
| 2SST-132<br>LSK-21-1C  | X              | X         |           | X               | X                  | X             |                  |                | COM 6TH PT HTR OUT<br>O2 SAMPLE   |
| 2SST-133<br>LSK-21-1C  | X              | X         |           | X               | X                  | X             |                  |                | COM 6TH PT HTR OUT<br>PH SAMPLE   |
| 2TML-132<br>LSK-16-2.1 | X              |           |           |                 |                    | X             |                  | FO             | OIL CLRS OUTLET OIL<br>TEMP/LOSS OF<br>CONTROL OF 2CCS-<br>TV43A AND 2CCS-<br>TV43B |
| 2ESS-1C<br>LSK-3-4A    | X              |           |           |                 |                    |               | X                |                | 6TH PT HTR 2FWS-E6C<br>EXTR STM PRESSURE  |
| 2ESS-7C<br>LSK-3-4G    | X              |           |           |                 |                    |               | X                |                | 1ST PT HTR 2CNM-E1C<br>SHELL PRESSURE   |
| 2ESS-12C<br>LSK-3-4G   | X              |           |           |                 |                    |               | X                |                | 2ND PT HTR 2CNM-E2C<br>SHELL PRESSURE   |
| 2ESS-17C<br>LSK-3-4F   | X              |           |           |                 |                    |               | X                |                | 3RD PT HTR 2CNM-E3C<br>EXTR STM PRESSURE  |
| 2ESS-25C<br>LSK-3-4D   | X              |           |           |                 |                    |               | X                |                | 4TH PT HTR 2CNM-E4C<br>EXTR STM PRESSURE  |
| 2ESS-31C<br>LSK-3-4B   | X              |           |           |                 |                    |               | X                |                | 5TH PT HTR 2CNM-E5C<br>EXTR STEAM PRESSURE  |

UPS1A

September 11, 1991

2VBB-UPS1A LOAD LIST  
 DWG. NO. AE-100D  
 SHEET 74 OF 117

10

11

12

13

14

15

16

17

18

19

20

21

22

23

24

25

26

27

28

29

30

31

32

33

34



UPS NO: 2VBB-UPS1A  
PNL NO: 2VBS-PNLA102  
BKR NO: 7  
CIRCUIT NO: 2CECA87

### DRAWING REFERENCES

EE-11J  
EE-3AK  
0007.159-451-512  
0007.159-451-334

[illegible]

**UP81A**

**September 11, 1991**

2VBB-UPS1A LOAD LIST  
DWG. NO. AE-100D  
SHEET 75 OF 117



UPS NO: 2VBB-UPS1A  
 PNL NO: 2VBS-PNLA102  
 BKR NO: 7  
 UPS NO: 2VBB-UPS1B  
 PNL NO: 2VBS-PNLB102  
 BKR NO: 6

PLANT IMPACT: LOSS OF POWER TO 2CEC-PNL887

| LOOP                      | PMS INDICATION | PMS ALARM | ERF INPUT | CR ANNUNCIATION | LOCAL ANNUNCIATION | CR INDICATION | LOCAL INDICATION | VALVE POSITION | DESCRIPTION/OTHER   |
|---------------------------|----------------|-----------|-----------|-----------------|--------------------|---------------|------------------|----------------|---|
| 2ARC-20A<br>LSK-5-1B      | X              | X         |           | X               |                    |               |                  |                | AIR REM PP1A SEAL W<br>TEMP H   |
| 2CNM-137                  |                |           |           |                 |                    | X             |                  |                | 2FWS-P1A,B,C<br>STARTUP BYPASS<br>VALVE POSITION<br>INDICATION  |
| 2CWS-47A<br>LSK-2-1.1D    | X              |           |           |                 |                    | X             |                  |                | CLG TWR RETURN<br>FLOW A  |
| 2DFR-106<br>LSK-23-6C     | X              | X         |           | X               |                    | X             |                  |                | DRYWELL FLOOR DRAIN<br>LEAKAGE TANK LEVEL   |
| 2DFR-137<br>LSK-23-6C     | X              | X         |           | X               |                    | X             |                  |                | DW FL DR PUMPS P1A<br>& P1B FLOW  |
| 2FWS-64A/B<br>LSK-6-1.1H  |                |           |           |                 |                    | X             |                  |                | FEEDWATER INLET<br>TEMP TO REACTOR<br>LINE A/B  |
| 2GMC-110<br>LSK-16-6C, 8D | X              |           |           |                 |                    | X             |                  |                | GENERATOR INLET<br>CONDUCTIVITY   |
| 2GMC-111<br>LSK-16-6C, 8D | X              |           |           |                 |                    | X             |                  |                | GENERATOR OUTLET<br>CONDUCTIVITY  |
| 2GMC-134<br>LSK-16-8C     | X              |           |           |                 |                    | X             |                  |                | ALT COOLER AIR<br>OUTLET TEMP, LOSE<br>CONTROL OF TURBINE<br>BLDG. CLOSED LOOP<br>COOLING WATER VALVE<br>2CCS-TV32A AND B |
|                           |                |           |           |                 |                    |               |                  | FO             |   |

UPS1A

September 11, 1991

2VBB-UPS1A LOAD LIST  
 DWG. NO. AE-100D  
 SHEET 76 OF 117



UPS NO: 2VBB-UPS1A  
 PNL NO: 2VBS-PNLA102  
 BKR NO: 7  
 UPS NO: 2VBB-UPS1B  
 PNL NO: 2VBS-PNLB102  
 BKR NO: 6

PLANT IMPACT: LOSS OF POWER TO 2CEC-PNL887

| LOOP                  | PMS INDICATION | PMS ALARM | ERF INPUT | CR ANNUNCIATION | LOCAL ANNUNCIATION | CR INDICATION | LOCAL INDICATION | VALVE POSITION | DESCRIPTION/OTHER  |
|-----------------------|----------------|-----------|-----------|-----------------|--------------------|---------------|------------------|----------------|--|
| 2GMH-105<br>LSK-16-7C | X              |           |           |                 |                    | X             |                  |                | GENERATOR GAS<br>PURITY  |
| 2GMH-117<br>LSK-16-7A | X              |           |           |                 |                    | X             |                  |                | GENERATOR GAS<br>PRESS   |
| 2GMH-156<br>LSK-16-7A |                |           |           |                 |                    | X             |                  | F0             | H2 COLD GAS<br>TEMP/TBCLC FLOW<br>MODULATING VALVE<br>2CCS-TV109 |
| 2GML-103<br>LSK-16-10 | X              | X         |           | X               |                    |               |                  |                | GEN LEADS CLR<br>RETURN AIR TEMP                                 |
|                       |                |           |           |                 |                    |               |                  |                |  |
100

100

100

100

100

UPS NO: 2VBB-UPS1A  
 PNL NO: 2VBS-PNLA102  
 BKR NO: 7  
 UPS NO: 2VBB-UPS1B  
 PNL NO: 2VBS-PNLB102  
 BKR NO: 6

PLANT IMPACT: LOSS OF POWER TO 2CEC-PNL887

| LOOP                      | PMS INDICATION | PMS ALARM | ERF INPUT | CR ANNUNCIATION | LOCAL ANNUNCIATION | CR INDICATION | LOCAL INDICATION | VALVE POSITION | DESCRIPTION/OTHER   |
|---------------------------|----------------|-----------|-----------|-----------------|--------------------|---------------|------------------|----------------|---|
| 2GMO-103<br>LSK-16-6      | X              |           |           |                 |                    | X             |                  |                | HYDRAUL SEAL OIL<br>BRG 9 PRESS   |
| 2GMO-104<br>LSK-16-6      | X              |           |           |                 |                    | X             |                  |                | HYDRAUL SEAL BRG<br>10 PRESS  |
| 2LOS-126<br>LSK-16-3      | X              | X         |           | X               | X                  |               | X                |                | DIRTY OIL STOR TK2<br>LEVEL/STOP LUBE<br>OIL XFER PUMP P2                             |
| 2LOS-127<br>LSK-16-3      | X              | X         |           | X               | X                  |               | X                |                | CLEAN OIL STOR TK1<br>LEVEL/STOP LUBE<br>OIL XFER PUMP P2                             |
| 2TME-15A,B<br>LSK-16-1.1A | X              |           |           |                 |                    | X             |                  |                | 2TME-E1A & E1B<br>REBLR DISCH STEAM<br>PRESS  |
| 2TME-103<br>LSK-16-1.1B   | X              |           |           |                 |                    | X             |                  | FAI            | E1A & E1B DISCH<br>HDR PRESS/LOSS OF<br>CONTROL OF 2TME-<br>MOV110, 2TME-<br>SOV121   |
| 2TME-107<br>LSK-16-1.1B   | X              |           |           |                 |                    | X             |                  | FAI            | E1A & B STEM SEAL<br>RED PRESS/LOSS OF<br>CONTROL OF 2TME-<br>MOV110, 2TME-<br>SOV121 |
| 2TME-108<br>LSK-16-1.1D   | X              |           |           |                 |                    | X             |                  |                | STEAM SEAL EXHAUST<br>VACUUM  |
| 2TMI-127<br>LSK-16-9      | X              |           |           |                 |                    | X             |                  |                | EXH HOOD A TURBINE<br>END TEMP  |
| 2TMI-128<br>LSK-16-9      | X              |           |           |                 |                    | X             |                  |                | EXH HOOD B TURBINE<br>TEMP  |
| 2TMI-129<br>LSK-16-9      | X              |           |           |                 |                    | X             |                  |                | EXH HOOD C TURBINE<br>TEMP  |

UPS1A

September 11, 1991

2VBB-UPS1A LOAD LIST  
 DWG. NO. AE-100D  
 SHEET 78 OF 117

1  
2  
**PLANT IMPACT: LOSS OF POWER TO 2CEC-PNL887**

|   | DESCRIPTION        |
|---|--------------------|
| 2 | PMS INDICATION     |
| 2 | PMS ALARM          |
|   | ERF INPUT          |
|   | CR ANNUNCIATION    |
|   | LOCAL ANNUNCIATION |
|   | CR INDICATION      |
|   | LOCAL INDICATION   |
|   | VALVE POSITION     |

[illegible]

**UP81A**

**September 11, 1991**

2VBB-UPS1A LOAD LIST  
DWG. NO. AE-100D  
SHEET 79 OF 117



UPS NO: 2VBB-UPS1A  
PNL NO: 2VBS-PNLA102  
BKR NO: 8  
CIRCUIT NO: 2EGSB07

### DRAWING REFERENCES

EE-11J  
EE-14C  
EE-14B  
0001.040-209-078  
0001.040-209-022

[illegible]

**UP81A**

**September 11, 1991**

2VBB-UPS1A LOAD LIST  
DWG. NO. AE-100D  
SHEET 80 OF 117

10

11

12

13

14

15

16

17

18

19

20

21

22

23

24

25

26

27

28

29

30

31

32

33

34

35

### DRAWING REFERENCES

0001.040-209-022

2VBB-UPS1A LOAD LIST  
DWG. NO. AE-100D  
SHEET 81 OF 117

20  
21  
22

23  
24  
25  
26  
27

28

29

30

31  
32

### DRAWING REFERENCES

**944E995 (C88)**

**EE-11J**

**EE-35D**

0007.511-414-479, 480

[illegible]

**UP81A**

**September 11, 1991**

2VBB-UPS1A LOAD LIST  
DWG. NO. AE-100D  
SHEET 82 OF 117





UPS NO: 2VBB-UPS1A  
PNL NO: 2VBS-PNLA102  
BKR NO: 11  
CIRCUIT NO: N/A

### DRAWING REFERENCES

**EE-11J**

[illegible]

**UP81A**

**September 11, 1991**

2VBB-UPS1A LOAD LIST  
DWG. NO. AE-100D  
SHEET 83 OF 117

100

100

100

100

2VBB-UPS1A LOAD LIST  
DWG. NO. AE-100D  
SHEET 84 OF 117

15

16

17

18

19

20

21

22

23

24

25

26

27

28

29

30

31

32

33

34

35

36

37

38

UPS NO: 2VBB-UPS1A  
PNL NO: 2VBS-PNLA102  
BKR NO: 13  
CIRCUIT NO: N/A

## DRAWING REFERENCES

EE-3TK  
EE-11J  
LOOP-2RMS-201  
LSK-22-IT

[illegible]

**UP81A**

**September 11, 1991**

2VBB-UP81A LOAD LIST  
DWG. NO. AE-100D  
SHEET 85 OF 117

11 11

12 12

13 13

14 14

15 15

16 16

17 17

18 18

19 19

20 20

21 21

### DRAWING REFERENCES

[illegible]

2VBB-UPS1A LOAD LIST  
DWG. NO. AE-100D  
SHEET 86 OF 117

[illegible]



### DRAWING REFERENCES

EE-11J  
EE-11GH

[illegible]

**UP81A**

**September 11, 1991**

2VBB-UPS1A LOAD LIST  
DWG. NO. AE-100D  
SHEET 87 OF 117



UPS NO: 2VBB-UPS1A  
PNL NO: 2VBS-PNLA102  
BKR NO: 16  
CIRCUIT NO: N/A

### DRAWING REFERENCES

EE-11J  
EE-3TF  
EE-11HL

[illegible]

**UP81A**

**September 11, 1991**

2VBB-UPS1A LOAD LIST  
DWG. NO. AE-100D  
SHEET 88 OF 117

100






















### DRAWING REFERENCES

**EE-11J**[illegible]

**UP81A**

**September 11, 1991**

2VBB-UPS1A LOAD LIST  
DWG. NO. AE-100D  
SHEET 89 OF 117

2

7

8

9

10

11

12

13

14

15

16

17

18

19

20

21

UPS NO: 2VBB-UPS1A  
PNL NO: 2VBS-PNLA102  
BKR NO: 18  
CIRCUIT NO: N/A

### DRAWING REFERENCES

**EE-11J**[illegible]

**UP81A**

**September 11, 1991**

2VBB-UPS1A LOAD LIST  
DWG. NO. AE-100D  
SHEET 90 OF 117

•















UPS NO: 2VBB-UPS1A  
PNL NO: 2VBS-PNLA102  
BKR NO: 19  
CIRCUIT NO: N/A

### DRAWING REFERENCES

**EE-11J**

[illegible]

**UP81A**

**September 11, 1991**

2VBB-UPS1A LOAD LIST  
DWG. NO. AE-100D  
SHEET 91 OF 117

1

2

3

4

5

6

7

8

9

10

UPS NO: 2VBB-UPS1A  
PNL NO: 2VBS-PNLA102  
BKR NO: 20  
CIRCUIT NO: N/A

### DRAWING REFERENCES

**EE-3TF**

**EE-11J**

**LSK-22-IT**

[illegible]

**UP81A**

**September 11, 1991**

2VBB-UPS1A LOAD LIST  
DWG. NO. AE-100D  
SHEET 92 OF 117

24

25

26

27

28

29

30

31

32

33

34

35

36

37

38

39

UPS NO: 2VBB-UPS1A  
PNL NO: 2VBS-PNLA102  
BKR NO: 21  
CIRCUIT NO: N/A

### DRAWING REFERENCES

**EE-11J**

[illegible]

**UP81A**

**September 11, 1991.**

2VBB-UPS1A LOAD LIST  
DWG. NO. AE-100D  
SHEET 93 OF 117

80

10

11

12

13

14

15

16

17

18

19

20

21

22

23

24

UPS NO: 2VBB-UPS1A  
PNL NO: 2VBS-PNLA102  
BKR NO: 22  
CIRCUIT NO: N/A

### DRAWING REFERENCES

EE-3TF  
EE-11J  
LSK-22-IT

[illegible]

**UP81A**

**September 11, 1991**

2VBB-UPS1A LOAD LIST  
DWG. NO. AE-100D  
SHEET 94 OF 117

1. 2. 



UPS NO: 2VBB-UPS1A  
PNL NO: 2VBS-PNLA102  
BKR NO: 23  
CIRCUIT NO: N/A

## DRAWING REFERENCES

EE-11J  
EE-11GH

[illegible]

**UP81A**

**September 11, 1991**

2VBB-UPS1A LOAD LIST  
DWG. NO. AE-100D  
SHEET 95 OF 117



UPS NO: 2VBB-UPS1A  
PNL NO: 2VBS-PNLA102  
BKR NO: 24  
CIRCUIT NO: N/A

DRAWING REFERENCES

EE-11J

| FEED TO DEVICE | DEVICE LOCATION |      | PLANT IMPACT |
|----------------|-----------------|------|--------------|
|                | BLDG            | ELEV |              |
| SPARE          |                 |      | NONE         |
|                |                 |      |              |
|                |                 |      |              |
UPS1A

September 11, 1991

2VBB-UPS1A LOAD LIST  
DWG. NO. AE-100D  
SHEET 96 OF 117

100


















UPS NO: 2VBB-UPS1A  
PNL NO: 2VBS-PNLA102  
BKR NO: 23  
DIST PNL NO: 2VBS-PNLA107  
BKR NO: 1  
CIRCUIT NO: 2LWSNNK581

## DRAWING REFERENCES

EE-11GH  
EE-3NN

[illegible]

**UP81A**

**September 11, 1991**

2VBB-UPS1A LOAD LIST  
DWG. NO. AE-100D  
SHEET 97 OF 117



## DRAWING REFERENCES

EE-11GH  
EE-3NN

[illegible]

2VBB-UPS1A LOAD LIST  
DWG. NO. AE-100D  
SHEET 98 OF 117

September 11, 1991





### DRAWING REFERENCES

EE-11GH  
EE-3NN

[illegible]

**UP81A**

**September 11, 1991**

2VBB-UPS1A LOAD LIST  
DWG. NO. AE-100D  
SHEET 99 OF 117

50

17

५६

• 43



5

•

7

62

5

2

88-2

### DRAWING REFERENCES

EE-11GH  
EE-3NN

[illegible]

**UP81A**

**September 11, 1991**

2VBB-UPS1A LOAD LIST  
DWG. NO. AE-100D  
SHEET 100 OF 117

10

11

12

13

14

15

16

17

18

19

20

21

22

23

24

25

### DRAWING REFERENCES

EE-11GH  
EE-3NN

[illegible]

2VBB-UPS1A LOAD LIST  
DWG. NO. AE-100D  
SHEET 101 OF 117

**September 11, 1991**


### DRAWING REFERENCES

EE-11GH  
EE-3NN

[illegible]

**UP81A**

**September 11, 1991**

2VBB-UPS1A LOAD LIST  
DWG. NO. AE-100D  
SHEET 102 OF 117





### DRAWING REFERENCES

EE-11GH

[illegible]

2VBB-UPS1A LOAD LIST  
DWG. NO. AE-100D  
SHEET 103 OF 117

**September 11, 1991**



### DRAWING REFERENCES

EE-11GH

[illegible]

**UPS1A**

**September 11, 1991**

2VBB-UPS1A LOAD LIST  
DWG. NO. AE-100D  
SHEET 104 OF 117



### DRAWING REFERENCES

EE-11GH  
EE-3NN

[illegible]

**UPS1A**

**September 11, 1991**

2VBB-UPS1A LOAD LIST  
DWG. NO. AE-100D  
SHEET 105 OF 117

10

11

12

13

14

15

16

17

18

19

20

21

22

23

24

### DRAWING REFERENCES

EE-11GH

**UP81A**

2VBB-UPS1A LOAD LIST  
DWG. NO. AE-100D  
SHEET 106 OF 117

2

1

2

3

4

5

6

7

8

9

10

11

12

13

14

15

16

17

18

19

20



### DRAWING REFERENCES

EE-11GH  
EE-3NN

[illegible]

2VBB-UPS1A LOAD LIST  
DWG. NO. AE-100D  
SHEET 107 OF 117

**September 11, 1991**

1.

2.

3.

4.

5.

6.

7.

8.

9.

10.

11.

12.

13.

14.

15.

16.

17.

### DRAWING REFERENCES

EE-11GH  
EE-3NN

[illegible]

2VBB-UPS1A LOAD LIST  
DWG. NO. AE-100D  
SHEET 108 OF 117

**September 11, 1991**



### DRAWING REFERENCES

EE-11GH

[illegible]

**UP81A**

**September 11, 1991**

2VBB-UPS1A LOAD LIST  
DWG. NO. AE-100D  
SHEET 109 OF 117

100

2

1

















### DRAWING REFERENCES

**EE-11GH**

UP81A

September 11, 1991

2VBB-UPS1A LOAD LIST  
DWG. NO. AE-100D  
SHEET 110 OF 117





### DRAWING REFERENCES

**CIRCUIT NO: 2LW8NNK579**

2VBB-UPS1A LOAD LIST  
DWG. NO. AE-100D  
SHEET 111 OF 117



## DRAWING REFERENCES

EE-11GH  
EE-3NE

[illegible]

2VBB-UPS1A LOAD LIST  
DWG. NO. AE-100D  
SHEET 112 OF 117

**September 11, 1991**



### DRAWING REFERENCES

EE-11GH  
EE-3NN

[illegible]

**September 11, 1991**

2VBB-UPS1A LOAD LIST  
DWG. NO. AE-100D  
SHEET 113 OF 117

1. 2. 

## DRAWING REFERENCES

EE-11GH  
EE-3NN

[illegible]

2VBB-UPS1A LOAD LIST  
DWG. NO. AE-100D  
SHEET 114 OF 117

**September 11, 1991**

23

1  
2  
UPS NO: 2VBB-UPS1A  
PNL NO: 2VBS-PNLA102  
BKR NO: 23  
DIST PNL NO: 2VBS-PNLA107  
BKR NO: 19  
CIRCUIT NO: 2LWSNNK598

### DRAWING REFERENCES

EE-11GH  
EE-3NA

[illegible]

**UP81A**

**September 11, 1991**

2VBB-UPS1A LOAD LIST  
DWG. NO. AE-100D  
SHEET 115 OF 117


## DRAWING REFERENCES

EE-11GH  
EE-3NB

[illegible]

2VBB-UPS1A LOAD LIST  
DWG. NO. AE-100D  
SHEET 116 OF 117

**September 11, 1991**


1  
2  
### DRAWING REFERENCES

EE-11GH


[illegible]

2VBB-UPS1A LOAD LIST  
DWG. NO. AE-100D  
SHEET 117 OF 117

**September 11, 1991**



# 2VBB-UPS1B LOAD LIST

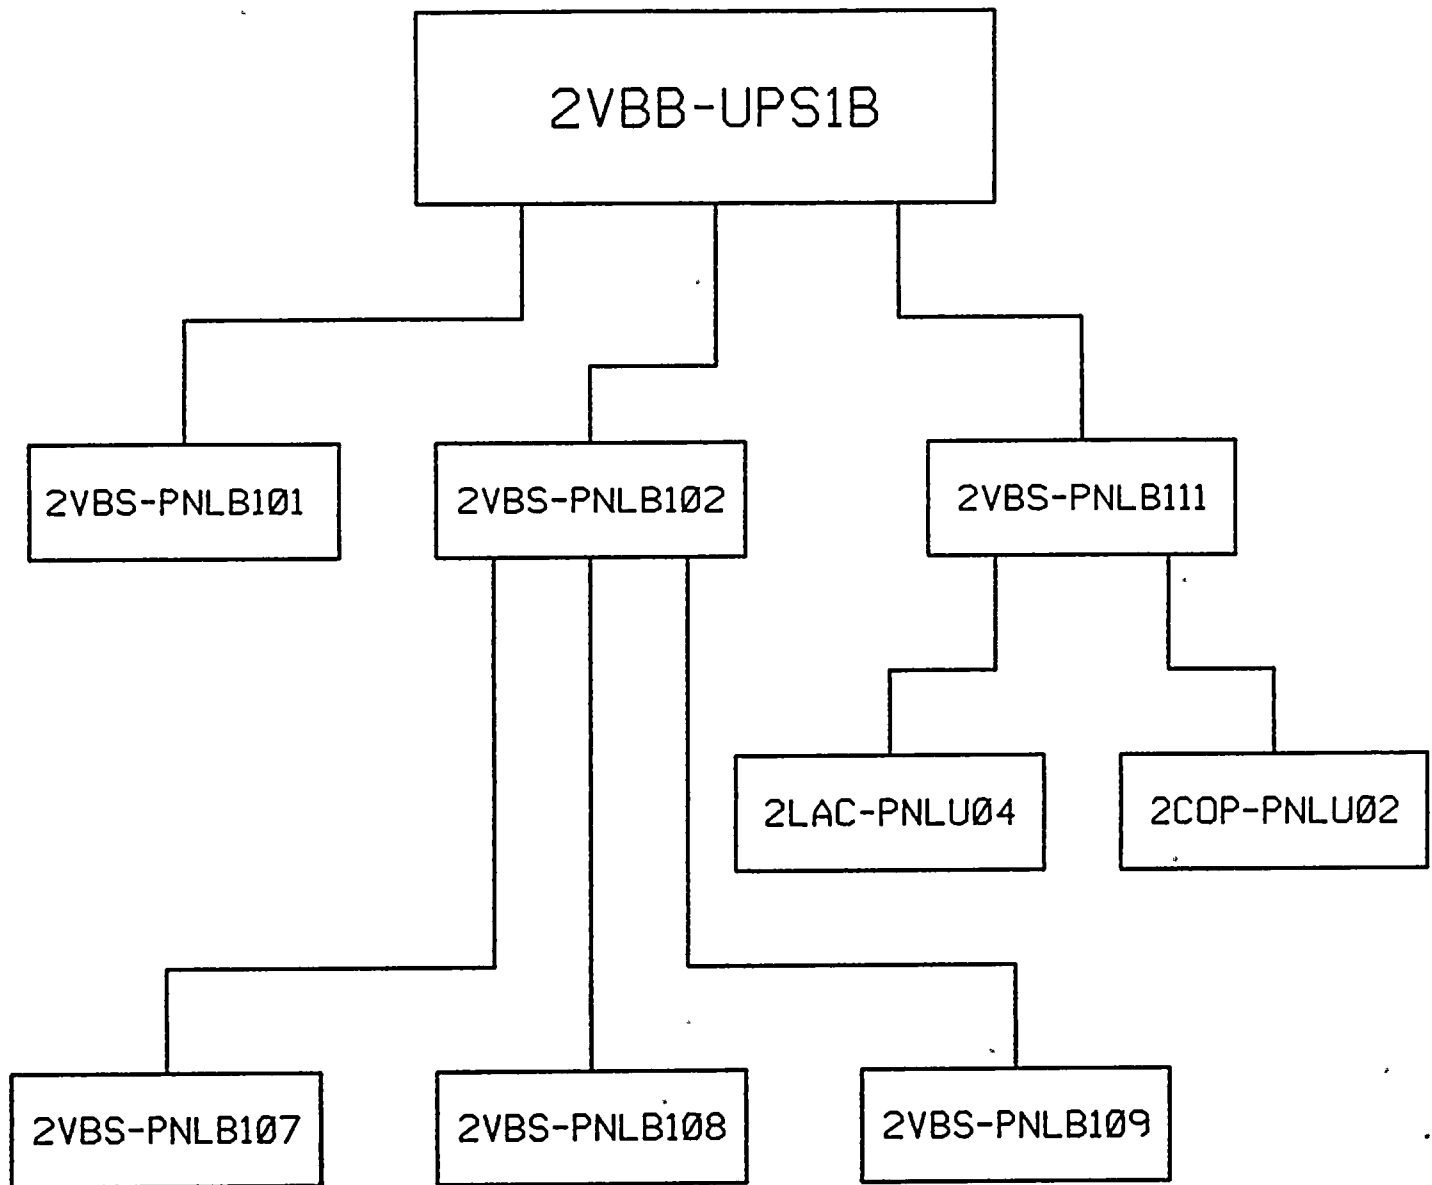

NOTE: THIS DRAWING WAS CREATED USING  
COMPUTER AIDED DRAFTING  
DO NOT MAKE MANUAL CHANGES

NUCLEAR NON-SAFETY RELATED


|                              |            |                          |  |
|------------------------------|------------|--------------------------|--|
|                              |            | NINE MILE POINT          |  |
|                              |            | NUCLEAR STATION - UNIT 2 |  |
|                              |            | SCRIBA, N.Y.             |  |
| LOAD LIST                    |            |                          |  |
| UNINTERRUPTIBLE POWER SUPPLY |            |                          |  |
| 2VBB-UPS1B                   |            |                          |  |
| SHEET 1 OF 228               |            |                          |  |
| SCALE                        | DRAWING NO |                          |  |
| NONE                         | AE-100E    |                          |  |



|     |      |     |    |                             |      |     |
|-----|------|-----|----|-----------------------------|------|-----|
| 1   | 9-91 | JPH |    | ORIGINAL ISSUE-<br>AS BUILT | 5-25 | Aug |
| CHK | DATE | BY  | MF | DESCRIPTION                 | CK   | APP |





# INDEX

| PANEL   | BKR. NO. | SHEET NO. |
|---|----------|-----------|
| 2VBS-PNLB101<br> | 1        | 5         |
|   | 2        | 6         |
|   | 3        | 7         |
|   | 4        | 8         |
|   | 5        | 9,10      |
|   | 6        | 11,12     |
|   | 7        | 13        |
|   | 8        | 14        |
|   | 9        | 15,16,17  |
|   | 10       | 18        |
|   | 11       | 19        |
|   | 12       | 20        |
|   | 13       | 21        |
|   | 14       | 22        |
|   | 15       | 23-31     |
|   | 16       | 32        |
|   | 17       | 33        |
|   | 18       | 34        |
|   | 19       | 35        |
|   | 20       | 36        |
|   | 21       | 37,38     |
|   | 22       | 39-42     |
|   | 23       | 43        |
|   | 24       | 44,45     |
|   | 25       | 46        |
|   | 26       | 47,48,49  |
|   | 27       | 50        |
|   | 28       | 51        |
|   | 29       | 52        |
|   | 30       | 53        |
|   | 31       | 54        |
|   | 32       | 55        |
|   | 33       | 56        |
|   | 34       | 57        |
|   | 35       | 58        |
|   | 36       | 59        |
|   | 37       | 60        |
|   | 38       | 61        |
| 2VBS-PNLB101  |          |           |

| PANEL   | BKR. NO. | SHEET NO. |
|---|----------|-----------|
| 2VBS-PNLB101  | 39       | 62,63     |
| 2VBS-PNLB101  | 40       | 64        |
|   |          |           |
| 2VBS-PNLB102<br> | 1        | 65        |
|   | 2        | 66        |
|   | 3        | 67,68,69  |
|   | 4        | 70        |
|   | 5        | 71        |
|   | 6        | 72        |
|   | 7        | 73,74,75  |
|   | 8        | 76        |
|   | 9        | 77        |
|   | 10       | 78        |
|   | 11       | 79        |
|   | 12       | 80        |
|   | 13       | 81        |
|   | 14       | 82        |
|   | 15       | 83        |
|   | 16       | 84        |
|   | 17       | 85        |
|   | 18       | 86        |
|   | 19       | 87        |
|   | 20       | 88        |
|   | 21       | 89        |
|   | 22       | 90        |
|   | 23       | 91        |
|   | 24       | 92        |
| 2VBS-PNLB102  |          |           |
| 2VBS-PNLB107<br> | 1        | 93        |
|   | 2        | 94        |
|   | 3        | 95        |
|   | 4        | 96        |
|   | 5        | 97        |
| 2VBS-PNLB107  |          |           |

(CONTINUED ON SHEET 3)

2VBB-UPS1B LOAD LIST  
DWG. NO. AE-100E  
SHEET 2 OF 228



# INDEX

| PANEL             | BKR. NO. | SHEET NO. |
|-------------------|----------|-----------|
| 2VBS-PNLB107<br>↓ | 6        | 98        |
|                   | 7        | 99        |
|                   | 8        | 100       |
|                   | 9        | 101       |
|                   | 10       | 102       |
|                   | 11       | 103       |
|                   | 12       | 104       |
|                   | 13       | 105       |
|                   | 14       | 106       |
|                   | 15       | 107       |
|                   | 16       | 108       |
|                   | 17       | 109       |
|                   | 18       | 110       |
|                   | 19       | 111       |
|                   | 20       | 112,113   |
|                   | 21       | 115-119   |
|                   | 22       | 121       |
|                   | 23       | 122       |
|                   | 24       | 123       |
|                   | 25       | 124       |
|                   | 26       | 125       |
|                   | 27       | 126       |
| 2VBS-PNLB107      | 28       | 127       |
| 2VBS-PNLB107      | NOTES    | 128       |

|                   |    |     |
|-------------------|----|-----|
| 2VBS-PNLB108<br>↓ | 1  | 129 |
|                   | 2  | 130 |
|                   | 3  | 131 |
|                   | 4  | 132 |
|                   | 5  | 133 |
|                   | 6  | 134 |
|                   | 7  | 135 |
|                   | 8  | 136 |
|                   | 9  | 137 |
|                   | 10 | 138 |
|                   | 11 | 139 |
|                   | 12 | 140 |
| 2VBS-PNLB108      | 13 | 141 |

| PANEL            | BKR. NO. | SHEET NO. |
|------------------|----------|-----------|
| 2VBS-PNL108<br>↓ | 14       | 142       |
|                  | 15       | 143       |
|                  | 16       | 144       |
|                  | 17       | 145       |
|                  | 18       | 146       |
|                  | 19       | 147       |
|                  | 20       | 148       |
|                  | 21       | 149       |
|                  | 22       | 150       |
|                  | 23       | 151       |
|                  | 24       | 152       |
|                  | 25       | 153       |
|                  | 26       | 154       |
|                  | 27       | 155       |
|                  | 28       | 156       |
| 2VBS-PNL108      | NOTES    | 157       |

|                  |    |     |
|------------------|----|-----|
| 2VBS-PNL109<br>↓ | 1  | 158 |
|                  | 2  | 159 |
|                  | 3  | 160 |
|                  | 4  | 161 |
|                  | 5  | 162 |
|                  | 6  | 163 |
|                  | 7  | 164 |
|                  | 8  | 165 |
|                  | 9  | 166 |
|                  | 10 | 167 |
|                  | 11 | 168 |
|                  | 12 | 169 |
|                  | 13 | 170 |
|                  | 14 | 171 |
|                  | 15 | 172 |
| 2VBS-PNL109      | 16 | 173 |

(CONTINUED ON SHEET 4)

2VBB-UPS1B LOAD LIST  
DWG. NO. AE-100E  
SHEET 3 OF 228

100

100

# INDEX

| PANEL            | BKR. NO. | SHEET NO. |
|------------------|----------|-----------|
| 2VBS-PNL109<br>↓ | 17       | 174       |
|                  | 18       | 175       |
|                  | 19       | 176       |
|                  | 20       | 177       |
|                  | 21       | 178       |
|                  | 22       | 179       |
|                  | 23       | 180       |
|                  | 24       | 181       |
|                  | 25       | 182       |
|                  | 26       | 183       |
|                  | 27       | 184       |
|                  | 28       | 185       |
|                  | NOTES    | 186       |
|                  |          |           |
| 2VBS-PNLB11<br>↓ | 1        | 187       |
|                  | 2        | 188       |
|                  | 3        | 189       |
|                  | 4        | 190       |
|                  | 5        | 191       |
|                  | 6        | 192       |
|                  | 7        | 193       |
|                  | 8        | 194       |
|                  | 9        | 195       |
|                  | 10       | 196       |
|                  | 11       | 197       |
|                  | 12       | 198       |
|                  | 13       | 199       |
|                  | 14       | 200       |
|                  | 15       | 201       |
|                  | 16       | 202       |
|                  | 17       | 203       |
|                  | 18       | 204       |
|                  | 19       | 205       |
|                  | 20       | 206       |
|                  | 21       | 207       |
|                  | 22       | 208       |
|                  | 23       | 209       |
|                  | 24       | 210       |

| PANEL            | BKR. NO. | SHEET NO. |
|------------------|----------|-----------|
| 2VBS-PNLB11<br>↓ | 25       | 211       |
|                  | 26       | 212       |
|                  | 27       | 213       |
|                  | 28       | 214       |
|                  | 29       | 215       |
|                  | 30       | 216       |
|                  | 31       | 217       |
|                  | 32       | 218       |
|                  | 33       | 219       |
|                  | 34       | 220       |
|                  | 35       | 221       |
|                  | 36       | 222       |
|                  | 37       | 223       |
|                  | 38       | 224       |
|                  | 39       | 225       |
|                  | 40       | 226       |
|                  | 41       | 227       |
|                  | 42       | 228       |
|                  |          |           |
|                  |          |           |
2VBB-UPS1B LOAD LIST  
DWG. NO. AE-100E  
SHEET 4 OF 228

100




























### DRAWING REFERENCES

**EE-011Y**

**EE-002R**

0007.370-002-006

0007.370-002-010

[illegible]

**September 10, 1991**

2VBB-UPS1B LOAD LIST  
DWG. NO. AE-100E  
SHEET 5 OF 228

1

2

3

4

5

6

7

8

9

10

11

12

13

14

15

16

17

18

19

20

21

22

23

24

25

26

27

28

29

30



BKR NO: 2  
CIRCUIT NO: N/A

**EE-11Y**  
**EE-3ET**  
**0007.520-001-555**  
**0007.520-001-544**

[illegible]

**September 10, 1991**

2VBB-UPS1B LOAD LIST  
DWG. NO. AE-100E  
SHEET 6 OF 228

1  
2  
BKR NO: 3  
CIRCUIT NO: 2TMIN10

EE-11Y  
ESK 7CEC14  
LSK 16-07  
LSK 16-09

**UP81B**

2VBB-UPS1B LOAD LIST  
DWG. NO. AE-100E  
SHEET 7 OF 228

10

11

12

13

14

15

16

17

18

19

20

21

22

### DRAWING REFERENCES

EE-11Y  
ESK-10IHA42, 43  
EE-3DN  
147D7844, SH. 2

[illegible]

**September 10, 1991**

2VBB-UPS1B LOAD LIST  
DWG. NO. AE-100E  
SHEET 8 OF 228

10-24-44

















EE-11Y, EE-3DU,  
ESK-10IHA40  
147D7838 SH. 2  
442X559 (0007.221-001-116 & 105)  
761E79ITY SH.4 (0007.223-001-019)

[illegible]

2VBB-UPS1B LOAD LIST  
DWG. NO. AE-100E  
SHEET 9 OF 228







10

11

12

13

14

15

16

17

18

19

20

21

22

23

UPS NO: 2VBB-UPS1B  
PNL NO: 2VBS-PNLB101  
DIST PNL NO:  
BKR NO: 6  
CIRCUIT NO: 2RCSB19

### DRAWING REFERENCES

EE-11Y  
EE-3DU  
147D7828  
0007.213-001-019  
0007.221-001-108

[illegible]

**UP81B**

**September 10, 1991**

2VBB-UPS1B LOAD LIST  
DWG. NO. AE-100E  
SHEET 11 OF 228

1000





























UPS NO: 2VBB-UPS1B  
 PNL NO: 2VBS-PNLB101  
 DIST PNL NO: 2CEC-PNL634  
 BKR NO: 6

PLANT IMPACT: LOSS OF POWER TO 2CEC-PNL634

761E791ITY  
 442X559-003  
 0007.221-001-108

| LOOP   | PMS INDICATION | PMS ALARM | ERF INPUT | CR ANNUNCIATION | LOCAL ANNUNCIATION | CR INDICATION | LOCAL INDICATION | VALVE POSITION | DESCRIPTION/OTHER  |
|--|----------------|-----------|-----------|-----------------|--------------------|---------------|------------------|----------------|--|
| FUSE L2 AND N2<br>0.25A SLOW BURN                          |                | X         |           | X               |                    |               |                  |                | RCS FLUX ESTIMATOR<br>(INOP)<br>TIMER & COUNTER<br>POWER SUPPLY<br>(24VDC)<br>RCS FLOW CONTROL |
| RECP. #2 FEEDS<br>POWER SUPPLIES<br>NEST<br>2,3,4,5,8,9,10 |                |           |           |                 |                    |               |                  |                | RCS FLUX ESTIMATOR<br>INSTRUMENTATION<br>RCS FLOW CONTROL<br>(INOP)                            |
| RECP. #2 FEEDS<br>POWER SUPPLIES<br>NEST<br>2,3,4,5,8,9,10 |                | X         |           | X               |                    | X             |                  | FL             | RCS FLOW CONTROL<br>LOOP B<br>INSTRUMENTATION<br>2RCS*HYV17B (INOP)                            |
| RECP. #2 FEEDS<br>POWER SUPPLIES<br>NEXT<br>2,3,4,5,8,9,10 |                | X         |           | X               |                    | X             |                  | FL             | 2RCS*HYV17B<br>POSITION & VELOCITY<br>CONTROL<br>INSTRUMENTATION<br>(INOP)                     |
| RECP. #2 FEEDS<br>POWER SUPPLIES<br>NEXT<br>2,3,4,5,8,9,10 |                |           |           |                 |                    |               |                  |                | RCS PUMP B SUCT.<br>TEMP VS. DOME<br>PRESSURE CAVITATION<br>INTERLOCK (INOP)                   |
| FUSE PLATE<br>VALIDINE AMP                                 |                |           |           |                 |                    |               |                  | FL             | 2RCS*FYV17B<br>POSITION & VELOCITY<br>AMP (INOP)   |
|  |                |           |           |                 |                    |               |                  |                |  |
|  |                |           |           |                 |                    |               |                  |                |  |
|  |                |           |           |                 |                    |               |                  |                |  |

UPS1B

September 10, 1991

2VBB-UPS1B LOAD LIST  
 DWG. NO. AE-100E  
 SHEET 12 OF 228

100 - 100

100













**DRAWING REFERENCES**  
**EE-11Y**  
**0007.213-001-019**  
**0007.213-001-027**  
**147D7828**  
**0007.213-001-025**

[illegible]

2VBB-UPS1B LOAD LIST  
DWG. NO. AE-100E  
SHEET 13 OF 228

**September 10, 1991**

1944


























### DRAWING REFERENCES

EE-11Y  
0007.213-001-019  
147D7828  
0007.213-001-022  
0007.213-001-025

[illegible]

UP81B

September 10, 1991

2VBB-UPS1B LOAD LIST  
DWG. NO. AE-100E  
SHEET 14 OF 228

1

2

3

4

5

6

7

8

9

10

11

12

13

**BKR NO: 9**  
**CIRCUIT NO: 2RCSN04**

EE-11Y  
EE-3DT  
0007.520-001-393  
0007.520-001-394  
0007.520-001-396  
0007.520-001-397  
0007.520-001-399  
0007.520-001-400  
0007.520-001-401  
0007.213-001-020  
0007.213-001-024  
0007.213-001-025  
0007.213-001-028  
0007.213-001-029  
147D7828

[illegible]

**September 10, 1991**

2VBB-UPS1B LOAD LIST  
DWG. NO. AE-100E  
SHEET 15 OF 228

100 - 2

100 - 2

UPS NO: 2VBB-UPS1B  
 PNL NO: 2VBS-PNLB101  
 DIST PNL NO: 2CEC-PNL612  
 BKR NO: 9

PLANT IMPACT: LOSS OF POWER TO 2CEC-PNL612

| LOOP                                  | PMS INDICATION | PMS ALARM | ERF INPUT | CR ANNUNCIATION | LOCAL ANNUNCIATION | CR INDICATION | LOCAL INDICATION | VALVE POSITION | DESCRIPTION/OTHER   |
|---------------------------------------|----------------|-----------|-----------|-----------------|--------------------|---------------|------------------|----------------|---|
| B35A-F103<br>B35-K600 (24VDC<br>POWR) |                |           |           |                 |                    | X             |                  |                | (B35-N005A,B,C,D<br>PRESSURE XMTR) RCS<br>PUMP A&B SEAL WATER<br>PRESSURE                             |
| (GE DRAWINGS<br>#761E791TY)           |                |           |           |                 |                    | X             |                  |                | (B35-N015A&B DIFF<br>PRESS XMTR) RCS<br>PUMP A&B  |
| (GE DRAWINGS<br>#761E791TY)           |                | X         |           | X               |                    | X             |                  |                | (B35-N040 PRESSURE<br>XMTR) RX DOME<br>PRESSURE   |
| (GE DRAWINGS<br>#761E791TY)           |                | X         |           | X               |                    |               |                  |                | RX VESSEL BOTTOM<br>DRAIN LINE TEMP "A"   |
| GE DRAWINGS<br>#761E791TY)            |                |           |           |                 |                    | X             |                  | FL             | (B35-N050A&B<br>PRESSURE XMTR)<br>DRYWELL PRESSURE<br>RCS FCV A&B MOTION<br>INHIBIT LOGIC<br>ACTUATED |
| (GE DRAWINGS<br>#761E791TY)           | X              | X         |           | X               |                    |               |                  |                | RX VESSEL BOTTOM<br>DRAIN LINE TEMP "B"   |
| (GE DRAWINGS<br>#761E791TY)           |                | X         |           | X               |                    |               |                  |                | RCS PUMP "A"<br>SUCTION TEMP VS. RX<br>DOME TEMP  |
| (GE DRAWINGS<br>#761E791TY)           | X              | X         |           | X               |                    |               |                  |                | RX DOME PRESSURE  |
| (GE DRAWINGS<br>#761E791TY)           |                |           |           |                 |                    |               |                  |                | RCS PUMP A SUCT<br>TEMP VS. DOME<br>PRESSURE RCS<br>THERMAL SHOCK<br>INTERLOCKS INOP                  |

UPS1B

September 10, 1991

2VBB-UPS1B LOAD LIST  
 DWG. NO. AE-100E  
 SHEET 16 OF 228



UPS NO: 2VBB-UPS1B  
 PNL NO: 2VBS-PNLB101  
 DIST PNL NO: 2CEC-PNL612  
 BKR NO: 9

PLANT IMPACT: LOSS OF POWER TO 2CEC-PNL612

| LOOP                     | PMS INDICATION | PMS ALARM | ERF INPUT | CR ANNUNCIATION | LOCAL ANNUNCIATION | CR INDICATION | LOCAL INDICATION | VALVE POSITION | DESCRIPTION/OTHER   |
|--------------------------|----------------|-----------|-----------|-----------------|--------------------|---------------|------------------|----------------|---|
| (GE DRAWINGS #761E791TY) |                | X         |           | X               |                    |               |                  |                | RCS PUMP "B" SUCTION TEMP VS. RX DOME TEMP                                  |
| (GE DRAWINGS #761E791TY) |                |           |           |                 |                    |               |                  |                | RCS PUMP B SUCT. TEMP VS. DOME PRESSURE RCS THERMAL SHOCK INTERLOCKS INOP   |
| (GE DRAWINGS #761E791TY) |                |           |           |                 |                    |               |                  |                | RCS PUMP A VS. PUMP B SUCT. TEMP RCS THERMAL SHOCK INTERLOCKS INOP          |
| (GE DRAWINGS #761E791TY) |                |           |           |                 |                    |               |                  |                | VESSEL BOTTOM DRAIN "A" VS. DOME PRESSURE RCS THERMAL SHOCK INTERLOCKS INOP |
| (GE DRAWINGS #761E791TY) |                |           |           |                 |                    |               |                  |                | VESSEL BOTTOM DRAIN "B" VS. DOME PRESSURE RCS THERMAL SHOCK INTERLOCKS INOP |
| B35A-F104                |                |           |           |                 |                    |               |                  |                | RCS THERMAL SHOCK INTERLOCKS (LFMG SET "A" & B TRANSFER LOGIC) INOP         |
| B35A-F1                  | X              |           |           |                 |                    |               |                  |                | RCS PUMP A & B SUCT. TEMP.  |
|                          |                |           |           |                 |                    |               |                  |                |   |
|                          |                |           |           |                 |                    |               |                  |                |   |

UPS1B

September 10, 1991

2VBB-UPS1B LOAD LIST  
 DWG. NO. AE-100E  
 SHEET 17 OF 228

10  
 11  
17



BKR NO: 10  
CIRCUIT NO: 2IHAB02

EE-11Y  
ESK-10IHA40  
D-1034-913  
EE-3BA  
14707845, SH. 2

[illegible]

**September 10, 1991**

2VBB-UPS1B LOAD LIST  
DWG. NO. AE-100E  
SHEET 18 OF 228

10

11

12

13

14

15

16

17

18

BKR NO: 11  
CIRCUIT NO: 2IHAB06

EE-11Y  
EE-3DN  
ESK-101HA42  
0007.521-001-261  
147D7844

[illegible]

**September 10, 1991**

2VBB-UPS1B LOAD LIST  
DWG. NO. AE-100E  
SHEET 19 OF 228

10

11

12

13

14

15

16

17

18

19

20

21

22

23

24

25

26

27

28

29

30

31

32

33

UPS NO: 2VBB-UPS1B  
 PNL NO: 2VBS-PNLB101  
 BKR NO: 12  
 CIRCUIT NO: 2RDSN11

DRAWING REFERENCES

EE-11Y  
 EE-3DE  
 147D7826  
 0007.520-001-353  
 0007.520-001-350  
 0007.520-001-339  
 0007.221-001-012  
 0007.221-001-017  
 0007.221-001-038

| FEED TO DEVICE                | DEVICE LOCATION |      | PLANT IMPACT  |
|-------------------------------|-----------------|------|---|
|                               | BLDG            | ELEV |   |
| 2CEC*PNL701                   | CCR             | 306  |   |
| JB102-1, J8102-2<br>C12A-W052 | CCR             | 306  |   |
| 2CEC*PNL603                   | CCR             | 306  | 1. LOSS OF ALTERNATE POWER<br>SOURCE TO FAN CONTROL CKT<br>FOR FULL CORE DISPLAY. MAIN<br>SOURCE: 2VBB-UPS1A PANEL<br>2VBS-PNLA101<br>BKR #37<br>2. LOSS OF RSCS LOGIC POWER<br>SUPPLY C12A-PS6. LOCK-UP<br>OF ALL RODS AND LOSS OF<br>MIMIC DISPLAY. |
|                               |                 |      |   |
|                               |                 |      |   |
UPS1B

September 10, 1991

2VBB-UPS1B LOAD LIST  
 DWG. NO. AE-100E  
 SHEET 20 OF 228

.

.

.

.

.

.

.

.

.

.

.

.

.

.

**BKR NO: 13**  
**CIRCUIT NO: 2RHSN06**

EE-11Y  
EE-3DE  
147D7826  
0007.520-001-314  
0007.241-001-007  
0007.520-001-298

**UP81B**

**September 10, 1991**

2VBB-UPS1B LOAD LIST  
DWG. NO. AE-100E  
SHEET 21 OF 228

100

101

102

103

104

105

106

107

108

109

110

111

112

113

114

115

116

117

118

119

120



BKR NO: 14  
CIRCUIT NO: 2M88N21

## DRAWING REFERENCES

EE-11Y  
EE-3DS  
0007.520-001-410  
0007.520-001-407  
0007.520-001-409  
147D7828

[illegible]

**UP81B**

September 10, 1991

2VBB-UPS1B LOAD LIST  
DWG. NO. AE-100E  
SHEET 22 OF 228

P  
S  
T

T

1862

18

1861

1860

BKR NO: 15  
CIRCUIT NO: 2FWSN34

EE-11Y  
EE-3DU  
0007.520-001-401  
0007.520-001-400  
0007.520-001-357  
0007.520-001-355  
0007.222-001-005  
0007.520-001-348  
0007.222-001-004  
147D7828

[illegible]

**September 10, 1991**

2VBB-UPS1B LOAD LIST  
DWG. NO. AE-100E  
SHEET 23 OF 228



UPS NO: 2VBB-UPS1B  
 PNL NO: 2VBS-PNLB101  
 DIST PNL NO: 2CEC-PNL612  
 BKR NO: 15

PLANT IMPACT: LOSS OF POWER TO 2CEC-PNL612

| LOOP                               | PMS INDICATION | PMS ALARM | ERF INPUT | CR ANNUNCIATION | LOCAL ANNUNCIATION | CR INDICATION | LOCAL INDICATION | VALVE POSITION | DESCRIPTION/OTHER  |
|------------------------------------|----------------|-----------|-----------|-----------------|--------------------|---------------|------------------|----------------|--|
| C33A-F1<br>C33-K612<br>(24VDC PWR) | X              |           |           |                 |                    | X             |                  |                | (C33-N007 PRESS<br>XMTR) TURBINE STEAM<br>FLOW (INOP)  |
| GE DRAWING<br>807E160TY            | X              |           |           |                 |                    | X             |                  |                | (C33-N008A PRESS<br>XMTR) RX PRESSURE<br>SIGNAL TO RCS DIFF<br>TEMP CAVITATION<br>INTERLOCK (INOP) |
| GE DRAWING<br>807E160TY            | X              |           |           |                 |                    | X             |                  |                | (C33-N008C PRESS<br>XMTR) RX PRESSURE<br>SIGNAL TO RCS DIFF<br>TEMP CAVITATION<br>INTERLOCK (INOP) |
| GE DRAWING<br>807E160TY            | X              |           |           |                 |                    | X             |                  |                | (C33-N003D FLOW<br>XMTR) (FEEDWATER<br>CONTROL) MAIN STEAM<br>LINE D (INOP)                        |
| GE DRAWING<br>807E160TY            | X              |           |           |                 |                    | X             |                  |                | (C33-N002A FLOW<br>XMTR) (FEEDWATER<br>CONTROL) FEEDWATER<br>LINE "A" FLOW<br>(INOP)               |
| GE DRAWING<br>807E160TY            | X              | X         |           | X               |                    | X             |                  |                | (C33-N005 PRESS<br>XMTR) RX PRESS<br>(INOP)  |
| GE DRAWING<br>807E160TY            | X              | X         |           | X               |                    | X             |                  |                | (C33-N004A LEVEL<br>XMTR) (INOP)<br>RX WATER LEVEL<br>NARROW RANGE "A"                             |

UPS1B

September 10, 1991

2VBB-UPS1B LOAD LIST  
 DWG. NO. AE-100E  
 SHEET 24 OF 228



UPS NO: 2VBB-UP81B  
 PNL NO: 2VBS-PNLB101  
 DIST PNL NO: 2CEC-PNL612  
 BKR NO: 15

PLANT IMPACT: LOSS OF POWER TO 2CEC-PNL612

| LOOP                         | PMS INDICATION | PMS ALARM | ERF INPUT | CR ANNUNCIATION | LOCAL ANNUNCIATION | CR INDICATION | LOCAL INDICATION | VALVE POSITION | DESCRIPTION/OTHER   |
|------------------------------|----------------|-----------|-----------|-----------------|--------------------|---------------|------------------|----------------|---|
| GE DRAWING<br>807E160TY      |                |           |           |                 |                    |               |                  |                | STARTUP VALVES<br>TRANSFER TO MANUAL<br>(HALF TRIP)<br>FEEDWATER PUMP/<br>TURBINE (HALF TRIP) |
| GE DRAWING<br>807E160TY      | X              | X         |           | X               |                    | X             |                  |                | FEEDWATER CONTROL 3<br>ELEMENT CONTROL<br>(INOP)  |
| GE DRAWING<br>807E160TY      |                |           |           |                 |                    | X             |                  | FL             | 2FWS-LV10A  |
| GE DRAWING<br>807E160TY      |                |           |           |                 |                    | X             |                  |                | AUTO/MANUAL<br>TRANSFER (INOP)<br>2FWS-LV10B (CONTROL<br>STATUS)                              |
| GE DRAWING<br>807E160TY      |                |           |           |                 |                    |               |                  |                | FEEDWATER CONTROL<br>SINGLE ELEMENT<br>CONTROL (INOP)   |
| GE DRAWING<br>807E160TY      |                |           |           |                 |                    | X             |                  |                | MASTER CONTROLLER<br>2FWS-LV10A, B & C<br>(INOP)  |
| GE DRAWING<br>807E160TY      |                |           |           |                 |                    |               |                  |                | FEEDWATER CONTROL<br>SETPOINT SETDOWN<br>(INOP)   |
| GE DRAWING<br>761E791TY SH 9 |                |           |           |                 |                    |               |                  |                | RX PRESSURE VS.<br>VESSEL BOTTOM DRAIN<br>"B" TEMP RCS<br>THERMAL SHOCK<br>INTERLOCKS (INOP)  |
| GE DRAWING<br>761E791TY SH 9 |                |           |           |                 |                    |               |                  |                | RX PRESSURE VS. RCS<br>PUMP B SUCT. TEMP<br>RCS THERMAL SHOCK<br>INTERLOCKS (INOP)            |

UP81B

September 10, 1991

2VBB-UP81B LOAD LIST  
 DWG. NO. AE-100E  
 SHEET 25 OF 228





UPS NO: 2VBB-UPS1B  
 PNL NO: 2VBS-PNLB101  
 DIST PNL NO: 2CEC-PNL612  
 BKR NO: 15

PLANT IMPACT: LOSS OF POWER TO 2CEC-PNL612

| LOOP                               | PMS INDICATION | PMS ALARM | ERF INPUT | CR ANNUNCIATION | LOCAL ANNUNCIATION | CR INDICATION | LOCAL INDICATION | VALVE POSITION | DESCRIPTION/OTHER   |
|------------------------------------|----------------|-----------|-----------|-----------------|--------------------|---------------|------------------|----------------|---|
| C33A-F4                            |                |           |           |                 |                    | X             |                  |                | STARTUP VALVES<br>TRANSFER TO MANUAL<br>(HALF TRIP)<br>FEEDWATER<br>PUMP/TURBINE (HALF<br>TRIP) |
| C33A-F7<br>C33-K611 (24VDC<br>PWR) | X              | X         |           | X               |                    | X             |                  |                | (C33-N003A FLOW<br>XMTR) (FEEDWATER<br>CONTROL) STEAM FLOW<br>LINE "A" (INOP)                   |
| C33A-F7<br>C33-K611 (24VDC<br>PWR) | X              | X         |           | X               |                    | X             |                  |                | (C33-N003B FLOW<br>XMTR) (FEEDWATER<br>CONTROL) STEAM FLOW<br>LINE "B" (INOP)                   |
| C33A-F7<br>C33-K611 (24VDC<br>PWR) | X              | X         |           | X               |                    | X             |                  |                | (C33-N003C FLOW<br>XMTR) (FEEDWATER<br>CONTROL) STEAM FLOW<br>LINE "C" (INOP)                   |
| C33A-F7<br>C33-K611 (24VDC<br>PWR) |                |           |           |                 |                    |               |                  | FL             | LOW PRESSURE START-<br>UP 2CNM-LV137  |
| C33A-F7<br>C33-K611 (24VDC<br>PWR) |                |           |           |                 |                    |               |                  | FL             | HIGH PRESSURE<br>START-UP 2FWS-LV55A  |
| C33A-F7<br>C33-K611 (24VDC<br>PWR) |                |           |           |                 |                    |               |                  | FL             | HIGH PRESSURE<br>START-UP 2FWS-LV55B  |
| C33A-F7<br>C33-K611 (24VDC<br>PWR) |                |           |           |                 |                    |               |                  |                | FEEDWATER CONTROL<br>SETPOINT SETDOWN<br>(INOP)   |
| C33A-F7<br>C33-K611 (24VDC<br>PWR) |                |           |           |                 |                    |               |                  |                | RCS LOW Rx WATER<br>LEVEL 3 & 4 TRIP  |

UPS1B

September 10, 1991

2VBB-UPS1B LOAD LIST  
 DWG. NO. AE-100E  
 SHEET 26 OF 228

100














UPS NO: 2VBB-UPS1B  
 PNL NO: 2VBS-PNLB101  
 DIST PNL NO: 2CEC-PNL612  
 BKR NO: 15

PLANT IMPACT: LOSS OF POWER TO 2CEC-PNL612

| LOOP                               | PMS INDICATION | PMS ALARM | ERF INPUT | CR ANNUNCIATION | LOCAL ANNUNCIATION | CR INDICATION | LOCAL INDICATION | VALVE POSITION | DESCRIPTION/OTHER   |
|------------------------------------|----------------|-----------|-----------|-----------------|--------------------|---------------|------------------|----------------|---|
| C33A-F7<br>C33-K611 (24VDC<br>PWR) |                |           |           |                 |                    |               |                  | FL             | 2FWS-LV10C  |
| C33A-F7<br>C33-K611 (24VDC<br>PWR) |                |           |           |                 |                    |               |                  | FL             | 2FWS-LV10B  |
| C33A-F7<br>C33-K611 (24VDC<br>PWR) |                |           |           |                 |                    |               |                  |                | FEEDWATER CONTROL<br>START-UP VALVE<br>(HIGH PRESSURE)<br>MASTER CONTROLLER<br>(INOP) |
| C33A-F7<br>C33-K611 (24VDC<br>PWR) |                |           |           |                 | X                  |               |                  |                | FEEDWATER CONTROL<br>TOTAL MAIN STEAM<br>FLOW (INOP)                                  |
| C33A-F7<br>C33-K611 (24VDC<br>PWR) |                |           |           |                 | X                  |               |                  |                | Rx WATER LEVEL<br>UPSET RANGE (INOP)  |
| C33A-F7<br>C33-K611 (24VDC<br>PWR) |                |           |           |                 | X                  |               |                  |                | Rx WATER LEVEL<br>NARROW RANGE<br>(INOP)  |
| C33A-F7<br>C33-K611 (24VDC<br>PWR) |                |           |           |                 | X                  |               |                  |                | FEEDWATER CONTROL<br>TOTAL FEEDWATER<br>FLOW (INOP)                                   |
| C33A-F7<br>C33-K611 (24VDC<br>PWR) |                |           |           |                 | X                  |               |                  |                | TURBINE STEAM FLOW<br>(INOP)  |
| C33A-F7<br>C33-K611 (24VDC<br>PWR) |                |           |           |                 | X                  |               |                  |                | FEEDWATER CONTROL<br>Rx PRESSURE (INOP)   |
| C33A-F7<br>C33-K611 (24VDC<br>PWR) |                |           |           |                 |                    |               |                  |                | FEEDWATER CONTROL<br>Rx WATER LEVEL 3&4<br>RCS TRIP INPUT "A"<br>& "B" (INOP)         |

UPS1B

September 10, 1991

2VBB-UPS1B LOAD LIST  
 DWG. NO. AE-100E  
 SHEET 27 OF 228



UPS NO: 2VBB-UPS1B  
 PNL NO: 2VBS-PNLB101  
 DIST PNL NO: 2CEC-PNL612  
 BKR NO: 15

PLANT IMPACT: LOSS OF POWER TO 2CEC-PNL612

| LOOP                               | PMS INDICATION | PMS ALARM | ERF INPUT | CR ANNUNCIATION | LOCAL ANNUNCIATION | CR INDICATION | LOCAL INDICATION | VALVE POSITION | DESCRIPTION/OTHER   |
|------------------------------------|----------------|-----------|-----------|-----------------|--------------------|---------------|------------------|----------------|---|
| C33A-F7<br>C33-K611 (24VDC<br>PWR) |                |           |           |                 |                    | X             |                  |                | FEEDWATER CONTROL<br>(INOP) FEEDWATER<br>FLOW SIGNAL LINE<br>"A"  |
| C33A-F8<br>C33-K612 (24VDC<br>PWR) | X              | X         |           | X               |                    |               |                  |                | RX WATER LEVEL 4&7<br>NARROW RANGE (INOP)   |
| C33A-F8<br>C33-K612 (24VDC<br>PWR) | X              | X         |           | X               |                    |               |                  |                | RX PRESSURE HIGH<br>(INOP)  |
| C33A-F8<br>C33-K612 (24VDC<br>PWR) |                |           |           |                 |                    |               |                  |                | FEEDWATER CONTROL 3<br>ELEMENT CONTROL<br>(INOP)  |
| C33A-F8<br>C33-K612 (24VDC<br>PWR) |                | X         |           | X               |                    |               |                  |                | FEEDWATER CONTROL<br>TOTAL MAIN STEAM<br>FLOW (INOP)  |
| C33A-F8<br>C33-K612 (24VDC<br>PWR) |                |           |           |                 |                    |               |                  |                | FEEDWATER CONTROL<br>LOW POWER TRIP<br>INPUT TO REACTOR<br>MANUAL CONTROL<br>(INOP)                       |
| C33A-F8<br>C33-K612 (24VDC<br>PWR) | X              |           |           |                 |                    | X             |                  |                | FEEDWATER CONTROL<br>MAIN STEAM FLOW<br>LINE "D" (INOP)   |
| C33A-F8<br>C33-K612 (24VDC<br>PWR) |                |           |           |                 |                    |               |                  |                | FEEDWATER CONTROL<br>LOW FEEDWATER FLOW<br>TRIP INPUT TO RCS<br>PUMP "A" & "B" NPSH<br>& POWER INTERLOCKS |
| C33A-F8<br>C33-K612 (24VDC<br>PWR) |                |           |           |                 |                    |               |                  |                | 2FWS-LV10C AUTO<br>CONTROL (INOP)   |

UPS1B

September 10, 1991

2VBB-UPS1B LOAD LIST  
 DWG. NO. AE-100E  
 SHEET 28 OF 228



UPS NO: 2VBB-UPS1B  
 PNL NO: 2VBS-PNLB101  
 DIST PNL NO: 2CEC-PNL612  
 BKR NO: 15

PLANT IMPACT: LOSS OF POWER TO 2CEC-PNL612

| LOOP                               | PMS INDICATION | PMS ALARM | ERF INPUT | CR ANNUNCIATION | LOCAL ANNUNCIATION | CR INDICATION | LOCAL INDICATION | VALVE POSITION | DESCRIPTION/OTHER  |
|------------------------------------|----------------|-----------|-----------|-----------------|--------------------|---------------|------------------|----------------|--|
| C33A-F8<br>C33-K612 (24VDC<br>PWR) |                |           |           |                 |                    | X             |                  |                | FEEDWATER CONTROL<br>(INOP) TOTAL<br>FEEDWATER FLOW                                  |
| C33A-F8<br>C33-K612 (24VDC<br>PWR) |                |           |           |                 |                    |               |                  | FL             | 2FWS-LV10C   |
| C33A-F8<br>CEE-K612 (24VDC<br>PWR) |                |           |           |                 |                    | X             |                  |                | A/M TRANSFER (INOP)<br>2CNM-LV137  |
| C33A-F8<br>C33-K612 (24VDC<br>PWR) |                |           |           |                 |                    | X             |                  |                | FEEDWATER CONTROL<br>HIGH PRESS/LOW FLOW<br>MASTER CONTROLLER<br>A/M TRANSFER (INOP) |
| C33A-F8<br>C33-K612 (24VDC<br>PWR) |                |           |           |                 |                    | X             |                  |                | A/M TRANSFER (INOP)<br>2FWS-LV55A  |
| C33A-F8<br>C33-K612 (24VDC<br>PWR) |                |           |           |                 |                    | X             |                  |                | A/M TRANSFER (INOP)<br>2FWS-LV55B  |
| C33A-F9                            |                |           |           |                 |                    | X             |                  |                | FEEDWATER PUMP<br>CAVITATION INTLK<br>LV10 LIMITER LOGIC<br>(INOP)                   |
| C33A-F10                           |                |           |           |                 |                    | X             |                  |                | FEEDWATER CONTROL<br>SETPOINT SETDOWN<br>LOGIC (INOP)                                |
| C33A-F11                           |                |           |           |                 |                    |               |                  |                | LOW FEEDWATER FLOW<br>RCS RUNBACK A&B<br>LOGIC ACTUATED                              |
| C33A-F13                           |                |           |           |                 |                    |               |                  |                | 2FWS-LV55A, 2FWS-<br>LV55B, 2CNM-LV137<br>TRANSFER TO MANUAL                         |

UPS1B

September 10, 1991

2VBB-UPS1B LOAD LIST  
 DWG. NO. AE-100E  
 SHEET 29 OF 228





**PLANT IMPACT: LOSS OF POWER TO 2CEC-PNL612**

| 1<br>NL612         | DESCRIPTION |
|--------------------|-------------|
| PMS INDICATION     |             |
| PMS ALARM          |             |
| ERF INPUT          |             |
| CR ANNUNCIATION    |             |
| LOCAL ANNUNCIATION |             |
| CR INDICATION      |             |
| LOCAL INDICATION   |             |
| VALVE POSITION     |             |

[illegible]

2VBB-UPS1B LOAD LIST  
DWG. NO. AE-100E  
SHEET 30 OF 228

1. 1. 1.

2. 2. 2.

3. 3. 3.

4. 4. 4.

5. 5. 5.

6. 6. 6.

7. 7. 7.

8. 8. 8.

9. 9. 9.

10. 10. 10.

11. 11. 11.

12. 12. 12.

UPS NO: 2VBB-UPS1B  
 PNL NO: 2VBS-PNLB101  
 DIST PNL NO: 2CEC\*PNL603  
 BKR NO: 15

PLANT IMPACT: LOSS OF POWER TO 2CEC\*PNL603

| LOOP     | PMS INDICATION | PMS ALARM | ERF INPUT | CR ANNUNCIATION | LOCAL ANNUNCIATION | CR INDICATION | LOCAL INDICATION | VALVE POSITION | DESCRIPTION/OTHER   |
|----------|----------------|-----------|-----------|-----------------|--------------------|---------------|------------------|----------------|---|
| C33A-F2A |                |           |           |                 |                    | X             |                  |                | 2FWS-LV10A (STATUS)   |
| C33A-F2B |                |           |           |                 |                    | X             |                  |                | 2FWS-LV10B (STATUS)   |
| C33A-F2C |                |           |           |                 |                    | X             |                  |                | 2FWS-LV10C (STATUS)   |
| C33A-F3A | X              |           |           | X               |                    |               |                  |                | 2FWS-LV10A CONTROL<br>SIGNAL FAILURE AND<br>ACTUATOR<br>TROUBLE/RESET<br>(INOP) |
| C33A-F3B | X              |           |           | X               |                    |               |                  |                | 2FWS-LV10B CONTROL<br>SIGNAL FAILURE AND<br>ACTUATOR<br>TROUBLE/RESET<br>(INOP) |
| C33A-F3C | X              |           |           | X               |                    |               |                  |                | 2FWS-LV10C CONTROL<br>SIGNAL FAILURE AND<br>ACTUATOR<br>TROUBLE/RESET<br>(INOP) |
|          |                |           |           |                 |                    |               |                  |                |   |
|          |                |           |           |                 |                    |               |                  |                |   |
4 4  






**BKR NO: 16**  
**CIRCUIT NO: 2CECB26**

EE-11Y  
EE-EAG  
EE-3B  
0007.159-451-317  
0007.159-451-319  
147D7836

UP81B

September 10, 1991

2VBB-UPS1B LOAD LIST  
DWG. NO. AE-100E  
SHEET 32 OF 228

100

101

102

103

104

105

106

107

108

109

110

111

112

**BKR NO: 17**  
**CIRCUIT NO: 2WCSN25**

**147D7830**  
**EE-11Y**  
**EE-3CV**  
**0007.520-001-446**  
**0007.520-001-462**  
**0007.224-001-003**  
**0007.224-001-006**

UP81B

September 10, 1991

2VBB-UPS1B LOAD LIST  
DWG. NO. AE-100E  
SHEET 33 OF 228

10  
11  
BKR NO: 18  
CIRCUIT NO: 2CECB88

147D7836  
EE-11Y  
EE-AG  
EE-3N  
0007.159-451-407  
0007.159-451-408

[illegible]

September 10, 1991

2VBB-UPS1B LOAD LIST  
DWG. NO. AE-100E  
SHEET 34 OF 228



UPS NO: 2VBB-UPS1B  
PNL NO: 2VBS-PNLB101

DRAWING REFERENCES  
EE-11Y

BKR NO: 19  
CIRCUIT NO: N/A

| FEED TO DEVICE | <u>DEVICE LOCATION</u> |      | PLANT IMPACT |
|----------------|------------------------|------|--------------|
|                | BLDG                   | ELEV |              |
| SPARE          |                        |      |              |
|                |                        |      |              |
|                |                        |      |              |
UPS1B

September 10, 1991

2VBB-UPS1B LOAD LIST  
DWG. NO. AE-100E  
SHEET 35 OF 228

1  
2  
UPS NO: 2VBB-UPS1B  
PNL NO: 2VBS-PNLB101

DRAWING REFERENCES  
EE-11Y

BKR NO: 20  
CIRCUIT NO: N/A

| FEED TO DEVICE | DEVICE LOCATION |      | PLANT IMPACT |
|----------------|-----------------|------|--------------|
|                | BLDG            | ELEV |              |
| SPARE          |                 |      |              |
|                |                 |      |              |
|                |                 |      |              |
UPS1B

September 10, 1991

2VBB-UPS1B LOAD LIST  
DWG. NO. AE-100E  
SHEET 36 OF 228



UPS NO: 2VBB-UPS1B  
 PNL NO: 2VBS-PNLB101  
 BKR NO: 21  
 CIRCUIT NO: 2CECNO6, 2CECN04, 2CECNO2

DRAWING REFERENCES

EE-11Y  
 ESK-7CEC01  
 LSK-32-09D  
 LSK-23-06C  
 LSK-09-01D  
 LSK-21-02B  
 ESK-7CEC14, SH. 1  
 LSK-33-02A  
 LSK-22-22  
 EE-3BE  
 147D7846, SH. 2

| FEED TO DEVICE                          | DEVICE LOCATION |      | PLANT IMPACT   |
|---|-----------------|------|--|
|   | BLDG            | ELEV |  |
| 2CEC*PNL741<br>JB103                    | CCR             | 306  |  |
| 2CEC-W056<br>2CEC*PNL873<br>PWS2-CECN06 | CCR             | 306  | POWER SUPPLY FOR CHART DRIVES & RECORDERS  |
| 2CEC*PNL873<br>2DER-FR101               | CCR             | 306  | LOSS OF DW EQUIP. DRAINS LEAK RATE RECORDER INDICATION   |
| 2CEC*PNL873<br>2DER-LR101/FR123         | CCR             | 306  | LOSS OF DW EQUIP DRN TANK 2DER-TK1 LEVEL RECORDER. LOSS OF DW EQUIP DRN PMP 3A/B FLOW RECORDER.    |
| 2CEC*PNL873<br>2DFR-FR106               | CCR             | 306  | LOSS OF DW FLR DRN LEAK RATE RECORDER.   |
| 2CEC*PNL873<br>2DFR-LR106/FR137         | CCR             | 306  | LOSS OF DW FLR DRN TANK 2DER-TK1 LVL RECORDER. LOSS OF DW FLR DRN P1A/B PUMP FLOW RATE RECORDER.   |
| 2CEC*PNL873<br>2CCP-FR266               | CCR             | 306  | LOSS OF RBCLCW FLOW TO DW UNIT COOLERS RECORDER.   |
| 2CEC*PNL603<br>2SSR-CR124/AR125         | CCR             | 306  | LOSS OF CRD PUMP DISCH SAMPLE CONDUCTIVITY RECORDER/LOSS OF CRD PUMP DISCH SAMPLE 02 CONC RECORDER |
| 2CEC*PNL873<br>2CEC-LU101               | CCR             | 306  | LOSS OF DW FLR & EQP DRN LEAK RATE PROG CONTROLLER   |

UPS1B

September 10, 1991

2VBB-UPS1B LOAD LIST  
 DWG. NO. AE-100E  
 SHEET 37 OF 228





UPS NO: 2VBB-UPS1B  
PNL NO: 2VBS-PNLB101  
BKR NO: 21  
CIRCUIT NO: 2CECNO6, 2CECN04, 2CECNO2

## DRAWING REFERENCES

EE-11Y  
ESK-7CEC01  
LSK-32-09D  
LSK-23-06C  
LSK-09-01D  
LSK-21-02B  
ESK-7CEC14, SH. 1  
LSK-33-02A  
LSK-22-22  
EE-3BE  
147D7846, SH. 2

[illegible]

**UP81B**

**September 10, 1991**

2VBB-UPS1B LOAD LIST  
DWG. NO. AE-100E  
SHEET 38 OF 228

4 3 10

1000











### DRAWING REFERENCES

|            |           |                  |
|------------|-----------|------------------|
| ESK-78ST01 | PID-17A   | EE-11Y           |
| ESK-78ST02 | PID-17C   | EE-3HE           |
| ESK-78ST03 | PID-17E   | 0007.511-989-029 |
| ESK-78ST10 | PID-17F   | 0007.511-989-030 |
| LSK-21-1D  | LSK-21-1G |                  |

[illegible]

2VBB-UPS1B LOAD LIST  
DWG. NO. AE-100E  
SHEET 39 OF 228

**September 10, 1991**



UPS NO: 2VBB-UPS1B  
 PNL NO: 2VBS-PNLB101  
 BKR NO: 22

PLANT IMPACT: LOSS OF POWER TO 2SST-IPNL154

| LOOP                      | PMS INDICATION | PMS ALARM | ERF INPUT | CR ANNUNCIATION | LOCAL ANNUNCIATION | CR INDICATION | LOCAL INDICATION | VALVE POSITION | DESCRIPTION/OTHER  |
|---------------------------|----------------|-----------|-----------|-----------------|--------------------|---------------|------------------|----------------|--|
| 2SST-122<br>LSK-21-1D     |                | X         |           | X               | X                  |               |                  | FC             | LOW PRESSURE FDW<br>HTR SAMPLE<br>TEMP/LOSS OF<br>CONTROL OF AOV151                      |
| 2SST-126<br>LSK-21-1D     |                | X         |           | X               | X                  |               |                  | FC             | 6TH PT FDW HTR<br>DISCHARGE SAMPLE<br>TEMP/LOSS OF<br>CONTROL OF AOV152                  |
| 2SST-118<br>LSK-21-1D     |                | X         |           | X               | X                  |               |                  | FC             | 4TH PT FDW HTR<br>SAMPLE TEMP/LOSS OF<br>CONTROL OF<br>AOV23A/B/C                        |
| 2SST-156<br>LSK-21-1D     |                | X         |           | X               | X                  |               |                  | FC             | AUX BOILER STM HDR<br>SAMPLE TEMP/LOSS OF<br>CONTROL OF AOV177                           |
| 2SST-52A/B/C<br>LSK-21-1D |                | X         |           | X               | X                  |               |                  | FC             | HTR DRAIN PUMP<br>P1A/B/C DISCH<br>SAMPLE TEMP/LOSS OF<br>CONTROL OF<br>AOV44A/B/C       |
| 2SST-136<br>LSK-21-1D     |                | X         |           | X               | X                  |               |                  | FC             | MAIN STEAM SAMPLE<br>TEMP/LOSS OF<br>CONTROL OF AOV173                                   |
| 2SST-153<br>LSK-21-1D     |                | X         |           | X               | X                  |               |                  | FC             | CLEAN STEAM<br>REBOILER 2TME-E1A<br>BLOWDOWN SAMPLE<br>TEMP/LOSS OF<br>CONTROL OF AOV174 |
| 2SST-165<br>LSK-21-1D     |                | X         |           | X               | X                  |               |                  | FC             | CLEAN STEAM<br>REBOILER 2TME-E1B<br>BLOWDOWN SAMPLE<br>TEMP/LOSS OF<br>CONTROL OF AOV175 |

UPS1B

September 10, 1991

2VBB-UPS1B LOAD LIST  
 DWG. NO. AE-100E  
 SHEET 40 OF 228



UPS NO: 2VBB-UPS1B  
 PNL NO: 2VBS-PNLB101  
 BKR NO: 22

PLANT IMPACT: LOSS OF POWER TO 2SST-IPNL154

| LOOP                  | PMS INDICATION | PMS ALARM | ERF INPUT | CR ANNUNCIATION | LOCAL ANNUNCIATION | CR INDICATION | LOCAL INDICATION | VALVE POSITION | DESCRIPTION/OTHER   |
|-----------------------|----------------|-----------|-----------|-----------------|--------------------|---------------|------------------|----------------|---|
| 2SST-283<br>LSK-21-1D |                | X         |           | X               | X                  |               |                  |                | AUX BOILER<br>FEEDPUMP DISCH HDR<br>SAMPLE TEMP/LOSS<br>OF CONTROL OF<br>AOV176 |
| 2SST-291<br>LSK-21-1G |                | X         |           | X               | X                  |               |                  | FC             | 5TH PT HTR DRAIN<br>DISCH SAMPLE<br>TEMP/LOSS OF<br>CONTROL OF<br>AOV61A/B/C    |
| 2SST-295<br>LSK-21-1G |                | X         |           | X               | X                  |               |                  | FC             | 6TH PT HTR DRAIN<br>DISCH SAMPLE<br>TEMP/LOSS OF<br>CONTROL OF<br>AOV62A/B/C    |
| 2SST-299<br>LSK-21-1G |                | X         |           | X               | X                  |               |                  | FC             | MOISTURE SEP DRAIN<br>RCVR SAMPLE<br>TEMP/LOSS OF<br>CONTROL OF<br>AOV63A/B     |
| 2SST-303<br>LSK-21-1G |                | X         |           | X               | X                  |               |                  | FC             | MOISTURE SEP DRAIN<br>RCVR SAMPLE<br>TEMP/LOSS OF<br>CONTROL OF<br>AOV64A/B     |
| 2SST-L<br>PID-17A     |                |           |           |                 |                    |               | X                |                | COND DMNRLZR INLET<br>SMPLG TEMP<br>IND/LOSS OF TI104                           |
| 2SST-L<br>PID-17A     |                |           |           |                 |                    |               | X                |                | COND DMNRLZR<br>OUTLET SMPLG TEMP<br>IND/LOSS OF TI110                          |
| 2SST-L<br>PID-17A     |                |           |           |                 |                    |               | X                |                | COM 6TH PT HTR<br>SMPLG TEMP<br>IND/LOSS OF TI127                               |

UPS1B

September 10, 1991

2VBB-UPS1B LOAD LIST  
 DWG. NO. AE-100E  
 SHEET 41 OF 228





**PLANT IMPACT: LOSS OF POWER TO 28ST-IPNL154**

PNL NO: 2VBS-PNLB101

**BKR NO: 22**

**UP81B**

## 2VBB-UP81B LOAD LIST

DWG. NO. AE-100E

**SHEET 42 OF 228**

•

•

•

•

•

•

•

### DRAWING REFERENCES

**EE-11Y**

**ESK-108XS01**

**ESK-108XS14**

BKR NO: 23  
CIRCUIT NO: 28X8N10

[illegible]

**UP81B**

**September 10, 1991**

2VBB-UPS1B LOAD LIST  
DWG. NO. AE-100E  
SHEET 43 OF 228

9

10  
11  
12

13

14

15

16

17

18

19

20

21

22

23

24

25

26

27

28

29

30

31

32

33

34

35

36

37

38

39

40

UPS NO: 2VBB-UPS1B  
PNL NO: 2VBS-PNLB101

BKR NO: 24  
CIRCUIT NO: 288TN84

DRAWING REFERENCES

PID-17D  
EE-11Y  
EE-3HE  
0007.510-989-031  
ESK-0788T03

| FEED TO DEVICE               | DEVICE LOCATION |      | PLANT IMPACT  |
|------------------------------|-----------------|------|---|
|                              | BLDG            | ELEV |   |
| 2SST-IPNL284<br>(TB-8, TB-9) | TB              | 250  | LOSS OF TURBINE PLANT SAMPLE<br>PANEL 2SST-IPNL284<br>INSTRUMENTATION, ANNUNCIATION<br>AND POWER. SEE ATTACHMENT. |
|                              |                 |      |   |
|                              |                 |      |   |
UPS1B

September 10, 1991

2VBB-UPS1B LOAD LIST  
DWG. NO. AE-100E  
SHEET 44 OF 228



UPS NO: 2VBB-UPS1B  
PNL NO: 2VBS-PNLB101

PLANT IMPACT: LOSS OF POWER TO 2SST-IPNL284

BKR NO: 24

| LOOP                | PMS INDICATION | PMS ALARM | ERF INPUT | CR ANNUNCIATION | LOCAL ANNUNCIATION | CR INDICATION | LOCAL INDICATION | VALVE POSITION | DESCRIPTION/OTHER  |
|---------------------|----------------|-----------|-----------|-----------------|--------------------|---------------|------------------|----------------|--|
| 2SST-C<br>PID-17D   |                |           |           |                 |                    | X             |                  |                | COND DMNRLZR 1A<br>OUTLET SMPLG TEMP<br>IND/LOSS OF TI10A                    |
| 2SST-C<br>PID-17D   |                |           |           |                 |                    | X             |                  |                | COND DMNRLZR 1B<br>OUTLET SMPLG TEMP<br>IND/LOSS OF TI10B                    |
| 2SST-C<br>PID-17D   |                |           |           |                 |                    | X             |                  |                | COND DMNRLZR 1C<br>OUTLET SMPLG TEMP<br>IND/LOSS OF TI10C                    |
| 2SST-C<br>PID-17D   |                |           |           |                 |                    | X             |                  |                | COND DMNRLZR 1D<br>OUTLET SMPLG TEMP<br>IND/LOSS OF TI10D                    |
| 2SST-C<br>PID-17D   |                |           |           |                 |                    | X             |                  |                | COND DMNRLZR 1E<br>OUTLET SMPLG TEMP<br>IND/LOSS OF TI10E                    |
| 2SST-C<br>PID-17D   |                |           |           |                 |                    | X             |                  |                | COND DMNRLZR 1F<br>OUTLET SMPLG TEMP<br>IND/LOSS OF TI10F                    |
| 2SST-C<br>PID-17D   |                |           |           |                 |                    | X             |                  |                | COND DMNRLZR 1G<br>OUTLET SMPLG TEMP<br>IND/LOSS OF TI10G                    |
| 2SST-C<br>PID-17D   |                |           |           |                 |                    | X             |                  |                | COND DMNRLZR 1H<br>OUTLET SMPLG TEMP<br>IND/LOSS OF TI10H                    |
| 2SST-C<br>PID-17D   |                |           |           |                 |                    | X             |                  |                | COND DMNRLZR 1J<br>OUTLET SMPLG TEMP<br>IND/LOSS OF TI10J                    |
| 2SST-286<br>PID-17D |                | X         |           | X               | X                  |               | X                | FC             | TURB GEN GLND SEAL<br>& EXHST STM SMPLG<br>TEMP/LOSS OF<br>CONTROL OF AOV287 |

UPS1B

September 10, 1991

2VBB-UPS1B LOAD LIST  
DWG. NO. AE-100E  
SHEET 45 OF 228









UPS NO: 2VBB-UPS1B  
PNL NO: 2VBS-PNLB101

DRAWING REFERENCES

EE-11Y  
ESK-108XS18

BKR NO: 25  
CIRCUIT NO: 28XSN11

| FEED TO DEVICE | DEVICE LOCATION |      | PLANT IMPACT   |
|----------------|-----------------|------|----------------|
|                | BLDG            | ELEV |                |
| GETARS         | CCR             | 306  | LOSS OF GETARS |
|                |                 |      |                |
|                |                 |      |                |
UPS1B

September 10, 1991

2VBB-UPS1B LOAD LIST  
DWG. NO. AE-100E  
SHEET 46 OF 228





































**BKR NO: 26**  
**CIRCUIT NO: 288TN85**

|                  |         |
|------------------|---------|
| EE-11Y           | PID-17A |
| EE-3HF           | PID-17C |
| 0007.510-989-105 | PID-17D |
| 0007.510-989-105 | PID-17E |
| 0007.510-989-108 | PID-17F |
| 0007.510-989-109 |         |
| 0007.510-989-106 |         |

[illegible]

**September 10, 1991**

2VBB-UPS1B LOAD LIST  
DWG. NO. AE-100E  
SHEET 47 OF 228

.

2

.

2

2

2

.

2

UPS NO: 2VBB-UPS1B  
PNL NO: 2VBS-PNLB101

PLANT IMPACT: LOSS OF POWER TO 2SST-IPNL285

BKR NO: 26

| LOOP                  | PMS INDICATION | PMS ALARM | ERF INPUT | CR ANNUNCIATION | LOCAL ANNUNCIATION | CR INDICATION | LOCAL INDICATION | VALVE POSITION | DESCRIPTION/OTHER  |
|-----------------------|----------------|-----------|-----------|-----------------|--------------------|---------------|------------------|----------------|--|
| 2SST-113<br>LSK-21-1B |                | X         |           | X               | X                  | X             | X                |                | CNDS DMNRLZR OUTLET<br>SAMPLE OXYGEN<br>IND/LOSS OF AIT113             |
| 2SST-132<br>LSK-21-1C |                | X         |           | X               | X                  | X             | X                |                | COM 6TH PT HTR<br>OUTLET SAMPLE<br>OXYGEN IND/LOSS OF<br>AIT132        |
| 2SST-133<br>LSK-21-1C |                | X         |           | X               | X                  | X             | X                |                | COM 6TH PT HTR<br>OUTLET SAMPLE PH<br>IND/LOSS OF AIT133               |
| 2SST-131<br>LSK-21-1B |                | X         |           | X               | X                  | X             | X                |                | COM 6TH PT HTR<br>OUTLET SAMPLE CNDT<br>IND/LOSS OF CIT131             |
| 2SST-114<br>LSK-21-1B |                | X         |           | X               | X                  | X             | X                |                | CNDS DMNRLZR OUTLET<br>SAMPLE CNDT<br>IND/LOSS OF CIT114               |
| 2SST-106<br>LSK-21-1A |                | X         |           | X               | X                  | X             | X                |                | CNDS DMNRLZR INLET<br>SAMPLE CNDT<br>IND/LOSS OF CIT106                |
| 2SST-53<br>LSK-21-1D  |                | X         |           | X               | X                  |               | X                |                | LP FDW HTR DRN PUMP<br>1A/1B/1C SMPL CNDT<br>IND/LOSS OF<br>CIT53A/B/C |
| 2SST-22<br>LSK-21-1A  |                | X         |           | X               | X                  |               | X                |                | MN COND A/B/C SHELL<br>EAST HLF CNDT<br>IND/LOSS OF<br>CIT22A/B/C      |
| 2SST-21<br>LSK-21-1A  |                | X         |           | X               | X                  |               | X                |                | MN COND A/B/C SHELL<br>WEST HLF CNDT<br>IND/LOSS OF<br>CIT21A/B/C      |

UPS1B

September 10, 1991

2VBB-UPS1B LOAD LIST  
DWG. NO. AE-100E  
SHEET 48 OF 228



UPS NO: 2VBB-UPS1B  
PNL NO: 2VBS-PNLB101

PLANT IMPACT: LOSS OF POWER TO 2SST-IPNL285

BKR NO: 26

| LOOP                  | PMS INDICATION | PMS ALARM | ERF INPUT | CR ANNUNCIATION | LOCAL ANNUNCIATION | CR INDICATION | LOCAL INDICATION | VALVE POSITION | DESCRIPTION/OTHER   |
|-----------------------|----------------|-----------|-----------|-----------------|--------------------|---------------|------------------|----------------|---|
| 2SST-58<br>LSK-21-1E  |                | X         |           | X               | X                  |               | X                |                | CNDS DMNRLZR 1A<br>THRU 1J EFFLUENT<br>CNDT IND/LOSS OF<br>CIT58A THRU 58J  |
| 2SST-50<br>LSK-21-1D  |                | X         |           | X               | X                  | X             | X                |                | LP FDW HTR DRN PUMP<br>1A/1B/1C SMPL<br>TURBIDITY IND/LOSS<br>OF AIT50A/B/C |
| 2SST-142<br>LSK-21-1C |                | X         |           | X               | X                  | X             | X                |                | CNDS DMNRLZR INLET<br>SAMPLE TURBIDITY<br>IND/LOSS OF AIT142                |
|                       |                |           |           |                 |                    |               |                  |                |   |
UPS1B

September 10, 1991

2VBB-UPS1B LOAD LIST  
DWG. NO. AE-100E  
SHEET 49 OF 228













UPS NO: 2VBB-UPS1B  
PNL NO: 2VBS-PNLB101

DRAWING REFERENCES

EE-11Y  
ESK-10SX816

BKR NO: 27  
CIRCUIT NO: 28X8N08

| FEED TO DEVICE | DEVICE LOCATION |      | PLANT IMPACT   |
|----------------|-----------------|------|----------------|
|                | BLDG            | ELEV |                |
| GETARS         | CCR             | 306  | LOSS OF GETARS |
|                |                 |      |                |
|                |                 |      |                |
UPS1B

September 10, 1991

2VBB-UPS1B LOAD LIST  
DWG. NO. AE-100E  
SHEET 50 OF 228










































UPS NO: 2VBB-UPS1B  
PNL NO: 2VBS-PNLB101

DRAWING REFERENCES

EE-11Y  
ESK-108XS15

BKR NO: 28  
CIRCUIT NO: 2SXSNO7

| FEED TO DEVICE | DEVICE LOCATION |      | PLANT IMPACT   |
|----------------|-----------------|------|----------------|
|                | BLDG            | ELEV |                |
| GETARS         | CCR             | 306  | LOSS OF GETARS |
|                |                 |      |                |
|                |                 |      |                |
UPS1B

September 10, 1991

2VBB-UPS1B LOAD LIST  
DWG. NO. AE-100E  
SHEET 51 OF 228










UPS NO: 2VBB-UPS1B  
PNL NO: 2VBS-PNLB101  
BKR NO: 29  
CIRCUIT NO: N/A

DRAWING REFERENCES  
EE-11Y

| FEED TO DEVICE | <u>DEVICE LOCATION</u> |      | PLANT IMPACT |
|----------------|------------------------|------|--------------|
|                | BLDG                   | ELEV |              |
| SPARE          |                        |      |              |
|                |                        |      |              |
|                |                        |      |              |
UPS1B  
September 10, 1991

2VBB-UPS1B LOAD LIST  
DWG. NO. AE-100E  
SHEET 52 OF 228






UPS NO: 2VBB-UPS1B  
PNL NO: 2VBS-PNLB101  
BKR NO: 30  
CIRCUIT NO: N/A

DRAWING REFERENCES  
EE-11Y

| FEED TO DEVICE | <u>DEVICE LOCATION</u> |      | PLANT IMPACT |
|----------------|------------------------|------|--------------|
|                | BLDG                   | ELEV |              |
| SPARE          |                        |      |              |
|                |                        |      |              |
|                |                        |      |              |
UPS NO: 2VBB-UPS1B  
PNL NO: 2VBS-PNLB101  
BKR NO: 31  
CIRCUIT NO: N/A

DRAWING REFERENCES  
EE-11Y

| FEED TO DEVICE | <u>DEVICE LOCATION</u> |      | PLANT IMPACT |
|----------------|------------------------|------|--------------|
|                | BLDG                   | ELEV |              |
| SPARE          |                        |      |              |
|                |                        |      |              |
|                |                        |      |              |
UPS1B

September 10, 1991

2VBB-UPS1B LOAD LIST  
DWG. NO. AE-100E  
SHEET 54 OF 228

4  
25  
28  
30  
31  
32  
33

1944

UPS NO: 2VBB-UPS1B  
PNL NO: 2VBS-PNLB101  
BKR NO: 32  
CIRCUIT NO: N/A

DRAWING REFERENCES  
EE-11Y

| FEED TO DEVICE | DEVICE LOCATION |      | PLANT IMPACT |
|----------------|-----------------|------|--------------|
|                | BLDG            | ELEV |              |
| SPARE          |                 |      |              |
|                |                 |      |              |
|                |                 |      |              |
UPS1B

September 10, 1991

2VBB-UPS1B LOAD LIST  
DWG. NO. AE-100E  
SHEET 55 OF 228







UPS NO: 2VBB-UPS1B  
PNL NO: 2VBS-PNLB101  
BKR NO: 33  
CIRCUIT NO: N/A

DRAWING REFERENCES  
EE-11Y

| FEED TO DEVICE | <u>DEVICE LOCATION</u> |      | PLANT IMPACT |
|----------------|------------------------|------|--------------|
|                | BLDG                   | ELEV |              |
| SPARE          |                        |      |              |
|                |                        |      |              |
|                |                        |      |              |
UPS1B  
September 10, 1991

2VBB-UPS1B LOAD LIST  
DWG. NO. AE-100E  
SHEET 56 OF 228









UPS NO: 2VBB-UPS1B  
PNL NO: 2VBS-PNLB101  
BKR NO: 34  
CIRCUIT NO: N/A

DRAWING REFERENCES  
EE-11Y

| FEED TO DEVICE | <u>DEVICE LOCATION</u> |      | PLANT IMPACT |
|----------------|------------------------|------|--------------|
|                | BLDG                   | ELEV |              |
| SPARE          |                        |      |              |
|                |                        |      |              |
|                |                        |      |              |
UPS1B

September 10, 1991

2VBB-UPS1B LOAD LIST  
DWG. NO. AE-100E  
SHEET 57 OF 228


































UPS NO: 2VBB-UPS1B  
 PNL NO: 2VBS-PNLB101  
 BKR NO: 35  
 CIRCUIT NO: N/A

DRAWING REFERENCES  
 EE-11Y

| FEED TO DEVICE | <u>DEVICE LOCATION</u> |      | PLANT IMPACT |
|----------------|------------------------|------|--------------|
|                | BLDG                   | ELEV |              |
| SPARE          |                        |      |              |
|                |                        |      |              |
|                |                        |      |              |


UPS NO: 2VBB-UPS1B  
PNL NO: 2VBS-PNLB101  
BKR NO: 36  
CIRCUIT NO: N/A

DRAWING REFERENCES  
EE-11Y

| FEED TO DEVICE | <u>DEVICE LOCATION</u> |      | PLANT IMPACT |
|----------------|------------------------|------|--------------|
|                | BLDG                   | ELEV |              |
| SPARE          |                        |      |              |
|                |                        |      |              |
|                |                        |      |              |
UPS1B

September 10, 1991

2VBB-UPS1B LOAD LIST  
DWG. NO. AE-100E  
SHEET 59 OF 228

2

10

•

14



44

44



**BKR NO: 37**  
**CIRCUIT NO: 2IHAN02**

EE-11Y  
ESK-10IHA40  
EE-3BA  
147D7845

UP81B

September 10, 1991

2VBB-UPS1B LOAD LIST  
DWG. NO. AE-100E  
SHEET 60 OF 228







UPS NO: 2VBB-UPS1B  
PNL NO: 2VBS-PNLB101

DRAWING REFERENCES

EE-11Y  
ESK-10IHA40

BKR NO: 38  
CIRCUIT NO: 2IHAB07

| FEED TO DEVICE   | DEVICE LOCATION |      | PLANT IMPACT  |
|--|-----------------|------|---|
|  | BLDG            | ELEV |   |
| 2CEC-PNL747<br>JB101<br>2IHA-W027<br>2CEC-PNL833<br>BREAKER A1CB2-1A<br>A1CB2-2A | CRR             | 288  | LOSS OF CONTROL ROOM<br>ANNUNCIATIONS AT 2CEC*PNL871,<br>873, 842, 851, 870, 875 AND 852<br>AND LOSS OF ASSOCIATED COMPUTER<br>ALARM POINTS |
|  |                 |      |   |
|  |                 |      |   |
UPS1B

September 10, 1991

2VBB-UPS1B LOAD LIST  
DWG. NO. AE-100E  
SHEET 61 OF 228






UPS NO: 2VBB-UPS1B  
PNL NO: 2VBS-PNLB101

DRAWING REFERENCES

BKR NO: 39  
CIRCUIT NO: 2SWPN52

EE-11Y  
ESK-78WP30 THRU 36  
LSK 9-10AB  
ESK 118WP03

| FEED TO DEVICE | DEVICE LOCATION |      | PLANT IMPACT  |
|----------------|-----------------|------|---|
|                | BLDG            | ELEV |   |
| 2SWP-MOV583    | TB              | 319  | 2HVT-UC222B OUTLET VAC BKR. LOSS OF INDICATION LIGHTS. FAIL AS IS.                    |
| 2SWP-MOV586    | TB              | 329  | 2HVT-UC221A&B, UC219 AND UC220 OUTLET VAC BKR. LOSS OF INDICATING LIGHTS. FAIL AS IS. |
| 2SWP-MOV596    | TB              | 303  | CHILLER BUILDING VAC BKR. LOSS OF INDICATION LIGHTS. FAIL AS IS.                      |
| 2SWP-MOV584    | TB              | 319  | 2HVR-UC222C OUTLET VAC BKR. LOSS OF INDICATION LIGHTS. FAIL AS IS.                    |
| 2SWP-MOV587    | TB              | 280  | 2HVT-UC216B OUTLET VAC BKR. LOSS OF INDICATION LIGHTS. FAIL AS IS.                    |
| 2SWP-MOV597    | TB              | 301  | CHILLER BUILDING VAC BKR. LOSS OF INDICATION LIGHTS. FAIL AS IS.                      |
| 2SWP-MOV585    | TB              | 320  | 2HVT-UC222A OUTLET VAC BKR. LOSS OF INDICATION LIGHTS. FAIL AS IS.                    |
| 2SWP-MOV588    | TB              | 303  | 2HVT-UC225 OUTLET VAC BKR. LOSS OF INDICATION LIGHTS. FAIL AS IS.                     |
| 2SWP-MOV589    | TB              | 323  | 2HVT-UC223A OUTLET VAC BKR. LOSS OF INDICATION LIGHTS. FAIL AS IS.                    |
| 2SWP-MOV591    | TB              | 322  | 2HVT-UC222D OUTLET VAC BKR. LOSS OF INDICATION LIGHTS. FAIL AS IS.                    |

UPS1B

September 10, 1991

2VBB-UPS1B LOAD LIST  
DWG. NO. AE-100E  
SHEET 62 OF 228

1  
2  
1  
2  
UPS NO: 2VBB-UPS1B  
PNL NO: 2VBS-PNLB101

BKR NO: 39  
CIRCUIT NO: 2SWPN52

DRAWING REFERENCES

EE-11Y  
ESK-78WP30 THRU 36  
LSK 9-10AB  
ESK 118WP03

| FEED TO DEVICE | DEVICE LOCATION |      | PLANT IMPACT   |
|----------------|-----------------|------|--|
|                | BLDG            | ELEV |  |
| 2SWP-MOV592    | TB              | 319  | 2HVT-UC222E OUTLET VAC BKR. LOSS OF INDICATION LIGHTS. FAIL AS IS  |
| 2SWP-MOV590    | TB              | 329  | 2HVT-UC223B OUTLET VAC BKR. LOSS OF INDICATION LIGHTS. FAIL AS IS. |
| 2SWP-MOV593    | TB              | 319  | 2HVT-UC223F OUTLET VAC BKR. LOSS OF INDICATION LIGHTS. FAIL AS IS. |
| 2SWP-MOV594    | TB              | 294  | 2HVT-UC218E OUTLET VAC BKR. LOSS OF INDICATION LIGHTS. FAIL AS IS. |
| 2SWP-MOV598    | SC              | 312  | REACTOR BUILDING VAC BKR. LOSS OF INDICATION LIGHTS. FAIL AS IS.   |
| 2SWP-MOV595    | SC              | 296  | 2HVT-UC217B OUTLET VAC BKR. LOSS OF INDICATION LIGHTS. FAIL AS IS. |
| 2SWP-MOV582    | SC              | 312  | REACTOR BUILDING VAC BKR. LOSS OF INDICATION LIGHTS. FAIL AS IS.   |
|                |                 |      |  |
|                |                 |      |  |
UPS1B

September 10, 1991

2VBB-UPS1B LOAD LIST  
DWG. NO. AE-100E  
SHEET 63 OF 228



UPS NO: 2VBB-UPS1B  
PNL NO: 2VBS-PNLB101  
BKR NO: 40  
CIRCUIT NO: N/A

DRAWING REFERENCES  
EE-11Y

| FEED TO DEVICE | DEVICE LOCATION |      | PLANT IMPACT |
|----------------|-----------------|------|--------------|
|                | BLDG            | ELEV |              |
| SPARE          |                 |      |              |
|                |                 |      |              |
|                |                 |      |              |
UPS1B  
September 10, 1991

2VBB-UPS1B LOAD LIST  
DWG. NO. AE-100E  
SHEET 64 OF 228









### DRAWING REFERENCES

**EE-11Y 147D7829**

EE-3CR

**7.520-001-402**

[illegible]

**UP81B**

**September 10, 1991**

## 2VBB-UP81B LOAD LIST

DWG. NO. AE-100E

**SHEET 65 OF 228**





## DRAWING REFERENCES

EE-11Y  
E&DCR Z21002C  
E&DCR Z21003  
N2OP-763

[illegible]

**UP81B**

**September 10, 1991**

2VBB-UPS1B LOAD LIST  
DWG. NO. AE-100E  
SHEET 66 OF 228










UPS NO: 2VBB-UPS1B  
 PNL NO: 2VBS-PNLB102  
 BKR NO: 3  
 CIRCUIT NO: 2WCSN21

DRAWING REFERENCES

147D7829  
 7.212-001-012  
 EE-11Y  
 EE-3CR  
 7.520-001-402  
 7.520-001-403  
 7.224-001-035  
 7.224-001-020  
 1.764-001-021

| FEED TO DEVICE                  | DEVICE LOCATION |      | PLANT IMPACT  |
|---------------------------------|-----------------|------|---|
|                                 | BLDG            | ELEV |   |
| 2CEC*PNL704<br>JB406            | CCR             | 306  |   |
| G33A-W022<br>2CEC-PNL613        | CCR             | 306  |   |
| G33A-W001<br>2CEC*PNL602        | CCR             | 306  |   |
| C51-W264<br>2CEC*PNL603         | CCR             | 306  |   |
| B22A-W025<br>2CEC-PNL619        | CCR             | 306  |   |
| B22A-W014<br>2CEC-PNL614        | CCR             | 306  |   |
| K600-2WCSN21<br>120V PWR SUPPLY | CCR             | 306  | PWR SUPPLY TO K1A & K1B-2WCSN21<br>VIA G33A-F4                                      |
| K1A-2WCSN21 RELAY               | CCR             | 306  | LOSS OF ALARM RELAY PUMP INLET<br>TEMP RWCU PUMP SEAL GLAND PLATE                   |
| K1B-2WCSN21 RELAY               | CCR             | 306  | LOSS OF ALARM RELAY PUMP INLET<br>TEMP RWCU PUMP SEAL GLAND PLATE.<br>SEE ATTACHED. |
|                                 |                 |      |   |
|                                 |                 |      |   |
|                                 |                 |      |   |
|                                 |                 |      |   |

UPS1B

September 10, 1991

2VBB-UPS1B LOAD LIST  
 DWG. NO. AE-100E  
 SHEET 67 OF 228

5

-

8

7

.


































UPS NO: 2VBB-UPS1B  
 PNL NO: 2VBS-PNLB102  
 BKR NO: 3

PLANT IMPACT: LOSS OF POWER TO: POWER SUPPLY G33-K600

| LOOP      | PMS INDICATION | PMS ALARM | ERE INPUT | CR ANNUNCIATION | LOCAL ANNUNCIATION | CR INDICATION | LOCAL INDICATION | VALVE POSITION | DESCRIPTION/OTHER                                       |
|-----------|----------------|-----------|-----------|-----------------|--------------------|---------------|------------------|----------------|---|
| G33-R613A |                |           |           |                 |                    | X             |                  |                | RECORDER FOR RX WTR<br>CLNUP FLTR DEMIN<br>INFLUENT     |
| G33-R613B |                |           |           |                 |                    | X             |                  |                | RECORDER FOR RX<br>RECIRC INFLUENT A                    |
| G33-K601  |                |           |           |                 |                    | X             |                  |                | CLEANUP SYS TEMP<br>INDICATION                          |
| G33-N602  | X              | X         |           | X               |                    | X             | X                |                | CONDUCTIVITY ALARM<br>SWITCH FOR FLTR<br>DEMIN INFLUENT |
| G33-N603A | X              | X         |           | X               | X                  | X             | X                |                | CONDUCTIVITY ALARM<br>FLTR A DEMIN<br>EFFLUENT          |
| G33-N603B | X              | X         |           | X               | X                  | X             | X                |                | CONDUCTIVITY ALARM<br>FLTR B DEMIN<br>EFFLUENT          |
| G33-N603C | X              | X         |           | X               | X                  | X             | X                |                | CONDUCTIVITY ALARM<br>FLTR C DEMIN<br>EFFLUENT          |
| G33-N603D | X              | X         |           | X               | X                  | X             | X                |                | CONDUCTIVITY ALARM<br>FLTR D DEMIN<br>EFFLUENT          |
| G33-SRU1  |                |           |           |                 |                    | X             |                  |                | BOTTOM HEAD DRAIN<br>FLOW INDICATION                    |
| G33-SRU1  |                |           |           |                 |                    | X             |                  |                | REGEN HT EX INLET<br>PRESS INDICATION                   |
| G33-R606  |                |           |           |                 |                    |               |                  | FC             | 2WCS-FV135 DUMP VLV<br>MANUAL CONTROL                   |
| B22-K616  |                | X         |           | X               |                    | X             |                  |                | HEAD STUD CORE TEMP                                     |

UPS1B

September 10, 1991

2VBB-UPS1B LOAD LIST  
 DWG. NO. AE-100E  
 SHEET 68 OF 228

8  
27

4  
5

4

12

1  
2  
2

UPS NO: 2VBB-UPS1B  
 PNL NO: 2VBS-PNLB102  
 BKR NO: 3

PLANT IMPACT: LOSS OF POWER TO: POWER SUPPLY G33-K600

| LOOP      | PMS INDICATION | PMS ALARM | ERE INPUT | CR ANNUNCIATION | LOCAL ANNUNCIATION | CR INDICATION | LOCAL INDICATION | VALVE POSITION | DESCRIPTION/OTHER                                |
|-----------|----------------|-----------|-----------|-----------------|--------------------|---------------|------------------|----------------|--|
| B22-N606  | X              | X         |           | X               |                    | X             |                  |                | FW TURBIDITY SWITCH-ALARM                        |
| B22-SRU1  |                |           |           |                 |                    | X             |                  |                | B22-R605 SHUTDOWN RANGE REACTOR VESSEL LEVEL IND |
| B22-K617  |                | X         |           | X               |                    | X             |                  |                | BOTTOM HEAD TEMP                                 |
| B22-K618  |                | X         |           | X               |                    | X             |                  |                | SHELL FLANGE TEMP                                |
| B22-K620  |                | X         |           | X               |                    | X             |                  |                | BOTTOM HEAD DRAIN TEMP                           |
| B22-N648  |                | X         |           | X               |                    | X             |                  |                | TEMP SWITCH FOR HEAD STUD CORE                   |
| B22-N649  |                | X         |           | X               |                    | X             |                  |                | TEMP SWITCH FOR BOTTOM HEAD                      |
| B22-N650  |                | X         |           | X               |                    | X             |                  |                | TEMP SWITCH FOR SHELL FLANGE                     |
| B22-N652  |                | X         |           | X               |                    | X             |                  |                | TEMP SWITCH FOR BOTTOM HEAD DRAIN                |
| B22-R622  |                |           |           |                 |                    | X             |                  |                | FW TURBIDITY RECORDER                            |
| B35-R614  |                |           |           |                 |                    | X             |                  |                | RECIRC FLOW RECORDER                             |
| C51-R602  |                |           |           |                 |                    | X             |                  |                | SRM RECORDER                                     |
| C51-R603A |                |           |           |                 |                    | X             |                  |                | IRM/APRM RECORDER                                |
| C51-R603B |                |           |           |                 |                    | X             |                  |                | IRM/APRM RECORDER                                |
| C51-R603C |                |           |           |                 |                    | X             |                  |                | IRM/APRM/RBM RECORDER                            |
| C51-R603D |                |           |           |                 |                    | X             |                  |                | IRM/APRM/RBM RECORDER                            |

UPS1B

September 10, 1991

2VBB-UPS1B LOAD LIST  
 DWG. NO. AE-100E  
 SHEET 69 OF 228





## DRAWING REFERENCES

EE-11Y  
EE-3AJ  
7.159-451-328  
7.159-451-327

[illegible]

**UP81B**

September '10, 1991

2VBB-UPS1B LOAD LIST  
DWG. NO. AE-100E  
SHEET 70 OF 228

2  
 3  
1000

1. 2. 84

### DRAWING REFERENCES

EE-11Y  
7.511-414-168

[illegible]

**UP81B**

September 10, 1991

2VBB-UPS1B LOAD LIST  
DWG. NO. AE-100E  
SHEET 71 OF 228










## DRAWING REFERENCES

EE-11Y

7.159-451-334

[illegible]

**UP81B**

**September 10, 1991**

## 2VBB-UP81B LOAD LIST

DWG. NO. AE-100E

SHEET 72 OF 228



### DRAWING REFERENCES

EE-11Y  
EE-3HH  
7.511-989-110  
7.511-989-111

[illegible]

2VBB-UPS1B LOAD LIST  
DWG. NO. AE-100E  
SHEET 73 OF 228

**September 10, 1991**




























UPS NO: 2VBB-UPS1B  
 PNL NO: 2VBS-PNLB102  
 BKR NO: 7

PLANT IMPACT: LOSS OF POWER TO: 2SSR-INPL145

PMS INDICATION  
 PMS ALARM  
 ERF INPUT  
 CR ANNUNCIATION  
 LOCAL ANNUNCIATION  
 CR INDICATION  
 LOCAL INDICATION  
 VALVE POSITION

| LOOP                       |   |   |  |   |   |   |   |  | DESCRIPTION/OTHER   |
|----------------------------|---|---|--|---|---|---|---|--|---|
| 2SSR-124<br>LSK-21-2B      | X | X |  | X | X | X | X |  | CONTROL ROD DRIVE<br>PUMP DISCH SAMPLE<br>CONDUCTIVITY            |
| 2SSR-113<br>LSK-21-2A      | X | X |  | X | X | X | X |  | REACTOR RECIRC<br>INFLUENT A SAMPLE<br>CONDUCTIVITY               |
| 2SSR-6A,B,C,D<br>LSK-21-2A | X | X |  | X | X | X | X |  | RWCU FILTER DEMIN<br>4A,B,C,D OUTLET<br>CONDUCTIVITY              |
| 2SSR-106<br>LSK-21-2A      | X |   |  | X |   | X | X |  | RWCU FILTER DEMIN<br>INFLUENT SAMPLE<br>CONDUCTIVITY              |
| 2SFC-146<br>LSK-34-2D      | X | X |  | X | X |   | X |  | SPENT FUEL POOL<br>COOLING POOL<br>CONDUCTIVITY                   |
| 2SSR-AIT125<br>LSK-21-2B   | X | X |  | X | X |   | X |  | CONTROL ROD DRIVE<br>PUMP DISCH SAMPLE<br>OXYGEN<br>CONCENTRATION |
| 2SSR-AIT14B<br>LSK-21-2C   | X | X |  | X | X | X | X |  | REACTOR RECIRC<br>INFLUENT A SAMPLE<br>OXYGEN                     |
| 2SSR-AIT130<br>LSK-21-2B   | X | X |  | X | X | X | X |  | RWCU FILTER DEMIN<br>INFLUENT SAMPLE<br>OXYGEN<br>CONCENTRATION   |
| 2SSR-AIT156<br>LSK-21-2C   | X | X |  | X | X |   | X |  | CONTROL ROD DRIVE<br>COMMON FLTR DISCH<br>TURBIDITY               |
| 2SSR-TIS9A,B<br>LSK-21-2D  |   | X |  | X | X |   | X |  | RHS HT EXCH E1A, 1B<br>DISCH SAMPLE TEMP                          |

UPS1B

September 10, 1991

2VBB-UPS1B LOAD LIST  
 DWG. NO. AE-100E  
 SHEET 74 OF 228

22

23

24

PLANT IMPACT: LOSS OF POWER TO: 288R-IPNL145

PNL NO: 2VBS-PNLB102

**BKR NO: 7**

**UP81B**

2VBB-UPS1B LOAD LIST  
DWG. NO. AE-100E  
SHEET 75 OF 228










UPS NO: 2VBB-UP81B  
PNL NO: 2VBS-PNLB102  
BKR NO: 8  
CIRCUIT NO: N/A

### DRAWING REFERENCES

1470-7827, SH 2  
EE-3CM, 3LM  
EE-11Y  
400B07-001, SH.4&6  
400B07-002, SH.4&6  
400B07-003, SH. 4&6  
400B07-004, SH. 4&6

[illegible]

**UP81B**

**September 10, 1991**

2VBB-UPS1B LOAD LIST  
DWG. NO. AE-100E  
SHEET 76 OF 228


UPS NO: 2VBB-UPS1B  
PNL NO: 2VBS-PNLB102  
BKR NO: 9  
CIRCUIT NO: N/A

### DRAWING REFERENCES

EE-11Y

[illegible]

**UP81B**

**September 10, 1991**

2VBB-UPS1B LOAD LIST  
DWG. NO. AE-100E  
SHEET 77 OF 228

10

11

12

13

14

15

16

17



**DRAWING REFERENCES**  
**EE-1A, 3ER, EE-11Y**  
**EE-27B, 402R EE-3AW**  
**ESK-7DRS01**  
**ESK-11DRS01**  
**ESK-6DRS01,2,3&4**

[illegible]

**UP81B**

**September 10, 1991**

2VBB-UPS1B LOAD LIST  
DWG. NO. AE-100E  
SHEET 78 OF 228

81  
82  
83  
84  
85  
86  
87  
88

UPS NO: 2VBB-UPS1B  
PNL NO: 2VBS-PNLB102  
BKR NO: 11  
CIRCUIT NO: N/A

DRAWING REFERENCES  
EE-11Y

| FEED TO DEVICE | <u>DEVICE LOCATION</u> |      | PLANT IMPACT |
|----------------|------------------------|------|--------------|
|                | BLDG                   | ELEV |              |
| SPARE          |                        |      |              |
|                |                        |      |              |
|                |                        |      |              |
UPS1B

September 10, 1991

2VBB-UPS1B LOAD LIST  
DWG. NO. AE-100E  
SHEET 79 OF 228



DRAWING REFERENCES  
EE-11Y

[illegible]

2VBB-UPS1B LOAD LIST  
DWG. NO. AE-100E  
SHEET 80 OF 228

**September 10, 1991**

1  
2  
UPS NO: 2VBB-UPS1B  
PNL NO: 2VBS-PNLB102  
BKR NO: 13  
CIRCUIT NO: N/A

DRAWING REFERENCES  
EE-11Y

| FEED TO DEVICE | <u>DEVICE LOCATION</u> |      | PLANT IMPACT |
|----------------|------------------------|------|--------------|
|                | BLDG                   | ELEV |              |
| SPARE          |                        |      |              |
|                |                        |      |              |
|                |                        |      |              |
UPS1B

September 10, 1991

2VBB-UPS1B LOAD LIST  
DWG. NO. AE-100E  
SHEET 81 OF 228





UPS NO: 2VBB-UPS1B  
 PNL NO: 2VBS-PNLB102  
 BKR NO: 14  
 CIRCUIT NO: N/A

DRAWING REFERENCES  
 EE-11Y

| FEED TO DEVICE | DEVICE LOCATION |      | PLANT IMPACT |
|----------------|-----------------|------|--------------|
|                | BLDG            | ELEV |              |
| SPARE          |                 |      |              |
|                |                 |      |              |
|                |                 |      |              |
UPS NO: 2VBB-UPS1B  
PNL NO: 2VBS-PNLB102  
BKR NO: 15  
CIRCUIT NO: N/A

DRAWING REFERENCES  
EE-11Y

| FEED TO DEVICE | <u>DEVICE LOCATION</u> |      | PLANT IMPACT |
|----------------|------------------------|------|--------------|
|                | BLDG                   | ELEV |              |
| SPARE          |                        |      |              |
|                |                        |      |              |
|                |                        |      |              |
UPS1B  
September 10, 1991

2VBB-UPS1B LOAD LIST  
DWG. NO. AE-100E  
SHEET 83 OF 228

2

3

4

5

6

7

8

6.4

2.0

UPS NO: 2VBB-UPS1B  
PNL NO: 2VBS-PNLB102  
BKR NO: 16  
CIRCUIT NO: N/A

DRAWING REFERENCES  
EE-11Y

| FEED TO DEVICE | <u>DEVICE LOCATION</u> |      | PLANT IMPACT |
|----------------|------------------------|------|--------------|
|                | BLDG                   | ELEV |              |
| SPARE          |                        |      |              |
|                |                        |      |              |
|                |                        |      |              |
UPS1B

September 10, 1991

2VBB-UPS1B LOAD LIST  
DWG. NO. AE-100E  
SHEET 84 OF 228

1  
2  
3  
4  
5

UPS NO: 2VBB-UPS1B  
PNL NO: 2VBS-PNLB102  
BKR NO: 17  
CIRCUIT NO: N/A

DRAWING REFERENCES  
EE-11Y

| FEED TO DEVICE | <u>DEVICE LOCATION</u> |      | PLANT IMPACT |
|----------------|------------------------|------|--------------|
|                | BLDG                   | ELEV |              |
| SPARE          |                        |      |              |
|                |                        |      |              |
|                |                        |      |              |
UPS1B  
September 10, 1991

2VBB-UPS1B LOAD LIST  
DWG. NO. AE-100E  
SHEET 85 OF 228





UPS NO: 2VBB-UPS1B  
PNL NO: 2VBS-PNLB102  
BKR NO: 18  
CIRCUIT NO: N/A

DRAWING REFERENCES  
EE-11Y

| FEED TO DEVICE | DEVICE LOCATION |      | PLANT IMPACT |
|----------------|-----------------|------|--------------|
|                | BLDG            | ELEV |              |
| SPARE          |                 |      |              |
|                |                 |      |              |
|                |                 |      |              |
UPS1B

September 10, 1991

2VBB-UPS1B LOAD LIST  
DWG. NO. AE-100E  
SHEET 86 OF 228

22

23

24

25

26

27

28

29

UPS NO: 2VBB-UPS1B  
PNL NO: 2VBS-PNLB102  
BKR NO: 19  
CIRCUIT NO: N/A

DRAWING REFERENCES  
EE-11Y

| FEED TO DEVICE | <u>DEVICE LOCATION</u> |      | PLANT IMPACT |
|----------------|------------------------|------|--------------|
|                | BLDG                   | ELEV |              |
| SPARE          |                        |      |              |
|                |                        |      |              |
|                |                        |      |              |
UPS1B  
September 10, 1991

2VBB-UPS1B LOAD LIST  
DWG. NO. AE-100E  
SHEET 87 OF 228

4  
5  
6  
7  
8  
9

UPS NO: 2VBB-UPS1B  
 PNL NO: 2VBS-PNLB102  
 BKR NO: 20  
 CIRCUIT NO: N/A

DRAWING REFERENCES  
 EE-11Y

| FEED TO DEVICE | DEVICE LOCATION |      | PLANT IMPACT |
|----------------|-----------------|------|--------------|
|                | BLDG            | ELEV |              |
| SPARE          |                 |      |              |
|                |                 |      |              |
|                |                 |      |              |
4.

5.

6.

7.

8.

9.

10.

11.

12.

13.

### DRAWING REFERENCES

EE-118

**EE-11Y**

[illegible]

UP81B

**September 10, 1991**

## 2VBB-UP81B LOAD LIST

DWG. NO. AE-100E

**SHEET 89 OF 228**

1. 2. 3. 4. 5. 6.

7. 8. 9. 10.

11. 12. 13. 14.



UPS NO: 2VBB-UPS1B  
PNL NO: 2VBS-PNLB102  
BKR NO: 22  
CIRCUIT NO: N/A

### DRAWING REFERENCES

**EE-118**

**EE-11Y**

[illegible]

**UP81B**

**September 10, 1991**

2VBB-UPS1B LOAD LIST  
DWG. NO. AE-100E  
SHEET 90 OF 228



UPS NO: 2VBB-UPS1B  
PNL NO: 2VBS-PNLB102  
BKR NO: 23  
CIRCUIT NO: N/A

### DRAWING REFERENCES

**EE-118**

**EE-11Y**

[illegible]

**UP81B**

**September 10, 1991**

2VBB-UPS1B LOAD LIST  
DWG. NO. AE-100E  
SHEET 91 OF 228

1  
2  
UPS NO: 2VBB-UPS1B  
PNL NO: 2VBS-PNLB102  
BKR NO: 24  
CIRCUIT NO: N/A

### DRAWING REFERENCES

**EE-11Y**[illegible]

**UP81B**

**September 10, 1991**

2VBB-UPS1B LOAD LIST  
DWG. NO. AE-100E  
SHEET 92 OF 228



### DRAWING REFERENCES

EE-118  
EE-3LE  
LSK-22-3M

[illegible]

**UP81B**

**September 11, 1991**

2VBB-UPS1B LOAD LIST  
DWG. NO. AE-100E  
SHEET 93 OF 228

1

2

3

4

5

6

7

8

9

10

11

12

13

14

15

16

17

18

19

20

21

22

23

24

25

26

27

28

29

30



## DRAWING REFERENCES

EE-118  
EE-3LE  
LSK-22-5R

[illegible]

2VBB-UPS1B LOAD LIST  
DWG. NO. AE-100E  
SHEET 94 OF 228

**September 11, 1991**

7

1

2

3

4

5

6

7

8

9

10

11

12

13

14

15

16

17

18

19

20

21

22

23

24

25

26

27

28

29

30

## DRAWING REFERENCES

EE-118  
EE-3LE  
LSK-22-5R

[illegible]

**UP81B**

**September 11, 1991**

2VBB-UPS1B LOAD LIST  
DWG. NO. AE-100E  
SHEET 95 OF 228

27

28

29

30

31

32

33

34

35

36

37

38

39

40

41

42

43

44

45

### DRAWING REFERENCES

EE-118  
EE-3LE  
LSK-9-7E

[illegible]

2VBB-UPS1B LOAD LIST  
DWG. NO. AE-100E  
SHEET 96 OF 228

September 11, 1991

22  
23  
24  
25  
26  
27

28  
29

UPS NO: 2VBB-UPS1B  
PNL NO: 2VBS-PNLB102  
BKR NO: 21  
DIST PNL NO: 2VBS-PNLB107  
BKR NO: 5  
CIRCUIT NO: 2RU134

### DRAWING REFERENCES

EE-118  
EE-3LE  
LSK-22-5R

[illegible]

**UP81B**

**September 11, 1991**

2VBB-UPS1B LOAD LIST  
DWG. NO. AE-100E  
SHEET 97 OF 228

10

44

11

12

13

14

15

16

17



### DRAWING REFERENCES

EE-118  
EE-3LE  
LSK-22-5R

[illegible]

2VBB-UPS1B LOAD LIST  
DWG. NO. AE-100E  
SHEET 98 OF 228

**September 11, 1991**

24

25

26

27

28

29

30

31

32

33

34

35

36

37

38

39

40

41

42

43

44

45

46

47

48

49

50

### DRAWING REFERENCES

EE-118  
EE-3LE  
LSK-22-5R

[illegible]

2VBB-UPS1B LOAD LIST  
DWG. NO. AE-100E  
SHEET 99 OF 228

**September 11, 1991**



### DRAWING REFERENCES

EE-118  
EE-3TR  
LSK-31-1.21D

[illegible]

2VBB-UPS1B LOAD LIST  
DWG. NO. AE-100E  
SHEET 100 OF 228

**September 11, 1991**



### DRAWING REFERENCES

EE-118  
EE-3LE  
LSK-22-5R

[illegible]

**UP81B**

**September 11, 1991**

2VBB-UPS1B LOAD LIST  
DWG. NO. AE-100E  
SHEET 101 OF 228

21  
22  
23  
24  
25  
26  
27

28  
29  
30



### DRAWING REFERENCES

EE-118  
EE-3LE  
LSK-22-5R

[illegible]

2VBB-UPS1B LOAD LIST  
DWG. NO. AE-100E  
SHEET 102 OF 228

**September 11, 1991**

100  


### DRAWING REFERENCES

EE-118  
EE-3LF  
LSK-22-5R

[illegible]

2VBB-UPS1B LOAD LIST  
DWG. NO. AE-100E  
SHEET 103 OF 228

**September 11, 1991**

10

11

12

13

14

15

### DRAWING REFERENCES

EE-118  
EE-3LF  
LSK-22-5R

[illegible]

**UP81B**

**September 11, 1991**

2VBB-UPS1B LOAD LIST  
DWG. NO. AE-100E  
SHEET 104 OF 228



September 11, 1991





### DRAWING REFERENCES

EE-118  
EE-3TM  
LSK-31-3A

UP81B

September 11, 1991

2VBB-UPS1B LOAD LIST  
DWG. NO. AE-100E  
SHEET 106 OF 228

10

11

12

13

14

15

16

17

18

19

20

21

22

23

UPS NO: 2VBB-UPS1B  
PNL NO: 2VBS-PNLB102  
BKR NO: 21  
DIST PNL NO: 2VBS-PNLB107  
BKR NO: 15  
CIRCUIT NO: 2RU208

### DRAWING REFERENCES

EE-118  
EE-3TM  
LSK-31-3A

[illegible]

**UP81B**

**September 11, 1991**

2VBB-UPS1B LOAD LIST  
DWG. NO. AE-100E  
SHEET 107 OF 228

1

2

3

4

5

6

7

8

9

10

11

12

13

14

15

16

17

18

19

20

21

22

23

24

25

26

27

28

29

30

### DRAWING REFERENCES

EE-118  
EE-3TP  
LSK-22-58

[illegible]

**UP81B**

**September 11, 1991**

2VBB-UPS1B LOAD LIST  
DWG. NO. AE-100E  
SHEET 108 OF 228

2-

11


















































### DRAWING REFERENCES

EE-118  
EE-3TP  
LSK-22-58

[illegible]

2VBB-UPS1B LOAD LIST  
DWG. NO. AE-100E  
SHEET 109 OF 228

**September 11, 1991**

1

2

3

4

5

6

7

8

9

10

11

12

13

14

15

16

17

18

19

20



### DRAWING REFERENCES

EE-118  
EE-3TP  
LSK-22-58

[illegible]

2VBB-UPS1B LOAD LIST  
DWG. NO. AE-100E  
SHEET 110 OF 228

**September 11, 1991**

100

101

### DRAWING REFERENCES

EE-118  
EE-3TP  
LSK-22-58

[illegible]

2VBB-UPS1B LOAD LIST  
DWG. NO. AE-100E  
SHEET 111 OF 228

**September 11, 1991**

100

101

102

103

104

105

106

107

108

109

110

111

### DRAWING REFERENCES

EE-118  
EE-3TA  
16.230-001-021  
16.230-001-022  
16.230-001-023

[illegible]

2VBB-UPS1B LOAD LIST  
DWG. NO. AE-100E  
SHEET 112 OF 228

**September 11, 1991**

12











































UPS NO: 2VBB-UP81B  
 PNL NO: 2VBS-PNLB102  
 DIST PNL NO: 2VBS-PNLB107  
 BKR NO: 20

PLANT IMPACT: LOSS OF POWER TO 2SSP-IPNL102

| LOOP        | PMS INDICATION | PMS ALARM | ERF INPUT | CR ANNUNCIATION | LOCAL ANNUNCIATION | CR INDICATION | LOCAL INDICATION | VALVE POSITION | DESCRIPTION/OTHER                         |
|-------------|----------------|-----------|-----------|-----------------|--------------------|---------------|------------------|----------------|---|
| 2SSP-FI104  |                |           |           |                 |                    | X             |                  |                | RHR SYSTEM SAMPLE RETURN FLOW             |
| 2SSP-PI1661 |                |           |           |                 |                    | X             |                  |                | REACTOR COOLANT SAMPLE INLET PRESSURE     |
| 2SSP-PI1662 |                |           |           |                 |                    | X             |                  |                | GAS COLLECTION CHAMBER PRESSURE           |
| 2SSP-PI1708 |                |           |           |                 |                    | X             |                  |                | GAS SAMPLE BOTTLE PRESSURE                |
| 2SSP-TI1660 |                |           |           |                 |                    | X             |                  |                | REACTOR COOLANT SAMPLE INLET TEMP         |
| 2SSP-TI1724 |                |           |           |                 |                    | X             |                  |                | SAMPLE GAS INLET TEMP.                    |
| 2SSP-CI1663 |                |           |           |                 |                    | X             |                  |                | REACTOR COOLANT SAMPLE INLET CONDUCTIVITY |
| 2SSP-RI1507 |                |           |           |                 |                    | X             |                  |                | SAMPLE AREA RADIATION                     |
| 2SSP-RI1665 |                |           |           |                 |                    | X             |                  |                | SAMPLE RETURN RADIATION                   |
| 2SSP-RI1704 |                |           |           |                 |                    | X             |                  |                | IODINE CARTRIDGE RADIATION                |
| 2SSP-LS1717 |                |           |           |                 |                    | X             |                  |                | GAS COOLER TRAP LEVEL                     |
|             |                |           |           |                 |                    |               |                  |                |   |
UP81B

September 11, 1991

2VBB-UP81B LOAD LIST  
 DWG. NO. AE-100E  
 SHEET 113 OF 228





THIS SHEET LEFT INTENTIONALLY BLANK

UPS1B

September 11, 1991

2VBB-UPS1B LOAD LIST  
DWG. NO. AE-100E  
SHEET 114 OF 228

10




































UPS NO: 2VBB-UPS1B  
PNL NO: 2VBS-PNLB102  
BKR NO: 21  
DIST PNL NO: 2VBS-PNLB107  
BKR NO: 21  
CIRCUIT NO: 2GSNN01

## DRAWING REFERENCES

**EE-118**

**EE-3TA**

EE-11FQ, ESK-7GSN01, LSK-14-1F

[illegible]

**UP81B**

**September 11, 1991**

## 2VBB-UP81B LOAD LIST

DWG. NO. AE-100E

**SHEET 115 OF 228**



THIS SHEET LEFT INTENTIONALLY BLANK

UPS1B

September 11, 1991

2VBB-UPS1B LOAD LIST  
DWG. NO. AE-100E  
SHEET 116 OF 228

1. 2. 

1

1

1

1 2 

1 2 

1

1

1

1

1

1

1 2 

### DRAWING REFERENCES

EE-118  
EE-3TA  
EE-11FL, ESK-7MWS02, LSK-9-15

[illegible]

**UP81B**

**September 11, 1991**

2VBB-UPS1B LOAD LIST  
DWG. NO. AE-100E  
SHEET 117 OF 228





THIS SHEET LEFT INTENTIONALLY BLANK

UPS1B

September 11, 1991

2VBB-UPS1B LOAD LIST  
DWG. NO. AE-100E  
SHEET 118 OF 228

10

11

12

13

14

15

16

17

18

19

20

21

22

### DRAWING REFERENCES

EE-118  
EE-3TA  
EE-11FL, ESK-7SSR02, LSK-21-2C

**UP81B**

2VBB-UPS1B LOAD LIST  
DWG. NO. AE-100E  
SHEET 119 OF 228



THIS SHEET LEFT INTENTIONALLY BLANK

UPS1B

September 11, 1991

2VBB-UPS1B LOAD LIST  
DWG. NO. AE-100E  
SHEET 120 OF 228

1. 2. 

1. 2. 

UPS NO: 2VBB-UPS1B  
PNL NO: 2VBS-PNLB102  
BKR NO: 21  
DIST PNL NO: 2VBS-PNLB107  
BKR NO: 22  
CIRCUIT NO: 2HVWN17

### DRAWING REFERENCES

ESK-6HVV10  
LSK-22-5E  
EE-118  
EE-3TA

[illegible]

**UP81B**

**September 11, 1991**

2VBB-UPS1B LOAD LIST  
DWG. NO. AE-100E  
SHEET 121 OF 228

6 4 1

1.00

1.00

1.00

1.00

1.00

1.00

1.00

1.00

1.00

1.00

1.00

1.00

1.00

1.00

1.00



### DRAWING REFERENCES

**EE-118**[illegible]

2VBB-UPS1B LOAD LIST  
DWG. NO. AE-100E  
SHEET 122 OF 228

**September 11, 1991**

1  
2  
2VBB-UPS1B LOAD LIST  
DWG. NO. AE-100E  
SHEET 123 OF 228



### DRAWING REFERENCES

**EE-118**[illegible]

2VBB-UPS1B LOAD LIST  
DWG. NO. AE-100E  
SHEET 124 OF 228

**September 11, 1991**

1  
2  
### DRAWING REFERENCES

EE-118

[illegible]

**UP81B**

**September 11, 1991**

2VBB-UPS1B LOAD LIST  
DWG. NO. AE-100E  
SHEET 125 OF 228





UPS NO: 2VBB-UPS1B  
PNL NO: 2VBS-PNLB102  
BKR NO: 21  
DIST PNL NO: 2VBS-PNLB107  
BKR NO: 27  
CIRCUIT NO: N/A

### DRAWING REFERENCES

**EE-118**

[illegible]

**UP81B**

**September 11, 1991**

2VBB-UPS1B LOAD LIST  
DWG. NO. AE-100E  
SHEET 126 OF 228

...

...

...

...

...

...

...

...

...

...

...

...

...

...

### DRAWING REFERENCES

**EE-118**[illegible]

2VBB-UPS1B LOAD LIST  
DWG. NO. AE-100E  
SHEET 127 OF 228

**September 11, 1991**



NOTES:

1. Lose local horns, alarms & indicators.
2. Lose annunciator window & computer pt in control room.
3. RMS computer will have indication of microprocessor failure.
4. Lose local annunciator window.
5. Lose local recorders.

UPS1B

September 11, 1991

2VBB-UPS1B LOAD LIST  
DWG. NO. AE-100E  
SHEET 128 OF 228

1  
2  
### DRAWING REFERENCES

**EE-118**

**EE-3RT**

**LSK-22-3M**

[illegible]

**UP81B**

**September 11, 1991**

## 2VBB-UP81B LOAD LIST

DWG. NO. AE-100E

**SHEET 129 OF 228**

1

2

3

4

5

6

7

8

9

10

11

12

13

14

15

16

17



### DRAWING REFERENCES

EE-118

EE-3RT

**LSK-22-3M**

[illegible]

**UP81B**

**September 11, 1991**

# 2VBB-UPS1B LOAD LIST

DWG. NO. AE-100E

**SHEET 130 OF 228**



### DRAWING REFERENCES

EE-118

**EE-3RT**

**LSK-22-3M**

[illegible]

**UP81B**

**September 11, 1991**

## 2VBB-UP81B LOAD LIST

DWG. NO. AE-100E

SHEET 131 OF 228

9  
- 1  
10

11

12

13

14

15

16

17

18

19

20

21

22

23

24

### DRAWING REFERENCES

EE-118

**EE-3RT**

LSK-22-3M

[illegible]

**UP81B**

**September 11, 1991**

## 2VBB-UP81B LOAD LIST

DWG. NO. AE-100E

**SHEET 132 OF 228**



### DRAWING REFERENCES

EE-3RT

**LSK-22-3M**

**UP81B**

## 2VBB-UP81B LOAD LIST

DWG. NO. AE-100E

**SHEET 133 OF 228**

22

23

24

25

26

27

28

29

30



### DRAWING REFERENCES

EE-118

**EE-3RT**

LSK-22-3M

[illegible]

**UP81B**

**September 11, 1991**

## 2VBB-UP81B LOAD LIST

DWG. NO. AE-100E

**SHEET 134 OF 228**

• •

•

•

•

•

•

•

•

•

• •

•

•

•

•

•

•

•

•

•

•

•

•

•

•

•

•

•

•

### DRAWING REFERENCES

EE-118

**EE-3RT**

**LSK-22-3M**

[illegible]

**UP81B**

**September 11, 1991**

## 2VBB-UP81B LOAD LIST

DWG. NO. AE-100E

**SHEET 135 OF 228**

1. 2. 3. 4. 5. 6. 7.

8. 9. 10. 11. 12. 13.

### DRAWING REFERENCES

EE-3RT

**LSK-22-3M**

[illegible]

**UP81B**

**September 11, 1991**

## 2VBB-UP81B LOAD LIST

DWG. NO. AE-100E

**SHEET 136 OF 228**

.

.

2

4

.

.

.

.

.

4

.

.

.

.

2

4

2

EE-118  
EE-3RT  
LSK-22-3M

[illegible]

2VBB-UPS1B LOAD LIST  
DWG. NO. AE-100E  
SHEET 137 OF 228

50

51

52

53

54

55

56

57

58

59

60

61

62

63

64

65

66

67

68

69

70



UPS NO: 2VBB-UPS1B  
PNL NO: 2VBS-PNLB102  
BKR NO: 22  
DIST PNL NO: 2VBS-PNLB108  
BKR NO: 10  
CIRCUIT NO: 2RU117

### DRAWING REFERENCES

**EE-118**

**EE-3RT**

**LSK-22-3M**

[illegible]

**UP81B**

September 11, 1991

## 2VBB-UPS1B LOAD LIST

DWG. NO. AE-100E

**SHEET 138 OF 228**

22

23

24

25

26

27

28

29

30

31

32

33

34

35

36

37

38

39

40

41

42

43

44

45

46

47

48

49

50

**SHEET 139 OF 228**

10

11

12

13

14

15

16

17

18

19

20

## DRAWING REFERENCES

EE-118

EE-3RT

LSK-22-3M

[illegible]

**UP81B**

**September 11, 1991**

## 2VBB-UP81B LOAD LIST

DWG. NO. AE-100E

**SHEET 140 OF 228**

MAF

44



•

25

433

1 3 2 1

239

5.

444

↓


2

— 19 —

### DRAWING REFERENCES

EE-118

EE-3RT

**LSK-22-3M**

[illegible]

UP81B

**September 11, 1991**

## 2VBB-UP81B LOAD LIST

DWG. NO. AE-100E

SHEET 141 OF 228

1

2

3

4

5

6

7

8

9

10

11

12

13

14

15



EE-118  
EE-3RT  
LSK-22-3M

[illegible]

2VBB-UPS1B LOAD LIST  
DWG. NO. AE-100E  
SHEET 142 OF 228

10

11

12

13

14

15

16

17

18

19

20

21

22

### DRAWING REFERENCES

EE-118

**EE-3RT**

LSK-22-3M

[illegible]

**UP81B**

September 11, 1991

## 2VBB-UPS1B LOAD LIST

DWG. NO. AE-100E

**SHEET 143 OF 228**



### DRAWING REFERENCES

EE-3RT

LSK-22-3M

[illegible]

**UP81B**

**September 11, 1991**

## 2VBB-UPS1B LOAD LIST

DWG. NO. AE-100E

**SHEET 144 OF 228**

3  
12  
1  
1  
1  
1  
1  
8

14  
8  
8

LSK-22-3M

**SHEET 145 OF 228**

10

11

12

13

14

15

16

17

18

19

20



## DRAWING REFERENCES

EE-118

EE-3RT

LSK-22-3M

[illegible]

**UP81B**

**September 11, 1991**

2VBB-UPS1B LOAD LIST  
DWG. NO. AE-100E  
SHEET 146 OF 228

1  
2  
1  
2  
### DRAWING REFERENCES

EE-118

EE-3RT

**LSK-22-3M**

[illegible]

**UP81B**

**September 11, 1991**

2VBB-UPS1B LOAD LIST  
DWG. NO. AE-100E  
SHEET 147 OF 228



### DRAWING REFERENCES

EE-118

EE-3RU

LSK-22-9.1J

[illegible]

UP81B

**September 11, 1991**

## 2VBB-UPS1B LOAD LIST

DWG. NO. AE-100E

**SHEET 148 OF 228**

1

2

3

4

5

6

7

8

9

10

11

12

13

EE-118  
EE-3RU  
LSK-22-9.1J

[illegible]

2VBB-UPS1B LOAD LIST  
DWG. NO. AE-100E  
SHEET 149 OF 228

100



•

3

484

2A<sup>4</sup>



;

3.

23

22

2



UPS NO: 2VBB-UPS1B  
PNL NO: 2VBS-PNLB102  
BKR NO: 22  
DIST PNL NO: 2VBS-PNLB108  
BKR NO: 22  
CIRCUIT NO: 2RU130

### DRAWING REFERENCES

EE-118

EE-3RU

**LSK-22-9.1J**

[illegible]

UP81B

**September 11, 1991**

2VBB-UPS1B LOAD LIST  
DWG. NO. AE-100E  
SHEET 150 OF 228



### DRAWING REFERENCES

EE-118

EE-3TQ

LSK-31-4F

[illegible]

**UP81B**

**September 11, 1991**

## 2VBB-UP81B LOAD LIST

DWG. NO. AE-100E

**SHEET 151 OF 228**

100

101

102

103

104

105

106

107

108

109

110

**DRAWING REFERENCES**  
**EE-118**  
**EE-3TQ**  
**LSK-31-4F**

[illegible]

2VBB-UPS1B LOAD LIST  
DWG. NO. AE-100E  
SHEET 152 OF 228

10

11

12

13

14

15

16

17

18

19

20

21

22

23

24

25

26

27

28

29

30

31

32

33

34

35

36

37

38

### DRAWING REFERENCES

**EE-118**

**EE-3TR**

LSK-2-1.1J

[illegible]

**UP81B**

**September 11, 1991**

## 2VBB-UP81B LOAD LIST

DWG. NO. AE-100E

SHEET 153 OF 228





EE-118  
EE-3TP  
LSK-22-30

[illegible]

2VBB-UPS1B LOAD LIST  
DWG. NO. AE-100E  
SHEET 154 OF 228

1  
2  
**SHEET 155 OF 228**



**DRAWING REFERENCES**  
**EE-118**

[illegible]

2VBB-UPS1B LOAD LIST  
DWG. NO. AE-100E  
SHEET 156 OF 228



NOTES:

1. LOSS OF LOCAL HORNS, ALARMS & INDICATORS
2. LOSS OF ANNUNCIATOR WINDOW & COMPTR PT IN CONTROL ROOM
3. RMS COMPUTER WILL HAVE INDICATION OF MICROPROCESSOR FAILURE
4. VALVE 20FG-AOV103 (OFFGAS TO THE STACK LINE) WILL LOSE THE AUTOMATIC CLOSE FUNCTION ON HIGH RADIATION
5. LOSS OF LOCAL ANNUNCIATOR WINDOW

UPS1B

September 11, 1991

2VBB-UPS1B LOAD LIST  
DWG. NO. AE-100E  
SHEET 157 OF 228

1

2

3

4

5

6

7



### DRAWING REFERENCES

EE-118  
LSK-22-1R  
EE-3LF

[illegible]

2VBB-UPS1B LOAD LIST  
DWG. NO. AE-100E  
SHEET 158 OF 228

**September 11, 1991**

1

2

3

4

5

6

7

8

9

10

11

12

13

14

15

16

17

18

19

20

21

22

23

24

25

26

27

28

29

30

### DRAWING REFERENCES

EE-118  
LSK-22-1R  
EE-3LF

[illegible]

2VBB-UPS1B LOAD LIST  
DWG. NO. AE-100E  
SHEET 159 OF 228

**September 11, 1991**



### DRAWING REFERENCES

EE-118  
LSK-22-1R  
EE-3LF

[illegible]

2VBB-UPS1B LOAD LIST  
DWG. NO. AE-100E  
SHEET 160 OF 228

**September 11, 1991**

10

11

12

13

14

15

16

17

18

19

### DRAWING REFERENCES

EE-118  
EE-3LF  
LSK-22-1R

[illegible]

**September 11, 1991**

100

101

102

103

104

105

106

107

108

109

110

111

112

113



### DRAWING REFERENCES

EE-118  
LSK-22-1R  
EE-3LF

[illegible]

**UP81B**

**September 11, 1991**

2VBB-UPS1B LOAD LIST  
DWG. NO. AE-100E  
SHEET 162 OF 228

•  
•  
•  
•  
•  
•  
•  
•

•

### DRAWING REFERENCES

EE-118  
LSK-22-1R  
EE-3LF

[illegible]

2VBB-UPS1B LOAD LIST  
DWG. NO. AE-100E  
SHEET 163 OF 228

**September 11, 1991**

2

4

1

2

2

100

2

### DRAWING REFERENCES

EE-118  
LSK-22-1R  
EE-3LF

[illegible]

2VBB-UPS1B LOAD LIST  
DWG. NO. AE-100E  
SHEET 164 OF 228

**September 11, 1991**

22

23

24

25

26

27

28

29

30

31

32

### DRAWING REFERENCES

EE-118  
LSK-22-1R  
EE-3R8

[illegible]

2VBB-UPS1B LOAD LIST  
DWG. NO. AE-100E  
SHEET 165 OF 228

**September 11, 1991**

1  
2  
3  
4  
5  
6  
7

8  
9  
10  
11  
12



### DRAWING REFERENCES

EE-118  
LSK-R22-1R  
EE-3TM

[illegible]

UP81B

September 11, 1991

2VBB-UPS1B LOAD LIST  
DWG. NO. AE-100E  
SHEET 166 OF 228

10

11

12

13

14

15

16

17

18

19

20

21

### DRAWING REFERENCES

EE-118  
LSK-22-1R  
EE-3RS

[illegible]

**UP81B**

**September 11, 1991**

2VBB-UPS1B LOAD LIST  
DWG. NO. AE-100E  
SHEET 167 OF 228

100  



### DRAWING REFERENCES

EE-118  
LSK-22-1R  
EE-3R8

[illegible]

2VBB-UPS1B LOAD LIST  
DWG. NO. AE-100E  
SHEET 168 OF 228

**September 11, 1991**

10

11

12

13

14

15

16

17

18

19

20

21

22

23

24

25

26

27

28

29

30

31

32

33

34

35

36

37

38

39

40

### DRAWING REFERENCES

[illegible]

2VBB-UPS1B LOAD LIST  
DWG. NO. AE-100E  
SHEET 169 OF 228

2

3

4

5

6

7

8

9



### DRAWING REFERENCES

EE-118  
LSK-22-1R  
EE-3R8

[illegible]

**UP81B**

**September 11, 1991**

2VBB-UPS1B LOAD LIST  
DWG. NO. AE-100E  
SHEET 170 OF 228

1

2

3

4

5

6

7

8

9

10

11

12

13

14

15

### DRAWING REFERENCES

EE-118  
LSK-22-1R  
EE-3RV

[illegible]

2VBB-UPS1B LOAD LIST  
DWG. NO. AE-100E  
SHEET 171 OF 228

**September 11, 1991**

1  
2  
### DRAWING REFERENCES

EE-118  
LSK-22-1R  
EE-3RS

[illegible]

2VBB-UPS1B LOAD LIST  
DWG. NO. AE-100E  
SHEET 172 OF 228

**September 11, 1991**

10

11

12

13

14

15

16

17

18

## DRAWING REFERENCES

EE-118  
LSK-22-1R  
EE-3R8

[illegible]

2VBB-UPS1B LOAD LIST  
DWG. NO. AE-100E  
SHEET 173 OF 228

September 11, 1991





### DRAWING REFERENCES

EE-118  
LSK-22-1R  
EE-3RS

[illegible]

**UP81B**

**September 11, 1991**

2VBB-UPS1B LOAD LIST  
DWG. NO. AE-100E  
SHEET 174 OF 228

1  
2  
1  
2  
1  
2  
1  
2  
UPS NO: 2VBB-UPS1B  
PNL NO: 2VBS-PNLB102  
BKR #23  
DIST PNL NO: 2VBS-PNLB109  
BKR NO: 18  
CIRCUIT NO: 2RU112

### DRAWING REFERENCES

EE-118  
LSK-22-1R  
EE-3RU

[illegible]

**UP81B**

**September 11, 1991**

2VBB-UPS1B LOAD LIST  
DWG. NO. AE-100E  
SHEET 175 OF 228

10

11

12

13

14

15

16

17

18

### DRAWING REFERENCES

EE-118  
LSK-22-1R  
EE-3RU

[illegible]

**UP81B**

**September 11, 1991**

2VBB-UPS1B LOAD LIST  
DWG. NO. AE-100E  
SHEET 176 OF 228

1

2

3

4

5

6

7

8

9

10

11

12

13

14

15

16

17

18

19

20

21

22

23

24

25

26

27

28

29

### DRAWING REFERENCES

EE-118  
LSK-22-1R  
EE-3RS

[illegible]

**UP81B**

September 11, 1991

2VBB-UPS1B LOAD LIST  
DWG. NO. AE-100E  
SHEET 177 OF 228

1

2

3

4

5

6

7

8

9

10

11

12



### DRAWING REFERENCES

EE-118  
LSK-27-15G  
EE-3TQ

[illegible]

2VBB-UPS1B LOAD LIST  
DWG. NO. AE-100E  
SHEET 178 OF 228

**September 11, 1991**

1

2

3

4

5

6

7

8

9

10

UPS NO: 2VBB-UPS1B  
PNL NO: 2VBS-PNLB102  
BKR #23  
DIST PNL NO: 2VBS-PNLB109  
BKR NO: 22  
CIRCUIT NO: 2RU193

### DRAWING REFERENCES

EE-118  
LSK-22-3M  
EE-3RU

[illegible]

**UP81B**

**September 11, 1991**

2VBB-UPS1B LOAD LIST  
DWG. NO. AE-100E  
SHEET 179 OF 228

11-12-13

11-12-13

11-12-13

### DRAWING REFERENCES

EE-118  
LSK-9-1H  
EE-3TR

[illegible]

**UP81B**

**September 11, 1991**

2VBB-UPS1B LOAD LIST  
DWG. NO. AE-100E  
SHEET 180 OF 228

1

2

3

4

5

6

7

8

9

### DRAWING REFERENCES

EE-118  
LSK-9-1H  
EE-3TR

[illegible]

2VBB-UPS1B LOAD LIST  
DWG. NO. AE-100E  
SHEET 181 OF 228

**September 11, 1991**





### DRAWING REFERENCES

EE-118  
LSK-34-2G  
EE-3TR

[illegible]

2VBB-UPS1B LOAD LIST  
DWG. NO. AE-100E  
SHEET 182 OF 228

**September 11, 1991**

11. 8

12

13

14

15

16

17

18

19

20

21

22

23

24

25

26

27

28

29

30

31

32

33

34

35

## <sup>d</sup> DRAWING REFERENCES

EE-118  
EE-3TP  
LSK-22-18

[illegible]

2VBB-UPS1B LOAD LIST  
DWG. NO. AE-100E  
SHEET 183 OF 228

**September 11, 1991**



### DRAWING REFERENCES

EE-118  
EE-3TP  
LSK-22-18

[illegible]

2VBB-UPS1B LOAD LIST  
DWG. NO. AE-100E  
SHEET 184 OF 228

**September 11, 1991**

22

23

24

25

26

27

28

29

30

31

32

33

34

35

36

37

38

39

40

41

42

43

44

45

46

47

48

49

50

51

52

53

## DRAWING REFERENCES

EE-118  
EE-3TP  
LSK-22-18

[illegible]

2VBB-UPS1B LOAD LIST  
DWG. NO. AE-100E  
SHEET 185 OF 228

September 11, 1991





NOTES:

1. LOSE LOCAL HORNS, ALARMS AND INDICATORS
2. LOSE ANNUNCIATOR WINDOW AND COMPUTER PT. IN CONTROL ROOM
3. RMS COMPUTER WILL HAVE INDICATION OF MICROPROCESSOR FAILURE

UPS1B

September 11, 1991

2VBB-UPS1B LOAD LIST  
DWG. NO. AE-100E  
SHEET 186 OF 228

2

3

4

5

6

7

8

9

10

11

### DRAWING REFERENCES

**EE-11BK**

BKR NO: 1  
CIRCUIT NO: N/A

[illegible]

UP81B

**September 10, 1991**

2VBB-UPS1B LOAD LIST  
DWG. NO. AE-100E  
SHEET 187 OF 228

•

•

•

•

•

•

•

•

•

UPS NO: 2VBB-UPS1B  
PNL NO: 2VBS-PNLB111

### DRAWING REFERENCES

**EE-11BK**

BKR NO: 2  
CIRCUIT NO: N/A

[illegible]

**UP81B**

**September 10, 1991**

2VBB-UPS1B LOAD LIST  
DWG. NO. AE-100E  
SHEET 188 OF 228

1

2

3

4

5

6

7

8

9

10

11

12

13

14

15

16

17

18

19

20

21

22

23

24

25

26

27

28

29

30

31

32

33

34

35

36

37

38

39

UPS NO: 2VBB-UPS1B  
PNL NO: 2VBS-PNLB111

DRAWING REFERENCES

EE-11BK

BKR NO: 3  
CIRCUIT NO: N/A

| FEED TO DEVICE | DEVICE LOCATION |      | PLANT IMPACT                  |
|----------------|-----------------|------|-------------------------------|
|                | BLDG            | ELEV |                               |
| RADIAX SYSTEM  |                 |      | PARTIAL LOSS OF RADIAX SYSTEM |
|                |                 |      |                               |
|                |                 |      |                               |
UPS1B

September 10, 1991

2VBB-UPS1B LOAD LIST  
DWG. NO. AE-100E  
SHEET 189 OF 228

1

2

3

4

5

6

7

8

9

10

11

12

13

14

15

16

17

18

19

20

21

22

23

24

25

26

27

28

29

30



UPS NO: 2VBB-UPS1B  
PNL NO: 2VBS-PNLB111

DRAWING REFERENCES

EE-11BK

BKR NO: 4  
CIRCUIT NO: N/A

| FEED TO DEVICE | <u>DEVICE LOCATION</u> |      | PLANT IMPACT                  |
|----------------|------------------------|------|-------------------------------|
|                | BLDG                   | ELEV |                               |
| RADIAX SYSTEM  |                        |      | PARTIAL LOSS OF RADIAX SYSTEM |
|                |                        |      |                               |
|                |                        |      |                               |
UPS1B

September 10, 1991

2VBB-UPS1B LOAD LIST  
DWG. NO. AE-100E  
SHEET 190 OF 228

100  
101  
UPS NO: 2VBB-UP81B  
PNL NO: 2VBS-PNLB111

### DRAWING REFERENCES

**EE-11BK**

**BKR NO: 5**  
**CIRCUIT NO: N/A**

[illegible]

**UP81B**

**September 10, 1991**

2VBB-UPS1B LOAD LIST  
DWG. NO. AE-100E  
SHEET 191 OF 228

2  
3  
4  
5  
6  
7  
8  
9  
10

11  
12

### DRAWING REFERENCES

**EE-11BK**

[illegible]

**September 10, 1991**

2VBB-UPS1B LOAD LIST  
DWG. NO. AE-100E  
SHEET 192 OF 228



### DRAWING REFERENCES

BKR NO: 7  
CIRCUIT NO: N/A

[illegible]

**September 10, 1991**

2VBB-UPS1B LOAD LIST  
DWG. NO. AE-100E  
SHEET 193 OF 228

2

3

4

5

6

7

8

9

10

11

12

13

14

15

16

17

18

19

20

21

22

23

24

25

26

27

28

29

30



### DRAWING REFERENCES

**EE-11BK**

BKR NO: 8  
CIRCUIT NO: N/A

[illegible]

**UP81B**

**September 10, 1991**

2VBB-UPS1B LOAD LIST  
DWG. NO. AE-100E  
SHEET 194 OF 228



UPS NO: 2VBB-UP81B  
PNL NO: 2VBS-PNLB111

## DRAWING REFERENCES

**EE-11BK**

**BKR NO: 9**  
**CIRCUIT NO: N/A**

[illegible]

**UP81B**

**September 10, 1991**

2VBB-UPS1B LOAD LIST  
DWG. NO. AE-100E  
SHEET 195 OF 228

1  
2  
UPS NO: 2VBB-UP81B  
PNL NO: 2VBS-PNLB111

### DRAWING REFERENCES

EE-11BK

BKR NO: 10  
CIRCUIT NO: N/A

[illegible]

**UP81B**

**September 10, 1991**

2VBB-UPS1B LOAD LIST  
DWG. NO. AE-100E  
SHEET 196 OF 228

1  
2  
UPS NO: 2VBB-UP81B  
PNL NO: 2VBS-PNLB111

### DRAWING REFERENCES

**EE-11BK**

BKR NO: 11  
CIRCUIT NO: N/A

[illegible]

**UP81B**

September 10, 1991

2VBB-UPS1B LOAD LIST  
DWG. NO. AE-100E  
SHEET 197 OF 228





UPS NO: 2VBB-UPS1B  
PNL NO: 2VBS-PNLB111

### DRAWING REFERENCES

**EE-11BK**

BKR NO: 12  
CIRCUIT NO: N/A

[illegible]

**UP81B**

**September 10, 1991**

2VBB-UPS1B LOAD LIST  
DWG. NO. AE-100E  
SHEET 198 OF 228



UPS NO: 2VBB-UP81B  
PNL NO: 2VBS-PNLB111

### DRAWING REFERENCES

**EE-11BK**

BKR NO: 13  
CIRCUIT NO: N/A

[illegible]

**UP81B**

**September 10, 1991**

2VBB-UPS1B LOAD LIST  
DWG. NO. AE-100E  
SHEET 199 OF 228







UPS NO: 2VBB-UPS1B  
PNL NO: 2VBS-PNLB111

DRAWING REFERENCES

EE-11BK

BKR NO: 14  
CIRCUIT NO: N/A

| FEED TO DEVICE | <u>DEVICE LOCATION</u> |      | PLANT IMPACT                  |
|----------------|------------------------|------|-------------------------------|
|                | BLDG                   | ELEV |                               |
| RADIAX SYSTEM  |                        |      | PARTIAL LOSS OF RADIAX SYSTEM |
|                |                        |      |                               |
|                |                        |      |                               |
UPS1B

September 10, 1991

2VBB-UPS1B LOAD LIST  
DWG. NO. AE-100E  
SHEET 200 OF 228



UPS NO: 2VBB-UPS1B  
PNL NO: 2VBS-PNLB111

DRAWING REFERENCES

EE-11BK

BKR NO: 15  
CIRCUIT NO: N/A

| FEED TO DEVICE | DEVICE LOCATION |      | PLANT IMPACT                  |
|----------------|-----------------|------|-------------------------------|
|                | BLDG            | ELEV |                               |
| RADIAX SYSTEM  |                 |      | PARTIAL LOSS OF RADIAX SYSTEM |
|                |                 |      |                               |
|                |                 |      |                               |
UPS1B

September 10, 1991

2VBB-UPS1B LOAD LIST  
DWG. NO. AE-100E  
SHEET 201 OF 228

1

2

3

4

5

6

7

8

9

10

11

12

13

14

15

16

17

18

19

20

21

22

23

24

25

26

27

28

29

30

31

32

33



### DRAWING REFERENCES

**EE-11BK**

BKR NO: 16  
CIRCUIT NO: N/A

[illegible]

UP81B

September 10, 1991

2VBB-UPS1B LOAD LIST  
DWG. NO. AE-100E  
SHEET 202 OF 228



UPS NO: 2VBB-UPS1B  
PNL NO: 2VBS-PNLB111

### DRAWING REFERENCES

**EE-11BK**

BKR NO: 17  
CIRCUIT NO: N/A

[illegible]

**UP81B**

**September 10, 1991**

2VBB-UPS1B LOAD LIST  
DWG. NO. AE-100E  
SHEET 203 OF 228


20

UPS NO: 2VBB-UPS1B  
PNL NO: 2VBS-PNLB111

DRAWING REFERENCES

EE-11BK

BKR NO: 18  
CIRCUIT NO: N/A

| FEED TO DEVICE | DEVICE LOCATION |      | PLANT IMPACT                  |
|----------------|-----------------|------|-------------------------------|
|                | BLDG            | ELEV |                               |
| RADIAX SYSTEM  |                 |      | PARTIAL LOSS OF RADIAX SYSTEM |
|                |                 |      |                               |
|                |                 |      |                               |
UPS1B

September 10, 1991

2VBB-UPS1B LOAD LIST  
DWG. NO. AE-100E  
SHEET 204 OF 228



UPS NO: 2VBB-UPS1B  
PNL NO: 2VBS-PNLB111

### DRAWING REFERENCES

**EE-11BK**

BKR NO: 19  
CIRCUIT NO: N/A

[illegible]

**UP81B**

**September 10, 1991**

2VBB-UPS1B LOAD LIST  
DWG. NO. AE-100E  
SHEET 205 OF 228





### DRAWING REFERENCES

**EE-11BK**[illegible]

**September 10, 1991**

2VBB-UPS1B LOAD LIST  
DWG. NO. AE-100E  
SHEET 206 OF 228



UPS NO: 2VBB-UPS1B  
PNL NO: 2VBS-PNLB111

DRAWING REFERENCES

EE-11BK

BKR NO: 21  
CIRCUIT NO: N/A

| FEED TO DEVICE | DEVICE LOCATION |      | PLANT IMPACT                  |
|----------------|-----------------|------|-------------------------------|
|                | BLDG            | ELEV |                               |
| RADIAX SYSTEM  |                 |      | PARTIAL LOSS OF RADIAX SYSTEM |
|                |                 |      |                               |
|                |                 |      |                               |
UPS1B  
September 10, 1991

2VBB-UPS1B LOAD LIST  
DWG. NO. AE-100E  
SHEET 207 OF 228

1

2

3

4

5

6

7

8

9

10 11 12 13 14 15 16

17

18

19

20 21 22 23 24 25 26

## DRAWING REFERENCES

EE-11BK

**BKR NO: 22**  
**CIRCUIT NO: N/A**

[illegible]

**UP81B**

**September 10, 1991**

2VBB-UPS1B LOAD LIST  
DWG. NO. AE-100E  
SHEET 208 OF 228
































UPS NO: 2VBB-UPS1B  
PNL NO: 2VBS-PNLB111

DRAWING REFERENCES

EE-11BK

BKR NO: 23  
CIRCUIT NO: N/A

| FEED TO DEVICE | DEVICE LOCATION |      | PLANT IMPACT                  |
|----------------|-----------------|------|-------------------------------|
|                | BLDG            | ELEV |                               |
| RADIAX SYSTEM  |                 |      | PARTIAL LOSS OF RADIAX SYSTEM |
|                |                 |      |                               |
|                |                 |      |                               |
UPS1B

September 10, 1991

2VBB-UPS1B LOAD LIST  
DWG. NO. AE-100E  
SHEET 209 OF 228

7

1871

25

26

27































UPS NO: 2VBB-UPS1B  
PNL NO: 2VBS-PNLB111

### DRAWING REFERENCES

**EE-11BK**

**BKR NO: 24**  
**CIRCUIT NO: N/A**

[illegible]

**UP81B**

**September 10, 1991**

2VBB-UPS1B LOAD LIST  
DWG. NO. AE-100E  
SHEET 210 OF 228









































### DRAWING REFERENCES

**BKR NO: 25**  
**CIRCUIT NO: N/A**

[illegible]

**September 10, 1991**

2VBB-UPS1B LOAD LIST  
DWG. NO. AE-100E  
SHEET 211 OF 228



### DRAWING REFERENCES

EE-11BK

**BKR NO: 26**  
**CIRCUIT NO: N/A**

[illegible]

**UP81B**

**September 10, 1991**

2VBB-UPS1B LOAD LIST  
DWG. NO. AE-100E  
SHEET 212 OF 228












UPS NO: 2VBB-UPS1B  
PNL NO: 2VBS-PNLB111

DRAWING REFERENCES

EE-11BK

BKR NO: 27  
CIRCUIT NO: N/A

| FEED TO DEVICE | <u>DEVICE LOCATION</u> |      | PLANT IMPACT                  |
|----------------|------------------------|------|-------------------------------|
|                | BLDG                   | ELEV |                               |
| RADIAX SYSTEM  |                        |      | PARTIAL LOSS OF RADIAX SYSTEM |
|                |                        |      |                               |
|                |                        |      |                               |
UPS1B  
September 10, 1991

2VBB-UPS1B LOAD LIST  
DWG. NO. AE-100E  
SHEET 213 OF 228
















UPS NO: 2VBB-UPS1B  
PNL NO: 2VBS-PNLB111

DRAWING REFERENCES

EE-11BK

BKR NO: 28  
CIRCUIT NO: N/A

| FEED TO DEVICE | DEVICE LOCATION |      | PLANT IMPACT                  |
|----------------|-----------------|------|-------------------------------|
|                | BLDG            | ELEV |                               |
| RADIAX SYSTEM  |                 |      | PARTIAL LOSS OF RADIAX SYSTEM |
|                |                 |      |                               |
|                |                 |      |                               |
UPS1B  
September 10, 1991

2VBB-UPS1B LOAD LIST  
DWG. NO. AE-100E  
SHEET 214 OF 228



### DRAWING REFERENCES

EE-11BK

BKR NO: 29  
CIRCUIT NO: N/A

[illegible]

**UP81B**

**September 10, 1991**

2VBB-UPS1B LOAD LIST  
DWG. NO. AE-100E  
SHEET 215 OF 228




















UPS NO: 2VBB-UPS1B  
PNL NO: 2VBS-PNLB111

DRAWING REFERENCES

EE-11BK

BKR NO: 30  
CIRCUIT NO: N/A

| FEED TO DEVICE | DEVICE LOCATION |      | PLANT IMPACT                  |
|----------------|-----------------|------|-------------------------------|
|                | BLDG            | ELEV |                               |
| RADIAX SYSTEM  |                 |      | PARTIAL LOSS OF RADIAX SYSTEM |
|                |                 |      |                               |
|                |                 |      |                               |
UPS1B

September 10, 1991

2VBB-UPS1B LOAD LIST  
DWG. NO. AE-100E  
SHEET 216 OF 228

10

11

12

13

14

15

16

17

18

19

20

21

22

23

### DRAWING REFERENCES

**EE-11BK**

BKR NO: 31  
CIRCUIT NO: N/A

[illegible]

**UP81B**

**September 10, 1991**

2VBB-UPS1B LOAD LIST  
DWG. NO. AE-100E  
SHEET 217 OF 228




































### DRAWING REFERENCES

EE-11BK

**BKR NO: 32**  
**CIRCUIT NO: N/A**

[illegible]

**UP81B**

**September 10, 1991**

2VBB-UPS1B LOAD LIST  
DWG. NO. AE-100E  
SHEET 218 OF 228


































UPS NO: 2VBB-UPS1B  
PNL NO: 2VBS-PNLB111

### DRAWING REFERENCES

**BKR NO: 33**  
**CIRCUIT NO: N/A**

EE-11BK  
E&DCR Y03801D

[illegible]

**UP81B**

**September 10, 1991**

2VBB-UPS1B LOAD LIST  
DWG. NO. AE-100E  
SHEET 219 OF 228














UPS NO: 2VBB-UPS1B  
PNL NO: 2VBS-PNLB111

DRAWING REFERENCES

EE-11BK  
EE-11X

BKR NO: 34  
CIRCUIT NO: N/A

| FEED TO DEVICE | DEVICE LOCATION |      | PLANT IMPACT |
|----------------|-----------------|------|--------------|
|                | BLDG            | ELEV |              |
| 2LAC-PNLU04    | CCR             | 261  | N/A          |
|                |                 |      |              |
|                |                 |      |              |
UPS1B

September 10, 1991

2VBB-UPS1B LOAD LIST  
DWG. NO. AE-100E  
SHEET 220 OF 228



### DRAWING REFERENCES

EE-11BK  
E&DCR Y03801D

[illegible]

2VBB-UPS1B LOAD LIST  
DWG. NO. AE-100E  
SHEET 221 OF 228

**September 10, 1991**























### DRAWING REFERENCES

EE-11BK  
EE-11X

[illegible]

2VBB-UPS1B LOAD LIST  
DWG. NO. AE-100E  
SHEET 222 OF 228

**September 10, 1991**




















### DRAWING REFERENCES

EE-11BK  
E&DCR Y03801D

[illegible]

2VBB-UPS1B LOAD LIST  
DWG. NO. AE-100E  
SHEET 223 OF 228

September 10, 1991



### DRAWING REFERENCES

**EE-11X**

**CIRCUIT NO: N/A**

[illegible]

2VBB-UPS1B LOAD LIST  
DWG. NO. AE-100E  
SHEET 224 OF 228

DWG. NO. AE-100E

SHEET 224 OF 228

**September 10, 1991**


































### DRAWING REFERENCES

**EE-11BK**

BKR NO: 39  
CIRCUIT NO: N/A

[illegible]

UP81B

**September 10, 1991**

2VBB-UPS1B LOAD LIST  
DWG. NO. AE-100E  
SHEET 225 OF 228

10

11

12

13

14

15

16

17

18

19

20

21



UPS NO: 2VBB-UPS1B  
PNL NO: 2VBS-PNLB111

### DRAWING REFERENCES

**EE-11BK**

BKR NO: 40  
CIRCUIT NO: N/A

[illegible]

**UP81B**

**September 10, 1991**

2VBB-UPS1B LOAD LIST  
DWG. NO. AE-100E  
SHEET 226 OF 228



### DRAWING REFERENCES

**EE-11BK**

BKR NO: 41  
CIRCUIT NO: N/A

[illegible]

**UP81B**

**September 10, 1991**

2VBB-UPS1B LOAD LIST  
DWG. NO. AE-100E  
SHEET 227 OF 228






UPS NO: 2VBB-UPS1B  
PNL NO: 2VBS-PNLB111

### DRAWING REFERENCES

EE-11BK

**BKR NO: 42**  
**CIRCUIT NO: N/A**

[illegible]


**UP81B**

**September 10, 1991**

2VBB-UPS1B LOAD LIST  
DWG. NO. AE-100E  
SHEET 228 OF 228



# 2VBB-UPS1C LOAD LIST

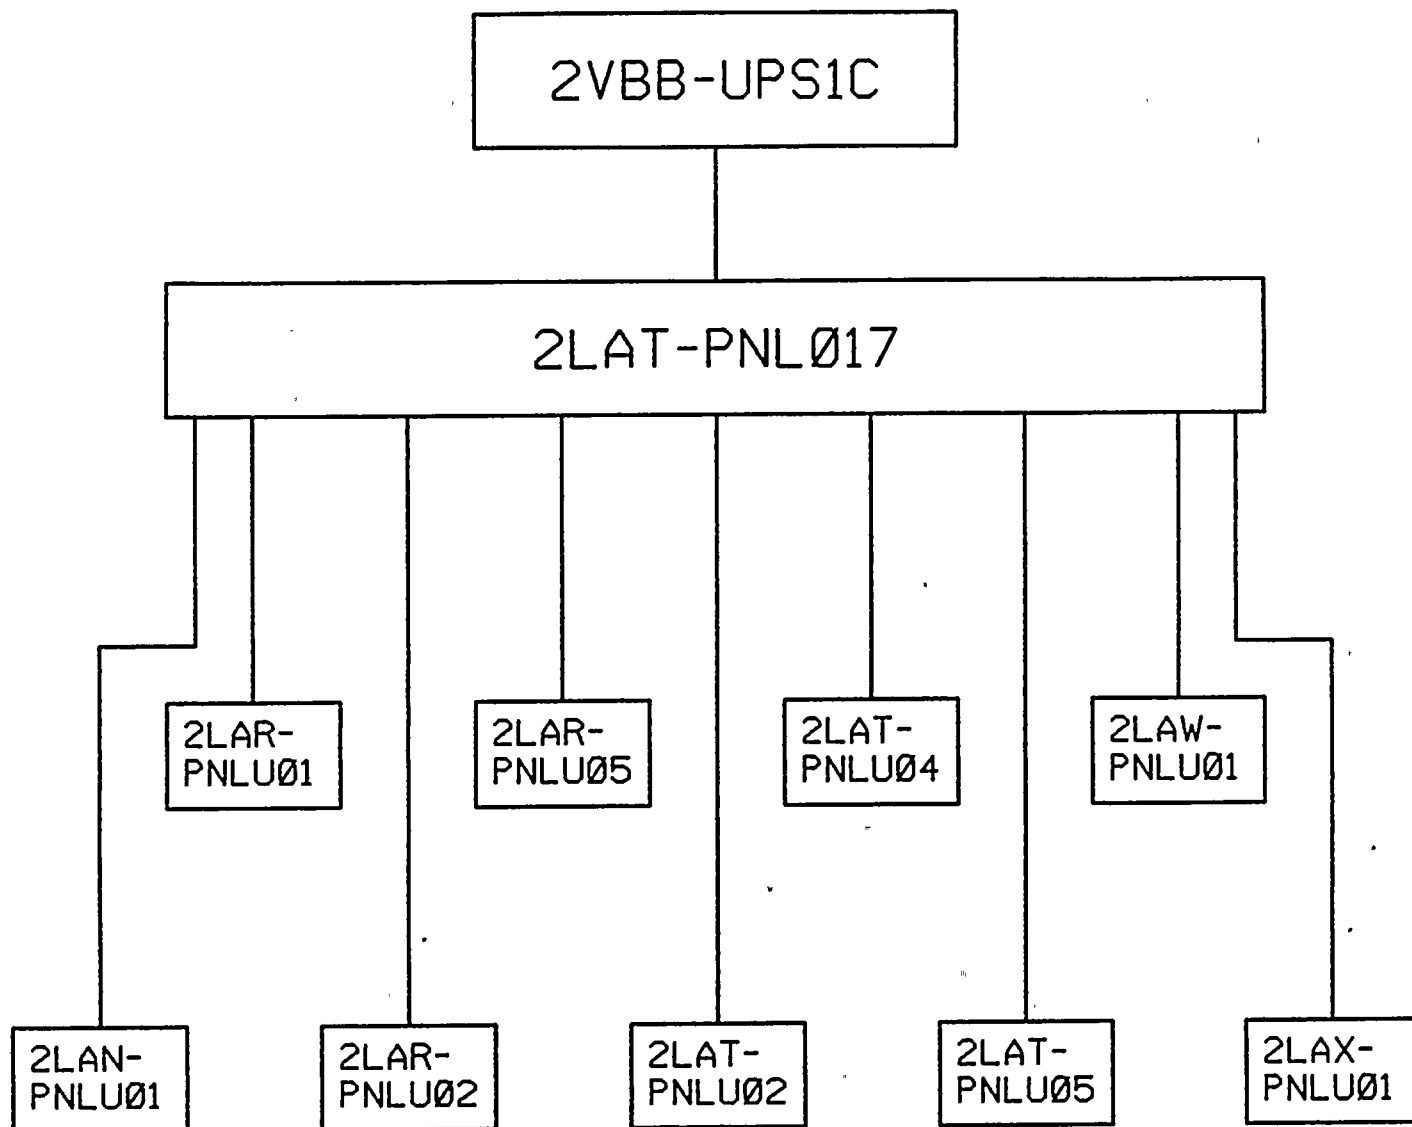

NOTE: THIS DRAWING WAS CREATED USING  
COMPUTER AIDED DRAFTING  
DO NOT MAKE MANUAL CHANGES

NUCLEAR NON-SAFETY RELATED

|               |   |  |
|---------------|---|--|
|               | NINE MILE POINT<br>NUCLEAR STATION - UNIT 2<br>SCRIBA, N.Y. |  |
|               | LOAD LIST<br>UNINTERRUPTIBLE POWER SUPPLY<br>2VBB-UPS1C     |  |
| SHEET 1 OF 33 |   |  |
| SCALE<br>NONE | DRAWING NO<br>AE-100F                                       |  |

|    |         |     |                             |             |     |
|----|---------|-----|-----------------------------|-------------|-----|
| 1  | 9-11-91 | JBP | ORIGINAL ISSUE-<br>AS BUILT | AR          | APP |
| MK | DATE    | BY  | MF                          | DESCRIPTION | CK  |





# INDEX

| PANEL       | BKR. NO. | SHEET NO. |
|-------------|----------|-----------|
| 2LAR-PNLU01 | 1        | 8         |
|             | 2        | 8         |
|             | 3        | 8         |
|             | 4        | 8         |
|             | 5        | 8         |
|             | 6        | 8         |
|             | 7        | 8         |
|             | 8        | 8         |
|             | 9        | 8         |
|             | 10       | 8         |
|             | 11       | 8         |
|             | 12       | 8         |
|             | 13       | 8         |
|             | 14       | 8         |
|             | 15       | 8         |
|             | 16       | 8         |
|             | 17       | 8         |
|             | 18       | 8         |
|             | 19       | 8         |
|             | 21       | 8         |
|             | 20       | 8         |
|             | 22       | 8         |
|             | 23       | 9         |
|             | 25       | 9         |
|             | 24       | 9         |
|             | 26       | 9         |
|             | 27       | 9         |
|             | 29       | 9         |
|             | 28       | 9         |
|             | 30       | 9         |
|             | 31       | 9         |
|             | 33       | 9         |
|             | 32       | 9         |
|             | 34       | 9         |
|             | 35       | 9         |
|             | 37       | 9         |
|             | 36       | 9         |
|             | 38       | 9         |

| PANEL       | BKR. NO. | SHEET NO. |
|-------------|----------|-----------|
| 2LAR-PNLU01 | 39       | 9         |
|             | 41       | 9         |
|             | 40       | 9         |
| 2LAR-PNLU01 | 42       | 9         |
|             |          |           |
|             |          |           |
| 2LAR-PNLU05 | 1        | 10        |
|             | 2        | 10        |
|             | 4        | 10        |
|             | 3        | 10        |
|             | 5        | 10        |
|             | 6        | 10        |
|             | 7        | 10        |
|             | 9        | 10        |
|             | 8        | 10        |
|             | 10       | 10        |
|             | 11       | 10        |
|             | 12       | 11        |
|             | 14       | 11        |
|             | 13       | 11        |
|             | 15       | 11        |
|             | 16       | 11        |
|             | 17       | 11        |
|             | 18       | 11        |
|             | 19       | 11        |
|             | 20       | 11        |
|             | 21       | 11        |
|             | 22       | 11        |
|             | 23       | 11        |
|             | 25       | 11        |
|             | 24       | 11        |
|             | 26       | 11        |
|             | 27       | 11        |
|             | 29       | 11        |

(CONTINUED ON SHEET 3)

2VBB-UPS1C LOAD LIST  
DWG. NO. AE-100F  
SHEET 2 OF 33



# INDEX

| PANEL                       | BKR. NO. | SHEET NO. |
|-----------------------------|----------|-----------|
| 2LAR-PNLU05<br><div>↓</div> | 28       | 11        |
|                             | 30       |           |
|                             | 31       | 11        |
|                             | 33       |           |
|                             | 32       | 12        |
|                             | 34       |           |
|                             | 35       | 12        |
|                             | 37       |           |
| 36                          | 12       |           |
| 38                          |          |           |
| 39                          | 12       |           |
| 41                          |          |           |
| 40                          | 12       |           |
| 42                          |          |           |
| 2LAR-PNLU05                 |          |           |
|                             |          |           |
| 2LAT-PNLU04<br><div>↓</div> | 1        | 13        |
|                             | 2        | 13        |
|                             | 3        | 13        |
|                             | 4        | 13        |
|                             | 5        | 13        |
|                             | 6        | 13        |
|                             | 7        | 13        |
|                             | 8        | 13        |
|                             | 9        | 13        |
|                             | 10       | 13        |
|                             | 11       | 13        |
|                             | 12       | 13        |
|                             | 13       | 13        |
|                             | 14       | 13        |
|                             | 15       | 13        |
|                             | 16       | 13        |
|                             | 17       | 13        |
|                             | 18       | 13        |
|                             | 19       | 14        |
|                             | 20       | 14        |
|                             | 21       | 14        |
|                             | 22       | 14        |
|                             | 23       | 14        |
| 2LAT-PNLU04                 |          |           |

| PANEL                       | BKR. NO. | SHEET NO. |
|-----------------------------|----------|-----------|
| 2LAT-PNLU04<br><div>↓</div> | 24       | 14        |
|                             | 25       | 14        |
|                             | 26       | 14        |
|                             | 27       | 14        |
|                             | 28       | 14        |
|                             | 29       | 14        |
|                             | 30       | 14        |
|                             | 31       | 14        |
|                             | 32       | 14        |
|                             | 33       | 14        |
|                             | 34       | 14        |
|                             | 35       | 15        |
|                             | 36       | 15        |
|                             | 38       |           |
|                             | 37       | 15        |
|                             | 39       | 15        |
|                             | 41       |           |
|                             | 40       | 15        |
|                             | 42       |           |
|                             |          |           |
| 2LAW-PNLU01<br><div>↓</div> | 1        | 16        |
|                             | 3        |           |
|                             | 2        | 16        |
|                             | 4        |           |
|                             | 5        | 16        |
|                             | 7        |           |
|                             | 6        | 16        |
|                             | 8        |           |
|                             | 9        | 16        |
|                             | 11       |           |
|                             | 10       | 16        |
|                             | 12       |           |
|                             |          |           |
| 2LAW-PNLU01                 |          |           |

(CONTINUED ON SHEET 4)

2VBB-UPS1C LOAD LIST  
DWG. NO. AE-100F  
SHEET 3 OF 33



# INDEX

| PANEL                       | BKR. NO.    | SHEET NO. |
|-----------------------------|-------------|-----------|
| 2LAW-PNLU01<br><div>↓</div> | 13          | 16        |
|                             | 15          |           |
|                             | 14          | 16        |
|                             | 16          |           |
|                             | 17          | 16        |
|                             | 19          |           |
|                             | 18          | 16        |
|                             | 20          |           |
|                             | 21          | 16        |
|                             | 23          |           |
|                             | 22          | 16        |
|                             | 24          |           |
|                             | 25          | 17        |
|                             | 27          |           |
|                             | 26          | 17        |
|                             | 28          |           |
|                             | 29          | 17        |
|                             | 31          |           |
|                             | 30          | 17        |
|                             | 32          | 17        |
|                             | 33          | 17        |
|                             | 34          | 17        |
|                             | 35          | 17        |
|                             | 36          | 17        |
|                             | 37          | 17        |
| 38                          | 17          |           |
| 39                          | 17          |           |
| 40                          | 17          |           |
| 41                          | 17          |           |
| 2LAW-PNLU01                 | 42          | 17        |
|                             |             |           |
| 2LAN-PNLU01<br><div>↓</div> | 1           | 18        |
|                             | 2           | 18        |
|                             | 3           | 18        |
|                             | 4           | 18        |
|                             | 5           | 18        |
|                             | 6           | 18        |
|                             | 2LAN-PNLU01 | 7         |

| PANEL            | BKR. NO. | SHEET NO. |
|------------------|----------|-----------|
| 2LAN-PNLU01<br>↓ | 8        | 18        |
|                  | 9        | 18        |
|                  | 10       | 18        |
|                  | 11       | 18        |
|                  | 12       | 19        |
|                  | 13       | 19        |
|                  | 14       | 19        |
|                  | 15       | 19        |
|                  | 16       | 19        |
|                  | 17       | 19        |
|                  | 18       | 19        |
|                  | 19       | 19        |
|                  | 21       |           |
|                  | 20       | 19        |
|                  | 22       | 19        |
|                  | 23       | 19        |
|                  | 25       |           |
|                  | 24       | 19        |
|                  | 26       | 19        |
|                  | 27       | 20        |
|                  | 28       | 20        |
|                  | 29       | 20        |
|                  | 30       | 20        |
|                  | 31       | 20        |
|                  | 33       |           |
|                  | 35       | 20        |
|                  | 32       |           |
|                  | 34       | 20        |
|                  | 36       | 20        |
|                  | 37       | 20        |
|                  | 38       | 20        |
|                  | 39       | 20        |
|                  | 40       | 20        |

(CONTINUED ON SHEET 5)

2VBB-UPS1C LOAD LIST  
DWG. NO. AE-100F  
SHEET 4 OF 33



# INDEX

| PANEL       | BKR. NO. | SHEET NO. |
|-------------|----------|-----------|
| 2LAN-PNLU01 | 41       | 20        |
| 2LAN-PNLU01 | 42       | 20        |
|             |          |           |
| 2LAR-PNLU02 | 1        | 21        |
|             | 2        | 21        |
|             | 3        | 21        |
|             | 4        | 21        |
|             | 5        | 21        |
|             | 6        | 21        |
|             | 7        | 21        |
|             | 8        | 21        |
|             | 9        | 21        |
|             | 10       | 21        |
|             | 11       | 21        |
|             | 13       | 21        |
|             | 12       | 21        |
|             | 14       | 22        |
|             | 15       | 22        |
|             | 16       | 22        |
|             | 17       | 22        |
|             | 18       | 22        |
|             | 19       | 22        |
|             | 20       | 22        |
|             | 21       | 22        |
|             | 22       | 22        |
|             | 23       | 22        |
|             | 25       | 22        |
|             | 24       | 22        |
|             | 26       | 22        |
|             | 27       | 22        |
|             | 29       | 22        |
|             | 28       | 22        |
|             | 30       | 22        |
|             | 31       | 22        |
|             | 33       | 22        |
|             | 32       | 22        |
|             | 34       | 22        |

| PANEL       | BKR. NO. | SHEET NO. |
|-------------|----------|-----------|
| 2LAR-PNLU02 | 35       | 22        |
|             | 37       | 22        |
|             | 36       | 23        |
|             | 38       | 23        |
|             | 39       | 23        |
|             | 41       | 23        |
|             | 40       | 23        |
|             | 42       | 23        |
|             |          |           |
| 2LAT-PNLU02 | 1        | 24        |
|             | 3        | 24        |
|             | 2        | 24        |
|             | 4        | 24        |
|             | 5        | 24        |
|             | 7        | 24        |
|             | 6        | 24        |
|             | 8        | 24        |
|             | 9        | 24        |
|             | 11       | 24        |
|             | 10       | 24        |
|             | 12       | 24        |
|             | 13       | 24        |
|             | 15       | 24        |
|             | 14       | 24        |
|             | 16       | 24        |
|             | 17       | 25        |
|             | 19       | 25        |
|             | 18       | 25        |
|             | 20       | 25        |
|             | 21       | 25        |
|             | 23       | 25        |
|             | 22       | 25        |
|             | 24       | 25        |

(CONTINUED ON SHEET 6)

2VBB-UPS1C LOAD LIST  
DWG. NO. AE-100F  
SHEET 5 OF 33





# INDEX

| PANEL            | BKR. NO. | SHEET NO. |
|------------------|----------|-----------|
| 2LAT-PNLU02<br>↓ | 25       | 25        |
|                  | 27       |           |
|                  | 26       | 25        |
|                  | 28       |           |
|                  | 29       | 25        |
|                  | 31       |           |
|                  | 30       | 25        |
|                  | 32       |           |
|                  | 33       | 25        |
|                  | 34       | 25        |
|                  | 35       | 25        |
|                  | 36       | 25        |
|                  | 37       | 25        |
|                  | 38       | 25        |
|                  | 39       | 25        |
|                  | 40       | 25        |
|                  | 41       | 26        |
|                  | 42       | 26        |
|                  |          |           |
| 2LAT-PNLU05<br>↓ | 1        | 27        |
|                  | 2        | 27        |
|                  | 3        | 27        |
|                  | 4        | 27        |
|                  | 5        | 27        |
|                  | 6        | 27        |
|                  | 7        | 27        |
|                  | 8        | 27        |
|                  | 9        | 27        |
|                  | 10       | 27        |
|                  | 12       |           |
|                  | 11       | 27        |
|                  | 13       |           |
|                  | 14       | 27        |
|                  | 16       |           |
|                  | 15       | 27        |
|                  | 17       |           |
|                  | 18       | 27        |
|                  | 19       | 27        |

| PANEL  | BKR. NO. | SHEET NO. |
|--|----------|-----------|
| PANEL       | BKR. NO. | SHEET NO.                       |
|-------------|----------|---------------------------------|
| 2LAR-PNLU01 | N/A      | FOR<br>NOTES<br>SEE<br>SHEET 33 |
| 2LAR-PNLU05 | N/A      |                                 |
| 2LAT-PNLU04 | N/A      |                                 |
| 2LAW-PNLU01 | N/A      |                                 |
| 2LAN-PNLU01 | N/A      |                                 |
| 2LAR-PNLU02 | N/A      |                                 |
| 2LAT-PNLU02 | N/A      |                                 |
| 2LAT-PNLU05 | N/A      |                                 |
| 2LAX-PNLU01 | N/A      |                                 |

2VBB-UPS1C LOAD LIST  
DWG. NO. AE-100F  
SHEET 7 OF 33



UPS NO: 2VBB-UPS1C  
 PNL NO: 2LAT-PNL017  
 DIST PNL NO: 2LAR-PNLU01  
 CIRCUIT NO: N/A

DRAWING REFERENCES

CE-100K

| FEED TO DEVICE             | BKR NO.  | LTG. DWG.                      | <u>DEVICE LOCATION</u> |           | PLANT IMPACT<br>OTHER LIGHTING<br>COVERAGE AS<br>INDICATED |
|----------------------------|----------|--------------------------------|------------------------|-----------|--|
|                            |          |                                | BUILDING               | ELEVATION |  |
| ESSENTIAL LIGHTING         | 1        | EE-67C                         | RX BLDG E              | 215       | NORMAL   |
| ESSENTIAL LIGHTING         | 2        | EE-67A                         | RX BLDG. NE            | 175       | NORMAL   |
| ESSENTIAL LIGHTING         | 3        | EE-67C                         | RX BLDG. NW            | 215       | NORMAL   |
| ESSENTIAL LIGHTING         | 4        | EE-67A                         | RX BLDG. SE            | 175       | NORMAL   |
| ESSENTIAL LIGHTING         | 5        | EE-67C                         | RX BLDG. NE            | 196       | NORMAL   |
| ESSENTIAL LIGHTING         | 6        | EE-67B                         | RX BLDG. E             | 196       | NORMAL   |
| ESSENTIAL LIGHTING         | 7        | EE-67B                         | RX BLDG.               | 215       | NORMAL   |
| RECEPTACLES                | 8        | EE-67C                         | RX BLDG                | 215       | LOSE<br>RECEPTACLES  |
| SPARE                      | 9        |                                |                        |           |  |
| EXIT LIGHT                 | 10       | EE-67A                         | RX BLDG                | 175       | LOSE EXIT LIGHT  |
| EXIT LIGHT                 | 11       | EE-67B                         | RX BLDG                | 196       | LOSE EXIT LIGHT  |
| EXIT LIGHT                 | 12       | EE-67C                         | RX BLDG                | 215       | LOSE EXIT LIGHT  |
| EXIT LIGHT                 | 13       | EE-67D                         | RX BLDG                | 240       | LOSE EXIT LIGHT  |
| COMMUNICATION<br>EQUIPMENT | 14       | EE-<br>80K, L,<br>M, AB,<br>AC | RX BLDG &<br>EL TUNNEL | VARIOUS   | LOSE<br>COMMUNICATION<br>SEE NOTE 1 & 2,<br>SHEET 33       |
| COMMUNICATION<br>EQUIPMENT | 15       | EE-80M                         | RX BLDG                | 215       | LOSE<br>COMMUNICATION<br>SEE NOTE 1 & 2,<br>SHEET 33       |
| SPARE                      | 16       |                                |                        |           |  |
| SPARE                      | 17       |                                |                        |           |  |
| SPARE                      | 18       |                                |                        |           |  |
| ESSENTIAL LIGHTING         | 19<br>21 | EE-67D                         | RX BLDG                | 240       | NORMAL LIGHTING  |
| ESSENTIAL LIGHTING         | 20<br>22 | EE-67A                         | RX BLDG                | 175       | NORMAL   |

UP850

September 11, 1991

2VBB-UPS1C LOAD LIST  
 DWG. NO. AE-100F  
 SHEET 8 OF 33

1. 2. 3. 4. 5. 6. 7. 8. 9. 10.

11. 12. 13. 14. 15. 16. 17. 18. 19. 20.

UPS NO: 2VBB-UPS1C  
 PNL NO: 2LAT-PNL017  
 DIST PNL NO: 2LAR-PNLU01  
 CIRCUIT NO: N/A

DRAWING REFERENCES

CE-100K

| FEED TO DEVICE     | BKR<br>NO. | LTG.<br>DWG.     | <u>DEVICE LOCATION</u> |            | PLANT IMPACT<br>OTHER LIGHTING<br>COVERAGE AS<br>INDICATED |
|--------------------|------------|------------------|------------------------|------------|--|
|                    |            |                  | BUILDING               | ELEVATION  |  |
| ESSENTIAL LIGHTING | 23<br>25   | EE-67D<br>EE-67E | RX BLDG.               | 240<br>261 | NORMAL<br>NORMAL   |
| ESSENTIAL LIGHTING | 24<br>26   | EE-67A           | RX BLDG.               | 175        | NORMAL   |
| SPARE              | 27<br>29   |                  |                        |            |  |
| ESSENTIAL LIGHTING | 28<br>30   | EE-67B           | RX BLDG.               | 196        | NORMAL   |
| ESSENTIAL LIGHTING | 31<br>33   | EE-67B           | RX BLDG                | 196        | NORMAL   |
| ESSENTIAL LIGHTING | 32<br>34   | EE-67C           | RX BLDG                | 215        | NORMAL   |
| SPARE              | 35<br>37   |                  |                        |            |  |
| ESSENTIAL LIGHTING | 36<br>38   | EE-67C           | RX BLDG                | 215        | NORMAL   |
| SPARE              | 39<br>41   |                  |                        |            |  |
| SPARE              | 40<br>42   |                  |                        |            |  |
|                    |            |                  |                        |            |  |
|                    |            |                  |                        |            |  |
UPS50

September 8, 1991

2VBB-UPS1C LOAD LIST  
 DWG. NO. AE-100F  
 SHEET 9 OF 33





UPS NO: 2VBB-UPS1C  
 PNL NO: 2LAT-PNL017  
 DIST PNL NO: 2LAR-PNLU05  
 CIRCUIT NO: N/A

DRAWING REFERENCES

CE-100P

| FEED TO DEVICE     | BKR<br>NO. | LTG.<br>DWG.  | DEVICE LOCATION<br>BUILDING ELEVATION |         | PLANT IMPACT<br>OTHER LIGHTING<br>COVERAGE AS<br>INDICATED |
|--------------------|------------|---------------|---------------------------------------|---------|--|
| EXIT LIGHTS        | 1          | EE-67K        | NORTH<br>AUX. BAY                     | 175     | LOSE EXIT<br>LIGHTS  |
| ESSENTIAL LIGHTING | 2<br>4     | EE-67K        | NORTH<br>AUX. BAY                     | 175     | NORMAL LIGHTING  |
| ESSENTIAL LIGHTING | 3          | EE-<br>67K, L | NORTH<br>AUX. BAY<br>STAIRWELL        | VARIOUS | NO OTHER<br>LIGHTING                                       |
| ESSENTIAL LIGHTING | 5          | EE-<br>67K, L | NORTH AUX.<br>BAY<br>STAIRWELL        | VARIOUS | NO OTHER<br>LIGHTING                                       |
| EXIT LIGHTS        | 6          | EE-67K        | NORTH AUX.<br>BAY<br>STAIRWELL        | 198     | LOSE EXIT<br>LIGHTS  |
| ESSENTIAL LIGHTING | 7<br>9     | EE-67K        | NORTH AUX.<br>BAY                     | 198     | NO OTHER<br>LIGHTING                                       |
| ESSENTIAL LIGHTING | 8<br>10    | EE-67L        | NORTH AUX.<br>BAY                     | 215     | NORMAL   |
| ESSENTIAL LIGHTING | 11         | EE-67L        | NORTH AUX.<br>BAY                     | 250     | NORMAL   |

UP850

September 11, 1991

2VBB-UPS1C LOAD LIST  
 DWG. NO. AE-100F  
 SHEET 10 OF 33












UPS NO: 2VBB-UPS1C  
 PNL NO: 2LAT-PNL017  
 DIST PNL NO: 2LAR-PNLU05  
 CIRCUIT NO: N/A

DRAWING REFERENCES

CE-100P

| FEED TO DEVICE             | BKR NO.  | LTG. DWG.          | DEVICE LOCATION<br>BUILDING ELEVATION |            | PLANT IMPACT<br>OTHER LIGHTING<br>COVERAGE AS<br>INDICATED |
|----------------------------|----------|--------------------|---------------------------------------|------------|--|
| ESSENTIAL LIGHTING         | 12<br>14 | EE-67L             | NORTH<br>AUX. BAY                     | 240        | NORMAL   |
| EXIT LIGHTS                | 13       | EE-67L             | NORTH<br>AUX. BAY                     | 215<br>240 | LOSE EXIT<br>LIGHTS  |
| SPARE                      | 15       |                    |                                       |            |  |
| SPARE                      | 16       |                    |                                       |            |  |
| SPARE                      | 17       |                    |                                       |            |  |
| SPARE                      | 18       |                    |                                       |            |  |
| COMMUNICATION<br>EQUIPMENT | 19       | EE-<br>80N,U,<br>V | RX BLDG. N.<br>AUX BAY                | VARIOUS    | LOSE<br>COMMUNICATION<br>SEE NOTE 1 & 2,<br>SHEET 33       |
| SPARE                      | 20       |                    |                                       |            |  |
| SPARE                      | 21       |                    |                                       |            |  |
| SPARE                      | 22       |                    |                                       |            |  |
| SPARE                      | 23<br>25 |                    |                                       |            |  |
| SPARE                      | 24<br>26 |                    |                                       |            |  |
| SPARE                      | 27<br>29 |                    |                                       |            |  |
| SPARE                      | 28<br>30 |                    |                                       |            |  |
| SPARE                      | 31<br>33 |                    |                                       |            |  |

UP850

September 11, 1991

2VBB-UPS1C LOAD LIST  
 DWG. NO. AE-100F  
 SHEET 11 OF 33


























UPS NO: 2VBB-UPS1C  
 PNL NO: 2LAT-PNL017  
 DIST PNL NO: 2LAR-PNLU05  
 CIRCUIT NO: N/A

DRAWING REFERENCES

CE-100P

| FEED TO DEVICE | BKR<br>NO. | LTG.<br>DWG. | DEVICE LOCATION<br>BUILDING ELEVATION |  | PLANT IMPACT<br>OTHER LIGHTING<br>COVERAGE AS<br>INDICATED |
|----------------|------------|--------------|---------------------------------------|--|--|
| SPARE          | 32<br>34   |              |                                       |  |  |
| SPARE          | 35<br>37   |              |                                       |  |  |
| SPARE          | 36<br>38   |              |                                       |  |  |
| SPARE          | 39<br>41   |              |                                       |  |  |
| SPARE          | 40<br>42   |              |                                       |  |  |
|                |            |              |                                       |  |  |
|                |            |              |                                       |  |  |
UPS50

September 8, 1991

2VBB-UPS1C LOAD LIST  
 DWG. NO. AE-100F  
 SHEET 12 OF 33
















UPS NO: 2VBB-UPS1C  
 PNL NO: 2LAT-PNL017  
 DIST PNL NO: 2LAT-PNLU04  
 CIRCUIT NO: N/A

DRAWING REFERENCES

CE-100H

| FEED TO DEVICE     | BKR NO. | LTG. DWG.      | DEVICE LOCATION       |            | PLANT IMPACT<br>OTHER LIGHTING<br>COVERAGE AS<br>INDICATED |
|--------------------|---------|----------------|-----------------------|------------|--|
|                    |         |                | BLDG                  | ELEV       |  |
| ESSENTIAL LIGHTING | 1       | EE-78E         | PIPE TUNNEL           | N/A        | NORMAL LIGHTING  |
| ESSENTIAL LIGHTING | 2       | EE-78B,<br>78F | PIPE TUNNEL           | N/A        | NORMAL LIGHTING  |
| ESSENTIAL LIGHTING | 3       | EE-78E         | PIPE TUNNEL           | N/A        | NORMAL LIGHTING  |
| EXIT SIGNS         | 4       | EE-78B,<br>78F | PIPE TUNNEL           | N/A        | LOSE EXIT LIGHTS   |
| SPARE              | 5       |                |                       |            |  |
| ESSENTIAL LIGHTS   | 6       | EE-78F         | PIPE TUNNEL           | N/A        | NORMAL LIGHTING  |
| ESSENTIAL LIGHTS   | 7       | EE-66H         | TB. CLEAN ACCESS AREA | VARIOUS    | NORMAL LIGHTING  |
| ESSENTIAL LIGHTS   | 8       | EE-78F         | PIPE TUNNEL           | N/A        | NORMAL LIGHTING  |
| ESSENTIAL LIGHTS   | 9       | EE-66H         | TB. CLEAN ACCESS AREA | VARIOUS    | NORMAL LIGHTING  |
| ESSENTIAL LIGHTS   | 10      | EE-78F         | PIPE TUNNEL           | N/A        | NORMAL LIGHTING  |
| ESSENTIAL LIGHTS   | 11      | EE-66H         | TB. CLEAN ACCESS AREA | 288        | NO OTHER LIGHTING  |
| ESSENTIAL LIGHTS   | 12      | EE-78F         | PIPE TUNNEL           | N/A        | NORMAL LIGHTING  |
| ESSENTIAL LIGHTS   | 13      | EE-66H         | TB. CLEAN ACCESS AREA | 250<br>261 | NO OTHER LIGHTING  |
| EXIT LIGHTS        | 14      | EE-78F         | PIPE TUNNEL           | N/A        | LOSE EXIT LIGHTS   |
| EXIT LIGHTS        | 15      | EE-66H         | TB. CLEAN ACCESS AREA | N/A        | LOSE EXIT LIGHTS   |
| SPARE              | 16      |                |                       |            |  |
| ESSENTIAL LIGHTS   | 17      | EE-67P         | AUX BLDG SOUTH        | 261        | NORMAL LIGHTING  |
| SPARE              | 18      |                |                       |            |  |

UP850

September 11, 1991

2VBB-UPS1C LOAD LIST  
 DWG. NO. AE-100F  
 SHEET 13 OF 33

28  
29  
UPS NO: 2VBB-UPS1C  
 PNL NO: 2LAT-PNL017  
 DIST PNL NO: 2LAT-PNLU04  
 CIRCUIT NO: N/A

DRAWING REFERENCES

CE-100H

| FEED TO DEVICE             | BKR NO. | LTG. DWG.          | <u>DEVICE LOCATION</u> |      | PLANT IMPACT<br>OTHER LIGHTING<br>COVERAGE AS<br>INDICATED |
|----------------------------|---------|--------------------|------------------------|------|--|
|                            |         |                    | BLDG                   | ELEV |  |
| ESSENTIAL LIGHTS           | 19      | EE-67P             | AUX BLDG<br>SOUTH      | 261  | NORMAL LIGHTING  |
| COMMUNICATION<br>EQUIPMENT | 20      | EE-<br>80D,<br>80E | TURB BLDG              | 250  | LOSE<br>COMMUNICATION<br>SEE NOTE 1 & 2,<br>SHEET 33       |
| EXIT LIGHTS                | 21      | EE-67P             | AUX BLDG<br>SOUTH      | 261  | LOSE EXIT<br>LIGHTS  |
| SPARE                      | 22      |                    |                        |      |  |
| SPARE                      | 23      |                    |                        |      |  |
| SPARE                      | 24      |                    |                        |      |  |
| SPARE                      | 25      |                    |                        |      |  |
| SPARE                      | 26      |                    |                        |      |  |
| SPARE                      | 27      |                    |                        |      |  |
| SPARE                      | 28      |                    |                        |      |  |
| SPARE                      | 29      |                    |                        |      |  |
| SPARE                      | 30      |                    |                        |      |  |
| SPARE                      | 31      |                    |                        |      |  |
| SPARE                      | 32      |                    |                        |      |  |
| SPARE                      | 33      |                    |                        |      |  |
| SPARE                      | 34      |                    |                        |      |  |

UPS50

September 11, 1991

2VBB-UPS1C LOAD LIST  
 DWG. NO. AE-100F  
 SHEET 14 OF 33

1

2

3  
4

5

6

7

8

9

10

## DRAWING REFERENCES

**CE-100H**

[illegible]

**UP850**

September 8, 1991

2VBB-UPS1C LOAD LIST  
DWG. NO. AE-100F  
SHEET 15 OF 33



UPS NO: 2VBB-UPS1C  
 PNL NO: 2LAT-PNL017  
 DIST PNL NO: 2LAW-PNLU01  
 CIRCUIT NO: N/A

DRAWING REFERENCES

CE-1008

| FEED TO DEVICE     | BKR<br>NO | LTG<br>DWG | <u>DEVICE LOCATION</u> |       | PLANT IMPACT<br>(OTHER<br>LIGHTING<br>COVERAGE AS<br>INDICATED) |
|--------------------|-----------|------------|------------------------|-------|---|
|                    |           |            | BLDG.                  | ELEV. |   |
| ESSENTIAL LIGHTING | 1<br>3    | EE-72A, B  | SCREENWELL             | NA    | NORMAL<br>LIGHTING  |
| ESSENTIAL LIGHTING | 2<br>4    | EE-72A, B  | SCREENWELL             | NA    | NORMAL<br>LIGHTING  |
| ESSENTIAL LIGHTING | 5<br>7    | EE-72A, B  | SCREENWELL             | NA    | NORMAL<br>LIGHTING  |
| ESSENTIAL LIGHTING | 6<br>8    | EE-72A, B  | SCREENWELL             | NA    | NORMAL<br>LIGHTING  |
| ESSENTIAL LIGHTING | 9<br>11   | EE-72C     | SCREENWELL             | NA    | NORMAL<br>LIGHTING  |
| ESSENTIAL LIGHTING | 10<br>12  | EE-72C     | SCREENWELL             | NA    | NORMAL<br>LIGHTING  |
| ESSENTIAL LIGHTING | 13<br>15  | EE-72A     | SCREENWELL             | NA    | NORMAL<br>LIGHTING  |
| SPARE              | 14<br>16  |            |                        |       |   |
| SPARE              | 17<br>19  |            |                        |       |   |
| SPARE              | 18<br>20  |            |                        |       |   |
| SPARE              | 21<br>23  |            |                        |       |   |
| SPARE              | 22<br>24  |            |                        |       |   |

UPS50

September 8, 1991

2VBB-UPS1C LOAD LIST  
 DWG. NO. AE-100F  
 SHEET 16 OF 33



UPS NO: 2VBB-UPS1C  
 PNL NO: 2LAT-PNL017  
 DIST PNL NO: 2LAW-PNLU01  
 CIRCUIT NO: N/A

DRAWING REFERENCES

CE-1008

| FEED TO DEVICE             | BKR<br>NO. | LTG.<br>DWG.                     | <u>DEVICE LOCATION</u> |       | PLANT IMPACT<br>OTHER<br>LIGHTING<br>COVERAGE AS<br>INDICATED |
|----------------------------|------------|----------------------------------|------------------------|-------|---|
|                            |            |                                  | BLDG.                  | ELEV. |   |
| SPARE                      | 25<br>27   |                                  |                        |       |   |
| SPARE                      | 26<br>28   |                                  |                        |       |   |
| SPARE                      | 29<br>31   |                                  |                        |       |   |
| EXIT LIGHT                 | 30         | EE-72B                           | SCREENWELL             | NA    | LOSE EXIT<br>LIGHTS   |
| EXIT LIGHT                 | 32         | EE-72A                           | SCREENWELL             | NA    | LOSE EXIT<br>LIGHTS   |
| SPARE                      | 33         |                                  |                        |       |   |
| SPARE                      | 34         |                                  |                        |       |   |
| ESSENTIAL LIGHTING         | 35         | EE-72A, B                        | SCREENWELL             | NA    | NORMAL<br>LIGHTING  |
| COMMUNICATION<br>EQUIPMENT | 36         | EE-80Z,<br>AD, AE,<br>AF, AG, AQ | SA, ASB<br>HB          | VAR   | LOSE<br>COMMUNICATION<br>SEE NOTE 1 &<br>2, SHEET 33          |
| SPARE                      | 37         |                                  |                        |       |   |
| SPARE                      | 38         |                                  |                        |       |   |
| SPARE                      | 39         |                                  |                        |       |   |
| SPARE                      | 40         |                                  |                        |       |   |
| SPARE                      | 41         |                                  |                        |       |   |
| SPARE                      | 42         |                                  |                        |       |   |

UP850

September 8, 1991

2VBB-UPS1C LOAD LIST  
 DWG. NO. AE-100F  
 SHEET 17 OF 33





UPS NO: 2VBB-UPS1C  
 PNL NO: 2LAT-PNL017  
 DIST PNL NO: 2LAN-PNLU01  
 CIRCUIT NO: N/A

DRAWING REFERENCES  
 CE-100R

| FEED TO DEVICE     | BKR NO. | LTG. DWG.    | DEVICE LOCATION |         | PLANT IMPACT<br>(OTHER LIGHTING COVERAGE AS INDICATED) |
|--------------------|---------|--------------|-----------------|---------|--|
|                    |         |              | BLDG.           | ELEV.   |  |
| ESSENTIAL LIGHTING | 1       | EE-69A       | RADWASTE        | 240     | NORMAL LIGHTING  |
| ESSENTIAL LIGHTING | 2       | EE-69A       | RADWASTE        | 261     | NORMAL LIGHTING  |
| EXIT LIGHTS        | 3       | EE-69A       | RADWASTE        | 240     | LOSE EXIT LIGHTS                                       |
| ESSENTIAL LIGHTING | 4       | EE-69A, B, C | RADWASTE STAIRS | VARIOUS | NO OTHER LIGHTING                                      |
| EXIT LIGHTS        | 5       | EE-69A       | RADWASTE        | 261     | LOSE EXIT LIGHTS                                       |
| ESSENTIAL LIGHTING | 6       | EE-69A, B, C | RADWASTE STAIRS | VARIOUS | NO OTHER LIGHTING                                      |
| ESSENTIAL LIGHTING | 7       | EE-69A       | RADWASTE        | 240     | NORMAL   |
| ESSENTIAL LIGHTING | 8       | EE-69A       | RADWASTE        | 261     | NORMAL LIGHTING  |
| ESSENTIAL LIGHTING | 9       | EE-69A       | RADWASTE        | 240     | NORMAL LIGHTING  |
| SPARE              | 10      |              |                 |         |  |
| ESSENTIAL LIGHTING | 11      | EE-69A       | RADWASTE        | 261     | NORMAL LIGHTING  |



UPS NO: 2VBB-UPS1C  
 PNL NO: 2LAT-PNL017  
 DIST PNL NO: 2LAN-PNLU01  
 CIRCUIT NO: N/A

DRAWING REFERENCES  
 CE-100R

| FEED TO DEVICE          | BKR NO.  | LTG. DWG.    | DEVICE LOCATION        |          | PLANT IMPACT<br>(OTHER LIGHTING COVERAGE AS INDICATED) |
|-------------------------|----------|--------------|------------------------|----------|--|
|                         |          |              | BLDG.                  | ELEV.    |  |
| SPARE                   | 12       |              |                        |          |  |
| EXIT LIGHTS             | 13       | EE-69B       | RADWASTE               | 279      | LOSE EXIT LIGHTS                                       |
| SPARE                   | 14       |              |                        |          |  |
| ESSENTIAL LIGHTING      | 15       | EE-69B, C    | RADWASTE               | 279, 287 | NORMAL LIGHTING  |
| COMMUNICATION EQUIPMENT | 16       | EE-80W, AJ   | RADWASTE COND. STORAGE | VAR.     | LOSE COMMUNICATION SEE NOTE 1 & 2, SHEET 33            |
| ESSENTIAL LIGHTING      | 17       | EE-69B, C    | RADWASTE               | 279, 287 | NORMAL LIGHTING  |
| COMMUNICATION EQUIPMENT | 18       | EE-80X, Y    | RADWASTE               | VAR      | LOSE COMMUNICATION SEE NOTE 1 & 2, SHEET 33            |
| ESSENTIAL LIGHTING      | 19<br>21 | EE-69A, B, C | RADWASTE STAIRS        | VAR      | NO OTHER LIGHTING                                      |
| EXIT LIGHTS             | 20       | EE-69B       | RADWASTE               | 291      | LOSE EXIT LIGHTS                                       |
| ESSENTIAL LIGHTING      | 22       | EE-69B       | RADWASTE               | 291      | NORMAL LIGHTING  |
| ESSENTIAL LIGHTING      | 23<br>25 | EE-69A, B, C | RADWASTE & STAIRS      | VAR      | NO OTHER LIGHTING                                      |
| ESSENTIAL LIGHTING      | 24       | EE-69B       | RADWASTE               | 291      | NORMAL LIGHTING  |
| EXIT LIGHTS             | 26       | EE-69C       | RADWASTE               | 309      | LOSE EXIT LIGHTS                                       |

UP850

September 11, 1991

2VBB-UPS1C LOAD LIST  
 DWG. NO. AE-100F  
 SHEET 19 OF 33






































UPS NO: 2VBB-UPS1C  
 PNL NO: 2LAT-PNL017  
 DIST PNL NO: 2LAN-PNLU01  
 CIRCUIT NO: N/A

DRAWING REFERENCES  
 CE-100R

| FEED TO DEVICE                         | BKR NO.        | LTG. DWG. | DEVICE LOCATION   |          | PLANT IMPACT<br>(OTHER LIGHTING COVERAGE AS INDICATED) |
|--|----------------|-----------|-------------------|----------|--|
|  |                |           | BLDG.             | ELEV.    |  |
| ESSENTIAL LIGHTING                     | 27             | EE-69C    | RADWASTE          | 301      | NORMAL LIGHTING  |
| ESSENTIAL LIGHTING                     | 28             | EE-69C    | RADWASTE          | 309, 318 | NORMAL LIGHTING  |
| SPARE                                  | 29             |           |                   |          |  |
| SPARE                                  | 30             |           |                   |          |  |
| OUTSIDE COMMUN. EQUIP. 2COP-PNLU01     | 31<br>33<br>35 | EE-80A    | NA                | NA       | LOSE COMMUNICATION<br>SEE NOTE 1 & 2,<br>SHEET 33      |
| SPARE                                  | 32             |           |                   |          |  |
| AIR CONDITIONERS 2RMS-CAB170; - RAK170 | 34             | EE-3FT    |                   |          | LOSS OF 2RMS-CAB170<br>MAIN STACK                      |
| SPARE                                  | 36             |           |                   |          |  |
| SPARE                                  | 37             |           |                   |          |  |
| ESSENTIAL LIGHTING                     | 38             | EE-80AJ   | COND. STORAGE     | VAR      | NORMAL LIGHTING  |
| CHEMISTRY LAB RECEPTACLES              | 39             | EE-69E    | RADWASTE CONT. RM | 261      | LOSE RECEPTACLES                                       |
| ESSENTIAL LIGHTING                     | 40             | EE-69E    | RADWASTE CONT. RM | 261, 279 | NORMAL LIGHTING  |
| ESSENTIAL LIGHTING                     | 41             | EE-69E    | RADWASTE CONT. RM | 261      | NORMAL LIGHTING  |
| SPARE                                  | 42             |           |                   |          |  |



UPS NO: 2VBB-UPS1C  
 PNL NO: 2LAT-PNL017  
 DIST PNL NO: 2LAR-PNLU02  
 CIRCUIT NO: N/A

DRAWING REFERENCES  
 CE-100L

| FEED TO DEVICE     | BKR NO.  | LTG. DWG.                         | <u>DEVICE LOCATION</u>        |            | PLANT IMPACT<br>OTHER LIGHTING<br>AS INDICATED    |
|--------------------|----------|-----------------------------------|-------------------------------|------------|---|
|                    |          |                                   | BLDG                          | ELEV       |   |
| ESSENTIAL LIGHTING | 1        | EE-67E                            | RX BLDG E                     | 261        | NORMAL LIGHTING                                   |
| EXIT LIGHTS        | 2        | EE-67E                            | RX BLDG W                     | 261        | LOSE EXIT LIGHTS                                  |
| ESSENTIAL LIGHTING | 3        | EE-67E                            | RX BLDG E                     | 261        | NO OTHER LIGHTING                                 |
| ESSENTIAL LIGHTING | 4        | EE-67F                            | RX BLDG S                     | 289        | NORMAL LIGHTING                                   |
| ESSENTIAL LIGHTING | 5        | EE-67E,<br>67F                    | TRACK BAY &<br>RX BLDG        | 261<br>289 | NORMAL LIGHTING                                   |
| ESSENTIAL LIGHTING | 6        | EE-67F                            | TRACK BAY &<br>RX BLDG        | 289        | NORMAL LIGHTING                                   |
| COMMUNICATION      | 7        | EE-80N,<br>P, Q,<br>R, S,<br>T, V | RX BLDG<br>S.AUX BLDG         | VAR        | LOSE COMMUNICATION<br>SEE NOTE 1 & 2,<br>SHEET 33 |
| ESSENTIAL LIGHTING | 8        | EE-67F                            | RX BLDG                       | 289        | NORMAL LIGHTING                                   |
| SPARE              | 9        |                                   |                               |            |   |
| ESSENTIAL LIGHTING | 10       | EE-67F                            | RX BLDG                       | 289        | NORMAL LIGHTING                                   |
| ESSENTIAL LIGHTING | 11<br>13 | EE-67E,<br>F, L                   | RX BLDG &<br>OUT TRACK<br>BAY | NA         | NORMAL LIGHTING                                   |
| ESSENTIAL LIGHTING | 12       | EE-67F                            | PRI CONT                      | 261        | NORMAL LIGHTING                                   |

UP850

September 11, 1991

2VBB-UPS1C LOAD LIST  
 DWG. NO. AE-100F  
 SHEET 21 OF 33

10

11

12

13

14

15

16

17

18

19

20

21



UPS NO: 2VBB-UPS1C  
 PNL NO: 2LAT-PNL017  
 DIST PNL NO: 2LAR-PNLU02  
 CIRCUIT NO: N/A

DRAWING REFERENCES  
 CE-100L

| FEED TO DEVICE     | BKR<br>NO. | LTG.<br>DWG.     | DEVICE LOCATION |            | PLANT IMPACT<br>OTHER LIGHTING<br>AS INDICATED |
|--------------------|------------|------------------|-----------------|------------|--|
|                    |            |                  | BLDG            | ELEV       |  |
| ESSENTIAL LIGHTING | 14         | EE-67D           | PRI CONT        | 249<br>240 | NORMAL LIGHTING                                |
| ESSENTIAL LIGHTING | 15         | EE-67E<br>EE-67F | PRI CONT        | VARIOUS    | NORMAL LIGHTING                                |
| ESSENTIAL LIGHTING | 16         | EE-67F           | PRI CONT        | 289<br>305 | NORMAL LIGHTING                                |
| SPARE              | 17         |                  |                 |            |  |
| SPARE              | 18         |                  |                 |            |  |
| SPARE              | 19         |                  |                 |            |  |
| SPARE              | 20         |                  |                 |            |  |
| SPARE              | 21         |                  |                 |            |  |
| SPARE              | 22         |                  |                 |            |  |
| ESSENTIAL LIGHTING | 23<br>25   | EE-67E           | RX BLDG         | 261        | NORMAL LIGHTING                                |
|                    | 24<br>26   |                  |                 |            |  |
| ESSENTIAL LIGHTING | 27<br>29   | EE-67E           | RX BLDG         | 261        | NORMAL LIGHTING                                |
|                    | 28<br>30   |                  |                 |            |  |
| SPARE              | 31<br>33   |                  |                 |            |  |
| SPARE              | 32<br>34   |                  |                 |            |  |
| SPARE              | 35<br>37   |                  |                 |            |  |

UPS50

September 8, 1991

2VBB-UPS1C LOAD LIST  
 DWG. NO. AE-100F  
 SHEET 22 OF 33



















**DRAWING REFERENCES**  
**CE-100L**

2VBB-UPS1C LOAD LIST  
DWG. NO. AE-100F  
SHEET 23 OF 33



UPS NO: 2VBB-UPS1C  
 PNL NO: 2LAT-PNL017  
 DIST PNL NO: 2LAT-PNLU02  
 CIRCUIT NO: N/A

DRAWING REFERENCES  
 CE-100F

| FEED TO DEVICE     | BKR<br>NO. | LTG.<br>DWG.     | <u>DEVICE LOCATION</u>         |      | PLANT IMPACT<br>OTHER LIGHTING<br>COVERAGE AS<br>INDICATED |
|--------------------|------------|------------------|--------------------------------|------|--|
|                    |            |                  | BLDG                           | ELEV |  |
| ESSENTIAL LIGHTING | 1<br>3     | EE-66C           | TURB MEZZ                      | 277  | NORMAL LIGHTING  |
| ESSENTIAL LIGHTING | 2<br>4     | EE-66D           | TURB MEZZ                      | 277  | NORMAL LIGHTING  |
| ESSENTIAL LIGHTING | 5<br>7     | EE-66C           | TURB MEZZ                      | 277  | NORMAL LIGHTING  |
| SPARE              | 6<br>8     |                  |                                |      |  |
| ESSENTIAL LIGHTING | 9<br>11    | EE-66C           | TURB MEZZ<br>FL AIR<br>EJECTOR | 277  | NORMAL LIGHTING  |
| ESSENTIAL LIGHTING | 10<br>12   | EE-66D           | TURB MEZZ                      | 277  | NORMAL LIGHTING  |
| ESSENTIAL LIGHTING | 13<br>15   | EE-66A<br>EE-66C | TURB STAIRS<br>SE              | NA   | NORMAL LIGHTING<br>NORMAL FROM EL<br>250                   |
| ESSENTIAL LIGHTING | 14<br>16   | EE-66D           | TURB MEZZ                      | 277  | NORMAL LIGHTING  |

UP850

September 8, 1991

2VBB-UPS1C LOAD LIST  
 DWG. NO. AE-100F  
 SHEET 24 OF 33

11

12

13

14

15

UPS NO: 2VBB-UPS1C  
 PNL NO: 2LAT-PNL017  
 DIST PNL NO: 2LAT-PNLU02  
 CIRCUIT NO: N/A

DRAWING REFERENCE  
 CE-100F

| FEED TO DEVICE              | BKR<br>NO. | LTG.<br>DWG.                                   | <u>DEVICE LOCATION</u>                   |            | PLANT IMPACT<br>OTHER LIGHTING<br>COVERAGE AS<br>INDICATED |
|-----------------------------|------------|--|--|------------|--|
|                             |            |  | BLDG                                     | ELEV       |  |
| ESSENTIAL LIGHTING          | 17<br>19   | EE-66D   | TURB MEZZ                                | 277        | NORMAL LIGHTING  |
| SPARE                       | 18<br>20   |  |  |            |  |
| SPARE                       | 21<br>23   |  |  |            |  |
| ESSENTIAL LIGHTING          | 22<br>24   | EE-79C   | HEATER BAY<br>DEMIN AREA                 | 277        | NORMAL LIGHTING  |
| SPARE                       | 25<br>27   |  |  |            |  |
| SPARE                       | 26<br>28   |  |  |            |  |
| SPARE                       | 29<br>31   |  |  |            |  |
| ESSENTIAL LIGHTING          | 30<br>32   | EE-66D   | TURB SWGR<br>RM                          | 277        | NORMAL LIGHTING  |
| SPARE                       | 33         |  |  |            |  |
| SPARE                       | 34         |  |  |            |  |
| ESSENTIAL LIGHTING          | 35         | EE-66C   | TURB MEZZ                                | 277        | NORMAL LIGHTING  |
| COMMUNICATIONS<br>EQUIPMENT | 36         | EE-<br>80D,<br>F, G,<br>H, J,<br>AG,<br>AJ, AR | COMM EQUIP<br>TB, FOAM RM<br>PIPE TUNNEL | VARIOUS    | LOSE<br>COMMUNICATIONS<br>SEE NOTE 1 & 2<br>SHEET 33       |
| ESSENTIAL LIGHTING          | 37         | EE-66D   | TURB BLDG                                | 292        | NORMAL LIGHTING  |
| ESSENTIAL LIGHTING          | 38         | EE-79C   | HEATER BAY,<br>DEMIN AREA                | 277        | NORMAL LIGHTING  |
| EXIT LIGHTS                 | 39         | EE-66A<br>EE-66C                               | TURB BLDG                                | 268<br>277 | LOSE EXIT<br>LIGHTS  |
| SPARE                       | 40         |  |  |            |  |

UP850

September 11, 1991

2VBB-UPS1C LOAD LIST  
 DWG. NO. AE-100F  
 SHEET 25 OF 33

41  
42  
43  
44

45

46

47

48

49

50



DRAWING REFERENCE  
CE-100F

[illegible]

**UP850**

**September 8, 1991**

2VBB-UPS1C LOAD LIST  
DWG. NO. AE-100F  
SHEET 26 OF 33



UPS NO: 2VBB-UPS1C  
 PNL NO: 2LAT-PNL017  
 DIST PNL NO: 2LAT-PNLU05  
 CIRCUIT NO: N/A

DRAWING REFERENCE  
 CE-100J

| FEED TO DEVICE     | BKR NO.  | LTG. DWG.       | <u>DEVICE LOCATION</u>                |          | PLANT IMPACT<br>OTHER LIGHTING<br>COVERAGE AS<br>INDICATED |
|--------------------|----------|-----------------|---------------------------------------|----------|--|
|                    |          |                 | BLDG                                  | ELEV     |  |
| SPARE              | 1        |                 |                                       |          |  |
| SPARE              | 2        |                 |                                       |          |  |
| SPARE              | 3        |                 |                                       |          |  |
| SPARE              | 4        |                 |                                       |          |  |
| ESSENTIAL LIGHTING | 5        | EE-66A,<br>C, E | TURB BLDG<br>NW                       | STAIR    | NO OTHER<br>LIGHTING                                       |
| SPARE              | 6        |                 |                                       |          |  |
| ESSENTIAL LIGHTING | 7        | EE-66A,<br>C, E | TURB BLDG<br>NW                       | STAIR    | NO OTHER<br>LIGHTING                                       |
| SPARE              | 8        |                 |                                       |          |  |
| EXIT LIGHT         | 9        | EE-66A          | TURB BLDG                             | 250, 261 | LOSE EXIT<br>LIGHTS  |
| ESSENTIAL LIGHTING | 10<br>12 | EE-79A          | OFFGAS & RR<br>PLATE AREA             | 261      | NORMAL LIGHTING  |
| ESSENTIAL LIGHTING | 11<br>13 | EE-79A          | OFFGAS &<br>DEMIN<br>STAIRS &<br>PASS | 250, 261 | NORMAL LIGHTING<br>EXCEPT STAIRS                           |
| ESSENTIAL LIGHTING | 14<br>16 | EE-79A          | HEATER BAY                            | 250      | NORMAL LIGHTING  |
| SPARE              | 15<br>17 |                 |                                       |          |  |
| ELEVATOR           | 18       | EE-66A          | TURB BLDG                             | 250      | NO OTHER<br>LIGHTING                                       |
| SPARE              | 19       |                 |                                       |          |  |

UP850

September 11, 1991

2VBB-UPS1C LOAD LIST  
 DWG. NO. AE-100F  
 SHEET 27 OF 33

100  



UPS NO: 2VBB-UPS1C  
 PNL NO: 2LAT-PNL017  
 DIST PNL NO: 2LAT-PNLU05  
 CIRCUIT NO: N/A

DRAWING REFERENCE  
 CE-100J

| FEED TO DEVICE     | BKR<br>NO. | LTG.<br>DWG. | <u>DEVICE LOCATION</u>         |      | PLANT IMPACT<br>OTHER LIGHTING<br>COVERAGE AS<br>INDICATED |
|--------------------|------------|--------------|--------------------------------|------|--|
|                    |            |              | BLDG                           | ELEV |  |
| SPARE              | 20         |              |                                |      |  |
| SPARE              | 21         |              |                                |      |  |
| SPARE              | 22         |              |                                |      |  |
| SPARE              | 23         |              |                                |      |  |
| ESSENTIAL LIGHTING | 24         | EE-68A       | SERVICE<br>BLDG FOAM R         | 261  | NORMAL LIGHTING  |
| SPARE              | 25         |              |                                |      |  |
| ESSENTIAL LIGHTING | 26         | EE-68A       | SERVICE<br>BLDG<br>CORRIDOR    | 261  | NORMAL LIGHTING  |
| SPARE              | 27         |              |                                |      |  |
| ESSENTIAL LIGHTING | 28         | EE-68A       | SERVICE<br>BLDG/TRUCK<br>AISLE | 248  | NORMAL LIGHTING  |
| SPARE              | 29         |              |                                |      |  |
| SPARE              | 30         |              |                                |      |  |

UPS50

September 11, 1991

2VBB-UPS1C LOAD LIST  
 DWG. NO. AE-100F  
 SHEET 28 OF 33

100

101

102

103

104

105

UPS NO: 2VBB-UPS1C  
 PNL NO: 2LAT-PNL017  
 DIST PNL NO: 2LAT-PNLU05  
 CIRCUIT NO: N/A

DRAWING REFERENCE  
 CE-100J

| FEED TO DEVICE     | BKR<br>NO. | LTG.<br>DWG.       | <u>DEVICE LOCATION</u>                         |      | PLANT IMPACT<br>OTHER LIGHTING<br>COVERAGE AS<br>INDICATED |
|--------------------|------------|--------------------|--|------|--|
|                    |            |                    | BLDG   | ELEV |  |
| SPARE              | 31         |                    |  |      |  |
| EXIT LIGHTS        | 32         | EE-79A             | OFFGAS<br>DEMIN AREA                           | 250  | LOSE EXIT<br>LIGHTS  |
| ESSENTIAL LIGHTING | 33         | EE-79A             | OFFGAS<br>DEMIN AREA                           | 250  | NORMAL LIGHTING  |
| ESSENTIAL LIGHTING | 34         | EE-<br>68A,<br>79A | SERVICE<br>BLDG TRUCK<br>AISLE,<br>DEMIN. AREA | 250  | NORMAL LIGHTING  |
| ESSENTIAL LIGHTING | 35<br>37   | EE-79C             | HTR BAY "A"                                    | 277  | NORMAL LIGHTING  |
| ESSENTIAL LIGHTING | 36<br>38   | EE-68A             | SERVICE<br>BLDG TRUCK<br>AISLE                 | 250  | NORMAL LIGHTING  |
| SPARE              | 39<br>41   |                    |  |      |  |
| SPARE              | 40<br>42   |                    |  |      |  |
|                    |            |                    |  |      |  |
|                    |            |                    |  |      |  |
UP850

September 11, 1991

2VBB-UPS1C LOAD LIST  
 DWG. NO. AE-100F  
 SHEET 29 OF 33





UPS NO: 2VBB-UPS1C  
 PNL NO: 2LAT-PNL017  
 DIST PNL NO: 2LAX-PNLU01  
 CIRCUIT NO: N/A

DRAWING REFERENCE  
 CE-100T

| FEED TO DEVICE     | BKR<br>NO. | LTG.<br>DWG. | <u>DEVICE LOCATION</u> |       | PLANT IMPACT<br>(OTHER LIGHTING<br>COVERAGE AS<br>INDICATED) |
|--------------------|------------|--------------|------------------------|-------|--|
|                    |            |              | BLDG.                  | ELEV. |  |
| ESSENTIAL LIGHTING | 1<br>3     | EE-68B       | AUX BOILER             | 261   | NORMAL LIGHTING  |
| ESSENTIAL LIGHTING | 2<br>4     | EE-68B       | AUX BOILER             | 261   | NORMAL LIGHTING  |
| ESSENTIAL LIGHTING | 5<br>7     | EE-68B       | AUX BOILER             | 261   | NORMAL LIGHTING  |
| SPARE              | 6<br>8     |              |                        |       |  |
| SPARE              | 9<br>11    |              |                        |       |  |
| SPARE              | 10<br>12   |              |                        |       |  |
| SPARE              | 13<br>15   |              |                        |       |  |
| SPARE              | 14<br>16   |              |                        |       |  |
| EXIT LIGHTS        | 17         | EE-68B       | AUX BOILER             | 261   | LOSE EXIT LIGHTS   |
| SPARE              | 18         |              |                        |       |  |
| SPARE              | 19         |              |                        |       |  |
| SPARE              | 20         |              |                        |       |  |
| SPARE              | 21         |              |                        |       |  |
| SPARE              | 22         |              |                        |       |  |

UPS50

September 11, 1991

2VBB-UPS1C LOAD LIST  
 DWG. NO. AE-100F  
 SHEET 30 OF 33





UPS NO: 2VBB-UPS1C  
 PNL NO: 2LAT-PNL017  
 DIST PNL NO: 2LAX-PNLU01  
 CIRCUIT NO: N/A

DRAWING REFERENCE  
 CE-100T

| FEED TO DEVICE             | BKR<br>NO. | LTG.<br>DWG.     | <u>DEVICE LOCATION</u> |         | PLANT IMPACT<br>(OTHER LIGHTING<br>COVERAGE AS<br>INDICATED) |
|----------------------------|------------|------------------|------------------------|---------|--|
|                            |            |                  | BLDG.                  | ELEV.   |  |
| SPARE                      | 23         |                  |                        |         |  |
| SPARE                      | 24         |                  |                        |         |  |
| SPARE                      | 25         |                  |                        |         |  |
| SPARE                      | 26         |                  |                        |         |  |
| COMMUNICATION<br>EQUIPMENT | 27         | EE-80W           | RADWASTE<br>BLDG       | VARIOUS | LOSE<br>COMMUNICATION<br>SEE NOTE 1 & 2,<br>SHEET 33         |
| COMMUNICATION<br>EQUIPMENT | 28         | EE-80Y<br>EE-80X | RADWASTE<br>BLDG       | VARIOUS | LOSE<br>COMMUNICATION<br>SEE NOTE 1 & 2,<br>SHEET 33         |
| SPARE                      | 29         |                  |                        |         |  |
| SPARE                      | 30         |                  |                        |         |  |
| SPARE                      | 31         |                  |                        |         |  |
| SPARE                      | 32         |                  |                        |         |  |
| SPARE                      | 33         |                  |                        |         |  |
| SPARE                      | 34         |                  |                        |         |  |
| SPARE                      | 35         |                  |                        |         |  |
| SPARE                      | 36         |                  |                        |         |  |
| SPARE                      | 37         |                  |                        |         |  |
| SPARE                      | 38         |                  |                        |         |  |
| SPARE                      | 39         |                  |                        |         |  |
| SPARE                      | 40         |                  |                        |         |  |

UP850

September 8, 1991

2VBB-UPS1C LOAD LIST  
 DWG. NO. AE-100F  
 SHEET 31 OF 33

1  
2  


1  
2  
**DRAWING REFERENCE**  
**CE-100T**

UP850

September 8, 1991

2VBB-UPS1C LOAD LIST  
DWG. NO. AE-100F  
SHEET 32 OF 33




NOTES:

1. THE HANDSET LOCATIONS OF THE COMMUNICATION SYSTEM HAVE BEEN LOCATED AT POSITIONS TO MEET THE INTENT OF THE NFPA 72D CODE REQUIREMENTS REGARDING THE INSTALLATION OF MANUAL FIRE ALARM PULL STATIONS. AS SUCH, THE LOSS OF COMMUNICATION SYSTEM HANDSETS RESULT IN THE EQUIVALENT LOSS OF MANUAL FIRE ALARM PULL STATIONS.
2. THESE AREAS ARE PROVIDED PARTIAL PAGING COMMUNICATION FROM UPS 2VBB-UPS1D.





# 2VBB-UPS1D LOAD LIST

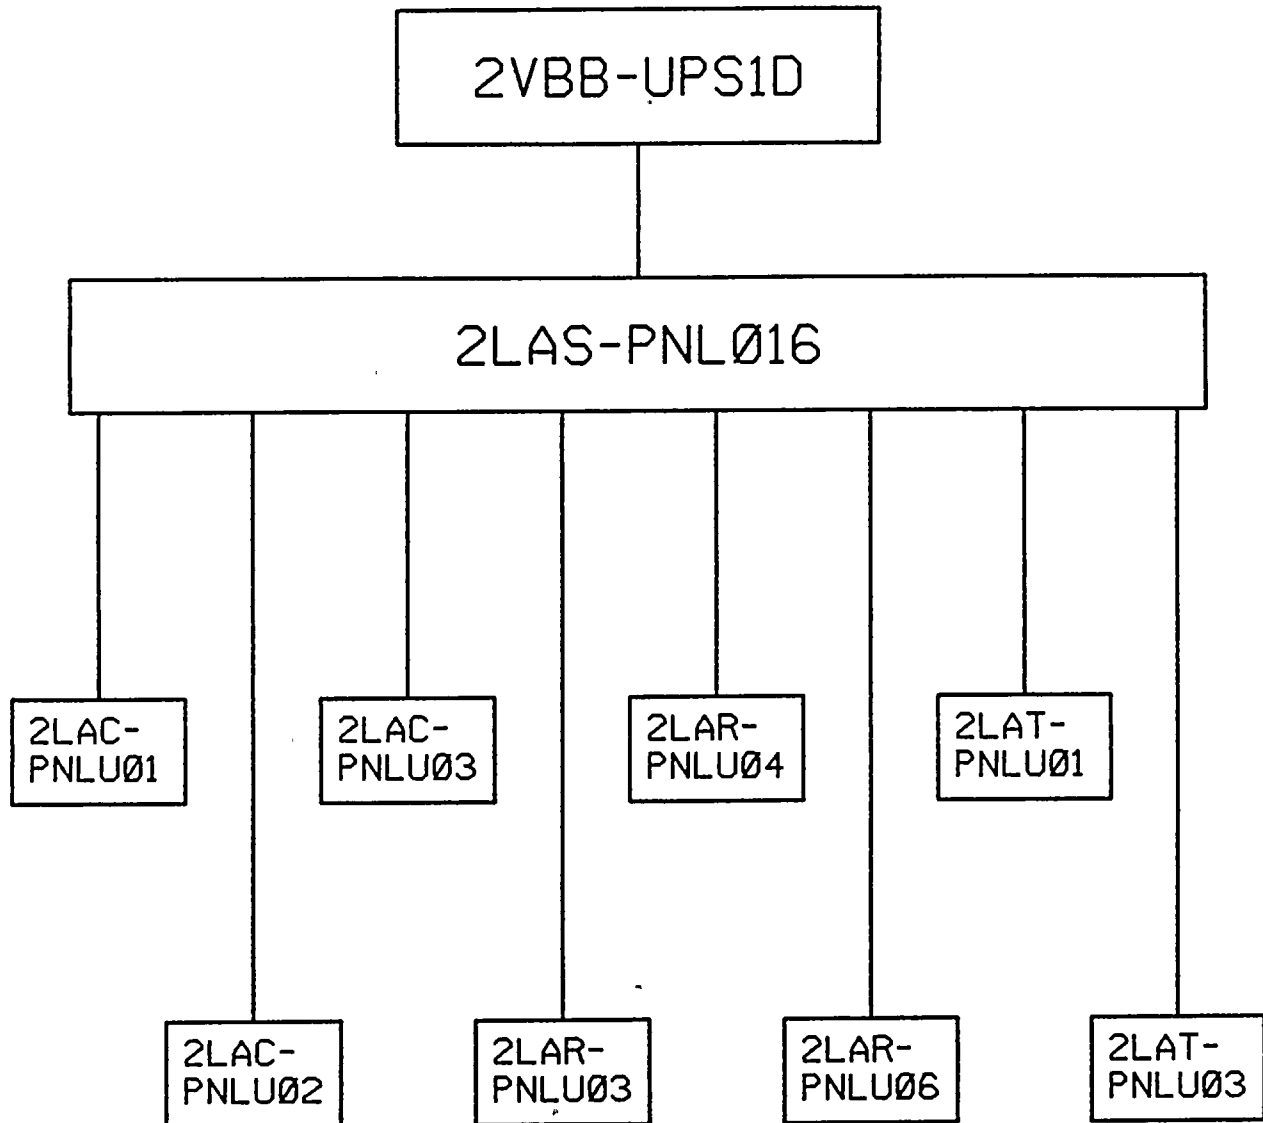

NOTE: THIS DRAWING WAS CREATED USING  
COMPUTER AIDED DRAFTING  
DO NOT MAKE MANUAL CHANGES

NUCLEAR NON-SAFETY RELATED

|                              |            |                          |  |
|------------------------------|------------|--------------------------|--|
|                              |            | NINE MILE POINT          |  |
|                              |            | NUCLEAR STATION - UNIT 2 |  |
|                              |            | SCRIBA, N.Y.             |  |
| LOAD LIST                    |            |                          |  |
| UNINTERRUPTIBLE POWER SUPPLY |            |                          |  |
| 2VBB-UPS1D                   |            |                          |  |
| SHEET 1 OF 33                |            |                          |  |
| SCALE                        | DRAWING NO | AE-100G                  |  |
| NONE                         |            |                          |  |

| 1  | 9-11-91 | JBP |    | ORIGINAL ISSUE-<br>AS BUILT | DRW<br>AR | APP<br>AKJ |
|----|---------|-----|----|-----------------------------|-----------|------------|
| MK | DATE    | BY  | MF | DESCRIPTION                 | CK        | APP        |



1  
2  
1  
2  
1

# INDEX

| PANEL            | BKR. NO. | SHEET NO. |
|------------------|----------|-----------|
| 2LAC-PNLU01<br>↓ | 1        | 7         |
|                  | 2        | 7         |
|                  | 3        | 7         |
|                  | 4        | 7         |
|                  | 5        | 7         |
|                  | 6        | 7         |
|                  | 7        | 7         |
|                  | 8        | 7         |
|                  | 9        | 7         |
|                  | 10       | 7         |
|                  | 11       | 7         |
|                  | 12       | 8         |
|                  | 13       | 8         |
|                  | 14       | 8         |
|                  | 15       | 8         |
|                  | 16       | 8         |
|                  | 17       | 8         |
|                  | 18       | 8         |
|                  | 19       | 8         |
|                  | 20       | 8         |
|                  | 21       | 8         |
|                  | 22       | 8         |
|                  | 23       | 8         |
|                  | 24       | 8         |
|                  | 25       | 9         |
|                  | 26       | 9         |
|                  | 27       | 9         |
|                  | 28       | 9         |
|                  | 29       | 9         |
|                  | 30       | 9         |
|                  | 31       | 9         |
|                  | 32       | 9         |
|                  | 34       | 9         |
|                  | 33       | 9         |
|                  | 35       | 9         |
|                  | 36       | 9         |
|                  | 38       | 9         |
| 2LAC-PNLU01      | 37       | 10        |

| PANEL                           | BKR. NO. | SHEET NO. |
|---------------------------------|----------|-----------|
| 2LAC-PNLU01<br>↓<br>2LAC-PNLU01 | 39       | 10        |
|                                 | 40       | 10        |
|                                 | 41       | 10        |
|                                 | 42       | 10        |
|                                 |          |           |
| 2LAC-PNLU03<br>↓                | 1        | 11        |
|                                 | 2        | 11        |
|                                 | 3        | 11        |
|                                 | 4        | 11        |
|                                 | 5        | 11        |
|                                 | 6        | 11        |
|                                 | 7        | 11        |
|                                 | 8        | 11        |
|                                 | 9        | 11        |
|                                 | 10       | 11        |
|                                 | 11       | 11        |
|                                 | 12       | 12        |
|                                 | 13       | 12        |
|                                 | 14       | 12        |
|                                 | 15       | 12        |
|                                 | 16       | 12        |
|                                 | 17       | 12        |
|                                 | 18       | 12        |
|                                 | 19       | 12        |
|                                 | 20       | 12        |
|                                 | 21       | 12        |
|                                 | 22       | 12        |
|                                 | 23       | 12        |
|                                 | 24       | 12        |
|                                 | 25       | 12        |
|                                 | 26       | 12        |
|                                 | 27       | 12        |
| 2LAC-PNLU03                     | 28       | 13        |

(CONTINUED ON SHEET 3)

2VBB-UPS1D LOAD LIST  
DWG. NO. AE-100G  
SHEET 2 OF 33

14

1

2

3

4

5

6

7

8

9

10

11

12

13

14

# INDEX

| PANEL            | BKR. NO. | SHEET NO. |
|------------------|----------|-----------|
| 2LAC-PNLU03<br>↓ | 29       | 13        |
|                  | 30       | 13        |
|                  | 31       | 13        |
|                  | 32       | 13        |
|                  | 33       | 13        |
|                  | 35       |           |
|                  | 37       |           |
|                  | 34       | 13        |
|                  | 36       | 13        |
|                  | 38       | 13        |
|                  | 39       | 13        |
|                  | 40       | 13        |
|                  | 41       | 14        |
|                  | 42       | 14        |
|                  |          |           |
| 2LAR-PNLU04<br>↓ | 1        | 15        |
|                  | 2        | 15        |
|                  | 3        | 15        |
|                  | 4        | 15        |
|                  | 5        | 15        |
|                  | 6        | 15        |
|                  | 7        | 15        |
|                  | 8        | 15        |
|                  | 9        | 15        |
|                  | 10       | 15        |
|                  | 11       | 15        |
|                  | 12       | 15        |
|                  | 13       | 15        |
|                  | 14       | 15        |
|                  | 15       | 15        |
|                  | 16       | 15        |
|                  | 17       | 15        |
|                  | 18       | 16        |
|                  | 19       | 16        |
|                  | 20       | 16        |
|                  | 21       | 16        |
|                  | 22       | 16        |
|                  |          |           |
| 2LAR-PNLU04      |          |           |

| PANEL                       | BKR. NO. | SHEET NO. |
|-----------------------------|----------|-----------|
| 2LAR-PNLU04<br><div>↓</div> | 23       | 16        |
|                             | 25       |           |
|                             | 24       | 16        |
|                             | 26       |           |
|                             | 27       | 16        |
|                             | 29       |           |
|                             | 28       | 16        |
|                             | 30       |           |
|                             | 31       | 16        |
|                             | 33       |           |
|                             | 32       | 16        |
|                             | 34       |           |
|                             | 35       | 16        |
|                             | 37       |           |
|                             | 36       | 16        |
| 38                          |          |           |
| 39                          | 16       |           |
| 41                          |          |           |
| 40                          | 16       |           |
| 42                          |          |           |
| 2LAR-PNLU04                 |          |           |
|                             |          |           |
| 2LAT-PNLU01<br><div>↓</div> | 1        | 17        |
|                             | 3        |           |
|                             | 2        | 17        |
|                             | 4        |           |
|                             | 5        | 17        |
|                             | 7        |           |
|                             | 6        | 17        |
|                             | 8        |           |
|                             | 9        | 17        |
|                             | 11       |           |
|                             | 10       | 17        |
|                             | 12       |           |
| 2LAT-PNLU01                 |          |           |

(CONTINUED ON SHEET 4)

2VBB-UPS1D LOAD LIST  
DWG. NO. AE-100G  
SHEET 3 OF 33

100

















# INDEX

| PANEL       | BKR. NO. | SHEET NO. |
|-------------|----------|-----------|
| 2LAT-PNLU01 | 13       | 17        |
|             | 15       |           |
|             | 14       | 17        |
|             | 16       |           |
|             | 17       | 17        |
|             | 19       |           |
|             | 18       | 17        |
|             | 20       |           |
|             | 21       | 17        |
|             | 23       |           |
|             | 22       | 17        |
|             | 24       |           |
|             | 25       | 18        |
|             | 26       | 18        |
|             | 27       | 18        |
|             | 29       |           |
|             | 28       | 18        |
|             | 30       |           |
|             | 31       | 18        |
|             | 33       |           |
|             | 32       | 18        |
|             | 34       |           |
|             | 35       | 18        |
|             | 36       | 18        |
|             | 37       | 18        |
|             | 38       | 18        |
|             | 39       | 18        |
|             | 40       | 19        |
|             | 41       | 19        |
|             | 42       | 19        |
| 2LAT-PNLU01 |          |           |
| 2LAC-PNLU02 | 1        | 20        |
|             | 2        | 20        |
|             | 3        | 20        |
|             | 4        | 20        |
|             | 5        | 20        |
|             | 6        | 20        |
|             | 7        | 20        |
| 2LAC-PNLU02 |          |           |

| PANEL       | BKR. NO. | SHEET NO. |
|-------------|----------|-----------|
| 2LAC-PNLU02 | 8        | 20        |
|             | 9        | 20        |
|             | 10       | 20        |
|             | 11       | 21        |
|             | 12       | 21        |
|             | 13       | 21        |
|             | 14       | 21        |
|             | 15       | 21        |
|             | 16       | 21        |
|             | 17       | 21        |
|             | 18       | 21        |
|             | 19       | 21        |
|             | 20       | 21        |
|             | 21       | 21        |
|             | 22       | 21        |
|             | 23       | 22        |
|             | 24       | 22        |
|             | 26       |           |
|             | 25       | 22        |
|             | 27       |           |
|             | 28       | 22        |
|             | 30       |           |
|             | 29       | 22        |
|             | 31       |           |
|             | 32       | 22        |
|             | 34       |           |
|             | 33       | 22        |
|             | 35       |           |
|             | 36       | 22        |
|             | 37       | 23        |
|             | 38       | 23        |
|             | 39       | 23        |
|             | 40       | 23        |
| 2LAC-PNLU02 |          |           |

(CONTINUED ON SHEET 5)

2VBB-UPS1D LOAD LIST  
DWG. NO. AE-100G  
SHEET 4 OF 33





# INDEX

| PANEL       | BKR. NO. | SHEET NO. |
|-------------|----------|-----------|
| 2LAC-PNLU02 | 41       | 23        |
| 2LAC-PNLU02 | 42       | 23        |
|             |          |           |
| 2LAR-PNLU03 | 1        | 24        |
|             | 2        | 24        |
|             | 3        | 24        |
|             | 4        | 24        |
|             | 5        | 24        |
|             | 6        | 24        |
|             | 7        | 24        |
|             | 8        | 24        |
|             | 9        | 24        |
|             | 10       | 24        |
|             | 11       | 24        |
|             | 12       | 24        |
|             | 13       | 25        |
|             | 14       | 25        |
|             | 15       | 25        |
|             | 16       | 25        |
|             | 17       | 25        |
|             | 18       | 25        |
|             | 19       | 25        |
|             | 20       | 25        |
|             | 21       | 25        |
|             | 22       | 26        |
|             | 23       |           |
|             | 25       | 26        |
|             | 24       | 26        |
|             | 26       | 26        |
|             | 27       |           |
|             | 29       | 26        |
|             | 28       |           |
|             | 30       | 26        |
|             | 31       |           |
|             | 33       | 26        |
|             | 32       |           |
| 2LAR-PNLU03 | 34       | 26        |

| PANEL       | BKR. NO. | SHEET NO. |
|-------------|----------|-----------|
| 2LAR-PNLU03 | 35       |           |
|             | 37       | 26        |
|             | 36       |           |
|             | 38       | 26        |
|             | 39       |           |
|             | 41       | 26        |
|             | 40       |           |
| 2LAR-PNLU03 | 42       | 26        |
|             |          |           |
| 2LAR-PNLU06 | 1        | 27        |
|             | 2        |           |
|             | 4        | 27        |
|             | 3        | 27        |
|             | 5        | 27        |
|             | 6        | 27        |
|             | 7        |           |
|             | 9        | 27        |
|             | 8        | 27        |
|             | 10       |           |
|             | 12       | 28        |
|             | 11       |           |
|             | 13       | 28        |
|             | 14       | 28        |
|             | 15       | 28        |
|             | 16       | 28        |
|             | 17       | 28        |
|             | 18       | 28        |
|             | 19       | 28        |
|             | 20       | 28        |
|             | 21       | 29        |
|             | 22       | 29        |
|             | 23       |           |
| 2LAR-PNLU06 | 25       | 29        |

(CONTINUED ON SHEET 6)

2VBB-UPS1D LOAD LIST  
DWG. NO. AE-100G  
SHEET 5 OF 33



# INDEX

| PANEL            | BKR. NO. | SHEET NO. |
|------------------|----------|-----------|
| 2LAR-PNLU06<br>↓ | 24       | 29        |
|                  | 26       |           |
|                  | 27       |           |
|                  | 29       | 29        |
|                  | 28       |           |
|                  | 30       | 29        |
|                  | 31       |           |
|                  | 33       | 29        |
|                  | 32       |           |
|                  | 34       | 29        |
|                  | 35       |           |
|                  | 37       | 29        |
|                  | 36       |           |
|                  | 38       | 29        |
|                  | 39       |           |
|                  | 41       | 29        |
|                  | 40       |           |
| 2LAR-PNLU06      | 42       | 29        |
|                  |          |           |
| 2LAT-PNLU03<br>↓ | 1        | 30        |
|                  | 3        |           |
|                  | 2        |           |
|                  | 4        | 30        |
|                  | 5        |           |
|                  | 7        | 30        |
|                  | 6        |           |
|                  | 8        | 30        |
|                  | 9        |           |
|                  | 11       | 30        |
|                  | 10       |           |
|                  | 12       | 30        |
|                  | 13       |           |
|                  | 15       | 30        |
|                  | 14       |           |
|                  | 16       | 30        |
|                  | 17       |           |
| 2LAT-PNLU03      | 19       | 30        |

| PANEL   | BKR. NO. | SHEET NO. |
|---|----------|-----------|


2VBB-UPS1D LOAD LIST  
DWG. NO. AE-100G  
SHEET 6 OF 33

27

28

29

30

31

32

33

34

35

36

37

38

39

UPS NO: 2VBB-UPS1D  
 PNL NO: 2LAS-PNL016  
 DIST PNL NO: 2LAC-PNLU01  
 CIRCUIT NO: N/A

DRAWING REFERENCES

CE-100A

| FEED TO DEVICE     | BKR NO. | LTG. DWG. | DEVICE LOCATION               |      | PLANT IMPACT                                   |
|--------------------|---------|-----------|-------------------------------|------|--|
|                    |         |           | BLDG                          | ELEV |  |
| ESSENTIAL LIGHTING | 1       | EE-78C,D  | ELEC. TUNNEL                  | 214  | COVERED BY NORMAL                              |
| ESSENTIAL LIGHTING | 2       | EE-78D    | ELEC. TUNNEL                  | 214  | COVERED BY NORMAL                              |
| ESSENTIAL LIGHTING | 3       | EE-78D    | ELEC. TUNNEL                  | 214  | COVERED BY NORMAL                              |
| ESSENTIAL LIGHTING | 4       | EE-78C    | ELEC. TUNNEL                  | 214  | COVERED BY NORMAL                              |
| ESSENTIAL LIGHTING | 5       | EE-78C,D  | ELEC. TUNNEL                  | 214  | LOSE EXIT LIGHT BUT ALL LTG. COVERED BY NORMAL |
| ESSENTIAL LIGHTING | 6       | EE-78C    | ELEC. TUNNEL                  | 214  | COVERED BY NORMAL                              |
| ESSENTIAL LIGHTING | 7       | EE-78C    | LTG- STAIR NO. 1 ELEC. TUNNEL | N/A  | NOT COVERED                                    |
| ESSENTIAL LIGHTING | 8       | EE-78C    | LTG- STAIR NO. 1 ELEC. TUNNEL | N/A  | NOT COVERED                                    |
| ESSENTIAL LIGHTING | 9       | EE-78D    | LTG-STAIR NO. 3 ELEC TUNNEL   | N/A  | NOT COVERED                                    |
| ESSENTIAL LIGHTING | 10      | EE-78D    | LTG-STAIR NO. 3 ELEC TUNNEL   | N/A  | NOT COVERED                                    |
| ESSENTIAL LIGHTING | 11      | EE-78D    | LTG-STAIR NO. 2 ELEC TUNNEL   | N/A  | NOT COVERED                                    |

UPS11

September 9, 1991

2VBB-UPS1D LOAD LIST  
 DWG. NO. AE-100G  
 SHEET 7 OF 33



UPS NO: 2VBB-UPS1D  
 PNL NO: 2LAS-PNL016  
 DIST PNL NO: 2LAC-PNLU01  
 CIRCUIT NO: N/A

DRAWING REFERENCES

CE-100A

| FEED TO DEVICE          | BKR NO. | LTG. DWG.                 | DEVICE LOCATION             |            | PLANT IMPACT                                     |
|-------------------------|---------|---------------------------|-----------------------------|------------|--|
|                         |         |                           | BLDG                        | ELEV       |  |
| ESSENTIAL LIGHTING      | 12      | EE-78D                    | LTG-STAIR NO. 2 ELEC TUNNEL | N/A        | NOT COVERED                                      |
| ESSENTIAL LIGHTING      | 13      | EE-78D                    | LTG-STAIR NO. 2 ELEC TUNNEL | N/A        | NOT COVERED                                      |
| SPARE                   | 14      |                           |                             |            |  |
| EXIT LIGHTS             | 15      | EE-67P, 78C,D             | ASB ELEC TUNNEL             | 261<br>214 | LOSE EXIT LIGHTS                                 |
| EXIT LIGHTS             | 16      | EE-65A                    | CONT. BLDG.                 | 214        | LOSE EXIT LIGHTS                                 |
| ESSENTIAL LIGHTING      | 17      | EE-67P, 78C               | LTG-STAIR 315° AZ           | N/A        | NOT COVERED                                      |
| EXIT LIGHTS             | 18      | EE-65B                    | CONT BLDG                   | 214        | LOSE EXIT LIGHTS                                 |
| ESSENTIAL LIGHTING      | 19      | EE-65A                    | CONT BLDG                   | 210<br>214 | COVERED BY NORMAL                                |
| SPARE                   | 20      |                           |                             |            |  |
| ESSENTIAL LIGHTING      | 21      | EE-65A                    | CONT BLDG STAIRWAY          | 214        | NOT COVERED                                      |
| ESSENTIAL LIGHTING      | 22      | EE-65A                    | CONT BLDG                   | 214        | COVERED BY NORMAL                                |
| ESSENTIAL LIGHTING      | 23      | EE-65A                    | CONT BLDG                   | 214        | COVERED BY NORMAL                                |
| COMMUNICATION EQUIPMENT | 24      | EE-80AB, 80AC, 80AG, 80AM | ELEC TUNNELS ASB CONT BLDG  | VARIOUS    | LOSE COMMUNICATION<br>SEE NOTE 1 & 2<br>SHEET 33 |

UPS11

September 11, 1991

2VBB-UPS1D LOAD LIST  
 DWG. NO. AE-100G  
 SHEET 8 OF 33

1. 2. 3.

















UPS NO: 2VBB-UPS1D  
 PNL NO: 2LAS-PNL016  
 DIST PNL NO: 2LAC-PNLU01  
 CIRCUIT NO: N/A

DRAWING REFERENCES

CE-100A

| FEED TO DEVICE | BKR<br>NO. | LTG.<br>DWG. | <u>DEVICE LOCATION</u> |      | PLANT IMPACT |
|----------------|------------|--------------|------------------------|------|--------------|
|                |            |              | BLDG                   | ELEV |              |
| SPARE          | 25         |              |                        |      |              |
| SPARE          | 26         |              |                        |      |              |
| SPARE          | 27         |              |                        |      |              |
| SPARE          | 28         |              |                        |      |              |
| SPARE          | 29         |              |                        |      |              |
| SPARE          | 30         |              |                        |      |              |
| SPARE          | 31         |              |                        |      |              |
| SPARE          | 32<br>34   |              |                        |      |              |
| SPARE          | 33         |              |                        |      |              |
| SPARE          | 35         |              |                        |      |              |
| SPARE          | 36<br>38   |              |                        |      |              |

UPS11

September 8, 1991

2VBB-UPS1D LOAD LIST  
 DWG. NO. AE-100G  
 SHEET 9 OF 33



UPS NO: 2VBB-UPS1D  
 PNL NO: 2LAS-PNL016  
 DIST PNL NO: 2LAC-PNLU01  
 CIRCUIT NO: N/A

DRAWING REFERENCES

CE-100A

| FEED TO DEVICE | BKR<br>NO. | LTG.<br>DWG. | DEVICE LOCATION |      | PLANT IMPACT |
|----------------|------------|--------------|-----------------|------|--------------|
|                |            |              | BLDG            | ELEV |              |
| SPARE          | 37         |              |                 |      |              |
| SPARE          | 39         |              |                 |      |              |
| SPARE          | 40         |              |                 |      |              |
| SPARE          | 41         |              |                 |      |              |
| SPARE          | 42         |              |                 |      |              |
|                |            |              |                 |      |              |
|                |            |              |                 |      |              |
UPS11

September 8, 1991

2VBB-UPS1D LOAD LIST  
 DWG. NO. AE-100G  
 SHEET 10 OF 33



UPS NO: 2VBB-UPS1D  
 PNL NO: 2LAS-PNL016  
 DIST PNL NO: 2LAC-PNLU03  
 CIRCUIT NO: N/A

DRAWING REFERENCES

CE-100C

| FEED TO DEVICE                    | BKR NO. | LTG. DWG. | DEVICE LOCATION              |            | PLANT IMPACT  |
|-----------------------------------|---------|-----------|------------------------------|------------|---|
|                                   |         |           | BLDG                         | ELEV       |   |
| ESSENTIAL LIGHTING                | 1       | EE-65D    | CB COMPUTER RM               | 288        | COVERED BY NORMAL LTG   |
| ESSENTIAL LIGHTING                | 2       | EE-65D    | CB INSTRUMENT RM             | 288        | COVERED BY NORMAL LTG & EMERG. LTG  |
| ESSENTIAL LIGHTING<br>RECEPTACLES | 3       | 65D, E    | CB RELAY RM<br>CB CONTROL RM | 288<br>306 | COVERED BY NORMAL LTG & EMERG. LTG  |
| EXIT LIGHTS                       | 4       | EE-65D    | CB                           | 288        | LOSS OF EXIT SIGN   |
| ESSENTIAL LIGHTING                | 5       | EE-65D    | CB WEST CORRIDORS            | 288        | COVERED BY NORMAL   |
| ESSENTIAL LIGHTING                | 6       | EE-65D    | CB CABLE CHASE               | 288        | COVERED BY NORMAL EXCEPT LT IN RM BET COL AC & AB & COL 10 1/4 AND 10 3/4 |
| ESSENTIAL LIGHTING                | 7       | EE-65E    | CB WEST CORRIDORS            | 306        | COVERED BY NORMAL   |
| ESSENTIAL LIGHTING                | 8       | EE-65E    | CB SHIFT SUPV. OFFICE        | 306        | COVERED BY NORMAL & EMERG. LTG  |
| ESSENTIAL LIGHTING                | 9       | EE-65E, F | CB SOUTH CORRIDORS           | 306        | COVERED BY NORMAL   |
| EXIT SIGNS                        | 10      | EE-65E, F | CB                           | 306        | LOSS OF EXIT SIGN   |
| ESSENTIAL LIGHTING                | 11      | EE-65F    | CB, HVAC & INST. RMS         | 306        | COVERED BY NORMAL & EMERG. LTG  |

UPS11

September 8, 1991

2VBB-UPS1D LOAD LIST  
 DWG. NO. AE-100G  
 SHEET 11 OF 33

1  
2  

1  
2  
UPS NO: 2VBB-UPS1D  
 PNL NO: 2LAS-PNL016  
 DIST PNL NO: 2LAC-PNLU03  
 CIRCUIT NO: N/A

DRAWING REFERENCES

CE-100C

| FEED TO DEVICE          | BKR NO. | LTG. DWG.    | DEVICE LOCATION |      | PLANT IMPACT   |
|-------------------------|---------|--------------|-----------------|------|--|
|                         |         |              | BLDG            | ELEV |  |
| SPARE                   | 12      |              |                 |      |  |
| SPARE                   | 13      |              |                 |      |  |
| SPARE                   | 14      |              |                 |      |  |
| SPARE                   | 15      |              |                 |      |  |
| SPARE                   | 16      |              |                 |      |  |
| SPARE                   | 17      |              |                 |      |  |
| SPARE                   | 18      |              |                 |      |  |
| COMMUNICATION EQUIPMENT | 19      | EE-80C, 80AM | CB              | 306  | LOSE COMM. IN CORRIDORS, CABLE RISER AREAS & LUNCH RM. CONTROL RM ALSO LOSES COMM. BUT IS PICKED UP BY JACKS HOOKED UP TO NORMAL PWR. SEE NOTE 1 & 2, SHEET 33 |
| ESSENTIAL LIGHTING      | 20      | EE-65D       | CB, HAVAC RM    | 288  | COVERD BY NORMAL   |
| SPARE                   | 21      |              |                 |      |  |
| SPARE                   | 22      |              |                 |      |  |
| SPARE                   | 23      |              |                 |      |  |
| SPARE                   | 24      |              |                 |      |  |
| SPARE                   | 25      |              |                 |      |  |
| SPARE                   | 26      |              |                 |      |  |
| SPARE                   | 27      |              |                 |      |  |

UPS11

September 8, 1991

2VBB-UPS1D LOAD LIST  
 DWG. NO. AE-100G  
 SHEET 12 OF 33
















UPS NO: 2VBB-UPS1D  
 PNL NO: 2LAS-PNL016  
 DIST PNL NO: 2LAC-PNLU03  
 CIRCUIT NO: N/A

DRAWING REFERENCES

CE-100C

| FEED TO DEVICE              | BKR<br>NO.     | LTG.<br>DWG.          | <u>DEVICE LOCATION</u>     |      | PLANT IMPACT   |
|-----------------------------|----------------|-----------------------|----------------------------|------|--|
|                             |                |                       | BLDG                       | ELEV |  |
| SPARE                       | 28             |                       |                            |      |  |
| SPARE                       | 29             |                       |                            |      |  |
| SPARE                       | 30             |                       |                            |      |  |
| SPARE                       | 31             |                       |                            |      |  |
| RECEPTACLES                 | 32             | EE-65E                | CB TRAINING<br>RM          | 306  | N/A  |
| DIMMER PANEL<br>2LAC-PNLU13 | 33<br>35<br>37 | EE-<br>65E,<br>EE-65G | CB CONTROL<br>RM           | 306  | LOSE ESSENTIAL<br>LIGHTS IN<br>CONTROL ROOM-<br>NORMAL AND<br>EMERGENCY<br>LIGHTS<br>REMAINING |
| RECEPTACLES                 | 34             | EE-65E                | CB TRAINING<br>RM          | 306  | N/A  |
| SPARE                       | 36             |                       |                            |      |  |
| RECEPTACLES                 | 38             | EE-66H                | TB HEALTH<br>PHYSICS<br>RM | 306  | N/A  |
| RECEPTACLES                 | 39             | EE-66H                | TB HEALTH<br>PHYSICS<br>RM | 306  | N/A  |
| RECEPTACLES                 | 40             | EE-66H                | TB HEALTH<br>PHYSICS<br>RM | 306  | N/A  |

UPS11

September 8, 1991

2VBB-UPS1D LOAD LIST  
 DWG. NO. AE-100G  
 SHEET 13 OF 33

7.

8.

9.

10.

11.

12.

13.

UPS NO: 2VBB-UPS1D  
 PNL NO: 2LAS-PNL016  
 DIST PNL NO: 2LAC-PNLU03  
 CIRCUIT NO: N/A

DRAWING REFERENCES

CE-100C

| FEED TO DEVICE | BKR<br>NO. | LTG.<br>DWG. | DEVICE LOCATION   |      | PLANT IMPACT              |
|----------------|------------|--------------|-------------------|------|---------------------------|
|                |            |              | BLDG              | ELEV |                           |
| RECEPTACLES    | 41         | EE-65D       | CB TELPHONE<br>RM | 306  | LOSS OF DIAL<br>TELEPHONE |
| RECEPTACLES    | 42         | EE-65E       | CB CONTROL<br>RM  | 306  | N/A                       |
|                |            |              |                   |      |                           |
|                |            |              |                   |      |                           |
UPS11

September 11, 1991

2VBB-UPS1D LOAD LIST  
 DWG. NO. AE-100G  
 SHEET 14 OF 33

22

23

24

25

26

27

28

29

30

31

32

UPS NO: 2VBB-UPS1D  
 PNL NO: 2LAS-PNL016  
 DIST PNL NO: 2LAR-PNLU04  
 CIRCUIT NO: N/A

DRAWING REFERENCES

CE-100N

| FEED TO DEVICE     | BKR<br>NO. | LTG.<br>DWG. | <u>DEVICE LOCATION</u> |      | PLANT IMPACT         |
|--------------------|------------|--------------|------------------------|------|----------------------|
|                    |            |              | BLDG                   | ELEV |                      |
| SPARE              | 1          |              |                        |      |                      |
| ESSENTIAL LIGHTING | 2          | EE-67J       | RX BLDG N<br>STAIRWAY  | 353  | NOT COVERED          |
| SPARE              | 3          |              |                        |      |                      |
| ESSENTIAL LIGHTING | 4          | EE-67J       | RX BLDG E              | 353  | COVERED BY<br>NORMAL |
| SPARE              | 5          |              |                        |      |                      |
| ESSENTIAL LIGHTING | 6          | EE-67J       | RX BLDG W              | 353  | COVERED BY<br>NORMAL |
| SPARE              | 7          |              |                        |      |                      |
| ESSENTIAL LIGHTING | 8          | EE-67J       | RX BLDG N              | 353  | COVERED BY<br>NORMAL |
| SPARE              | 9          |              |                        |      |                      |
| SPARE              | 10         |              |                        |      |                      |
| SPARE              | 11         |              |                        |      |                      |
| SPARE              | 12         |              |                        |      |                      |
| SPARE              | 13         |              |                        |      |                      |
| SPARE              | 14         |              |                        |      |                      |
| SPARE              | 15         |              |                        |      |                      |
| SPARE              | 16         |              |                        |      |                      |
| SPARE              | 17         |              |                        |      |                      |

UPS11

September 11, 1991

2VBB-UPS1D LOAD LIST  
 DWG. NO. AE-100G  
 SHEET 15 OF 33

11.

12.

13.

14.

15.

16.

17.

UPS NO: 2VBB-UPS1D  
 PNL NO: 2LAS-PNL016  
 DIST PNL NO: 2LAR-PNLU04  
 CIRCUIT NO: N/A

DRAWING REFERENCES

CE-100N

| FEED TO DEVICE     | BKR<br>NO. | LTG.<br>DWG. | DEVICE LOCATION |      | PLANT IMPACT         |
|--------------------|------------|--------------|-----------------|------|----------------------|
|                    |            |              | BLDG            | ELEV |                      |
| SPARE              | 18         |              |                 |      |                      |
| SPARE              | 19         |              |                 |      |                      |
| SPARE              | 20         |              |                 |      |                      |
| SPARE              | 21         |              |                 |      |                      |
| SPARE              | 22         |              |                 |      |                      |
| ESSENTIAL LIGHTING | 23<br>25   | EE-67J       | RX BLDG         | 353  | COVERED BY<br>NORMAL |
| SPARE              | 24<br>26   |              |                 |      |                      |
| SPARE              | 27<br>29   |              |                 |      |                      |
| ESSENTIAL LIGHTING | 28<br>30   | EE-67J       | RX BLDG         | 353  | COVERED BY<br>NORMAL |
| SPARE              | 31<br>33   |              |                 |      |                      |
| SPARE              | 32<br>34   |              |                 |      |                      |
| SPARE              | 35<br>37   |              |                 |      |                      |
| SPARE              | 36<br>38   |              |                 |      |                      |
| SPARE              | 39<br>41   |              |                 |      |                      |
| SPARE              | 40<br>42   |              |                 |      |                      |

UPS11

September 8, 1991

2VBB-UPS1D LOAD LIST  
 DWG. NO. AE-100G  
 SHEET 16 OF 33





UPS NO: 2VBB-UPS1D  
 PNL NO: 2LAS-PNL016  
 DIST PNL NO: 2LAT-PNLU01  
 CIRCUIT NO: N/A

DRAWING REFERENCES

CE-100E

| FEED TO DEVICE     | BKR<br>NO. | LTG.<br>DWG. | DEVICE LOCATION                                     |      | PLANT IMPACT   |
|--------------------|------------|--------------|---|------|--|
|                    |            |              | BLDG  | ELEV |  |
| ESSENTIAL LIGHTING | 1<br>3     | EE-66E       | TURB BLDG   | 306  | 2 LIGHTS<br>COVERED BY<br>NORMAL LOSE 1<br>LIGHT NEAR EL.<br>NO. 1 |
| ESSENTIAL LIGHTING | 2<br>4     | EE-66E       | TURB BLDG   | 306  | COVERED BY<br>NORMAL   |
| ESSENTIAL LIGHTING | 5<br>7     | EE-66F       | TURB BLDG   | 306  | COVERED BY<br>NORMAL   |
| SPARE              | 6<br>8     |              |   |      |  |
| ESSENTIAL LIGHTING | 9<br>11    | EE-66F       | TURB BLDG   | 306  | COVERED BY<br>NORMAL   |
| ESSENTIAL LIGHTING | 10<br>12   | EE-66F       | TURB BLDG<br>CONTAMIN<br>INSTR RM                   | 306  | COVERAGE<br>PROVIDED   |
| ESSENTIAL LIGHTING | 13<br>15   | EE-66G       | TURB BLDG<br>MOISTURE<br>SEP/<br>REHEATER<br>AREA B | 306  | COVERED BY<br>NORMAL   |
| SPARE              | 14<br>16   |              |   |      |  |
| ESSENTIAL LIGHTING | 17<br>19   | EE-66G       | TURB BLDG<br>MOISTURE<br>SEP/<br>REHEATER<br>AREA A | 306  | COVERED BY<br>NORMAL   |
| SPARE              | 18<br>20   |              |   |      |  |
| ESSENTIAL LIGHTING | 21<br>23   | EE-66G       | TURB BLDG<br>CLEAN STEAM<br>RBLB AREA               | 306  | COVERED BY<br>NORMAL   |
| SPARE              | 22<br>24   |              |   |      |  |

UPS11

September 11, 1991

2VBB-UPS1D LOAD LIST  
 DWG. NO. AE-100G  
 SHEET 17 OF 33

10

11

12

13

14

15

16

17

18

19

20

21

22

23

UPS NO: 2VBB-UPS1D  
 PNL NO: 2LAS-PNL016  
 DIST PNL NO: 2LAT-PNLU01  
 CIRCUIT NO: N/A

DRAWING REFERENCES

CE-100E

| FEED TO DEVICE             | BKR NO.  | LTG. DWG.              | DEVICE LOCATION   |                       | PLANT IMPACT   |
|----------------------------|----------|------------------------|---|-----------------------|--|
|                            |          |                        | BLDG  | ELEV                  |  |
| ESSENTIAL LIGHTING         | 25       | EE-66G                 | TURB BLDG<br>MOISTURE<br>SEP/<br>REHEATER<br>ENT              | 306                   | NO COVERAGE<br>PROVIDED                                    |
| EXIT LIGHTS                | 26       | EE-<br>66E, F          | TURB BLDG   | 306                   | LOSE EXIT<br>LIGHTS  |
| SPARE                      | 27<br>29 |                        |   |                       |  |
| ESSENTIAL LIGHTING         | 28<br>30 | EE-79E                 | VENTILATION<br>RM   | 288<br>306            | COVERAGE<br>PROVIDED                                       |
| ESSENTIAL LIGHTING         | 31<br>33 | EE-79E                 | VENTILATION<br>RM   | 288<br>306            | COVERED BY<br>NORMAL                                       |
| ESSENTIAL LIGHTING         | 32<br>34 | EE-79E                 | OFFGAS AREA   | 288<br>317            | COVERED BY<br>NORMAL                                       |
| COMMUNICATION<br>EQUIPMENT | 35       | EE-<br>80F, G,<br>H, J | TURB BLDG   | 277<br>306            | LOSE<br>COMMUNICATION<br>SEE NOTE 1 & 2<br>SHEET 33        |
| ESSENTIAL LIGHTING         | 36       | EE-<br>66F,<br>66G     | TURB BLDG<br>CONTAMIN<br>INSTR RM,<br>CLEAN STEAM<br>REBOILER | 306                   | COVERED BY<br>NORMAL                                       |
| COMMUNICATION<br>EQUIPMENT | 37       | EE-<br>80AD,<br>AE, AF | HEATER<br>BAYS, VENT<br>EQUIP RM                              | 250, 277,<br>288, 306 | LOSE<br>COMMUNICATION<br>SEE NOTE 1 & 2,<br>SHEET 33       |
| ESSENTIAL LIGHTING         | 38       | EE-79E                 | OFFGAS AREA   | 288, 306              | COVERED BY<br>NORMAL EXCEPT<br>LIGHT BY COLUMN<br>FA-3 1/2 |
| ELEVATOR #3                | 39       | EE-66B                 | TURB BLDG   | 250                   | NO COVERAGE<br>PROVIDED                                    |

UPS11

September 11, 1991

2VBB-UPS1D LOAD LIST  
 DWG. NO. AE-100G  
 SHEET 18 OF 33

47

48

49

50

51

52

53

54

55

56

57

58

59

60

61

62

63

64



20

21

22

23

24

UPS NO: 2VBB-UPS1D  
 PNL NO: 2LAS-PNL016  
 DIST PNL NO: 2LAC-PNLU02  
 CIRCUIT NO: N/A

DRAWING REFERENCES

CE-100B

| FEED TO DEVICE     | BKR NO. | LTG. DWG.        | DEVICE LOCATION            |            | PLANT IMPACT   |
|--------------------|---------|------------------|----------------------------|------------|--|
|                    |         |                  | BLDG                       | ELEV       |  |
| ESSENTIAL LIGHTING | 1       | EE-65B           | CB, CBL CHASE, CORRIDOR    | 237        | NO COVERAGE STAIRS BETWEEN AA-AB & 10 1/4 AND 10 3/4 |
| ESSENTIAL LIGHTING | 2       | EE-65B           | CB, CABLE ROUTING          | 237        | COVERAGE PROVIDED BY NORMAL                          |
| ESSENTIAL LIGHTING | 3       | EE-65D<br>EE-65B | CB, STAIRS SW              | 237<br>250 | NO COVERAGE STAIRS BETWEEN AA-AB & 10 1/4 AND 10 3/4 |
| ESSENTIAL LIGHTING | 4       | EE-65B           | CB, CABLE ROUTING          | 237        | COVERAGE PROVIDED BY NORMAL                          |
| ESSENTIAL LIGHTING | 5       | EE-65B,<br>68C   | CB CABLE CHASE<br>DIE. GEN | 237<br>244 | COVERAGE PROVIDED BY NORMAL                          |
| ESSENTIAL LIGHTING | 6       | EE-65C           | CB, STANDBY SWG. RM        | 261        | COVERAGE PROVIDED BY NORMAL & EMERG.                 |
| ESSENTIAL LIGHTING | 7       | EE-65C           | CB, STANDBY SWG. RM        | 261        | COVERAGE PROVIDED BY NORMAL & EMERG.                 |
| ESSENTIAL LIGHTING | 8       | EE-65C           | CB, STAIRS NE              | 261<br>270 | NO COVERAGE  |
| ESSENTIAL LIGHTING | 9       | EE-65C           | CB, CABLE CHASE            | 261        | COVERAGE PROVIDED BY NORMAL                          |
| ESSENTIAL LIGHTING | 10      | EE-65C           | CB, BATTERY RMS            | 261        | COVERAGE PROVIDED BY NORMAL                          |

UPS11

September 8, 1991

2VBB-UPS1D LOAD LIST  
 DWG. NO. AE-100G  
 SHEET 20 OF 33

20  
21  
22

23

24  
25  
26  
27



UPS NO: 2VBB-UPS1D  
 PNL NO: 2LAS-PNL016  
 DIST PNL NO: 2LAC-PNLU02  
 CIRCUIT NO: N/A

DRAWING REFERENCES

CE-100B

| FEED TO DEVICE     | BKR NO. | LTG. DWG.   | DEVICE LOCATION                |                   | PLANT IMPACT                |
|--------------------|---------|-------------|--------------------------------|-------------------|-----------------------------|
|                    |         |             | BLDG                           | ELEV              |                             |
| ESSENTIAL LIGHTING | 11      | EE-65C      | CB, CORRIDOR                   | 261               | COVERAGE PROVIDED BY NORMAL |
| ESSENTIAL LIGHTING | 12      | EE-65C      | CB, CORRIDOR                   | 237               | COVERAGE PROVIDED BY NORMAL |
| EXIT LIGHTS        | 13      | EE-65C      | CB                             | 261               | LOSE EXIT LIGHTS            |
| ESSENTIAL LIGHTING | 14      | EE-78A      | ELEC. BAY                      | 261               | COVERAGE PROVIDED BY NORMAL |
| ESSENTIAL LIGHTING | 15      | EE-65C      | CB, STAIRS SW                  | 261<br>279        | NO COVERAGE                 |
| ESSENTIAL LIGHTING | 16      | EE-78A      | ELEC. BAY                      | 261               | COVERAGE PROVIDED BY NORMAL |
| ESSENTIAL LIGHTING | 17      | EE-65C      | CB, VENT EQUIP & HPCS SWG. RMS | 261               | COVERAGE PROVIDED BY NORMAL |
| ESSENTIAL LIGHTING | 18      | EE-66H, 78A | ELEC. BAY                      | 261               | NO COVERAGE STAIRWELL       |
| SPARE              | 19      |             |                                |                   |                             |
| EXIT LIGHTS        | 20      | EE-66H, 78A | ELEC BAY                       | 261               | LOSE EXIT LIGHTS            |
| ESSENTIAL LIGHTING | 21      | EE-65D, 65F | CB, STAIRS SW                  | 288<br>296<br>306 | NO COVERAGE                 |
| SPARE              | 22      |             |                                |                   |                             |

UPS11

September 11, 1991

2VBB-UPS1D LOAD LIST  
 DWG. NO. AE-100G  
 SHEET 21 OF 33



UPS NO: 2VBB-UPS1D  
 PNL NO: 2LAS-PNL016  
 DIST PNL NO: 2LAC-PNLU02  
 CIRCUIT NO: N/A

DRAWING REFERENCES

CE-100B

| FEED TO DEVICE             | BKR<br>NO. | LTG.<br>DWG.                     | DEVICE LOCATION                         |                           | PLANT IMPACT   |
|----------------------------|------------|----------------------------------|---|---------------------------|--|
|                            |            |                                  | BLDG                                    | ELEV                      |  |
| ESSENTIAL LIGHTING         | 23         | EE-<br>65C,<br>65D,E             | CB, STAIRS<br>NE                        | 261<br>288<br>296         | NO COVERAGE  |
| SPARE                      | 24<br>26   |                                  |   |                           |  |
| ESSENTIAL LIGHTING         | 25<br>27   | EE-68C                           | DIESEL GEN<br>RMS                       | 261                       | COVERAGE<br>PROVIDED BY<br>NORMAL & EMERG  |
| SPARE                      | 28<br>30   |                                  |   |                           |  |
| SPARE                      | 29<br>31   |                                  |   |                           |  |
| SPARE                      | 32<br>34   |                                  |   |                           |  |
| SPARE                      | 33<br>35   |                                  |   |                           |  |
| COMMUNICATION<br>EQUIPMENT | 36         | EE-<br>80A,AL<br>AM,AN,<br>AP,AS | NS<br>CB<br>DG<br>115KV &<br>345KV SWYD | 237/261<br>214/237<br>261 | AT EL. 261 LOSE<br>COMM IN REMOTE<br>SHUTDOWN RM BUT<br>STILL HAVE<br>JACKS AT NORM<br>PWR.<br>SEE NOTE 1 & 2,<br>SHEET 33 |

UPS11

September 8, 1991

2VBB-UPS1D LOAD LIST  
 DWG. NO. AE-100G  
 SHEET 22 OF 33



UPS NO: 2VBB-UPS1D  
 PNL NO: 2LAS-PNL016  
 DIST PNL NO: 2LAC-PNLU02  
 CIRCUIT NO: N/A

DRAWING REFERENCES

CE-100B

| FEED TO DEVICE          | BKR NO. | LTG. DWG.    | DEVICE LOCATION |            | PLANT IMPACT  |
|-------------------------|---------|--------------|-----------------|------------|---|
|                         |         |              | BLDG            | ELEV       |   |
| COMMUNICATION EQUIPMENT | 37      | EE-80B,C, AM | CONT BLCG       | 288<br>306 | EL 288 IS COVERED BY 2LAC-PNLU04 IN COMP & RELAY RM ONLY AND AT EL 306 COMM IS LOST IN CORRIDOR AND CABLE RISER AREA. CONTROL RM COMM IS PICKED UP FROM JACKS FROM NORM PWR. SEE NOTE 1&2, SHEET 33 |
| EXIT LIGHTS             | 38      | EE-68C       | DIESEL GEN BLDG | 261        | LOSE EXIT LIGHTS  |
| ESSENTIAL LIGHTING      | 39      | EE-68C       | DIESEL GEN BLDG | 261        | COVERAGE PROVIDED BY NORMAL   |
| ESSENTIAL LIGHTING      | 40      | EE-68C       | DIESEL GEN BLDG | 261        | COVERAGE PROVIDED BY NORMAL   |
| SPARE                   | 41      |              |                 |            |   |
| ESSENTIAL LIGHTING      | 42      | EE-68C       | DIESEL GEN BLDG | 261        | NO COVERAGE PROVIDED SOUTH ENT/EACH BAY   |
|                         |         |              |                 |            |   |
|                         |         |              |                 |            |   |
UPS11

September 11, 1991

2VBB-UPS1D LOAD LIST  
 DWG. NO. AE-100G  
 SHEET 23 OF 33





UPS NO: 2VBB-UPS1D  
 PNL NO: 2LAS-PNL016  
 DIST PNL NO: 2LAR-PNLU03  
 CIRCUIT NO: N/A

DRAWING REFERENCES

CE-100M

| FEED TO DEVICE          | BKR NO. | LTG. DWG.       | <u>DEVICE LOCATION</u>     |                    | PLANT IMPACT                              |
|-------------------------|---------|-----------------|----------------------------|--------------------|---|
|                         |         |                 | BLDG                       | ELEV               |   |
| ESSENTIAL LIGHTING      | 1       | EE-67G          | RX. BLDG                   | 306                | COVERAGE PROVIDED BY NORMAL               |
| ESSENTIAL LIGHTING      | 2       | EE-67G          | RX. BLDG                   | 306                | COVERAGE BY NORMAL                        |
| ESSENTIAL LIGHTING      | 3       | EE-67G          | RX. BLDG                   | 306                | COVERAGE BY NORMAL                        |
| ESSENTIAL LIGHTING      | 4       | EE-67G          | RX. BLDG                   | 306                | COVERAGE BY NORMAL                        |
| SPARE                   | 5       |                 |                            |                    |   |
| ESSENTIAL LIGHTING      | 6       | EE-67H          | RX. BLDG                   | 328                | COVERAGE PROVIDED BY NORMAL               |
| ESSENTIAL LIGHTING      | 7       | EE-67H          | RX. BLDG                   | 328                | COVERAGE PROVIDED BY NORMAL               |
| ESSENTIAL LIGHTING      | 8       | EE-67H          | RX. BLDG                   | 328                | COVERAGE PROVIDED BY NORMAL               |
| ESSENTIAL LIGHTING      | 9       | EE-67H          | RX. BLDG                   | 328                | COVERAGE PROVIDED BY NORMAL               |
| ESSENTIAL LIGHTING      | 10      | EE-67H          | RX. BLDG                   | 328                | COVERAGE PROVIDED BY NORMAL               |
| ESSENTIAL LIGHTING      | 11      | EE-67H          | RX. BLDG                   | 328                | COVERAGE PROVIDED BY NORMAL               |
| COMMUNICATION EQUIPMENT | 12      | EE-80N, P, Q, R | RX. BLDG. PAGE/PARTY JACKS | 240, 261, 289, 306 | LOSE COMMUNICATION SEE NOTE 1&2, SHEET 33 |

UPS11

September 11, 1991

2VBB-UPS1D LOAD LIST  
 DWG. NO. AE-100G  
 SHEET 24 OF 33








UPS NO: 2VBB-UPS1D  
 PNL NO: 2LAS-PNL016  
 DIST PNL NO: 2LAR-PNLU03  
 CIRCUIT NO: N/A

DRAWING REFERENCES

CE-100M

| FEED TO DEVICE          | BKR NO. | LTG. DWG.                      | DEVICE LOCATION               |   | PLANT IMPACT                                  |
|-------------------------|---------|--------------------------------|-------------------------------|---|---|
|                         |         |                                | BLDG                          | ELEV  |   |
| COMMUNICATION EQUIPMENT | 13      | EE-80M, N, P, Q, R, S, T, U, V | RX. BLDG.<br><br>N. AUX. BLDG | 215, 240, 261, 289, 306, 328, 353<br><br>175, 198 | LOSE COMMUNICATIONS SEE NOTE 1&2, SHEET 33    |
| ESSENTIAL LIGHTING      | 14      | EE-67E                         | RX. BLDG STAIRS S.            | 261   | NO COVERAGE IN SOUTH STAIR-TOWER OF RX. BLDG  |
| ESSENTIAL LIGHTING      | 15      | EE-67F, 67G                    | RX. BLDG STAIRS S.            | 289, 306  | NO COVERAGE IN SOUTH STAIR-TOWER OF RX. BLDG. |
| ESSENTIAL LIGHTING      | 16      | EE-67E, 67F, 67G               | RX. BLDG STAIRS N.            | 261, 289, 306                                     | NO COVERAGE IN NORTH STAIR-TOWER OF RX. BLDG  |
| ESSENTIAL LIGHTING      | 17      | EE-67G, 67H                    | RX. BLDG STAIRS N.            | 306, 328  | NO COVERAGE IN SOUTH STAIR-TOWER OF RX. BLDG  |
| ESSENTIAL LIGHTING      | 18      | EE-67G, 67H                    | RX. BLDG STAIRS N.            | 306, 328  | NO COVERAGE IN NORTH STAIR-TOWER OF RX. BLDG  |
| SPARE                   | 19      |                                |                               |   |   |
| ESSENTIAL LIGHTING      | 20      | EE-67J                         | RX. BLDG STAIRS S.            | 353   | NO COVERAGE IN SOUTH STAIR-WAY                |
| SPARE                   | 21      |                                |                               |   |   |

UPS11

September 8, 1991

2VBB-UPS1D LOAD LIST  
 DWG. NO. AE-100G  
 SHEET 25 OF 33



UPS NO: 2VBB-UPS1D  
 PNL NO: 2LAS-PNL016  
 DIST PNL NO: 2LAR-PNLU03  
 CIRCUIT NO: N/A

DRAWING REFERENCES

CE-100M

| FEED TO DEVICE        | BKR<br>NO. | LTG.<br>DWG. | <u>DEVICE LOCATION</u> |                  | PLANT IMPACT                          |
|-----------------------|------------|--------------|------------------------|------------------|---------------------------------------|
|                       |            |              | BLDG                   | ELEV             |                                       |
| ESSENTIAL<br>LIGHTING | 22         | EE-67J       | RX. BLDG<br>STAIRS S.  | 363, 378,<br>394 | NO COVERAGE IN<br>SOUTH STAIR-<br>WAY |
| SPARE                 | 23<br>25   |              |                        |                  |                                       |
| ESSENTIAL<br>LIGHTING | 24         | EE-67J       | RX. BLDG.<br>STAIRS S. | 408, 421,<br>427 | NO COVERAGE IN<br>SOUTH STAIRWAY      |
| SPARE                 | 26         |              |                        |                  |                                       |
| SPARE                 | 27<br>29   |              |                        |                  |                                       |
| SPARE                 | 28<br>30   |              |                        |                  |                                       |
| SPARE                 | 31<br>33   |              |                        |                  |                                       |
| SPARE                 | 32<br>34   |              |                        |                  |                                       |
| SPARE                 | 35<br>37   |              |                        |                  |                                       |
| SPARE                 | 36<br>38   |              |                        |                  |                                       |
| SPARE                 | 39<br>41   |              |                        |                  |                                       |
| SPARE                 | 40<br>42   |              |                        |                  |                                       |

UPS11

September 8, 1991

2VBB-UPS1D LOAD LIST  
 DWG. NO. AE-100G  
 SHEET 26 OF 33

100

100

100

UPS NO: 2VBB-UPS1D  
 PNL NO: 2LAS-PNL016  
 DIST PNL NO: 2LAR-PNL006  
 CIRCUIT NO: N/A

DRAWING REFERENCES

CE-100Q

| FEED TO DEVICE     | BKR NO. | LTG. DWG. | DEVICE LOCATION |                          | PLANT IMPACT  |
|--------------------|---------|-----------|-----------------|--------------------------|---|
|                    |         |           | BLDG            | ELEV                     |   |
| EXIT LIGHTS        | 1       | EE-67K    | ABS             | 175                      | LOSE EXIT LIGHTS  |
| ESSENTIAL LIGHTING | 2<br>4  | EE-67K,L  | ABS             | 175<br>215               | COVERAGE PROVIDED BY NORMAL   |
| ESSENTIAL LIGHTING | 3       | EE-67K,L  | ABS STAIRWELL   | 175,198,<br>215 &<br>240 | NO COVERAGE WITHIN AUX BAY SOUTH STAIRWELL & RX BLDG. ENT. AT STAIRWELL |
| ESSENTIAL LIGHTING | 5       | EE-67K,L  | ABS STAIRWELL   | 175,<br>198,215<br>& 250 | NO COVERAGE WITHIN AUX BAY SOUTH STAIRWELL & RX BLDG. ENT. AT STAIRWELL |
| EXIT LIGHTS        | 6       | EE-67K    | ABS             | 198                      | LOSE EXIT LIGHTS  |
| ESSENTIAL LIGHTING | 7<br>9  | EE-67K,L  | ABS             | 198,240                  | COVERAGE PROVIDED BY NORMAL   |
| EXIT LIGHTS        | 8       | EE-67L    | ABS             | 215,240,<br>261          | LOSE ENT. LIGHTS  |

UPS11

September 11, 1991

2VBB-UPS1D LOAD LIST  
 DWG. NO. AE-100G  
 SHEET 27 OF 33








UPS NO: 2VBB-UPS1D  
 PNL NO: 2LAS-PNL016  
 DIST PNL NO: 2LAR-PNLU06  
 CIRCUIT NO: N/A

DRAWING REFERENCES

CE-100Q

| FEED TO DEVICE     | BKR<br>NO. | LTG.<br>DWG. | DEVICE LOCATION |      | PLANT IMPACT                      |
|--------------------|------------|--------------|-----------------|------|-----------------------------------|
|                    |            |              | BLDG            | ELEV |                                   |
| ESSENTIAL LIGHTING | 10<br>12   | EE-67L       | ABS             | 215  | COVERAGE<br>PROVIDED BY<br>NORMAL |
| ESSENTIAL LIGHTING | 11<br>13   | EE-67L       | ABS             | 240  | COVERAGE<br>PROVIDED BY<br>NORMAL |
| ESSENTIAL LIGHTING | 14         | EE-67L       | ABS             | 250  | COVERAGE<br>PROVIDED BY<br>NORMAL |
| SPARE              | 15         |              |                 |      |                                   |
| SPARE              | 16         |              |                 |      |                                   |
| SPARE              | 17         |              |                 |      |                                   |
| SPARE              | 18         |              |                 |      |                                   |
| SPARE              | 19         |              |                 |      |                                   |
| SPARE              | 20         |              |                 |      |                                   |

UPS11

September 8, 1991

2VBB-UPS1D LOAD LIST  
 DWG. NO. AE-100G  
 SHEET 28 OF 33













UPS NO: 2VBB-UPS1D  
 PNL NO: 2LAS-PNL016  
 DIST PNL NO: 2LAR-PNLU06  
 CIRCUIT NO: N/A

DRAWING REFERENCES

CE-100Q

| FEED TO DEVICE             | BKR<br>NO. | LTG.<br>DWG.           | DEVICE LOCATION    |   | PLANT IMPACT.                                      |
|----------------------------|------------|------------------------|--------------------|---|--|
|                            |            |                        | BLDG               | ELEV  |  |
| COMMUNICATION<br>EQUIPMENT | 21         | EE-<br>80K,L,<br>N,U,V | RX BLDG<br><br>ABS | 175,196,<br>240<br>175,198,<br>215 &<br>240 | LOSE<br>COMMUNICATION<br>SEE NOTE 1&2,<br>SHEET 33 |
| SPARE                      | 22         |                        |                    |   |  |
| SPARE                      | 23<br>25   |                        |                    |   |  |
| SPARE                      | 24<br>26   |                        |                    |   |  |
| SPARE                      | 27<br>29   |                        |                    |   |  |
| SPARE                      | 28<br>30   |                        |                    |   |  |
| SPARE                      | 31<br>33   |                        |                    |   |  |
| SPARE                      | 32<br>34   |                        |                    |   |  |
| SPARE                      | 35<br>37   |                        |                    |   |  |
| SPARE                      | 36<br>38   |                        |                    |   |  |
| SPARE                      | 39<br>41   |                        |                    |   |  |
| SPARE                      | 40<br>42   |                        |                    |   |  |

UPS11

September 8, 1991

2VBB-UPS1D LOAD LIST  
 DWG. NO. AE-100G  
 SHEET 29 OF 33



UPS NO: 2VBB-UPS1D  
 PNL NO: 2LAS-PNL016  
 DIST PNL NO: 2LAT-PNLU03  
 CIRCUIT NO: N/A

DRAWING REFERENCES

CE-100G

| FEED TO DEVICE     | BKR<br>NO. | LTG.<br>DWG. | <u>DEVICE LOCATION</u>           |      | PLANT IMPACT                      |
|--------------------|------------|--------------|----------------------------------|------|-----------------------------------|
|                    |            |              | BLDG                             | ELEV |                                   |
| ESSENTIAL LIGHTING | 1<br>3     | EE-66A       | TURB. BLDG.<br>GRD. FL.          | 250  | COVERAGE<br>PROVIDED BY<br>NORMAL |
| ESSENTIAL LIGHTING | 2<br>4     | EE-66B       | TURB. BLDG.<br>GRD. FL.          | 250  | COVERAGE<br>PROVIDED BY<br>NORMAL |
| ESSENTIAL LIGHTING | 5<br>7     | EE-79B       | RAMP TO<br>SCREENWELL<br>BLDG.   | 250  | COVERAGE<br>PROVIDED BY<br>NORMAL |
| SPARE              | 6<br>8     |              |                                  |      |                                   |
| SPARE              | 9<br>11    |              |                                  |      |                                   |
| ESSENTIAL LIGHTING | 10<br>12   | EE-66B       | TURB. BLDG.<br>GRD. FL.          | 250  | COVERAGE<br>PROVIDED BY<br>NORMAL |
| SPARE              | 13<br>15   |              |                                  |      |                                   |
| SPARE              | 14<br>16   |              |                                  |      |                                   |
| SPARE              | 17<br>19   |              |                                  |      |                                   |
| ESSENTIAL LIGHTING | 18<br>20   | EE-79B       | HTR. BAY<br>"B"                  | 250  | COVERAGE<br>PROVIDED BY<br>NORMAL |
| ESSENTIAL LIGHTING | 21<br>23   | EE-79B       | HTR. BAY<br>"C"                  | 250  | COVERAGE<br>PROVIDED BY<br>NORMAL |
| SPARE              | 22<br>24   |              |                                  |      |                                   |
| ESSENTIAL LIGHTING | 25         | EE-66B       | TURB. BLDG.<br>HEAT EXCH.<br>RM. | 250  | COVERAGE<br>PROVIDED BY<br>NORMAL |

UPS11

September 11, 1991

2VBB-UPS1D LOAD LIST  
 DWG. NO. AE-100G  
 SHEET 30 OF 33



UPS NO: 2VBB-UPS1D  
 PNL NO: 2LAS-PNL016  
 DIST PNL NO: 2LAT-PNLU03  
 CIRCUIT NO: N/A

DRAWING REFERENCES

CE-100G

| FEED TO DEVICE          | BKR NO.  | LTG. DWG.                    | DEVICE LOCATION  |                          | PLANT IMPACT                                 |
|-------------------------|----------|------------------------------|--|--------------------------|--|
|                         |          |                              | BLDG   | ELEV                     |  |
| EXIT LIGHTING           | 26       | EE-66B                       | TURB. BLDG.  | 250                      | LOSE EXIT LIGHTS                             |
| EXIT LIGHTS             | 27       | EE-78B, 78E                  | PIPE TUNNELS   | N/A                      | LOSE EXIT LIGHTS                             |
| COMMUNICATION EQUIPMENT | 28       | EE-80AE, 80AH                | HEATER BAYS<br>PIPE TUNNEL   | 277                      | LOSE COMMUNICATION<br>SEE NOTE 1&2, SHEET 33 |
| COMMUNICATION EQUIPMENT | 29       | EE-80D, E, Z, AD, AH, AJ, AR | TURB. BLDG.,<br>SCREENWELL,<br>HTR. BAY,<br>PIPE TUNNEL<br>SERV. BLDG. | 250<br>261<br>250<br>261 | LOSE COMMUNICATION<br>SEE NOTE 1&2, SHEET 33 |
| ESSENTIAL LIGHTING      | 30       | EE-66B                       | TURB. BLDG.<br>MAINSTEAM<br>CHASE ENT.                                 | 250                      | COVERAGE PROVIDED BY NORMAL                  |
| ESSENTIAL LIGHTING      | 31       | EE-78B                       | PIPE TUNNEL  | N/A                      | COVERAGE PROVIDED BY NORMAL                  |
| ESSENTIAL LIGHTING      | 32       | EE-78E                       | PIPE TUNNEL  | N/A                      | COVERAGE PROVIDED BY NORMAL                  |
| ESSENTIAL LIGHTING      | 33       | EE-78B                       | PIPE TUNNEL  | N/A                      | COVERAGE PROVIDED BY NORMAL                  |
| ESSENTIAL LIGHTING      | 34       | EE-79B                       | HEATER BAY<br>"B" & "C"  | 250                      | COVERAGE PROVIDED BY NORMAL                  |
| ESSENTIAL LIGHTING      | 35<br>37 | EE-79D                       | HEATER BAY<br>"B"  | 250                      | COVERAGE PROVIDED BY NORMAL                  |
| ESSENTIAL LIGHTING      | 36       | EE-78E                       | PIPE TUNNEL  |                          | COVERAGE PROVIDED BY NORMAL                  |

UPS11

September 11, 1991

2VBB-UPS1D LOAD LIST  
 DWG. NO. AE-100G  
 SHEET 31 OF 33



UPS NO: 2VBB-UPS1D  
PNL NO: 2LAS-PNL016  
DIST PNL NO: 2LAT-PNLU03  
CIRCUIT NO: N/A

DRAWING REFERENCES

CE-100G

| FEED TO DEVICE     | BKR<br>NO. | LTG.<br>DWG. | DEVICE LOCATION                              |      | PLANT IMPACT   |
|--------------------|------------|--------------|--|------|--|
|                    |            |              | BLDG   | ELEV |  |
| SPARE              | 38         |              |  |      |  |
| ESSENTIAL LIGHTING | 39<br>41   | EE-79D       | HEATER BAY<br>"C"<br>MAINSTEAM<br>CHASE ENT. | 277  | COVERAGE<br>PROVIDED BY<br>NORMAL EXCEPT<br>IN STAIRWELL |
| SPARE              | 40<br>42   |              |  |      |  |
|                    |            |              |  |      |  |
|                    |            |              |  |      |  |
UPS11

September 8, 1991

2VBB-UPS1D LOAD LIST  
DWG. NO. AE-100G  
SHEET 32 OF 33






**NOTES:**

1. THE HANDSET LOCATIONS OF THE COMMUNICATION SYSTEM HAVE BEEN LOCATED AT POSITIONS TO MEET THE INTENT OF THE NFPA 72D CODE REQUIREMENTS REGARDING THE INSTALLATION OF MANUAL FIRE ALARM PULL STATIONS. AS SUCH, THE LOSS OF COMMUNICATION SYSTEM HANDSETS RESULT IN THE EQUIVALENT LOSS OF MANUAL FIRE ALARM PULL STATIONS.
2. THESE AREAS ARE PROVIDED PARTIAL PAGING COMMUNICATION FROM UPS 2VBB-UPS1C.



# 2VBB-UPS1G LOAD LIST

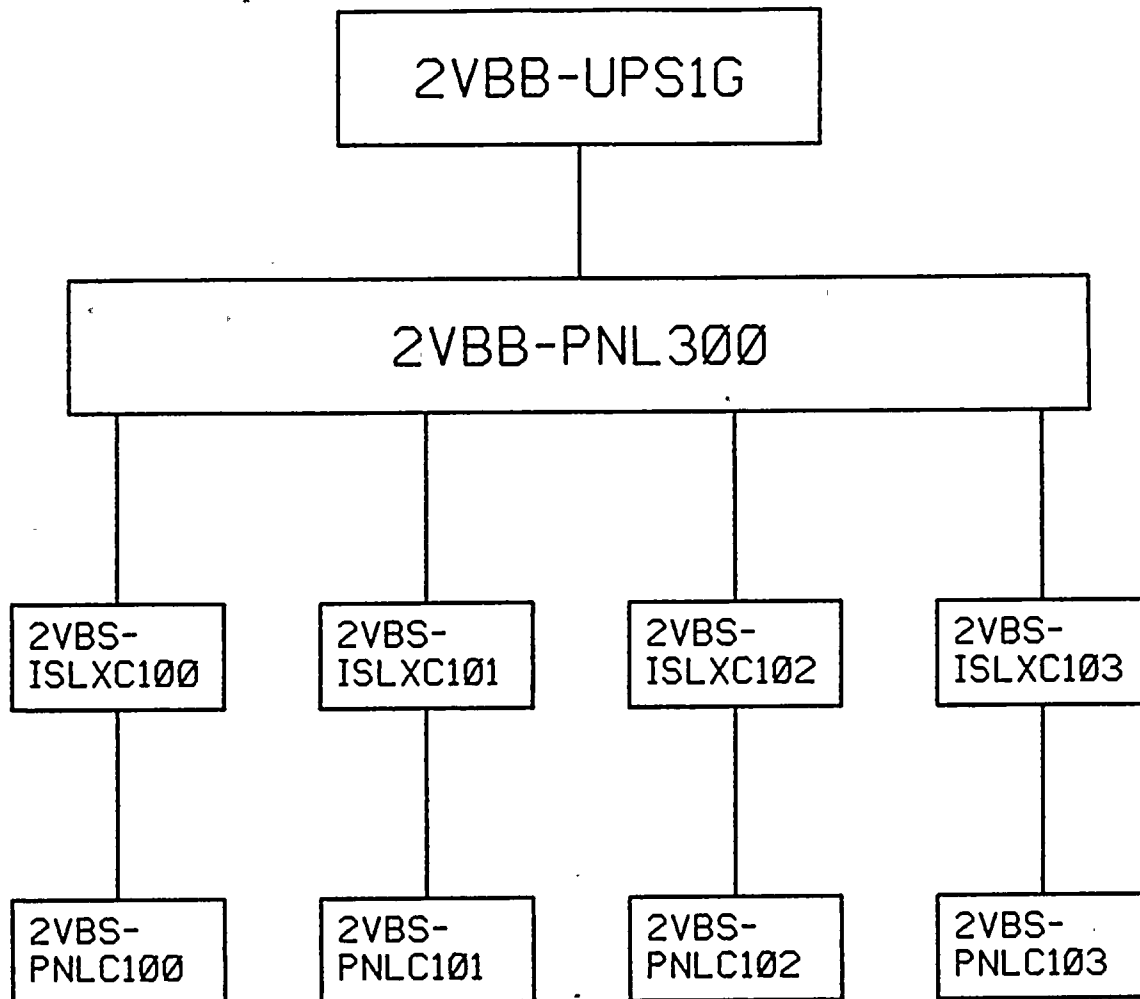

NOTE: THIS DRAWING WAS CREATED USING  
COMPUTER AIDED DRAFTING  
DO NOT MAKE MANUAL CHANGES

NUCLEAR NON-SAFETY RELATED

|               |   |  |
|---------------|---|--|
|               | NINE MILE POINT<br>NUCLEAR STATION - UNIT 2<br>SCRIBA, N.Y. |  |
|               | LOAD LIST   |  |
|               | UNINTERRUPTIBLE POWER SUPPLY                                |  |
|               | 2VBB-UPS1G  |  |
| SHEET 1 OF 18 |   |  |
| SCALE<br>NONE | DRAWING NO<br>AE-100H                                       |  |

|     |         |     |    |                             |           |     |
|-----|---------|-----|----|-----------------------------|-----------|-----|
| 1   | 9-11-91 | JBP |    | ORIGINAL ISSUE-<br>AS BUILT | out<br>KB | def |
| CHK | DATE    | BY  | MF | DESCRIPTION                 | CK        | APP |



# INDEX

| PANEL        | BKR. NO. | SHEET NO. |
|--------------|----------|-----------|
| 2VBS-PNLC100 | 1        | 4         |
|              | 2        | 4         |
|              | 3        | 4         |
|              | 4        | 4         |
|              | 5        | 4         |
|              | 6        | 4         |
|              | 7        | 4         |
|              | 8        | 5         |
|              | 9        | 5         |
|              | 10       | 5         |
|              | 11       | 5         |
|              | 12       | 5         |
|              | 13       | 5         |
|              | 14       | 5         |
|              | 15       | 5         |
|              | 16       | 5         |
|              | 17       | 6         |
|              | 18       | 6,7       |
|              | 19       | 6,8       |
|              | 20       | 6         |
|              | 21       | 6         |
|              | 22       | 6         |
|              | 23       | 6         |
|              | 24       | 6         |
|              | 25       | 6         |
|              | 26       | 6         |
|              | 27       | 6         |
|              | 28       | 6         |
|              |          |           |
| 2VBS-PNLC101 | 1        | 9         |
|              | 2        | 9         |
|              | 3        | 9         |
|              | 4        | 9         |
|              | 5        | 9         |
|              | 6        | 9         |
|              | 7        | 9         |
|              | 8        | 10        |
|              | 9        | 10        |

| PANEL        | BKR. NO. | SHEET NO. |
|--------------|----------|-----------|
| 2VBS-PNLC101 | 10       | 10        |
|              | 11       | 10        |
|              | 12       | 10        |
|              | 13       | 10        |
|              | 14       | 10        |
|              | 15       | 10        |
|              | 16       | 10        |
|              | 17       | 10        |
|              | 18       | 11        |
|              | 19       | 11        |
|              | 20       | 11        |
|              | 21       | 11        |
|              | 22       | 11        |
|              | 23       | 11        |
|              | 24       | 11        |
|              | 25       | 12        |
|              | 26       | 12        |
|              | 27       | 12        |
|              | 28       | 12        |
|              |          |           |
| 2VBS-PNLC102 | 1        | 13        |
|              | 2        | 13        |
|              | 3        | 13        |
|              | 4        | 13        |
|              | 5        | 14        |
|              | 6        | 14        |
|              | 7        | 14        |
|              | 8        | 14        |
|              | 9        | 14        |
|              | 10       | 14        |
|              | 11       | 14        |
|              | 12       | 14        |
|              | 13       | 14        |

(CONTINUED ON SHEET 3)

2VBB-UPS1G LOAD LIST  
DWG. NO. AE-100H  
SHEET 2 OF 18



# INDEX

| PANEL             | BKR. NO. | SHEET NO. |
|-------------------|----------|-----------|
| 2VBS-PNLC102<br>↓ | 14       | 14        |
|                   | 15       | 15        |
|                   | 16       | 15        |
|                   | 17       | 15        |
|                   | 18       | 15        |
|                   | 19       | 15        |
|                   | 20       | 15        |
|                   | 21       | 15        |
|                   | 22       | 15        |
|                   | 23       | 15        |
|                   | 24       | 15        |
|                   | 25       | 15        |
|                   | 26       | 16        |
|                   | 27       | 16        |
|                   | 28       | 16        |
| 2VBS-PNLC102      |          |           |

|              |    |    |
|--------------|----|----|
| 2VBS-PNLC103 | 1  | 17 |
|              | 2  | 17 |
|              | 3  | 17 |
|              | 4  | 17 |
|              | 5  | 17 |
|              | 6  | 17 |
|              | 7  | 17 |
|              | 8  | 17 |
|              | 9  | 17 |
|              | 10 | 17 |
|              | 11 | 17 |
|              | 12 | 17 |
|              | 13 | 17 |
|              | 14 | 17 |
|              | 15 | 17 |
|              | 16 | 17 |
|              | 17 | 17 |
|              | 18 | 17 |
|              | 19 | 18 |
|              | 20 | 18 |
|              | 21 | 18 |
| 2VBS-PNLC103 | 22 | 18 |

| PANEL             | BKR. NO. | SHEET NO. |
|-------------------|----------|-----------|
| 2VBS-PNLC103<br>↓ | 23       | 18        |
|                   | 24       | 18        |
|                   | 25       | 18        |
|                   | 26       | 18        |
|                   | 27       | 18        |
|                   | 28       | 18        |
|                   |          |           |
|                   |          |           |
| 2VBS-PNLC103      |          |           |

2VBB-UPS1G LOAD LIST  
DWG. NO. AE-100H  
SHEET 3 OF 18

12-28-54

1

2

12-28-54

3



UPS NO: 2VBB-UPS1G  
 PNL NO: 2VBB-PNL300  
 DIST PNL NO: 2VBS-PNLC100  
 CIRCUIT NO: N/A

**DRAWING REFERENCES**  
 EE-27B

| FEED TO DEVICE | BKR NO. | CONN. DWG.        | DEVICE LOCATION |       | PLANT IMPACT   |
|----------------|---------|-------------------|-----------------|-------|--|
|                |         |                   | BLDG.           | ELEV. |  |
| 2CEC-CP600     | 1       | EE-11J<br>EE-11BH | CRR             | 288   | LOSE BOP CENTRAL PROCESSING UNIT - "A" (PMS COMPUTER) INTEGRAL PART TO SPECIFIC SPDS AND/OR 3D MONICORE FUNCTIONS    |
| 2CEC-CP603     | 2       | EE-11J<br>EE-11BH | CRR             | 288   | LOSE BOP LARGE CORE STORAGE CABINET NO. 1 (PMS COMPUTER) INTEGRAL PART TO SPECIFIC PSDS AND/OR 3D MONICORE FUNCTIONS |
| 2CEC-CP612     | 3       | EE-11J<br>EE-11BH | CRR             | 288   | LOSE DISPLAY GENERATION CABINET (PMS COMPUTER)   |
| 2CEC-CP608     | 4       | EE-11J<br>EE-11BH | CRR             | 288   | LOSE MAGNETIC TAPE NO. 1 CABINET. LONG TERM DATA STORAGE (PMS COMPUTER)  |
| 2CEC-CP619     | 5       | EE-11J<br>EE-11BH | CRR             | 288   | LOSE NSSS ANALOG/DIGITAL I/O CABINET (PMS COMPUTER) INTEGRAL PART TO SPECIFIC SPDS AND/OR 3D MONICORE FUNCTIONS      |
| 2CEC-CP620     | 6       | EE-11J<br>EE-11BH | CRR             | 288   | LOSE NSSS DIGITAL I/O CABINET (PMS COMPUTER) INTEGRAL PART TO SPECIFIC SPDS AND/OR 3D MONICORE FUNCTIONS             |
| 2CEC-CP607     | 7       | EE-11J<br>EE-11BH | CRR             | 288   | LOSE COMMON CORE MEMORY (PMS COMPUTER)   |

UPS19

September 9, 1991

2VBB-UPS1G LOAD LIST  
 DWG. NO. AE-100H  
 SHEET 4 OF 18

24  
12

24  
12

UPS NO: 2VBB-UPS1G  
 PNL NO: 2VBB-PNL300  
 DIST PNL NO: 2VBS-PNLC100  
 CIRCUIT NO: N/A

DRAWING REFERENCES  
 EE-27B

| FEED TO DEVICE | BKR NO. | CONN. DWG.        | <u>DEVICE LOCATION</u> |       | PLANT IMPACT  |
|----------------|---------|-------------------|------------------------|-------|---|
|                |         |                   | BLDG.                  | ELEV. |   |
| 2CEC-CP624     | 8       | EE-11J<br>EE-11BH | CRR                    | 288   | LOSE BOP DIGITAL I/O CABINET NO. 3 (PMS COMPUTER)   |
| 2CEC-CP622     | 9       | EE-11J<br>EE-11BH | CRR                    | 288   | LOSE BOP DIGITAL I/O CABINET NO. 1 (PMS COMPUTER) INTEGRAL PART TO SPECIFIC SPDS AND/OR 3D MONICORE FUNCTIONS. LOSE SIGNAL OUTPUT TO SERVICE WATER PEN RECORDERS REQUIRED FOR STATE DEC. (2SWP-FR602) |
| 2CEC-CP6261    | 10      | EE-11J<br>EE-11BH | CRR                    | 288   | LOSE BOP DIGITAL I/O CABINET NO. 5 (PMS COMPUTER)   |
| 2CEC-CP625     | 11      | EE-11J<br>EE-11BH | CRR                    | 288   | LOSE BOP DIGITAL I/O CABINET NO. 4 (PMS COMPUTER)   |
| 2CEC-CP617     | 12      | EE-11J<br>EE-11BH | CRR                    | 288   | LOSE BOP ANALOG INPUT CABINET NO. 4 (PMS COMPUTER)  |
| 2CEC-CP616     | 13      | EE-11J<br>EE-11BH | CRR                    | 288   | LOSE BOP ANALOG INPUT CABINET NO. 4 (PMS COMPUTER)  |
| 2CEC-RCTP1     | 14      | EE-11J<br>EE-11BH | CSA                    | 261   | CABLE SPARED ON ELEV. 261   |
| 2CEC-CP618     | 15      | EE-11J<br>EE-11BH | CRR                    | 288   | LOSE BOP ANALOG INPUT CABINET NO. 5 (PMS COMPUTER)  |
| 2CEC-RCPT2     | 16      | EE-11J<br>EE-11BH | CRR                    | 288   | CABLE SPARED IN FALSE FLOOR   |

UPS19

September 9, 1991

2VBB-UPS1G LOAD LIST  
 DWG. NO. AE-100H  
 SHEET 5 OF 18




































UPS NO: 2VBB-UPS1G  
 PNL NO: 2VBB-PNL300  
 DIST PNL NO: 2VBS-PNLC100  
 CIRCUIT NO: N/A

DRAWING REFERENCES

EE-27B

EE-27A

| FEED TO DEVICE | BKR NO. | CONN. DWG.        | DEVICE LOCATION |       | PLANT IMPACT   |
|----------------|---------|-------------------|-----------------|-------|--|
|                |         |                   | BLDG.           | ELEV. |  |
| 2CEC-RCPT10    | 17      | EE-11J<br>EE-11BH | CCR             | 306   | CABLES ON ELEV. 306<br>SPARED IN FALSE FLOOR                                     |
| 2EPG*PNL101    | 18      | EE-8DS<br>EE-11J  | DG              | 261   | DSL GEN DIV 1 GETARS<br>INPUT SIGNALS LOSS OF<br>ALL FUNCTIONS. SEE<br>ATTACHED. |
| 2EPG*PNL103    | 19      | EE-8DS<br>EE-11J  | DG              | 261   | DSL GEN DIV 2 GETARS<br>INPUT SIGNALS LOSS OF<br>ALL FUNCTIONS. SEE<br>ATTACHED  |
| SPARE          | 20      |                   |                 |       |  |
| SPARE          | 21      |                   |                 |       |  |
| SPARE          | 22      |                   |                 |       |  |
| SPARE          | 23      |                   |                 |       |  |
| SPARE          | 24      |                   |                 |       |  |
| SPARE          | 25      |                   |                 |       |  |
| SPARE          | 26      |                   |                 |       |  |
| SPARE          | 27      |                   |                 |       |  |
| SPARE          | 28      |                   |                 |       |  |

UPS19

September 9, 1991

2VBB-UPS1G LOAD LIST  
 DWG. NO. AE-100H  
 SHEET 6 OF 18



UPS NO: 2VBB-UPS1G  
 PNL NO: 2VBB-PNL300  
 DIST. PNL NO: 2VBS-PNLC100  
 BKR NO: 18  
 CIRCUIT NO: 2EGPA09/28XSA01

DRAWING REFERENCES

0001420-221-098  
 EE-8DR, 14B, 11J, 3KY  
 ESK-8EGP01, 02, 04  
 ESK-10SX802

| FEED TO DEVICE   | <u>DEVICE LOCATION</u> |       | PLANT IMPACT  |
|--|------------------------|-------|---|
|  | BLDG.                  | ELEV. |   |
| 2EGP*PNL101<br>DIESEL GEN. DIV. 1<br>GETARS INPUT SIGNAL                 | DG                     | 261   | LOSS OF THE GETARS' ABILITY TO<br>MONITOR DIV. 1 DIE. GEN. WATTS,<br>VARS, FREQ, DC FIELD VOLTS, AC<br>VOLTS, AND SPEED, LOSS OF ALL<br>FUNCTIONS |
| 2CES*PNL517<br>STARTUP<br>TESTING/TRANSIENT<br>ANALYSIS RECORDING<br>SYS | CB                     | 237   |   |

UPS19

September 9, 1991

2VBB-UPS1G LOAD LIST  
 DWG. NO. AE-100H  
 SHEET 7 OF 18





UPS NO: 2VBB-UPS1G  
 PNL NO: 2VBB-PNLC100  
 DIST PNL NO: 2VBS-PNLC100  
 BKR NO: 19  
 CIRCUIT NO: 2EGPB09/28XSB01

DRAWING REFERENCES  
 EE-11J, 8DS  
 ESK-8EGP03, 108XS03

| FEED TO DEVICE   | <u>DEVICE LOCATION</u> |       | PLANT IMPACT   |
|--|------------------------|-------|--|
|  | BLDG.                  | ELEV. |  |
| 2EGP*PNL103<br>DIESEL GEN. DIV. 2<br>GETARS INPUT SIGNAL                 | DG                     | 261   | LOSS OF THE GETARS' ABILITY TO<br>MONITOR DIV. II DIE. GEN. WATTS,<br>VARS, FREQ, DC FIELD VOLTS, AC<br>VOLTS, AND SPEED, LOSS OF ALL<br>FUNCTIONS |
| 2CES*PNL519<br>STARTUP<br>TESTING/TRANSIENT<br>ANALYSIS RECORDING<br>SYS | CB                     | 237   |  |

UPS19

September 9, 1991

2VBB-UPS1G LOAD LIST  
 DWG. NO. AE-100H  
 SHEET 8 OF 18



UPS NO: 2VBB-UPS1G  
 PNL NO: 2VBB-PNL300  
 DIST PNL NO: 2VBS-PNLC101  
 CIRCUIT NO: N/A

DRAWING REFERENCES  
 EE-27B

| FEED TO DEVICE   | BKR<br>NO. | CONN.<br>DWG. | <u>DEVICE LOCATION</u> |      | PLANT IMPACT   |
|------------------|------------|---------------|------------------------|------|--|
|                  |            |               | BLDG                   | ELEV |  |
| 2CEC-CP601       | 1          | EE-11BH       | CRR                    | 288  | LOSS OF POWER TO CENTRAL PROCESSING UNIT-"B" (PMS COMPUTER) INTEGRAL PART. TO SPECIFIC SPDS AND/OR 3D-MONICORE FUNCTIONS |
| 2CEC-CP604       | 2          | EE-11BH       | CRR                    | 288  | LOSS OF POWER TO LARGE CORE STORAGE CABINET NO. 2 INTEGRAL PART TO SPECIFIC SPDS AND/OR 3D-MONICORE FUNCTIONS            |
| 2CEC-RCPT6 SPARE | 3          | EE-11BH       | CRR                    | 288  |  |
| 2CEC-CP656       | 4          | EE-11BH       | CRR                    | 288  | LOSS OF POWR TO MAGNETIC TAPE CABINET NO. 2 (PROCESS COMPUTER) LONG TERM DATA STORAGE                                    |
| 2CEC-CP623       | 5          | EE-11BH       | CRR                    | 288  | LOSS OF POWER TO DIGITAL I/O CABINET, BOP NO. 2  |
| 2CEC-CP627       | 6          | EE-11BH       | CRR                    | 288  | LOSS OF POWER TO DIGITAL I/O CABINET, BOP NO. 6  |
| 2CEC-CP628       | 7          | EE-11BH       | CRR                    | 288  | LOSS OF POWER TO DIGITAL I/O CABINET, BOP NO. 7  |





UPS NO: 2VBB-UPS1G  
 PNL NO: 2VBB-PNL300  
 DIST PNL NO: 2VBS-PNLC101  
 CIRCUIT NO: N/A

DRAWING REFERENCES  
 CE-27B

| FEED TO DEVICE                | BKR<br>NO. | CONN.<br>DWG. | DEVICE LOCATION |      | PLANT IMPACT   |
|-------------------------------|------------|---------------|-----------------|------|--|
|                               |            |               | BLDG            | ELEV |  |
| 2CEC-CP610                    | 8          | EE-11BH       | CRR             | 288  | LOSS OF POWER TO DIGITAL I/O CABINET, BOP NO. 8                        |
| 2CEC-CP611                    | 9          | EE-11BH       | CRR             | 288  | LOSS OF POWER TO DIGITAL I/O CABINET, BOP NO. 9                        |
| 2CEC-CP621                    | 10         | EE-11BH       | CRR             | 288  | LOSS OF POWER TO DIGITAL I/O CABINET, BOP NO. 10                       |
| 2CEC-CP640                    | 11         | EE-11BH       | CRR             | 288  | LOSS OF POWER TO DIGITAL I/O CABINET, BOP NO. 11                       |
| 2CEC-CP613                    | 12         | EE-11BH       | CRR             | 288  | LOSS OF POWR TO ANALOG INPUT CABINET, NSSS NO. 3                       |
| 2CEC-CP614                    | 13         | EE-11BH       | CRR             | 288  | LOSS OF POWER TO ANALOG INPUT CABINET, BOP NO. 1                       |
| 2CEC-CP615                    | 14         | EE-11BH       | CRR             | 288  | LOSS OF POWER TO ANALOG INPUT CABINET, BOP NO. 2                       |
| 2CEC-RCPT3<br>2CEC-CP864      | 15         | EE-11BH       | CRR             | 288  | LOSS OF POWER TO DRMS CPU-2 PRINTER                                    |
| 2CEC-RCPT4<br>2CEC-CP863      | 16         | EE-11BH       | CRR             | 288  | LOSS OF POWER TO DRMS CPU-1 PRINTER                                    |
| 2CEC-RCPT5<br>2CEC-CP638, 862 | 17         | EE-11BH       | CRR             | 288  | LOSS OF POWER TO PROCESS COMPUTER CARD READER AND DRMS PROGRAM CONSOLE |

UPS19

September 9, 1991

2VBB-UPS1G LOAD LIST  
 DWG. NO. AE-100H  
 SHEET 10 OF 18



UPS NO: 2VBB-UPS1G  
 PNL NO: 2VBB-PNL300  
 DIST PNL NO: 2VBS-PNLC101  
 CIRCUIT NO: N/A

DRAWING REFERENCES  
 EE-27B

| FEED TO DEVICE                              | BKR<br>NO. | CONN.<br>DWG. | <u>DEVICE LOCATION</u> |      | PLANT IMPACT  |
|---|------------|---------------|------------------------|------|---|
|   |            |               | BLDG                   | ELEV |   |
| 2CEC-RCPT7<br>2CEC-KYBD600,<br>DSPL605, 606 | 18         | EE-<br>11BH   | CRR                    | 288  | LOSS OF POWER<br>TO OPERATOR'S<br>KEYBOARD,<br>OPERATOR'S<br>MONITOR, AND<br>ALARM MONITOR<br>(PROCESS<br>COMPUTER) |
| 2CEC-RCPT8<br>2CEC-KYBD601,<br>DSPL609      | 19         | EE-<br>11BH   | CRR                    | 288  | LOSS OF POWER<br>TO UTILITY<br>KEYBOARD AND<br>MONITOR<br>(PROCESS<br>COMPUTER)                                     |
| 2CEC-RCPT9<br>2CEC-CP633, 634,<br>636       | 20         | EE-<br>11BH   | CRR                    | 288  | LOSS OF POWER<br>TO LOG PRINTER,<br>UTILITY<br>PRINTER, AND<br>ALARM PRINTER<br>(PROCESS<br>COMPUTER)               |
| 2CEC-CP657                                  | 21         | EE-<br>11BH   | CRR                    | 288  | LOSS OF POWER<br>TO SWITCHING<br>CABINET<br>(PROCESS<br>COMPUTER)   |
| SPARE                                       | 22         |               |                        |      |   |
| SPARE                                       | 23         |               |                        |      |   |
| SPARE                                       | 24         |               |                        |      |   |





UPS NO: 2VBB-UPS1G  
 PNL NO: 2VBB-PNL300  
 DIST PNL NO: 2VBS-PNLC101  
 CIRCUIT NO: N/A

DRAWING REFERENCES  
 EE-27B

| FEED TO DEVICE | BKR<br>NO. | CONN.<br>DWG. | DEVICE LOCATION |      | PLANT IMPACT |
|----------------|------------|---------------|-----------------|------|--------------|
|                |            |               | BLDG            | ELEV |              |
| SPARE          | 25         |               |                 |      |              |
| SPARE          | 26         |               |                 |      |              |
| SPARE          | 27         |               |                 |      |              |
| SPARE          | 28         |               |                 |      |              |
|                |            |               |                 |      |              |
|                |            |               |                 |      |              |
|                |            |               |                 |      |              |

UPS19

September 9, 1991

2VBB-UPS1G LOAD LIST  
 DWG. NO. AE-100H  
 SHEET 12 OF 18



UPS NO: 2VBB-UPS1G  
 PNL NO: 2VBB-PNL300  
 DIST PNL NO: 2VBS-PNLC102  
 CIRCUIT NO: N/A

DRAWING REFERENCES  
 EE-27B

| FEED TO DEVICE              | BKR<br>NO. | CONN<br>DWG.          | <u>DEVICE LOCATION</u> |           | PLANT IMPACT   |
|-----------------------------|------------|-----------------------|------------------------|-----------|--|
|                             |            |                       | BUILDING               | ELEVATION |  |
| 2IHS-PNL105<br>ERF COMPUTER | 1          | EE-<br>11GH<br>EE-3NF | CRR                    | 288       | POWER TO ERF<br>COMPUTER INPUT<br>PANEL, LOSS OF<br>INPUTS WHICH<br>SUPPORT SAFETY<br>PARAMETER<br>DISPLAY SYSTEM<br>(SPDS) AND<br>EMERGENCY<br>RESPONSE<br>FACILITY (ERF)<br>FUNCTIONS. |
| 2IHS-PNL106<br>ERF COMPUTER | 2          | EE-<br>11GH<br>EE-3ND | CRR                    | 288       | POWER TO ERF<br>COMPUTER INPUT<br>PANEL, LOSS OF<br>INPUTS WHICH<br>SUPPORT SAFETY<br>PARAMETER<br>DISPLAY SYSTEM<br>(SPDS) AND<br>EMERGENCY<br>RESPONSE<br>FACILITY (ERF)<br>FUNCTIONS. |
| 2IHS-PNL107<br>ERF COMPUTER | 3          | EE-<br>11GH<br>EE-3NP | CRR                    | 288       | POWER TO ERF<br>COMPUTER INPUT<br>PANEL, LOSS OF<br>INPUTS WHICH<br>SUPPORT SAFETY<br>PARAMETER<br>DISPLAY SYSTEM<br>(SPDS) AND<br>EMERGENCY<br>RESPONSE<br>FACILITY (ERF)<br>FUNCTIONS. |
| 2CEC-RCPT 23<br>2CEC-CP652  | 4          | EE-<br>11GH           | CRR                    | 288       | POWER TO DRMS<br>2CEC-CP652  |

UPS19

September 9, 1991

2VBB-UPS1G LOAD LIST  
 DWG. NO. AE-100H  
 SHEET 13 OF 18

100

100

100

UPS NO: 2VBB-UPS1G  
 PNL NO: 2VBB-PNL300  
 DIST PNL NO: 2VBS-PNLC102  
 CIRCUIT NO: N/A

DRAWING REFERENCES  
 EE-27B

| FEED TO DEVICE                            | BKR NO. | CONN DWG.         | DEVICE LOCATION<br>BUILDING ELEVATION |     | PLANT IMPACT  |
|---|---------|-------------------|---------------------------------------|-----|---|
| 2CEC-RCPT 24<br>2CEC-CP851                | 5       | EE-11GH           | CRR                                   | 288 | DRMS MAIN PROCESSOR #1 POWER  |
| 2CEC-RCPT 25<br>2CEC-CP850                | 6       | EE-11GH           | CRR                                   | 288 | DRMS COMPUTER I/O CAB. 1 POWER, LOSE PORTION OF MONITORING CAPABILITIES |
| 2CEC-RCPT 26<br>2CEC-CP853                | 7       | EE-11GH           | CRR                                   | 288 | DRMS MAIN PROCESSOR #2 POWER, LOSE PORTION OF MONITORING CAPABILITIES   |
| 2CEC-RCPT 27<br>2CEC-CP854                | 8       | EE-11GH           | CRR                                   | 288 | DRMS COMPUTER I/O CAB. 2 POWER  |
| 2CEC-RCPT20<br>2CEC-CP861                 | 9       | EE-11GH           | CRR                                   | 288 | POWER TO DRMS DATA LOGGER   |
| 2CEC-CP860                                | 10      | EE-11GH<br>EE-4CM | CRR                                   | 288 | POWER TO DRMS ENGR. CONSOLE   |
| 2CEC-RCPT 11<br>2IHS-<br>DSPL102, KYBD102 | 11      | EE-11GH           | CCR                                   | 306 | COMPUTER KEYBOARD/DISPLAY   |
| 2CEC-RCPT 14<br>2RMS-<br>DSPL175, KYBD175 | 12      | EE-11GH           | CCR                                   | 306 | COMPUTER KEYBOARD/DISPLAY   |
| 2CEC-RCPT 16<br>2LWS-CP457                | 13      | EE-11GH           | CCR                                   | 306 | COMPUTER KEYBOARD/DISPLAY   |
| 2CEC-RCPT 18<br>2MMS-DSPL106, CP107       | 14      | EE-11GH           | CCR                                   | 306 | POWER TO METEOROLOGICAL MONITOR   |

UPS19

September 9, 1991

2VBB-UPS1G LOAD LIST  
 DWG. NO. AE-100H  
 SHEET 14 OF 18































UPS NO: 2VBB-UPS1G  
 PNL NO: 2VBB-PNL300  
 DIST PNL NO: 2VBS-PNLC102  
 CIRCUIT NO: N/A

DRAWING REFERENCES  
 EE-27B

| FEED TO DEVICE           | BKR NO. | CONN DWG.          | DEVICE LOCATION<br>BUILDING ELEVATION |     | PLANT IMPACT  |
|--------------------------|---------|--------------------|---------------------------------------|-----|---|
| 2FPM-PNL201              | 15      | EE-11GH<br>EE-18AC | CRR                                   | 288 | AC POWER TO PANEL 2FPM-PNL201 FIRE PROTECTION SYSTEM, LOSS OF MONITORING FUNCTIONS  |
| 2FPM-PNL200              | 16      | EE-11GH<br>EE-18AC | CRR                                   | 288 | AC POWER TO PANEL 2FPM-PNL200 FIRE PROTECTION SYSTEM, LOSS OF MONITORING FUNCTIONS. |
| 2SXS-RCPT1<br>2SXS-CB204 | 17      | EE-11GH            | CCR                                   | 306 | GETARS COMPUTER CAB/ POWER  |
| 2CEC-RCPT35              | 18      | EE-11GH            | CRR                                   | 288 | RECEPTACLES FOR COMPUTER EQUIP.   |
| 2CEC-RCPT 36             | 19      | EE-11GH            | CRR                                   | 288 | RECEPTACLES FOR COMPUTER EQUIP.   |
| 2CEC-RCPT 37             | 20      | EE-11GH            | CRR                                   | 288 | RECEPTACLES FOR COMPUTER EQUIP.   |
| 2CEC-RCPT 39             | 21      | EE-11GH            | CRR                                   | 288 | RECEPTACLES FOR COMPUTER EQUIP.   |
| 2CEC-RCPT 41             | 22      | EE-11GH            | CRR                                   | 288 | RECEPTACLES FOR COMPUTER EQUIP.   |
| 2CEC-RCPT 40             | 23      | EE-11GH            | CRR                                   | 288 | RECEPTACLES FOR COMPUTER EQUIP.   |
| SPARE                    | 24      |                    |                                       |     |   |
| SPARE                    | 25      |                    |                                       |     |   |

UPS19

September 9, 1991

2VBB-UPS1G LOAD LIST  
 DWG. NO. AE-100H  
 SHEET 15 OF 18

100

100

100

100

100

100

100

100



UPS NO: 2VBB-UPS1G  
PNL NO: 2VBB-PNL300  
DIST PNL NO: 2VBS-PNLC102  
CIRCUIT NO: N/A

DRAWING REFERENCES  
EE-27B

| FEED TO DEVICE | BKR<br>NO. | CONN<br>DWG. | DEVICE LOCATION |           | PLANT IMPACT |
|----------------|------------|--------------|-----------------|-----------|--------------|
|                |            |              | BUILDING        | ELEVATION |              |
| SPARE          | 26         |              |                 |           |              |
| SPARE          | 27         |              |                 |           |              |
| SPARE          | 28         |              |                 |           |              |
|                |            |              |                 |           |              |
|                |            |              |                 |           |              |
UPS19

September 9, 1991

2VBB-UPS1G LOAD LIST  
DWG. NO. AE-100H  
SHEET 16 OF 18

100

1

100

100

100

100

100

UPS NO: 2VBB-UPS1G  
 PNL NO: 2VBB-PNL300  
 DIST PNL NO: 2VBS-PNLC103  
 CIRCUIT NO: N/A

DRAWING REFERENCES

EE-27A

| FEED TO DEVICE                                    | BKR NO. | CONN DWG.         | DEVICE LOCATION<br>BUILDING ELEVATION |     | PLANT IMPACT         |
|---|---------|-------------------|---------------------------------------|-----|----------------------|
| 2RMS-PNL187                                       | 1       | EE-4CM<br>EE-11GH | TB                                    | 306 | LOSE HP-2<br>CONSOLE |
| 2RMS-RCPT1<br>2RMS-CP186                          | 2       | EE-11GH           | TB                                    | 306 | LOSE HP-2<br>PRINTER |
| 2RMS-RCPT2<br>COUNTING RM RCPT.                   | 3       | EE-11GH           | TB                                    | 306 | LOSE<br>RECEPTACLES  |
| 2RMS-RCPT6<br>RECEPTACLE FOR<br>COUNTING RM TABLE | 4       | EE-11GH           | TB                                    | 306 | LOSE<br>RECEPTACLES  |
| 2RMS-RCPT10<br>COUNTING RM RCPT                   | 5       | EE-11GH           | TB                                    | 306 | LOSE<br>RECEPTACLES  |
| SPARE   | 6       |                   |                                       |     |                      |
| SPARE   | 7       |                   |                                       |     |                      |
| SPARE   | 8       |                   |                                       |     |                      |
| SPARE   | 9       |                   |                                       |     |                      |
| SPARE   | 10      |                   |                                       |     |                      |
| SPARE   | 11      |                   |                                       |     |                      |
| SPARE   | 12      |                   |                                       |     |                      |
| SPARE   | 13      |                   |                                       |     |                      |
| SPARE   | 14      |                   |                                       |     |                      |
| SPARE   | 15      |                   |                                       |     |                      |
| SPARE   | 16      |                   |                                       |     |                      |
| SPARE   | 17      |                   |                                       |     |                      |
| SPARE   | 18      |                   |                                       |     |                      |

UPS19

September 9, 1991

2VBB-UPS1G LOAD LIST  
 DWG. NO. AE-100H  
 SHEET 17 OF 18











UPS NO: 2VBB-UPS1G  
 PNL NO: 2VBB-PNL300  
 DIST PNL NO: 2VBS-PNLC103  
 CIRCUIT NO: N/A

| FEED TO DEVICE | BKR<br>NO. | CONN<br>DWG. | DEVICE LOCATION |           | PLANT IMPACT |
|----------------|------------|--------------|-----------------|-----------|--------------|
|                |            |              | BUILDING        | ELEVATION |              |
| SPARE          | 19         |              |                 |           |              |
| SPARE          | 20         |              |                 |           |              |
| SPARE          | 21         |              |                 |           |              |
| SPARE          | 22         |              |                 |           |              |
| SPARE          | 23         |              |                 |           |              |
| SPARE          | 24         |              |                 |           |              |
| SPARE          | 25         |              |                 |           |              |
| SPARE          | 26         |              |                 |           |              |
| SPARE          | 27         |              |                 |           |              |
| SPARE          | 28         |              |                 |           |              |
|                |            |              |                 |           |              |
|                |            |              |                 |           |              |
UPS19

September 9, 1991

2VBB-UPS1G LOAD LIST  
 DWG. NO. AE-100H  
 SHEET 18 OF 18

