

BEAVER VALLEY POWER STATION, UNIT 1

REPORT ON THE
REANALYSIS OF SAFETY-RELATED PIPING SYSTEMS

FOR

BEAVER VALLEY UNIT 1
DUQUESNE LIGHT COMPANY

ORIGINAL - JUNE 15, 1979

REVISION 1 - JULY 11, 1979

541 042

Stone & Webster Engineering Corporation
Boston, Massachusetts

7907130

413

P

BEAVER VALLEY POWER STATION, UNIT 1

If a seismic event which results in accelerations greater than acceleration level of 0.01g occurs during the period of interim operation, the plant will be shut down for inspection of those piping systems and supports which have not been shown to be fully acceptable for the OBE case. As discussed in the FSAR, Section 5.2.8.1, the accelerometers are initiated and recording started at a setpoint of 0.01 g acceleration. All seismic monitoring instrumentation is demonstrated operable in accordance with the test methods and testing frequencies specified in Table 4.3-4 of the Technical Specifications. The seismic instrumentation will be checked prior to startup.

This report addresses details of the analysis work, results of pipe and support analyses to date, presents a discourse on conservatism, and discusses other topics within the scope of the reanalysis task. The report represents all work to date and is in addition to other submittals previously forwarded since the Order to Show Cause.

The seismic reanalysis is based on piping analysis programs, SHOCK3 and NUPIPE, that use methodology currently acceptable to the NRC. The results to date indicate that the subject systems will be able to perform their intended safety functions under the maximum seismic conditions specified in the Final Safety Analysis Report. The reanalysis effort has demonstrated the conservative nature of the original seismic analysis. The piping systems have been found to be impacted only slightly after thorough, rigorous reanalysis.

541 043

BEAVER VALLEY POWER STATION, UNIT 1

Results to date also show that no piping of any size will have to be replaced or repaired.

Abbreviations used in this report are defined in Table 1-1.

541 044

BEAVER VALLEY POWER STATION, UNIT 1

TABLE 1-1

ABBREVIATIONS

| | |
|------------|---|
| S_{LP} | = Pressure Stress |
| S_{DL} | = Deadload Stress |
| S_h | = Allowable Stress at Maximum (Hot) Temperature |
| S_{OBET} | = Total Stress under OBE Condition |
| S_{DBET} | = Total Stress under DBE Condition |
| S_{DBEI} | = Inertial Effect of DBE |
| S_a | = Allowable Stress |
| S_y | = Yield Strength |
| S_u | = Ultimate Strength |
| S_{th} | = Thermal Stress |

541 045

BEAVER VALLEY POWER STATION, UNIT 1

SECTION 3

RESPONSES TO NRC LETTERS AND ADDITIONAL QUESTIONS

The following four questions were raised by NRC personnel during a visit to the Beaver Valley Unit 1 project at S&W, June 5-7, 1979. Each NRC question is followed by the response.

NRC Questions

1. Indicate the frequency range over which the new SSI-ARS is not enveloped by the previous spectra. Discuss the effect this has on components, equipment, and piping analyzed to the old spectra.

Response

The problems listed below with the system piping frequency and period use the old ARS curve as the run of record. A review of the curves included in this section which indicated a comparison between the peak spread SSI curve vs the old ARS curve shows that none of these problems except as noted fall into the period range where the SSI curve is not enveloped by the old ARS curve.

541 046

BEAVER VALLEY POWER STATION, UNIT 1

| Problem | Frequency | Period |
|------------|-------------------------|------------------|
| <u>No.</u> | <u>(cycles/seconds)</u> | <u>(seconds)</u> |
| 100 | 9.16 | .11 |
| 179 | 10.87 | .09 |
| 215 | 5.42 | .18 |
| 101 | 4.98 | .20 |
| 3063 | 9.51 | .11 |
| 204 | 13.17 | .08 |
| 785 | 3.78 | .26 |
| 157 | 13.42 | .07 |
| 158 | 23.95 | .04 |
| 212 | 10.47 | .10 |
| 228 | 8.71 | .11 |
| 229 | 9.41 | .11 |
| 2112 | 3.31 | .30 |
| 610 | 16.22 | .06 |
| 612 | 16.66 | .06 |
| 3011 | 3.87 | .25 |
| 1 | 5.73 | .18 |

Problems 785, 3011, and 1 presently fall into the area where the SSI curve is not enveloped by the old ARS.

541 047

BEAVER VALLEY POWER STATION, UNIT 1

A review of Problem No. 785 (Feedwater System) indicates that 72.6 percent of the allowable seismic OBE stress was attained using the original amplified response spectrum. Therefore, a substantial increase, 1.38 times for the OBE, would still be acceptable. The portion of the SSE curve for the horizontal earthquakes that exceeds the acceleration values of the original ARS is not seen by the piping system. For the vertical earthquake, the increase in acceleration is 20 percent which would still result in acceptable stress levels. For the DBE case, the horizontal accelerations increase 1.4 times and the vertical accelerations increase 1.2 times. These values are seen by the piping system and would result in stress levels below the allowable stress.

$$\begin{aligned} \text{Problem No. 785:} \quad S_{LP} + S_{DL} &= 4832 \quad ; \quad S_h = 15000 \\ S_{LP} + S_{DL} + S_{OBET} &= 14397 \quad ; \quad 1.2 S_h = 18000 \\ S_{LP} + S_{DL} + S_{DBET} &= 20232 \quad ; \quad 1.8 S_h = 27000 \end{aligned}$$

A review of Problem No. 3011 (Residual Heat Removal System) indicates that 98 percent of the allowable seismic OBE stress was attained using the original amplified response spectrum. For the DBE case, only 62 percent of the allowable stress was exhausted. Therefore, an increase of 1.02 times for the OBE and 1.61 times for the DBE case would be acceptable. A comparison of the original ARS with the SSI-ARS indicates that the acceleration values of the SSI-ARS not bounded by the original ARS were in a frequency range not experienced by the piping system. The

541 048

BEAVER VALLEY POWER STATION, UNIT 1

only exception to this is for the DBE case where the acceleration values of the Y-direction earthquake increased. The acceleration values for the first and second modes increased 1.17 and 1.5 times, respectively. This is within the 1.61 allowable increase given above. The contribution of the Y-direction earthquake is minor due to the rigidity of the system to the vertical response.

$$\begin{aligned} \text{Problem No. 3011: } S_{LP} + S_{DL} &= 4144 ; S_h = 14950 \\ S_{LP} + S_{DL} + S_{OBET} &= 17656 ; 1.2 S_h = 17940 \\ S_{LP} + S_{DL} + S_{DBET} &= 18148 ; 1.8 S_h = 26910 \end{aligned}$$

A review of Problem No. 1 (River Water System) indicates that only 54.3 percent of the allowable seismic OBE stress was attained using the original amplified response spectrum. Similarly for the DBE case, 46.5 percent of the allowable was used. Therefore, a substantial increase, 1.84 times for OBE condition and 2.15 for the DBE condition, would be acceptable. For the OBE case, a comparison of the original ARS and the SSI-ARS indicates a slight increase in acceleration values for the SSI curve. This increase is only for the Y-direction earthquake, which does not contribute heavily to the overall response of the system.

For the DBE case, the comparison of the curves indicated an increase in the X-, Y-, and Z-direction earthquake acceleration values. However, the

541 049

BEAVER VALLEY POWER STATION, UNIT 1

stress margin [2.15] readily accommodates this increase. Problem No. 1 does not have any supports.

$$\begin{aligned}\text{Problem No. 1: } S_{LP} + S_{DL} &= 2244 ; S_h = 15000 \\ S_{LP} + S_{DL} + S_{OBET} &= 10801 ; 1.2 S_h = 18000 \\ S_{LP} + S_{DL} + S_{DBET} &= 13754 ; 1.8 S_h = 27000\end{aligned}$$

The following ARS for the intake structure have not been peak spread; however, the problems (157, 158) using these curves have been reviewed and the system frequency is well beyond the spread peak.

A review of procedures used for the qualification of Seismic Category I equipment and the potential effect of SSI-ARS indicates that the original plant qualifications basis is conservative and that increased margins of safety would generally result from the use of SSI-ARS. This conclusion is confirmed by comparison of the original plant ARS with SSI-ARS and by review of procedures and seismic data used for the original equipment qualification basis.

Procedures used for the qualification of Seismic Category I equipment are described in BVPS FSAR Section B.2.2. These procedures resulted in qualification programs being implemented for balance-of-plant equipment. Mechanical equipment was principally qualified by static analysis

BEAVER VALLEY POWER STATION, UNIT 1

techniques and instrumentation and electrical equipment by shake table tests.

The original plant ARS was conservatively used for both analytical and test qualification programs. A review of the original plant ARS on a building-by-building and elevation-by-elevation basis indicated that peak resonant responses occurred below 10 Hz and that amplification of ground motion principally occurred below 20 Hz for structures housing Seismic Category I equipment. For each building a "cutoff frequency" was selected (i.e., 10 or 20 Hz) in order to identify seismic acceleration levels above and below the cutoff frequency for calculational purposes. The "g" level identified below the cutoff frequency was a minimum of 1.3 times (Ref. FSAR Question 3.15) the peak ARS response. At the cutoff frequency the rigid range g value was conservatively selected. Equipment having a natural frequency below the cutoff frequency was qualified to an equivalent static acceleration of 1.3 times the peak ARS response. When equipment frequency characteristics were rigid (above the cutoff frequency) the maximum rigid range g values were used. For tested equipment, the maximum rigid range g levels were conservatively used for qualification.

A comparison of the ARS used for the original plant design with the SSI-ARS indicates that the original plant ARS are conservative based upon the

541 051

BEAVER VALLEY POWER STATION, UNIT 1

above seismic specification of static g values for qualification by static analysis and testing. Seismic Category I equipment was qualified on this conservative basis.

Seismic qualification of Seismic Category I equipment may also be established by the response spectrum modal analysis or seismic testing (Test Response Spectra) techniques. For these options, the ARS used for the original plant design provide the appropriate seismic definition for qualification. In this regard it is noted that peaks of the SSI-ARS are significantly lower than the peaks of the original plant ARS. The SSI-ARS peaks occur in the 2 to 5 Hz region for all structures evaluated and there is little amplification of maximum floor acceleration above 10 Hz. In some isolated cases the SSI-ARS curves exceed the original plant ARS in the low frequency region (below 5 Hz) distant from peak original ARS responses. This breaching of the original ARS would only potentially affect equipment whose natural frequency is below 5 Hz. One item, the outside recirculating spray pumps, was found which exhibited natural frequencies below 5 Hz. This component was qualified by dynamic analysis using the original plant ARS. It was concluded to be seismically qualified on the basis of a significant reduction of the primary modes response. Seismic Category I equipment which exhibits natural frequencies in excess of 5 Hz cannot be affected.

541 052

Based on this discussion it is concluded that the ARS used for original plant design provide an acceptable basis for qualification of Seismic Category I equipment.

Components loaded by piping systems are reviewed by analytical techniques described above. Each components nozzle is first reviewed to assure local component integrity. Loads for all nozzles were combined with the component seismic response to assure adequacy of component supports (near term). All components required for near term have been qualified to their revised loadings. Each component's seismic response was not revised to reflect changes due to SSI consideration. This is extremely conservative and facilitated an expeditious review of nozzle load data.

2. Indicate which code or what criteria is used for the evaluation of local stresses and whether anything different from the original analysis is being done in this respect.

Response

Local stresses are those induced at welded attachments to pipe, such as lugs or trunnions. Criteria for local stress evaluation are established through application of Welding Research Council Bulletin 107 (WRC-107).

541 053

This method of analysis is consistent with the original analysis performed.

3. Indicate whether eccentricities, e.g., valve center of gravities, are accounted for in the piping analyses.

Response

The eccentricity of the operators on all motor-operated and air-operated valves is included in the pipe stress analysis/review.

4. If interim operation is proposed, indicate how I&E Bulletin 79-02 will be addressed prior to startup for any support which contains base plates and concrete expansion anchor bolts, which are not found to be completely acceptable.

Response

Duquesne Light Company has a program underway for inspecting base plate and anchor bolts in the plant. Those supports which at this time are not completely acceptable have been included as priority items for this inspection.

541 054

NRC Letter

The following are responses to questions raised in an NRC letter (Appendix 2) from Mr. D.G. Eisenhut to Mr. C.N. Dunn of Duquesne Light Company.

1. Indicate whether both OBE and DBE seismic stresses always include stresses due to seismic anchor movements (if any) and show how they are combined; e.g., sum of the absolute values. Is anything being done differently now than was done in the original SHOCK2 analysis? Your answer should include an explanation of the second paragraph of page B. 2-2 of the FSAR.

Response

For the reanalysis effort, the effects of the seismic anchor displacements have been evaluated statically and separately from the inertia effect. Static analysis is performed for each direction of relative displacement and for each earthquake, leading to a total of six evaluations. Internal moments resulting from the three evaluations for each earthquake are combined by SRSS on a component level and are then combined with the inertia effects by absolute summation, also on a component level. This procedure differs from the SHOCK2 procedure in that the SHOCK2 program utilized a single static analysis for each earthquake that incorporated the anchor movements in each of three directions simultaneously with the

BEAVER VALLEY POWER STATION, UNIT 1

equivalent inertia forces resulting from the intramodal and then the intermodal summation procedures of SHOCK2.

Calculated stresses in Table 4-1 include the effect of anchor displacement combined with inertia effects with the resulting response then combined and deadload and pressure stresses to form the total stress which is compared to the allowable stress, as follows:

$$S_{LP} + S_{DL} + S_{OBET} \leq 1.2 S_h$$

$$S_{LP} + S_{DL} + S_{DBET} \leq 1.8 S_h$$

Problem No. 120 (River Water System) has been evaluated for the DBE case as follows:

$$S_{LF} + S_{DL} + S_{DBEI} \leq 1.8 S_h$$

At the time the Beaver Valley 1 procedures were formulated, the B31.1 code did not address seismic design in the sense of providing detailed rules for stress determination and load combinations. Further, the code did not deal with Normal, Upset, Emergency, and Faulted stress limits. Since that time, development of B31.7 and ASME III have addressed these rules and limits.

541 056

BEAVER VALLEY POWER STATION, UNIT 1

Current rules allow two significant departures from the original techniques utilized on Beaver Valley Unit 1.

- A. An option is provided for Upset Conditions whereby the anchor displacement effect can be considered in equation 9 along with deadweight, pressure, and seismic inertia effects or they may be combined with thermal expansion effects and evaluated under equation 10.
 - B. For Emergency and Faulted Conditions, the codes require evaluation of only the primary portion (inertia effect) of the seismic loadings and do not require that the anchor displacement effect be considered, since it is secondary in nature. Also allowed is a Faulted Stress allowable of $2.4 S_h$, which was not stated in the Beaver Valley Unit 1 licensing documents; the equivalent value utilized was $1.8 S_h$.
2. State how support stiffness is being accounted for in the current reanalysis effort and whether anything different from the original analysis is being done in this respect.

541 057

Response

Reanalysis efforts are utilizing two programs, SHOCK3 and NUPIPE. If SHOCK3 is utilized, supports and restraints are modeled in the manner of SHOCK2 as rigid members, essentially allowing zero deflection in each restrained direction. When NUPIPE is utilized, representative spring stiffnesses are input in each restrained direction.

Consistent support stiffnesses are used for each problem.

3. Provide the acceptance criteria used in the design of the pipe supports, including weld and bolt sizing criteria, and indicate any deviations from criteria originally used (except criteria established in addressing I&E Bulletin 79-02). Also, state your intention to comply, prior to facility startup, with I&E Bulletin 79-02 for all cases where loading on a pipe support increases as a result of the piping reanalysis and the support reevaluation indicates that any part of the support is not within the applicable acceptance criteria.

541 058

Response

Acceptance criteria used in the design of pipe supports are shown in Table 3-1. Allowable loads for drilled-in-concrete anchor bolts are shown in Table 3-2. These criteria are being utilized for the reevaluation effort except under the conditions of Section 2 which addresses interim startup conditions.

Duquesne Light Company has a program underway that addresses the following items as a plan of action to comply with IE Bulletin 79-02 for those pipe supports requiring modifications based upon pipe stress analysis described in this report.

- a. Where pipe support reanalysis results in new supports, the base plates and anchor bolts shall be designed incorporating IE Bulletin 79-02 criteria.
- b. Where pipe support reanalysis results in modifications to existing supports, the base plates and anchor bolts shall be evaluated incorporating IE Bulletin 79-02 criteria.
- c. Field inspections shall be performed on those existing base plates being modified in order to ensure bolt integrity.

541 059

4. Discuss the impact the current piping stress reanalysis effort has on the FSAR pipe break criteria. Indicate whether postulated pipe break locations could or have change(d) as a result of the reanalyses and, if so, what you propose to do in the event a break location previously not designed for must be postulated.

Response

The reanalysis performed to date to the licensed acceptance criteria indicates that stress patterns have not changed significantly since maximum stresses occur at points of stress intensification, such as elbows and branch connections.

A detailed review of these problems indicates that the first five highest stress points occur at points of stress intensification. They also occur in those areas where the lines are fully restrained by pipe whip restraints and therefore no additional restraints are required.

FSAR Section 5.2.6.3 states that break locations have been postulated for only the main steam and feedwater inside containment and Appendix D of the FSAR states that breaks need only be postulated in the main steam and feedwater systems outside containment.

541 060

BEAVER VALLEY POWER STATION, UNIT 1

NRC Letter

The following are responses to questions raised in a second NRC letter, dated May 25, 1979 (Appendix G) also from Mr. D.G. Eisenhut to Mr. C.N. Dunn of Duquesne Light Company.

1. All pipe runs analyzed with SHOCK2 must be identified.

Response

Appendixes A and B identify problems originally analyzed with SHOCK2. Appendix A lists those problems addressed for interim startup and Appendix B lists those problems to be analyzed in the long term.

2. Request the following full size drawings:

RM-21B

RM-27A, B

RM-29A, B, C, D

RM-37A

RM-39A, B

541 061

BEAVER VALLEY POWER STATION, UNIT 1

Response

Full size drawings were provided to the NRC by S&W during the meeting at S&W on June 5, 1979.

3. Reanalysis of the primary component cooling water heat exchanger discharge piping.

Lines: 18"-WR-14-151 Q3
18"-WR-15-151 Q3
18"-WR-16-151 Q3
30"-WR-17-151 Q3

Failure of any of these lines would result in flooding of redundant safety related equipment.

Response

These lines have been added to the problems for interim startup. Problem No. 121 includes:

18"-WR-14-151-Q3
18"-WR-15-151-Q3

541 062

BEAVER VALLEY POWER STATION, UNIT 1

18"-WR-16-151-Q3

30"-WR-17-151-Q3

Problem No. 122 includes:

30"-WR-17-151-Q3

4. Reanalysis of the following lines located in the intake structure.

30"-WR-171-151-Q3

30"-WR-172-151-Q3

30"-WR-175-151-Q3

18"-WR-154-151-Q3

12"-WR-177-151-Q3

10"-SWW-14-151-Q3

10"-SWW-1-121*

Failure of any of these lines could result in possible flooding of safety related pumps. The asterisked line, unlike the other lines, was not considered safety-related during the plant design and was never seismically analyzed. This line runs above and adjacent to River Water Pump 1B and can only be isolated from the seismically designed piping by a

541 063

BEAVER VALLEY POWER STATION, UNIT 1

manually operated butterfly valve which is normally open during plant operation.

Response

These lines have been added to the problems for interim startup. Problem No. 152 includes:

30"-WR-171-151-Q3

30"-WR-172-151-Q3

30"-WR-175-151-Q3

Problem No. 160, which overlaps problem No. 159, includes:

18"-WR-154-151-Q3

Problem No. 161 includes:

12"-WR-177-151-Q3

541 064

BEAVER VALLEY POWER STATION, UNIT 1

Problem No. 165 includes:

10"-SWW-14-151-Q3

10"-SWW-1-121

5. The cooling water discharge lines from the emergency diesel generator cooling system heat exchangers downstream of the normal open isolation valves are not seismically qualified. These lines are located in the diesel generator compartments and their failure could impact on the operation of the emergency diesels. A seismic analysis should be performed on these lines.

Response

The cooling water discharge lines, which are less than 6 inches, were not analyzed on SHOCK2 but were hand calculated and seismically supported based on standard spacing between supports.

6. The discharge lines of the quench spray pumps have not been proposed for reanalysis.

10"-QS-3-153-Q3

10"-QS-4-153-Q3

541 065

BEAVER VALLEY POWER STATION, UNIT 1

8"-QS-22-153-Q3

8"-QS-23-153-Q3

Justify that reanalysis of the above lines is not necessary.

Response

The discharge lines of the quench spray pumps were seismically analyzed on NUPIPE for the DBE plus water hammer loads previous to the present reanalysis effort; consequently, these lines were not included in this reanalysis effort. The OBE case for which the SHOCK2 run is the calculation of record will be rerun in the long term reanalysis.

7. The recirculation spray piping both inside and outside containment with the exception of the lines listed below is not being reanalyzed. Justify that reanalysis of the recirculation spray system is not necessary.

12"-RS-5-153-Q3

12"-RS-7-153-Q3

12"-RS-8-153-Q3

541 066

BEAVER VALLEY POWER STATION, UNIT 1

Response

The recirculation spray lines were seismically analyzed on NUPIPE previous to the present reanalysis; consequently, these lines were not included in this reanalysis effort. The OBE case for which the SHOCK2 run is the calculation of record will be rerun on the long term reanalysis.

8. Verify that the discharge lines from the control room air condition condensers, the charging pump, coolers, and line 6"-WR-53-151-Q3 have been seismically analyzed by an acceptable method. These lines are part of the river water system.

Response

The discharge lines were not analyzed on SHOCK2, but were hand calculated and seismically supported based on standard spacing between supports.

Additional NRC Questions

The following questions were raised during a telephone conversation among Duquesne Light Company, Stone & Webster, and NRC personnel on June 28, 1979.

541 067

BEAVER VALLEY POWER STATION, UNIT 1

1. It appears that Table B-2 contains some problems which should be addressed in the short term.

Response

The problems previously included in Table B-2 have been rereviewed in depth and, as a result, the short-term effort has been revised to include the following:

Problem 213

Problem 2113

Problem 616

Problem 651

Problem 652

Problem 653

Problem 301 (Comprised of Problems 308, 3007, 3008, 3013 and 3014)

The following problems have been found to be checks of the hand calculations of record and have been transferred to Table B-3:

541 068

BEAVER VALLEY POWER STATION, UNIT 1

| | | |
|------|------|------|
| 310 | 3021 | 3131 |
| 312 | 3031 | |
| 341B | 3035 | |
| 655C | 3043 | |
| 840 | 3100 | |
| 965 | 3127 | |

Problem 139 was voided because the line was not required to be seismically supported.

2. For those problems not included in the interim scope, what is the consequence of a failure?

Response

The systems which are not included in the interim scope are (1) component cooling water system outside containment, (2) fuel pool purification and cooling system, and (3) quench and recirculation spray system.

The component cooling water (CC) system outside containment has been evaluated using the short-term criteria with the following results:

541 069

Problem 171, the supply to the CC heat exchangers has one support (H-65) out of 15 which has a local overstress of 4 percent. Problem 270, the discharge from the CC heat exchangers has one support (H-56) out of 13 which has a local overstress in a lug of 78 percent. It is considered that, if a DBE were to occur, failure of these two supports would not cause a system rupture or a resultant loss of function.

The fuel pool cooling and purification system is presently isolated since there is no spent fuel being stored.

The quench and recirculation spray systems have been completely analyzed for DBE and water hammer loads using NUPIPE. The OBE case will be run in the long term.

3. How have stress intensification factors been applied at branch connections during the reanalysis?

Response

Appropriate stress intensifications from B31.1 have been applied to the run pipe at reduced outlet branch connections. Branches which are uncoupled have been evaluated for the effects of the movements of the run

pipe using appropriate stress intensification. The thermal and seismic displacements of the run pipe are applied at the branch with the stresses being determined by the use of a flexibility nomograph. The stresses are then compared to code allowables.

4. In the SSI Report, where do the building displacements come from? Which data sets were used and what are the bases for their selection?

Response

The building acceleration and displacement profiles, illustrated in Figures 4-11 and 4-12 of the Report on "Soil-Structure Interaction in the Development of Amplified Response Spectra for Beaver Valley Power Station Unit 1," are maxima from the time history responses at each mass point in the structural dynamic model and are determined automatically by the FRIDAY computer program. They are based on the FSAR earthquake, the strain-compatible free-field soil properties from the final iteration of the SHAKE computer program, and a structural damping ratio of 0.02. This is consistent with the basis used for generation of Amplified Response Spectra (ARS) and conservative with respect to soil properties associated with broadened and 'bumped' ARS, referred to under Item 7, Section 9.5 of the report. Displacements calculated on this basis are, therefore, reasonable for use in the reevaluation of piping systems.

5. Provide a general statement relative to the selection of an amplified response spectrum at the highest support location versus the center of gravity of the piping system.

Response

Appendix B2.1 (page B2.2) of the FSAR states that Beaver Valley Unit 1 dynamic piping stress analysis is based on a response spectra curve closest to, but higher than, the center of gravity of the piping system. However, the procedure that is being implemented on the reanalysis effort, that is, to use the amplified response spectra at the highest pipe support elevation is always conservative, because the ARS at the highest support location will always result in higher acceleration levels than at the center of gravity.

For the reanalysis to date, only two problems have used ARS curves which have been applied just above the center of gravity of the piping system. These two problems are the pressurizer relief valve discharge lines (833) and the pressurizer spray line (1200); both systems encompass a large elevational change from termination to termination. In these two cases, it has been deemed to be more reasonable to use an ARS curve close to the center of gravity of the system, rather than at the highest support location.

BEAVER VALLEY POWER STATION, UNIT 1

TABLE 3-1

PIPE SUPPORT ACCEPTANCE CRITERIA

| <u>Load Combination</u> | <u>Tension</u> | <u>Shear</u> | <u>Column Buckling</u> | <u>Welds</u> |
|-------------------------|----------------|----------------|------------------------|--------------|
| <u>Maximum of:</u> | | | | |
| DL + TH + OBET | 0.8 Sy | 0.513 Sy (web) | Note (1) | 0.3 Su |
| <u>or</u> | | 0.53 Sy | | |
| DL + TH + DBET | | | | |

Note (1): Column buckling criteria are established by Euler equations and are a function of $\left(\frac{kl}{r}\right)$ in accordance with Table 1-36, p 5-84 of AISC.

541 073

BEAVER VALLEY POWER STATION, UNIT 1

TABLE 3-2

DRILLED-IN-CONCRETE ANCHOR BOLT ALLOWABLE LOADS

1. Red head self-drill type S, and type JS installed in 3,000 psi concrete; see Attachment A, Tables I and II, respectively.

For reductions in allowable loads due to closer spacing, see Attachment A, Tables III and IV, respectively.

2. Star slugin compounded cinch anchor bolts and ring wedge cinch anchors; see Attachment A, Tables V and VI, respectively.
3. Hilti or Phillips wedge type anchor bolts are as follows:

| <u>Bolt Diameter</u> | <u>Allowable Tension (lbs)</u> | <u>Loads Shear (lbs)</u> |
|--------------------------|--|----------------------------------|
| 3/8" | 950 | 1150 |
| 1/2" | 2185 | 2180 |
| 5/8" | 2145 | 2845 |
| 3/4" | 3525 | 3800 |
| 7/8" | 4100 | 4585 |
| 1" | 5710 | 6780 |

The one-third increase does not apply to drilled-in-concrete anchor bolts.

4. Anchor bolt tension and shear interaction equation:

$$\left(\frac{T}{T_A} \right)^{5/3} + \left(\frac{S}{S_A} \right)^{5/3} \leq 1.0$$

Where T/T_A and S/S_A are the ratios of the actual over the allowable for tension and shear, respectively.

541 074

TABLE 3-2 (Cont)

ATTACHMENT A
TABLES I & II

TABLE I

| Cat. No. | | | Bo" Dia. | Anchor Data | | INSTALLED IN CONCRETE | | | | | | | | INSTALLED IN GRADED CONCRETE BLOCKS ^(c) | |
|----------------|---------------|-------|----------|---------------------|---------------------|----------------------------|------|------|------|------------------------|------|------|---------|---|------|
| | | | | | | ALLOWABLE PULLOUT VALUES | | | | ALLOWABLE SHEAR VALUES | | | | | |
| | | | | | | I. C. B. O. ⁽¹⁾ | | | | I. C. B. O. | | | | | |
| Self- Drill | Man- Drill | 1/4" | O.D. | Depth | 2000 ⁽¹⁾ | 2500 | 3000 | 3500 | 2000 | 2500 | 3000 | 3500 | PULLOUT | SHEAR | |
| | | | | | | | | | | | | | | | |
| S-14 | J-14 | 1/4" | 7/16" | 1-3/32" 1-1/8" | 410 | 455 | 500 | 540 | 490 | 490 | 490 | 490 | 375 | 550 | 340 |
| S-16 | — | 5/16" | 15/32" | 1-5/16" | 575 | 660 | 750 | 840 | 770 | 770 | 770 | 770 | 550 | 800 | 500 |
| S-18 | J-18 | 3/8" | 9/16" | 1-17/32" 1-9/16" | 800 | 910 | 1020 | 1140 | 1000 | 1100 | 1100 | 1100 | 750 | 900 | 740 |
| S-12 | J-12 | 1/2" | 11/16" | 2-1/32" 2-1/16" | 1210 | 1380 | 1550 | 1720 | 1187 | 1350 | 1550 | 1750 | 1150 | 1100 | 880 |
| S-18 | J-18 | 5/8" | 27/32" | 2-15/32" 2-9/16" | 1550 | 1780 | 2000 | 2230 | 1400 | 1600 | 1820 | 2020 | 1450 | 1300 | 1060 |
| S-24 | J-24 | 3/4" | 1" | 3-1/4" 3-3/16" | 1880 | 2120 | 2350 | 2570 | 1670 | 1900 | 2120 | 2370 | 1700 | 1600 | 1300 |
| S-28 | — | 7/8" | 1-1/8" | 3-11/16" | 2050 | 2330 | 2630 | 2900 | 2050 | 2230 | 2500 | 2800 | 1800 | 2000 | 1600 |

TABLE II

| | | | | INSTALLED IN CONCRETE | | | | | | | | | |
|----------|-----------|---------------|--------|--------------------------|------------|------|------|------|------------------------|------|------|------|------|
| | | | | ALLOWABLE PULLOUT VALUES | | | | | ALLOWABLE SHEAR VALUES | | | | |
| | | | | I. C. B. O. | | | | | I. C. B. O. | | | | |
| Cat. No. | Bolt Dia. | Drilling Data | | Bolt Dia. | Hole Depth | 2000 | 2500 | 3000 | 3500 | 2000 | 2500 | 3000 | 3500 |
| | | | | | | | | | | | | | |
| J5-14 | 1/4" | 1/4" | 1-5/8" | | | 390 | 450 | 530 | 540 | 490 | 490 | 490 | 490 |
| J5-36 | 3/8" | 3/8" | 1-7/8" | | | 570 | 665 | 775 | 885 | 570 | 620 | 720 | 825 |
| J5-12 | 1/2" | 1/2" | 2-1/4" | | | 840 | 975 | 1130 | 1300 | 750 | 830 | 910 | 1000 |
| J5-58 | 5/8" | 5/8" | 2-3/4" | | | 1150 | 1320 | 1540 | 1775 | 1000 | 1100 | 1250 | 1370 |
| J5-34 | 3/4" | 3/4" | 3-1/4" | | | 1800 | 2080 | 2100 | 2300 | 1500 | 1650 | 1800 | 1950 |



APPROVED BY:  

NOTES: 1. All column headings refer to 28 day strength of stone aggregate concrete.

2. Quoted from International Conference of Building Officials report #1372.6.

3. Allowable loads apply to anchors installed in fully grouted cells. Values are for concrete masonry units conforming to U.B.C. standard No. 24-4-64 with special inspection. Without special inspection use 50 per cent of listed values.

**PULLOUT CAPACITIES OF PHILLIPS RED HEAD CONCRETE ANCHORS AS
AFFECTED BY SPACING**

In compliance with the request of the client, Doberne & Elgenson conducted a series of tests to develop the information used in this report. The test facilities of the Smith-Emery Company, an independent testing laboratory, were used.

The purpose of these tests was to determine the load holding characteristics of Phillips anchors under various spacing arrangements.

Results

1. When the spacing between adjacent anchors reaches a distance equal to several times the anchor diameter, there is no loss in capacity. The following table shows the minimum center-to-center spacing that could be used with each anchor without causing a loss in individual capacity.

TABLE III

| Anchor Bolt Size | 1/4" | 5/16" | 3/8" | 1/2" | 5/8" | 3/4" | 7/8" |
|-----------------------------------|------|--------|------|------|------|------|------|
| Minimum Spacing for 100% capacity | 3" | 3-1/4" | 4" | 5" | 6" | 7" | 8" |

2. When the center-to-center spacing, as shown in the above table is reduced, the capacity of the individual anchor decreases.

The following table shows center-to-center spacing corresponding to a 20% reduction in individual anchor capacity.

TABLE IV

| Anchor Bolt Size | 1/4" | 5/16" | 3/8" | 1/2" | 5/8" | 3/4" | 7/8" |
|----------------------------------|--------|--------|------|--------|------|--------|------|
| Minimum Spacing for 80% Capacity | 1-1/2" | 1-5/8" | 2" | 2-1/2" | 3" | 3-1/2" | 4" |

Dimensions of blocks used for tests were 8" x 8" x 16" with an average compressive strength of 2650 psi.

541 076
POOR ORIGINAL

TABLE 3-2 (Cont)

ATTACHMENT A
TABLES V & VI

TABLE V

| STAR SLUG IN COMPOUNDED CINCH ANCHOR BOLTS (THREADED OR PLAIN TYPE) | | | | | | | | | | | |
|--|--------|--------|--------|--------|--------|--------|--------|--------|--------|--------|--------|
| Bolt size | 1/4" | 3/8" | 1/2" | 5/8" | 3/4" | 7/8" | 1" | 1 1/8" | 1 1/4" | 1 1/2" | 1 3/4" |
| Drill size and hole diameter | 1/2" | 3/4" | 1" | 1 1/8" | 1 1/4" | 1 1/2" | 1 3/4" | 2" | 2 1/8" | 2 1/4" | 2 3/8" |
| Minimum depth of hole (2 unit set) | 1 1/4" | 1 1/2" | 1 3/4" | 2" | 2 1/8" | 2 1/4" | 2 3/4" | 3" | 3 1/8" | 3 1/4" | 3 3/8" |
| Shear strength of bolt in lbs. - U.T. 50,000 lbs | 600 | 1550 | 2850 | 4550 | 6200 | 9450 | 12400 | 16800 | 21700 | 26700 | 35300 |
| Breaking strain of bolt in lbs. - U.T. 60,000 lbs | 1750 | 4800 | 8200 | 13150 | 19650 | 27200 | 35800 | 45000 | 57800 | 64000 | 84000 |
| Safe load for each one unit set | 125 | 300 | 400 | 725 | 800 | 850 | 900 | 900 | 900 | 900 | 900 |
| Safe load for each two unit set | 250 | 600 | 800 | 1450 | 1600 | 1700 | 1800 | 1800 | 1800 | 1800 | 1800 |
| Safe load for each three unit set | 375 | 900 | 1200 | 2175 | 2400 | 2550 | 2700 | 2700 | 2700 | 2700 | 2700 |
| Safe load for each four unit set | 500 | 1200 | 1600 | 2900 | 3200 | 3400 | 3600 | 3600 | 3600 | 3600 | 3600 |
| Safe load for each five unit set | 625 | 1500 | 2000 | 3625 | 4000 | 4250 | 4500 | 4500 | 4500 | 4500 | 4500 |
| Safe load for each six unit set | 750 | 1800 | 2400 | 4350 | 4800 | 5100 | 5400 | 5400 | 5400 | 5400 | 5400 |

* Based on a safety factor of 10 to 1. Safe loads for anchors are for tension or shear

TABLE VI

| RING WEDGE CINCH ANCHORS | | | | | | | | | | | |
|---|--------|--------|--------|--------|--------|--------|--------|--------|--------|--------|--------|
| Bolt size | 1/4" | 3/8" | 1/2" | 5/8" | 3/4" | 7/8" | 1" | 1 1/8" | 1 1/4" | 1 1/2" | 1 3/4" |
| Area of bolt at shank | .047 | .110 | .196 | .307 | .448 | .601 | .785 | .994 | 1.227 | 1.767 | 2.364 |
| Area of bolt at thread | .027 | .068 | .126 | .202 | .302 | .419 | .551 | .693 | .890 | 1.294 | 1.764 |
| Diameter of hole & drill equal | 5/8" | 3/4" | 1" | 1 1/8" | 1 1/4" | 1 1/2" | 1 5/8" | 2" | 2 1/8" | 2 1/4" | 2 3/8" |
| No. of units req'd to equal strength of bolt * | 2 | 2 | 2 | 3 | 3 | 3 | 4 | 4 | 4 | 4 | 4 |
| Minimum depth of hole for number of units specified | 1 1/2" | 1 1/2" | 1 3/4" | 2 1/8" | 2 3/4" | 4" | 6 1/2" | 7 1/2" | 8" | 9 1/4" | 9 1/4" |
| Strength of bolts, Breaking strain, -Pounds | 2202 | 4950 | 8803 | 13754 | 19779 | 26880 | 35168 | 42336 | 52172 | 75264 | 9060 |
| Safe load for U.S. Standard Steel Bolts - Pounds ** | 172 | 451 | 845 | 1370 | 2070 | 2900 | 3800 | 4790 | 6210 | 9060 | 9060 |

* When masonry is of doubtful grade additional units should be used

** Based upon approximately 1/10 to actual holding power

POOR ORIGINAL

541

077

SECTION 4

PIPE STRESS RESULTS

A total of 120 pipe stress problems have been identified for reanalysis and are being analyzed by Stone & Webster Engineering Corporation in Boston, Massachusetts.

The pipe stress reanalysis consists of substituting the SHOCK3 or NUPIPE code for the SHOCK2 code. SHOCK3 is a current seismic code that calculates both intramodal and intermodal seismic forces using a modified square root of the sum of the squares (SRSS) technique and an SRSS technique, respectively, rather than an algebraic summation. The NUPIPE Program utilizes modal response combinations as follows:

Intermodal - SRSS for combination, grouping for modal combination
(where closely spaced modes are combined by absolute sum).

Intramodal - SRSS for direction combination.

541 078

Field verified piping fabricator isometric drawings provide the basis for program inputs for the pipe stress reanalysis.

Additionally, in some cases, piping is analyzed utilizing amplified response spectra (ARS) that are developed using soil structure interaction techniques (SSI-ARS). The resultant stresses and loads are used to evaluate piping, supports, nozzles, and penetrations. These techniques are discussed in Section 8.7.

Of the 120 SHOCK2 problems, 93 have been reanalyzed and are within allowable stress values. Table 4-1 lists the problems including the peak stress values for the SHOCK3 and NUPIPE pipe stress runs.

Stresses were computed by the SHOCK3 or NUPIPE program using different mass models and in some cases different ARS than the original calculations. More importantly, the reanalyses were based on field-verified, as-built conditions which in some cases differ significantly from the original design conditions. For these reasons, the originally calculated stresses are not comparable to the new stresses.

Table 4-2 summarizes the nozzles and penetrations evaluated under the reanalysis program. Of a total of 87 nozzles on problems within the scope of the interim effort, 82 have been evaluated and found to be acceptable, and 5

541 079

are contained in problems for which the final pipe stress analysis is not complete but are expected to be acceptable based on reanalysis.

The SHOCK2 stress problems contained in the interim effort include 50 penetrations, all of which have been evaluated and found to be acceptable.

Summary

During the period between the initial issue of this report and this revision, 30 additional problems have been rerun on NUPIPE using the SSI-ARS curve. All of the above 30 problems have been reanalyzed and were found to be within allowable stress limits.

541 080

BEAVER VALLEY POWER STATION, UNIT 1

TABLE 4-1

PIPE STRESS REEVALUATION SUMMARY

| <u>System and Problem No.</u> | <u>Allowable Stress (psi)</u> | <u>Reanalysis Maximum Stress</u> | <u>Reanalysis Method</u> |
|---------------------------------------|--|--|------------------------------|
| <u>Reactor Coolant</u> | | | |
| 653A | <u>12,547</u> 18,820 | <u>7,671</u> 8,189 | NUPIPE/SSI-ARS |
| 653B | <u>19,200</u> 28,800 | <u>10,084</u> 10,575 | NUPIPE/SSI-ARS |
| 653C | <u>19,200</u> 28,800 | <u>15,060</u> 17,244 | NUPIPE/SSI-ARS |
| 833 & 8 | <u>17,220/19,200</u> ⁽¹⁾ 25,830/28,200 | <u>12,420</u> ⁽²⁾ 17,300 | NUPIPE/SSI-ARS |
| 1200 | <u>19,200</u> 28,800 | <u>12,690</u> 16,424 | NUPIPE/SSI-ARS |
| 1201 | <u>19,200</u> 28,800 | <u>9,711</u> 10,442 | NUPIPE/SSI-ARS |
| <u>Safety Injection</u> | | | |
| 391A | <u>19,080</u> 28,620 | <u>15,425</u> 18,228 | SHOCK3/SSI-ARS |
| 2112 | <u>22,500</u> 33,750 | <u>20,754</u> 25,002 | SHOCK3 |
| 610 | <u>18,586</u> 27,878 | <u>2,081</u> 2,328 | NUPIPE/SSI-ARS |
| 613 | <u>21,180</u> 31,770 | <u>9,802</u> 14,336 | NUPIPE/SSI-ARS |
| 611 | <u>19,500/20,280</u> ⁽¹⁾ 29,250/30,400 | <u>17,585</u> 16,069 | NUPIPE/SSI-ARS |
| 15 | <u>17,340/19,200</u> ⁽¹⁾ 26,010/28,800 | <u>7,214</u> 8,123 | SHOCK3/SSI-ARS |

541 081

BEAVER VALLEY POWER STATION, UNIT 1

TABLE 4-1 (Cont)

| <u>System and Problem No.</u> | <u>Allowable Stress (psi)</u> | <u>Reanalysis Maximum Stress</u> | <u>Reanalysis Method</u> |
|--|---------------------------------------|--|------------------------------|
| 1011 | <u>20,850</u> 31,275 | <u>8,245</u> 14,087 | SHOCK3/SSI-ARS |
| 301 | <u>19,200</u> 28,800 | <u>7,722</u> 8,712 | NUPIPE/SSI-ARS |
| 213(") | <u>20,388</u> 30,582 | <u>5,837</u> 5,437 | NUPIPE/SSI-ARS |
| 2113(") | <u>20,388</u> 30,582 | <u>4,078</u> 4,443 | NUPIPE/SSI-ARS |
| <u>Quench Spray</u> | | | |
| 211 | <u>22,500</u> 33,750 | <u>1,807</u> 2,653 | SHOCK3/SSI-ARS |
| 212 | <u>22,500</u> 33,750 | <u>10,445</u> 11,639 | SHOCK3 |
| 228 | <u>22,500</u> 33,750 | <u>12,149</u> 16,589 | SHOCK3 |
| 229 | <u>22,500</u> 33,750 | <u>11,810</u> 15,987 | SHOCK3 |
| <u>Recirculation Spray</u> | | | |
| 612 | <u>18,796</u> 28,193 | <u>1,366</u> 1,434 | NUPIPE/SSI-ARS |
| <u>Charging and Volume Control</u> | | | |
| 100 | <u>18,660</u> 27,990 | <u>15,220</u> 15,468 | SHOCK3 |
| 102 | <u>18,660</u> 27,990 | <u>6,289</u> 6,621 | SHOCK3/SSI-ARS |

541 082

BEAVER VALLEY POWER STATION, UNIT 1

TABLE 4-1 (Cont)

| <u>System and Problem No.</u> | <u>Allowable Stress (psi)</u> | <u>Reanalysis Maximum Stress</u> | <u>Reanalysis Method</u> |
|--|---|--|------------------------------|
| <u>Residual Heat Removal</u> | | | |
| 255A | <u>17,940</u> 26,910 | <u>5,075</u> 6,041 | NUPIPE/SSI-ARS |
| 256 | <u>17,160</u> 25,740 | <u>11,843</u> 15,063 | NUPIPE/SSI-ARS |
| 14 | <u>17,940/19,200</u> (1) 26,910/28,800 | <u>8,740</u> 10,376 | SHOCK3/SSI-ARS |
| 3011 | <u>17,940</u> 26,910 | <u>17,656</u> 18,148 | NUPIPE |
| 616 | <u>18,300</u> 27,450 | <u>8,498</u> 11,500 | NUPIPE/SSI-ARS |
| <u>Component Cooling Water</u> | | | |
| 302 | <u>18,000</u> 27,000 | <u>6,295</u> 10,271 | NUPIPE/SSI-ARS |
| 303 | <u>18,000</u> 27,000 | <u>6,906</u> 10,377 | NUPIPE/SSI-ARS |
| 304 | <u>18,000</u> 27,000 | <u>7,836</u> 11,108 | NUPIPE/SSI-ARS |
| 305 | <u>18,000</u> 27,000 | <u>5,835</u> 8,330 | NUPIPE/SSI-ARS |
| 306 | <u>18,000</u> 27,000 | <u>4,246</u> 5,077 | NUPIPE/SSI-ARS |
| 307 | <u>18,000</u> 27,000 | <u>6,133</u> 7,780 | SHOCK3/SSI-ARS |
| 180E (2) | <u>18,000</u> 27,000 | <u>7,551</u> 7,370 | NUPIPE/SSI-ARS |

541 083

BEAVER VALLEY POWER STATION, UNIT 1

TABLE 4-1 (Cont)

| <u>System and Problem No.</u> | <u>Allowable Stress (psi)</u> | <u>Reanalysis Maximum Stress</u> | <u>Reanalysis Method</u> |
|---------------------------------------|---------------------------------------|--|------------------------------|
| 181E(3) | <u>18,000</u> 27,000 | <u>7,516</u> 15,168 | NUPIPE/SSI-ARS |
| 170C(3) | <u>18,000</u> 27,000 | <u>4,539</u> 5,031 | NUPIPE/SSI-ARS |
| 171(3) | <u>18,000</u> 27,000 | <u>5,472</u> 5,667 | NUPIPE/SSI-ARS |
| 172 (3) | <u>18,000</u> 27,000 | <u>8,319</u> 13,734 | NUPIPE/SSI-ARS |
| 173D(3) | <u>18,000</u> 27,000 | <u>5,107</u> 5,994 | NUPIPE/SSI-ARS |
| 174D(3) | <u>18,000</u> 27,000 | <u>3,036</u> 4,115 | NUPIPE/SSI-ARS |
| 175B(3) | <u>18,000</u> 27,000 | <u>5,197</u> 5,414 | NUPIPE/SSI-ARS |
| 176A(3) | <u>18,000</u> 27,000 | <u>3,505</u> 3,777 | SHOCK3/SSI-ARS |
| 177(3) | <u>18,000</u> 27,000 | <u>9,223</u> 13,707 | SHOCK3/SSI-ARS |
| 178C(3) | <u>18,000</u> 27,000 | <u>15,703</u> 15,797 | NUPIPE/SSI-ARS |
| 179(3) | <u>18,000</u> 27,000 | <u>2,081</u> 2,995 | NUPIPE/SSI-ARS |
| 183(3) | <u>18,000</u> 27,000 | <u>9,320</u> 11,336 | NUPIPE/SSI-ARS |
| 184(3) | <u>18,000</u> 27,000 | <u>10,133</u> 11,734 | NUPIPE/SSI-ARS |
| 186A(3) | <u>18,000</u> 27,000 | <u>15,703</u> 15,797 | NUPIPE/SSI-ARS |
| 270A(3) | <u>18,000</u> 27,000 | <u>15,703</u> 15,797 | NUPIPE/SSI-ARS |

541 084

BEAVER VALLEY POWER STATION, UNIT 1

TABLE 4-1 (Cont)

| <u>System and Problem No.</u> | <u>Allowable Stress (psi)</u> | <u>Reanalysis Maximum Stress</u> | <u>Reanalysis Method</u> |
|---------------------------------------|---------------------------------------|--|------------------------------|
| 215 | <u>18,000</u> 27,000 | <u>16,311</u> 26,731 | SHOCK3 |
| 217 | <u>18,000</u> 27,000 | <u>15,751</u> ⁽²⁾ 23,924 | NUPIPE/SSI-ARS |
| 930 | <u>18,000</u> 27,000 | <u>15,751</u> 23,924 | NUPIPE/SSI-ARS |
| 931 | <u>18,000</u> 27,000 | <u>15,751</u> 23,924 | NUPIPE/SSI-ARS |
| 214 | <u>18,000</u> 27,000 | <u>14,740</u> 25,774 | NUPIPE/SSI-ARS |
| River Water | | | |
| 1 | <u>18,000</u> 27,000 | <u>10,801</u> 13,759 | SHOCK3 |
| 30 | <u>18,000</u> 27,000 | <u>4,830</u> 7,576 | NUPIPE/SSI-ARS |
| 31 | <u>18,000</u> 27,000 | <u>4,830</u> 7,576 | NUPIPE/SSI-ARS |
| 32 | <u>18,000</u> 27,000 | <u>5,363</u> 8,390 | NUPIPE/SSI-ARS |
| 33 | <u>18,000</u> 27,000 | <u>5,169</u> 8,241 | NUPIPE/SSI-ARS |
| 14C | <u>18,000</u> 27,000 | <u>13,758</u> 16,349 | SHOCK3/SSI-ARS |
| 384 | <u>18,000</u> 27,000 | <u>6,156</u> 8,512 | SHOCK3 ⁽³⁾ |
| 157 | <u>18,000</u> 27,000 | <u>1,884</u> 2,011 | NUPIPE/SSI-ARS |
| 158 | <u>18,000</u> 27,000 | <u>1,976</u> 2,090 | NUPIPE/SSI-ARS |

541 085

BEAVER VALLEY POWER STATION, UNIT 1

TABLE 4-1 (Cont)

| <u>System and Problem No.</u> | <u>Allowable Stress (psi)</u> | <u>Reanalysis Maximum Stress</u> | <u>Reanalysis Method</u> |
|---------------------------------------|---------------------------------------|--|------------------------------|
| 159 ^(b) | <u>18,000</u> 27,000 | <u>10,443</u> 17,277 | NUPIPE/SSI-ARS |
| 128 | <u>18,000</u> 27,000 | <u>10,760</u> 12,562 | NUPIPE/SSI-ARS |
| 127 | <u>18,000</u> 27,000 | <u>13,384</u> 15,970 | NUPIPE/SSI-ARS |
| 125 | <u>18,000</u> 27,000 | <u>10,760</u> 12,562 | NUPIPE/SSI-ARS |
| 124 | <u>18,000</u> 27,000 | <u>13,384</u> 15,970 | NUPIPE/SSI-ARS |
| 123 | <u>18,000</u> 27,000 | <u>10,861</u> 17,797 | NUPIPE/SSI-ARS |
| 120 | <u>18,000</u> 27,000 | <u>8,820</u> (7) | NUPIPE/SSI-ARS |
| 126 | <u>18,000</u> 27,000 | <u>13,384</u> 15,970 | NUPIPE/SSI-ARS |
| 216 | <u>18,000</u> 27,000 | <u>6,047</u> 9,989 | NUPIPE/SSI-ARS |
| 203 | <u>18,000</u> 27,000 | <u>2,444</u> 4,189 | NUPIPE/SSI-ARS |
| 2031 | <u>18,000</u> 27,000 | <u>8,260</u> 9,699 | NUPIPE/SSI-ARS |
| 152 | <u>18,000</u> 27,000 | <u>4,950</u> 6,032 | NUPIPE/SSI-ARS |
| 121 | <u>18,000</u> 27,000 | <u>6,068</u> 8,354 | NUPIPE/SSI-ARS |
| 122 | <u>18,000</u> 27,000 | <u>8,038</u> 14,096 | NUPIPE/SSI-ARS |
| 165 | <u>18,000</u> 27,000 | <u>4,950</u> 6,032 | NUPIPE/SSI-ARS |

BEAVER VALLEY POWER STATION, UNIT 1

TABLE 4-1 (Cont)

| <u>System and Problem No.</u> | <u>Allowable Stress (psi)</u> | <u>Reanalysis Maximum Stress</u> | <u>Reanalysis Method</u> |
|---------------------------------------|---------------------------------------|--|------------------------------|
| 652 | <u>18,000</u> 27,000 | <u>1,231</u> 1,394 | NUPIPE/SSI-ARS |
| 653 | <u>18,000</u> 27,000 | <u>1,495</u> 1,624 | NUPIPE/SSI-ARS |
| <u>Main Steam</u> | | | |
| 658 | <u>22,500</u> 33,750 | <u>10,248</u> 12,025 | SHOCK3/SSI-ARS |
| 6590 | <u>18,000</u> 27,000 | <u>9,977</u> 11,108 | SHOCK3/SSI-ARS |
| 101 | <u>18,000</u> 27,000 | <u>16,917</u> 18,277 | SHOCK3 |
| 659 | <u>22,500</u> 33,750 | <u>10,544</u> 12,570 | SHOCK3/SSI-ARS |
| 660 | <u>22,500</u> 33,750 | <u>11,121</u> 13,304 | SHOCK3/SSI-ARS |
| 3063 | <u>22,500</u> 33,750 | <u>12,289</u> 16,481 | SHOCK3 |
| <u>Feed Water</u> | | | |
| 204 | <u>18,000</u> 27,000 | <u>2,952</u> 3,761 | SHOCK3 |
| 783 | <u>18,000</u> 27,000 | <u>9,361</u> 11,624 | SHOCK3/SSI-ARS |
| 784 | <u>18,000</u> 27,000 | <u>10,853</u> 13,726 | SHOCK3/SSI-ARS |
| 785 | <u>18,000</u> 27,000 | <u>14,397</u> 20,232 | SHOCK3 |
| 261 | <u>18,000</u> 27,000 | <u>10,479</u> 13,585 | SHOCK3/SSI-ARS |

541 087

BEAVER VALLEY POWER STATION, UNIT 1

TABLE 4-1 (Cont)

| <u>System and Problem No.</u> | <u>Allowable Stress (psi)</u> | <u>Reanalysis Maximum Stress</u> | <u>Reanalysis Method</u> |
|---------------------------------------|---------------------------------------|--|------------------------------|
| Diesel Generator <u>Exhaust</u> | | | |
| 651 | <u>12,960</u> 19,440 | <u>1,201</u> 1,717 | NUPIPE/SSI-ARS |

Notes: SSI-ARS = Amplified response spectra developed using soils structure interaction techniques

Stresses shown are Operational Basis Earthquake (OBE) Stresses
Design Basis Earthquake (DBE) Stresses

- (1) TP304/TP316 allowables
- (2) After modification
- (3) Problems are no longer within scope of short-term reanalysis effort. See Appendix B.
- (4) Problems 213 and 2113 include $S_{DL} + S_{LP} + S_{OBEI}$ and $S_{DL} + S_{LP} + S_{DBEI}$ only.
- (5) Being rerun with SSI-ARS.
- (6) Problem 159 includes Problems 160 and 161.
- (7) Evaluated for the DBE case only.

541 088

BEAVER VALLEY POWER STATION, UNIT 1

TABLE -2

NOZZLE AND PENETRATION SUMMARY

| <u>System/ Problem No.</u> | <u>Total No. of Nozzles/ Penetrations</u> | <u>No. Acceptable After Pipe Stress Re- analysis</u> | <u>No. Requiring Further Re- Analysis</u> |
|--------------------------------|---|--|---|
| <u>Reactor Coolant</u> | | | |
| 653A | 6/0 | 6/0 | 0/0 |
| 653B | 8/0 | 8/0 | 0/0 |
| 653C | 8/0 | 8/0 | 0/0 |
| 833 & 8 | 4/0 | 4/0 | 0/0 |
| 1200 | 1/0 | 1/0 | 0/0 |
| 1201 | 0/0 | 0/0 | 0/0 |
| <u>Safety Injection</u> | | | |
| 391A | 1/0 | 1/0 | 0/0 |
| 2112 | 0/0 | 0/0 | 0/0 |
| 610 | 2/2 | 2/2 | 0/0 |
| 613 | 0/0 | 0/0 | 0/0 |
| 615 | 2/3 | 2/3 | 0/0 |
| 15 | 1/0 | 1/0 | 0/0 |
| 1011 | 0/0 | 0/0 | 0/0 |
| 301 | 0/2 | 0/2 | 0/0 |
| 213 | 0/0 | 0/0 | 0/0 |
| 2113 | 0/0 | 0/0 | 0/0 |

541 089

BEAVER VALLEY POWER STATION, UNIT 1

TABLE 4-2 (Cont)

| <u>System/ Problem No.</u> | <u>Total No. of Nozzles/ Penetrations</u> | <u>No. Acceptable After Pipe Stress Re- analysis</u> | <u>No. Requiring Further Re- Analysis</u> |
|--|---|--|---|
| <u>Quench Spray</u> | | | |
| 211 | 1/0 | 1/0 | 0/0 |
| 212 | 1/0 | 1/0 | 0/0 |
| 228 | 1/0 | 1/0 | 0/0 |
| 229 | 1/0 | 1/0 | 0/0 |
| <u>Recirculation Spray</u> | | | |
| 612 | 2/2 | 2/2 | 0/0 |
| <u>Charging & Volume Control</u> | | | |
| 100 | 2/0 | 2/0 | 0/0 |
| 102 | 1/0 | 1/0 | 0/0 |
| <u>Residual Heat Removal</u> | | | |
| 255A | 6/0 | 6/0 | 0/0 |
| 256 | 0/0 | 0/0 | 0/0 |
| 14 | 1/0 | 1/0 | 0/0 |
| 3011 | 0/0 | 0/0 | 0/0 |
| 616 | 0/1 | 0/1 | 0/0 |
| <u>Component Cooling Water</u> | | | |
| 302 | 1/1 | 1/1 | 0/0 |
| 303 | 1/1 | 1/1 | 0/0 |

541 090

BEAVER VALLEY POWER STATION, UNIT 1

TABLE 4-2 (Cont)

| <u>System/ Problem No.</u> | <u>Total No. of Nozzles/ Penetrations</u> | <u>No. Acceptable After Pipe Stress Re- analysis</u> | <u>No. Requiring Further Re- Analysis</u> |
|--------------------------------|---|--|---|
| 304 | 1/1 | 1/1 | 0/0 |
| 305 | 1/1 | 1/1 | 0/0 |
| 306 | 0/1 | 0/1 | 0/0 |
| 307 | 0/1 | 0/1 | 0/0 |
| 180E ⁽¹⁾ | 2/0 | 2/0 | 0/0 |
| 181E ⁽¹⁾ | 2/0 | 2/0 | 0/0 |
| 170C ⁽¹⁾ | 3/0 | 1/0 | 2/0 |
| 171 ⁽¹⁾ | 6/0 | 6/0 | 0/0 |
| 172 ⁽¹⁾ | 0/0 | 0/0 | 0/0 |
| 173D ⁽¹⁾ | 0/0 | 0/0 | 0/0 |
| 174D ⁽¹⁾ | 0/0 | 0/0 | 0/0 |
| 175B ⁽¹⁾ | 0/0 | 0/0 | 0/0 |
| 176A ⁽¹⁾ | 0/0 | 0/0 | 0/0 |
| 177 ⁽¹⁾ | 1/0 | 1/0 | 0/0 |
| 178C ⁽¹⁾ | 1/0 | 1/0 | 0/0 |
| 179 ⁽¹⁾ | 1/0 | 1/0 | 0/0 |
| 183 ⁽¹⁾ | 3/0 | 3/0 | 0/0 |
| 184 ⁽¹⁾ | 2/0 | 2/0 | 0/0 |
| 186A ⁽¹⁾ | 0/0 | 0/0 | 0/0 |
| 270A ⁽¹⁾ | 3/0 | 3/0 | 0/0 |
| 215 | 0/4 | 0/4 | 0/0 |
| 217 | 0/4 | 0/4 | 0/0 |

541 091

BEAVER VALLEY POWER STATION, UNIT 1

TABLE 4-2 (Cont)

| <u>System/ Problem No.</u> | <u>Total No. of Nozzles/ Penetrations</u> | <u>No. Acceptable After Pipe Stress Re- analysis</u> | <u>No. Requiring Further Re- Analysis</u> |
|--------------------------------|---|--|---|
| 930 | 0/1 | 0/1 | 0/0 |
| 931 | 0/1 | 0/1 | 0/0 |
| 214 | 0/1 | 0/1 | 0/0 |
| <u>River Water</u> | | | |
| 1 | 4/4 | 4/4 | 0/0 |
| 30 | 1/1 | 1/1 | 0/0 |
| 31 | 1/1 | 1/1 | 0/0 |
| 32 | 1/1 | 1/1 | 0/0 |
| 33 | 1/1 | 1/1 | 0/0 |
| 140 | 1/0 | 1/0 | 0/0 |
| 384 | 1/0 | 1/0 | 0/0 |
| 157 | 0/0 | 0/0 | 0/0 |
| 158 | 0/0 | 0/0 | 0/0 |
| 159 | 3/0 | 3/0 | 0/0 |
| 128 | 0/0 | 0/0 | 0/0 |
| 127 | 0/0 | 0/0 | 0/0 |
| 125 | 0/0 | 0/0 | 0/0 |
| 124 | 0/0 | 0/0 | 0/0 |
| 123 | 0/4 | 0/4 | 0/0 |
| 120 | 0/4 | 0/4 | 0/0 |
| 126 | 3/0 | 3/0 | 0/0 |
| 216 | 1/1 | 1/1 | 0/0 |

541 092

BEAVER VALLEY POWER STATION, UNIT 1

TABLE 4-2 (Cont)

| <u>System/ Problem No.</u> | <u>Total No. of Nozzles/ Penetrations</u> | <u>No. Acceptable After Pipe Stress Re- analysis</u> | <u>No. Requiring Further Re- Analysis</u> |
|--------------------------------|---|--|---|
| 203 | 3/0 | 3/0 | 0/0 |
| 2031 | 0/0 | 0/0 | 0/0 |
| 152 | 0/0 | 0/0 | 0/0 |
| 121(2) | 3/0 | 0/0 | 0/0 |
| 122 | 0/0 | 0/0 | 0/0 |
| 165 | 0/0 | 0/0 | 0/0 |
| 652(2) | 1/0 | 0/0 | 0/0 |
| 653(2) | 1/0 | 0/0 | 0/0 |
| <u>Main Steam</u> | | | |
| 658 | 1/1 | 1/1 | 0/0 |
| 6590 | 0/0 | 0/0 | 0/0 |
| 101 | 0/0 | 0/0 | 0/0 |
| 659 | 1/1 | 1/1 | 0/0 |
| 660 | 1/1 | 1/1 | 0/0 |
| 3063 | 0/0 | 0/0 | 0/0 |
| <u>Feed- water</u> | | | |
| 204 | 3/0 | 3/0 | 0/0 |
| 783 | 1/1 | 1/1 | 0/0 |
| 784 | 1/1 | 1/1 | 0/0 |
| 785 | 1/1 | 1/1 | 0/0 |
| 261 | 0/0 | 0/0 | 0/0 |

BEAVER VALLEY POWER STATION, UNIT 1

TABLE 4-2 (Cont)

| <u>System/ Problem No.</u> | <u>Total No. of Nozzles/ Penetrations</u> | <u>No. Acceptable After Pipe Stress Re- analysis</u> | <u>No. Requiring Further Re- Analysis</u> |
|---------------------------------------|---|--|---|
| Diesel Generator <u>Exhaust</u> | | | |
| 651 | 0/0 | 0/0 | 0/0 |

NOTES:

- (1) Not within the short term reanalysis effort.
- (2) These problems recently added to the interim scope. Results of the reanalysis are not available at this time.

541 094

SECTION 5

PIPE SUPPORT RESULTS

Table 5-1 summarizes the pipe supports evaluated in the reanalysis program. There are 696 pipe supports on lines within the interim reanalysis effort; of these, 508 have been evaluated and found acceptable and 7 have been modified to be acceptable. A support is considered acceptable if all the load components are lower in magnitude than those for which the support was originally designed. If some load components are greater than the original design load components, the support is reanalyzed using the new loads. Of the total 188 supports requiring reanalysis, 68 have been found to be acceptable based on DBEI+DL, 111 have not been accepted at this time. Of the 111 unacceptable supports, 76 have not been evaluated at this time due to their recent addition to the reanalysis effort. There is sufficient analytical information available for the remaining 35 supports to exercise engineering judgment in determining whether the unacceptable condition will become acceptable.

1. The use of ASME III Section NF faulted allowable stress values for structural members

541 095

BEAVER VALLEY POWER STATION, UNIT 1

2. The use of one time load for snubbers

3. Use of DBEI plus dead load

If a support is unacceptable using any of the above approaches, a modification is required. Table 5-2 identifies those supports where acceptance is based on the future use of the options listed above. Hardware modifications and additions are discussed in Section 6.

With respect to item 3 above, acceptance criteria for pipe support design and analysis are presented in Table 3-1 of this report. As a basis for interim startup of the Beaver Valley Unit 1 facility, supports which do not meet these criteria will be reevaluated using the allowables of ASME III, Subsection NF, Appendix XVII and Appendix F for the design basis earthquake (DBE). The load combinations and a summary of significant allowable stresses to which evaluation will be made under these ASME criteria appear in Table 5-3.

Support designs which are not in accordance with either of these criteria will be suitably modified against the acceptance design criteria of Table 3-1 prior to interim plant operation.

Base plate design criteria and anchor bolt pullout and shear allowable loads are addressed in Section 3. The seismic support loadings which will be

541 096

utilized for the NF evaluation will be the result of either SHOCK3 or NUPIPE evaluations using SSI-ARS.

Summary

The pipe support reanalysis effort which took place between the original issue and Revision 1 of this report includes accepting 97 supports; 68 based on DBEI+DL and 29 based on long-term criteria. Also, one additional modification was necessary for the 14" RH line off the reactor coolant loop.

541 097

BEAVER VALLEY POWER STATION, UNIT 1

TABLE 5-1

PIPE SUPPORTS SUMMARY

| <u>System/ Problem No.</u> | <u>Total No. of Supports</u> | <u>No. Presently Acceptable Based on Reanalysis</u> | <u>No. Acceptable for Interim Operation</u> | <u>Modifications or Additions Required</u> |
|--------------------------------|--------------------------------------|---|---|--|
| <u>Reactor Coolant</u> | | | | |
| 653A | 2 | 2 | 0 | 0 |
| 653B | 16 | 12 | 0 | 4 |
| 653C | 8 | 8 | 0 | 0 |
| 833&8 | 15 | 15 | 0 | 1 |
| 1200 | 18 | 15 | 3 | 0 |
| 1201 | 19 | 19 | 0 | 0 |
| <u>Safety Injection</u> | | | | |
| 391A | 11 | 11 | 0 | 0 |
| 2112 | 8 | 8 | 0 | 0 |
| 610 | 2 | 2 | 0 | 0 |
| 613 | 5 | 5 | 0 | 0 |
| 615(2) | 11 | 6 | 5 | 0 |
| 15 | 11 | 7 | 4 | 0 |
| 1011 | 19 | 16 | 3 | 0 |
| 301(8) | 56 | 0 | 56 | 0 |
| 213(4) | 16 | 0 | 0 | 0 |
| 2113(4) | 16 | 0 | 0 | 0 |
| <u>Quench Spray</u> | | | | |
| 211 | 5 | 5 | 0 | 0 |
| 212 | 3 | 3 | 0 | 0 |

541 098
0

BEAVER VALLEY POWER STATION, UNIT 1

TABLE 5-1 (Cont)

| <u>System/ Problem No.</u> | <u>Total No. of Supports</u> | <u>No. Presently Acceptable Based on Reanalysis</u> | <u>No. Acceptable for Interim Operation</u> | <u>Modifications or Additions Required</u> |
|------------------------------------|--------------------------------------|---|---|--|
| 228 | 0 | 0 | 0 | 0 |
| 229 | 0 | 0 | 0 | 0 |
| <u>Recirculation Spray</u> | | | | |
| 612 | 0 | 0 | 0 | 0 |
| <u>Charging Volume Control</u> | | | | |
| 100 | 9 | 9 | 0 | 0 |
| 102 | 8 | 8 | 0 | 0 |
| <u>Residual Heat Removal</u> | | | | |
| 255A | 3 | 4 | 4 | 0 |
| 256 | 6 | 6 | 0 | 0 |
| 14 | 15 | 15 | 0 | 0 |
| 3011 | 11 | 10 | 1 | 0 |
| 616(4) | 7 | 0 | 0 | 0 |
| <u>Component Cooling Water</u> | | | | |
| 302 | 23 | 23 | 0 | 0 |
| 303 | 23 | 23 | 0 | 0 |
| 304 | 33 | 31 | 2 | 0 |
| 305 | 30 | 29 | 1 | 0 |
| 306 | 11 | 10 | 1 | 0 |
| 307 | 10 | 10 | 0 | 0 |

541 099

BEAVER VALLEY POWER STATION, UNIT 1

TABLE 5-1 (Cont)

| <u>System/ Problem No.</u> | <u>Total No. of Supports</u> | <u>No. Presently Acceptable Based on Reanalysis</u> | <u>No. Acceptable for Interim Operation</u> | <u>Modifications or Additions Required</u> |
|--------------------------------|--------------------------------------|---|---|--|
| 180E(') | 5 | 5 | 0 | 0 |
| 181E(') | 5 | 4 | 1 | 0 |
| 170C(') | 17 | 16 | 1 | 0 |
| 171(') | 15 | 11 | 4 | 0 |
| 172(') | 13 | 12 | 1 | 0 |
| 173D(') | 15 | 14 | 1 | 0 |
| 174D(') | 20 | 16 | 4 | 0 |
| 175B(') | 6 | 5 | 1 | 0 |
| 176A(') | 5 | 5 | 0 | 0 |
| 177(') | 9 | 9 | 0 | 0 |
| 178C(') | 14 | 10 | 4 | 0 |
| 179(') | 8 | 8 | 0 | 0 |
| 183(') | 9 | 8 | 1 | 0 |
| 184(') | 14 | 11 | 3 | 0 |
| 186A(') | 6 | 3 | 3 | 0 |
| 270A(') | 10 | 6 | 4 | 0 |
| 215 | 8 | 6 | 2 | 0 |
| 217 | 10 | 10 | 0 | 1 |
| 930 | 3 | 3 | 0 | 0 |
| 931 | 2 | 2 | 0 | 0 |
| 214 | 5 | 5 | 0 | 0 |

541 100

BEAVER VALLEY POWER STATION, UNIT 1

TABLE 5-1 (Cont)

| <u>System/ Problem No.</u> | <u>Total No. of Supports</u> | <u>No. Presently Acceptable Based on Reanalysis</u> | <u>No. Acceptable for Interim Operation</u> | <u>Modifications or Additions Required</u> |
|--------------------------------|--------------------------------------|---|---|--|
| <u>River Water</u> | | | | |
| 1 | 0 | 0 | 0 | 0 |
| 30 | 2 | 2 | 0 | 0 |
| 31 | 2 | 2 | 0 | 0 |
| 32 | 2 | 1 | 1 | 0 |
| 33 | 2 | 2 | 0 | 0 |
| 140 | 2 | 2 | 0 | 0 |
| 384 | 5 | 5 | 0 | 0 |
| 157 | 3 | 3 | 0 | 0 |
| 158 | 2 | 2 | 0 | 0 |
| 159 (3) | 8 | 8 | 0 | 0 |
| 128 | 1 | 0 | 1 | 0 |
| 127 | 10 | 4 | 6 | 0 |
| 125 | 12 | 10 | 2 | 0 |
| 124 | 13 | 12 | 1 | 0 |
| 123 | 15 | 12 | 0 | 3 |
| 120 | 11 | 5 | 6 | 0 |
| 126 | 7 | 7 | 0 | 0 |
| 216 | 2 | 2 | 0 | 0 |
| 203 | 16 | 15 | 1 | 0 |
| 2031 | 9 | 9 | 0 | 0 |
| 121 (4) | 15 | 0 | 0 | 0 |

541 101

BEAVER VALLEY POWER STATION, UNIT 1

TABLE 5-1 (Cont)

| <u>System/ Problem No.</u> | <u>Total No. of Supports</u> | <u>No. Presently Acceptable Based on Reanalysis</u> | <u>No. Acceptable for Interim Operation</u> | <u>Modifications or Additions Required</u> | |
|---------------------------------|--------------------------------------|---|---|--|--|
| 122 ^(*) | 19 | 0 | 0 | 0 | |
| 165 ^(*) | 1 | 0 | 0 | 0 | |
| 152 | 8 | 7 | 1 | 0 | |
| 652 ^(*) | 1 | 0 | 1 | 0 | |
| 653 ^(*) | 2 | 0 | 2 | 0 | |
| <u>Main Steam</u> | | | | | |
| 658 | 6 | 6 | 0 | 0 | |
| 6590 | 3 | 3 | 0 | 0 | |
| 101 | 4 | 4 | 0 | 0 | |
| 659 | 2 | 1 | 1 | 0 | |
| 660 | 7 | 7 | 0 | 0 | |
| 3063 | 0 | 0 | 0 | 0 | |
| <u>Feedwater</u> | | | | | |
| 204 | 15 | 15 | 0 | 0 | |
| 783 | 9 | 9 | 0 | 0 | |
| 784 | 6 | 6 | 0 | 0 | |
| 785 | 3 | 3 | 0 | 0 | |
| 261 | 6 | 6 | 0 | 0 | |
| <u>Diesel Generator Exhaust</u> | | | | | |
| 651 ^(*) | 2 | 0 | 0 | 0 | |

NOTES:

^(*) Supports are no longer in scope for interim startup. See Appendix B.

BEAVER VALLEY POWER STATION, UNIT 1

TABLE 5-1 (Cont)

- '2' Problem 615 contains modifications (NPSH) scheduled for installation during the first refueling outage. Therefore, it will only be analyzed for interim operation.
- '3' Problem 159 includes Problems 160 and 161.
- '4' Problem recently added to scope and result not available.
- '5' Analyzed based on DBEI+DL only.

541 103

BEAVER VALLEY POWER STATION, UNIT 1

TABLE 5-2

ENGINEERING EVALUATION OF REMAINING SUPPORTS

| <u>Problem No.</u> | <u>Support No.</u> | <u>Overstress Condition</u> | <u>Resolution</u> |
|-------------------------------------|--------------------|--|--|
| <u>SAFETY INJECTION SYSTEM</u> | | | |
| 615 | A37 | Pad to Run Pipe Weld Overstressed | Will be Acceptable Based on DBEI+DL |
| | R61 | Frame Overstressed | Will be Acceptable Based on DBEI+DL |
| | HSS-211 | Member Overstressed | Will be Acceptable Based on DBEI+DL |
| | HSS-212A | Snubber Overloaded | Will be Acceptable Based on DBEI+DL |
| | HSS-212B | Snubber Overloaded | Will be Acceptable Based on DBEI+DL |
| 15 | H2 | Member/Base Plates/Bolt Pullout | Will be Acceptable Based on DBEI+DL |
| | H8 | Lug to Pipe Weld Overstress/Bolt Pullout | Will be Acceptable Based on DBEI+DL |
| | H102A | Snubber Overloaded | Will be Acceptable Based on DBEI+DL |
| | H102B | Snubber Overloaded | Will be Acceptable Based on DBEI+DL |
| 1011 | R13 | Member Overstressed | Will be Acceptable Based on DBEI+DL |
| | R14 | Member Overstressed | Will be Acceptable Based on DBEI+DL |
| | R16 | Member Overstressed | Will be Acceptable Based on DBEI+DL |
| <u>RESIDUAL HEAT REMOVAL SYSTEM</u> | | | |
| 255 | H11 | Member Overstress | Will be Acceptable Based on DBEI+DL |
| | H16 | Member Overstress | Will be Acceptable Based on DBEI+DL |
| | H21 | Member Overstress | Will be Acceptable Based on DBEI+DL |
| | H22 | Member Overstress | Will be Acceptable Based on DBEI+DL |
| 3011 | H10A.4 | Weld Overstressed/Bolt Pullout | Will be Acceptable Using SSI-ARS Curve |

541 104

BEAVER VALLEY POWER STATION, UNIT 1

TABLE 5-2 (Cont)

| <u>Problem No.</u> | <u>Support</u> | <u>Overstress Condition</u> | <u>Resolution</u> |
|---------------------------------------|----------------|----------------------------------|-------------------------------------|
| <u>COMPONENT COOLING WATER SYSTEM</u> | | | |
| 304 | R182 | Bolt Pullout/Member Overstressed | Will be Acceptable Based on DBEI+DL |
| | R10D.6 | Local Stress | Will be Acceptable Based on DBEI+DL |
| 305 | R176 | Bolt Pullout | Will be Acceptable Based on DBEI+DL |
| 306 | R264 | Local Stress/Trunnion Overstress | Will be Acceptable Based on DBEI+DL |
| 215 | R201 | Bolt Pullout | Will be Acceptable Based on DBEI+DL |
| | R203 | Member Overstressed | Will be Acceptable Based on DBEI+DL |

The following problems are not required for interim startup:

170,171,172,173,174,175,176,
177,178,179,180,181,183,184,
186 & 270. Refer to Appendix B.

RIVER WATER SYSTEM

| | | | |
|-----|------|---------------------|-------------------------------------|
| 127 | H56 | Member Overstressed | Will be Acceptable Based on DBEI+DL |
| | H63 | Member Overstressed | Will be Acceptable Based on DBEI+DL |
| 125 | H57 | Bolt Pullout | Will be Acceptable Based on DBEI+DL |
| | H49 | Bolt Pullout | Will be Acceptable Based on DBEI+DL |
| 124 | H28A | Weld Overstressed | Will be Acceptable Based on DBEI+DL |

541 105








541 106

BAVER VALLEY POWER STATION, UNIT 1

Following reanalysis of Problem No. 833, an additional snubber was designed and will be installed to alleviate a pipe overstress occurring under upset (OBE) and faulted (DBE) conditions.

Similarly, an additional snubber was designed and will be installed in Problem No. 217 to alleviate a pipe overstress occurring under the same conditions.

Three supports in Problem No. 123 will be modified, one to make the as-built condition agree with the original design, one to strengthen a marginal original design, and one to alleviate an overstressed weld in the support resulting from seismic uplift forces.

Similarly, four supports in Problem No. 653B will be modified, three to make the as-built condition agree with the original design, and one to alleviate an overstressed member in the support resulting from seismic forces.

541 107

SECTION 7

LONG TERM REANALYSIS PROGRAM

The long term reanalysis program will consist of preparing completely documented calculational packages, utilizing the NUPIPE computer program with amplified response spectra (ARS) based on soil-structure interaction (SSI), for the problems identified in Appendixes A and B. In addition, the problems associated with the quench and recirculation spray systems will be analyzed for the operating basis earthquake.

ANCHOR MOVEMENT CRITERIA

Pipe stress analysis for Beaver Valley Unit 1 was performed in accordance with the ANSI B31.1 Power Piping Code - 1967. In formulating load combinations to meet paragraphs 102.3.3(a) and (d), seismic anchor displacement effects were included with seismic inertia effects to form total seismic response for the DBE case.

Inclusion of the DBE anchor displacement effects in combination with the DBE inertia effects is not a requirement of current codes, neither ANSI B31.1 or ASME III NC or ND3600, since the displacement effect is secondary in nature.

541 108

Revision 1

BEAVER VALLEY POWER STATION, UNIT 1

Under the long term piping analysis criteria established for Beaver Valley Unit 1, anchor displacement effects need not be combined with the inertia effects of the DBE event when evaluating primary stresses in the system.

541 109

7. Piping and supports in general are conservatively designed, even when no dynamic seismic analysis is performed. Fossil-fueled power plants, refineries, and process plants have survived major earthquakes in California, Alaska, Guatemala, and other locations with little or no piping damage. This experience includes earthquakes considerably larger than the DBE for Beaver Valley Unit 1. The experience with piping performance in earthquakes is reviewed in detail in a report included here as Appendix H.

In addition to the conservatisms listed above, which are inherent in any design of nuclear facilities, there are additional conservatisms specific to the Beaver Valley unit. These conservatisms are not theoretical concepts, but indeed are real and existing margins of safety. To quantify these conservatisms is difficult, but this in no way negates the sound conservative premise on which the reanalysis effort is based. These additional conservatisms are discussed below.

8.1 STRESS LIMITS

The analyses and reanalyses of Seismic Category I piping systems are based upon the conservative stress limit of $1.8S_h$ under the limiting faulted or DBE loading conditions. The present ASME Section III Code specifies the piping stress limit to be $2.4S_h$ under the Faulted DBE Condition. Only the quench and

541 113

BEAVER VALLEY POWER STATION, UNIT 1

recirculation spray systems were redesigned and reanalyzed in 1975 for the DBE condition including water hammer loads using $2.4S_h$ as an allowable. In July 1978, the NUREG/CR-0261 report* used the limit moment theory to address the Code rules, and it was established that gross plastic deformation may occur when primary stress exceeds 1.5 to 2.0 times the yield strength (S_y) of piping material, but for stresses below these values, functional capability was maintained.

For Beaver Valley, Unit 1, the majority of carbon steel piping material is of SA-106 Grade B steel. Using the lower limit of $1.5S_y$ from NUREG/CR-0261 and representative properties of SA-106 Grade B steel, the added margin of conservatism is the ratio ($1.5S_y/1.8S_h$), which ranges from 1.4 at 650°F to 1.94 at 100°F.

The Beaver Valley Unit 1 pipe stress reanalysis calculations have included the seismic stress due to anchor displacements in the DBE condition. Inclusion of the anchor movement stresses was not explicitly required by ANSI Code B31.1, used for the original design, and is not required by current 1979 codes, for the faulted DBE condition. Addition of this stress component is a significant conservatism for the long term reanalysis.

* E.C. Rodabaugh and S.E. Moore, "Evaluation of the Plastic Characteristics of Piping Products in Relation to Code Criteria," NUREG/CR-0261, July 1978

8.4 FIELD VERIFICATION OF AS-BUILT CONDITIONS

The documentation of as-built conditions for Beaver Valley Unit 1 began in September 1974 and was completed prior to startup. The effort was manned by Pipe Stress Analysis and Pipe Support Designers who walked all Category I piping systems to ensure compliance with the stress analysis summaries (MSKs). All Category I piping was checked for piping configuration, pipe support location, and pipe support type. The results of this effort were documented and reported on Southwest Fabricating isometric drawings which then became part of the permanent plant record. These isometric drawings supersede the RP series drawings. Duquesne Light Co. personnel verified the accuracy of a portion of these isometric drawings during March and April of 1979 subsequent to the shutdown order.

8.5 ENGINEERING ASSURANCE

A comprehensive and extensive Engineering Assurance program has been developed and applied to the reanalysis activities. A detailed project procedure was developed that includes provisions for design control, document control, and interface controls. Each new project procedure developed received a full review and approval by the S&W Engineering Assurance (EA) staff.

541 112

BEAVER VALLEY POWER STATION, UNIT 1

APPENDIX A

SYSTEMS AFFECTED FOR INTERIM STARTUP

The reanalysis for interim startup includes those lines originally computer analyzed with the SHOCK2 code and which are necessary for safe shutdown. In order to evaluate safety system lines which have interconnecting ties with nonsafety system lines, the reanalysis was extended to include lines attached to the safety systems, past the first automatic trip valve or the first normally closed manual valve, to the first piping anchor.

| <u>System</u> | <u>Line Number</u> | <u>Problem No.</u> | <u>FSAR Fig. No.</u> |
|----------------------|---------------------|--------------------|----------------------|
| Reactor Coolant (RC) | 29"-RC-4-2501R-Q1 | 653A | 4-1 |
| | 27.5"-RC-6-2501R-Q1 | | |
| | 31"-RC-5-2501R-Q1 | | |
| | 8"-RC-29-2501R-Q1 | | |
| | 8"-RC-27-2501R-Q1 | | |
| | 31"-RC-8-2501R-Q1 | 653C | 4-1 |
| | 29"-RC-7-2501R-Q1 | | |
| | 27.5"-RC-9-2501R-Q1 | | |
| | 8"-RC-37-2501R-Q1 | | |
| | 8"-RC-39-2501R-Q1 | | |
| | 14"-RC-86-2501R-Q1 | | 4-1,4-2 |
| | 29"-RC-1-2501R-Q1 | 653B | 4-1 |
| | 27.5"-RC-3-2501R-Q1 | | |
| | 31"-RC-2-2501R-Q1 | | |
| | 8"-RC-17-2501R-Q1 | | |
| | 8"-RC-19-2501R-Q1 | | |
| | 12"-RC-111-602 | 833 & 8 | 4-2 |
| | 6"-RC-100-602 | | |
| | 6"-RC-101-602 | | |
| | 6"-RC-102-602 | | |
| | 6"-RC-108-602 | | |
| | 6"-RC-104-1502-Q1 | | |
| | 6"-RC-97-1502-Q1 | | |
| | 6"-RC-98-1502-Q1 | | |
| | 6"-RC-99-1502-Q1 | | |
| | 3"-RC-105-1502-Q1 | | |
| | 3"-RC-106-1502-Q1 | 1200 | 4-1,4-2 |
| | 3"-RC-107-1502-Q1 | | |
| | 4"-RC-71-1502-Q1 | 1201 | 4-1,4-2 |
| | 4"-RC-72-1502-Q1 | | |
| | 4"-RC-71-1502-Q1 | 1201 | 4-1,4-2 |
| | 4"-RC-72-1502-Q1 | | |

BEAVER VALLEY POWER STATION, UNIT 1

| <u>System</u> | <u>Line Number</u> | <u>Problem No.</u> | <u>FSAR Fig. No.</u> |
|--------------------------|--------------------|------------------------|--------------------------|
| Safety Injection (SI) | 6"-SI-41-153W-Q2 | 100 | 9.1-1 |
| | 6"-SI-42-153W-Q2 | | |
| | 6"-SI-40-153W-Q2 | | |
| | 12"-SI-110-602-Q1 | 653C | 6.3-2 |
| | 12"-SI-111-1502-Q2 | | 4-1, 6.3-2 |
| | 6"-SI-40-153W-Q2 | 102 | 9.1-1 |
| | 6"-SI-44-153W-Q2 | | |
| | 8"-SI-2-153W-Q2 | | |
| | 8"-SI-2-153W-Q3 | 2112 | 6.3-1 |
| | 8"-SI-2-153W-Q3 | 1011 | 6.3-1, 9.1-1 |
| | 12"-SI-5-153A-Q2 | 610 | 6.3-1, |
| | 12"-SI-6-153A-Q2 | | 6.3-2 |
| | 12"-SI-7-153A-Q2 | | |
| | 12"-SI-8-153A-Q2 | | |
| | 12"-SI-13-153A-Q2 | | |
| | 12"-SI-6-153A-Q2 | 613 | 6.3-1, |
| | 12"-SI-1-153W-Q2 | | 6.3-2 |
| | 10"-SI-15-1502-Q1 | 615 | |
| | 10"-SI-16-153W-Q2 | | |
| | 10"-SI-17-153W-Q2 | | |
| | 10"-SI-18-1502-Q1 | | |
| | 10"-SI-26-153W-Q2 | | |
| | 10"-SI-27-153W-Q2 | | |
| | 10"-SI-28-1502-Q1 | | |
| | 6"-SI-32-1502-Q1 | | |
| | 6"-SI-33-1502-Q1 | | |
| | 6"-SI-34-1502-Q1 | 615 | 6.3-1, |
| | 6"-SI-40-153W-Q2 | | 6.3-2 |
| | 6"-SI-44-153W-Q2 | | |
| | 12"-SI-121-1502-Q1 | 15 | 6.3-2,4-1 |
| | 12"-SI-108-602-Q2 | | |
| | 12"-SI-1-153W-Q3 | 391A | 6.3-1, 6.4-1 |
| | 8"-SI-2-153W-Q3 | | 6.3-1 |
| | 12"-SI-101-1502-Q1 | 14 | 6.3-2,4-1 |
| | 10"-RH-23-1502-Q1 | | 9.3-1 |
| | 12"-SI-120-602-Q2 | | |
| | 10"-RH-16-602-Q2 | | |
| | 6"-SI-30-1502-Q1 | 301 | 6.3-2 |

BEAVER VALLEY POWER STATION, UNIT 1

| <u>System</u> | <u>Line Number</u> | <u>Problem No.</u> | <u>FSAR Fig. No.</u> |
|--|--------------------|--------------------|----------------------|
| Quench Spray (QS) | 6"-SI-29-1502-Q1 | | |
| | 6"-SI-20-1502-Q1 | | |
| | 6"-SI-19-1502-Q1 | | |
| | 6"-SI-32-1502-Q1 | | |
| | 6"-SI-33-1502-Q1 | | |
| | 6"-SI-40-153W-Q2 | 2113 | 6.3-1 |
| | 6"-SI-44-153W-Q2 | 213 | 6.3-1 |
| | 12"-QS-2-153B-Q3 | 211 | 6.4-1 |
| | 12"-QS-1-153B-Q3 | 212 | 6.4-1 |
| | 12"-QS-1-153B-Q3 | 228 | 6.4-1 |
| Recirculation Spray (RS) | 12"-QS-2-153B-Q3 | 229 | 6.4-1 |
| | 12"-RS-7-153A-Q2 | 612 | 6.4-1 |
| | 12"-RS-8-153A-Q2 | | |
| | 12"-RS-5-153A-Q2 | | |
| | | | |
| Charging and Volume Control (CH) | 6"-CH-63-153W-Q2 | 100 | 9.1-1 |
| | 6"-CH-67-153W-Q2 | | |
| | 8"-CH-15-153W-Q2 | | |
| | 8"-CH-15-153W-Q2 | 102 | |
| | 6"-CH-68-153W-Q2 | | |
| Residual Heat Removal (RH) | 12"-RH-6-602-Q2 | 255A | 9.3-1 |
| | 12"-RH-9-602-Q2 | | |
| | 12"-RH-12-602-Q2 | | |
| | 10"-RH-4-602-Q2 | | |
| | 10"-RH-5-602-Q2 | | |
| | 10"-RH-7-602-Q2 | | |
| | 10"-RH-8-602-Q2 | | |
| | 10"-RH-10-602-Q2 | | |
| | 10"-RH-19-602-Q2 | | |
| | 12"-RH-9-602-Q2 | 256 | 9.3-1 |
| | 12"-RH-12-602-Q2 | | |
| | 10"-RH-16-602-Q2 | | |
| | 10"-RH-17-602-Q2 | | |
| | 6"-RH-20-602-Q2 | | |
| | 3"-RH-13-602-Q2 | | |
| | 10"-RH-16-602-Q2 | 3011 | 9.3-1 |

BEAVER VALLEY POWER STATION, UNIT 1

| <u>System</u> | <u>Line Number</u> | <u>Problem No.</u> | <u>FSAR Fig. No.</u> |
|-------------------|--------------------|--------------------|----------------------|
| | 14"-RH-1-1502-Q1 | 653B | 4-1,9.3-1 |
| | 14"-RH-2-602-Q2 | | |
| | 14"-RH-18-602-Q2 | | |
| | 10"-RH-24-1502-Q1 | 653C | 6.3-2 |
| | 10"-RH-23-1502-Q2 | 14 | 9.3-1, 6.3-2 |
| | 6"-RH-14-152-Q2 | 616 | 9.3-1 |
| Component Cooling | 18"-CC-118-151-Q3 | 302 | 9.4-4 |
| | 18"-CC-116-151-Q3 | 303 | 9.4-4 |
| | 18"-CC-114-151-Q3 | 304 | 9.4-4 |
| | 18"-CC-130-151-Q3 | 305 | 9.4-4 |
| | 8"-CC-255-151-Q3 | 306 | 9.4-3 |
| | 8"-CC-256-151-Q3 | | |
| | 8"-CC-257-151-Q3 | | |
| | 6"-CC-261-151-Q3 | | |
| | 8"-CC-476-151-Q3 | | |
| | 6"-CC-258-151-Q3 | 307 | 9.4-3 |
| | 6"-CC-265-151-Q3 | | |
| | 8"-CC-259-151-Q3 | | |
| | 8"-CC-260-151-Q3 | | |
| | 8"-CC-517-151-Q3 | | |
| | 6"-CC-519-151-Q3 | 215 | 9.4-4 |
| | 24"-CC-125-151-Q3 | | |
| | 18"-CC-489-151-Q2 | | |
| | 18"-CC-490-151-Q2 | | |
| | 18"-CC-529-151-Q3 | | |
| | 18"-CC-530-151-Q3 | | |
| | 6"-CC-488-151-Q2 | | |
| | 6"-CC-526-151-Q3 | | |
| | 4"-CC-487-151-Q3 | | |
| | 4"-CC-525-151-Q2 | | |
| | 3"-CC-486-151-Q3 | | |
| | 3"-CC-523-151-Q2 | | |
| | 2"-CC-485-151-Q2 | | |
| | 2"-CC-524-151-Q3 | | |
| | 24"-CC-266-151-Q3 | | |
| | 6"-CC-518-151-Q3 | | |
| | 24"-CC-112-151-Q3 | 217 | 9.4-3, 9.4-4 |
| | 24"-CC-113-151-Q3 | | |

541 116

BEAVER VALLEY POWER STATION, UNIT 1

| <u>System</u> | <u>Line Number</u> | <u>Problem No.</u> | <u>FSAR Fig. No.</u> |
|-----------------------|--------------------|--------------------|----------------------|
| | 6"-CC-510-151-Q3 | | 9.4-3, |
| | 6"-CC-511-151-Q3 | | 9.4-4 |
| | 6"-CC-512-151-Q3 | | |
| | 6"-CC-482-151-Q3 | | |
| | 18"-CC-483-151-Q3 | | |
| | 18"-CC-484-151-Q3 | | |
| | 18"-CC-527-151-Q3 | | |
| | 18"-CC-528-151-Q3 | | |
| | 8"-CC-517-151-Q2 | 214 | 9.4-3 |
| | 6"-CC-481-151-Q2 | 930 | 9.4-4 |
| | 6"-CC-511-151-Q3 | | |
| | 6"-CC-480-151-Q2 | 931 | 9.4-4 |
| | 6"-CC-510-151-Q3 | | |
| Chilled Water (CW) | 8"-CW-8-151 | 216 | 9.4-3 |
| | 8"-CW-9-151 | 214 | 9.4-3 |
| River Water (WR) | 6"-WR-117-151-Q3 | 203 | 10.3-5 |
| | 14"-WR-64-151-Q2 | 30 | 9.9-1A |
| | 14"-WR-82-151-Q2 | 31 | 9.9-1A |
| | 14"-WR-89-151-Q2 | 32 | 9.9-1A |
| | 14"-WR-87-151-Q2 | 33 | 9.9-1A |
| | 8"-WR-228-151-Q3 | 140 | 9.9-1 |
| | 8"-WR-229-151-Q3 | | |
| | 8"-WR-230-151 | | |
| | 8"-WR-231-151 | | |
| | 8"-WR-234-151-Q3 | 214 | 9.4-3 |
| | 14"-WR-63-151-Q2 | 1 | 9.9-1A |
| | 14"-WR-65-151-Q2 | | |
| | 14"-WR-86-151-Q2 | | |
| | 14"-WR-88-151-Q2 | | |

BEAVER VALLEY POWER STATION, UNIT 1

| <u>System</u> | <u>Line Number</u> | <u>Problem No.</u> | <u>FSAR Fig. No.</u> |
|---------------|---|------------------------|--------------------------|
| | 14"-WR-25-151-Q3 14"-WR-26-151-Q3 14"-WR-27-151-Q3 14"-WR-28-151-Q3 24"-WR-29-151-Q3 | 120 | 9.9-1A |
| | 14"-WR-21-151-Q3 14"-WR-22-151-Q3 14"-WR-23-151-Q3 14"-WR-24-151-Q3 24"-WR-19-151-Q3 24"-WR-20-151-Q3 | 123 | 9.9-1A |
| | 24"-WR-19-151-Q3 24"-WR-187-151-Q3 | 124 | 9.9-1A |
| | 24"-WR-20-151-Q3 24"-WR-186-151-Q3 | 125 | 9.9-1A |
| | 24"-WR-7-151-Q3 24"-WR-8-151-Q3 24"-WR-9-151-Q3 18"-WR-11-151-Q3 18"-WR-12-151-Q3 18"-WR-13-151-Q3 | 126 | 9.9-1A |
| | 24"-WR-19-151-Q3 | 127 | 9.9-1A |
| | 24"-WR-20-151-Q3 | 128 | 9.9-1A |
| | 24"-WR-99-151-Q3 | 157 | 9.9-1A |
| | 24"-WR-100-151-Q3 | 158 | 9.9-1A,B |
| | 20"-WR-1-151-Q3 20"-WR-2-151-Q3 20"-WR-3-151-Q3 20"-WR-4-151-Q3 20"-WR-5-151-Q3 20"-WR-6-151-Q3 24"-WR-99-151-Q3 24"-WR-100-151-Q3 18"-WR-154-151-Q3 12"-WR-177-151-Q3 | 159(1) | 9.9-1A,B |
| | 8"-WR-227-151 | 216 | 9.4-3, 9.9-1A |
| | 30"-WR-171-151-Q3 | 5452 | 9.9-1B |

118

BEAVER VALLEY POWER STATION, UNIT 1

| <u>System</u> | <u>Line Number</u> | <u>Problem No.</u> | <u>FSAR Fig. No.</u> |
|--------------------|--------------------|--------------------|----------------------|
| | 30"-WR-172-151-Q3 | | |
| | 30"-WR-175-151-Q3 | | |
| | 10"-SWW-14-151-Q3 | 165(2) | 9.9-1B |
| | 10"-SWW-1-121 | | |
| | 18"-WR-14-151-Q3 | 121 | 9.9-1A |
| | 18"-WR-15-151-Q3 | | |
| | 18"-WR-16-151-Q3 | | |
| | 30"-WR-17-151-Q3 | 122 | 9.9-1A |
| | 6"-WR-155-151-Q3 | 384 | 9.9-1B |
| | 6"-WR-214-151-Q3 | 652 | RM-53A |
| | 6"-WR-215-151-Q3 | 653 | RM-53A |
| Main Steam (MS) | 3"-SDHV-1-601-Q2 | 101 | 10.3-1 |
| | 3"-SDHV-2-601-Q2 | | |
| | 3"-SDHV-3-601-Q2 | | |
| | 4"-SDHV-4-601-Q2 | | |
| | 32"-SHP-56-601-Q2 | 658 | 10.3-1 |
| | 32"-SHP-57-601-Q2 | 659 | 10.3-1 |
| | 32"-SHP-58-601-Q2 | 660 | 10.3-1 |
| | 4"-SHP-19-601-Q2 | 6590 | 10.3-1 |
| | 4"-SHP-20-601-Q2 | | |
| | 4"-SHP-21-601-Q2 | | |
| | 6"-SAE-1-601 | | |
| | 6"-SAE-2-601 | | |
| | 6"-SAE-3-601 | | |
| | 32"-SHP-56-601-Q2 | 3063 | 10.3-1 |
| | 32"-SHP-57-601-Q2 | | |
| | 32"-SHP-58-601-Q2 | | |
| | 32"-SHP-22-601-Q2 | | |
| | 32"-SHP-23-601-Q2 | | |
| | 32"-SHP-24-601-Q2 | | |
| | 10"-SSVD-1-601 | | |
| | 10"-SSVD-2-601 | | |
| | 10"-SSVD-3-601 | | |
| | 10"-SSVD-4-601 | | |
| | 10"-SSVD-5-601 | | |
| | 10"-SSVD-6-601 | | |
| | 10"-SSVD-7-601 | | |
| | 10"-SSVD-8-601 | | |

541 119

BEAVER VALLEY POWER STATION, UNIT 1

| <u>System</u> | <u>Line Number</u> | <u>Problem No.</u> | <u>FSAK Fig. No.</u> |
|-----------------------------------|--------------------|--------------------|----------------------|
| | 10"-SSVD-9-601 | | |
| | 10"-SSVD-10-601 | | |
| | 10"-SSVD-11-601 | | |
| | 10"-SSVD-12-601 | | |
| | 10"-SSVD-13-601 | | |
| | 10"-SSVD-14-601 | | |
| | 10"-SSVD-15-601 | | |
| Main and Auxiliary Feedwater (FW) | 4"-WAPD-3-601-Q3 | 204 | 10.3-5 |
| | 4"-WAPD-4-601-Q3 | | |
| | 4"-WAPD-5-601-Q3 | | |
| | 4"-WAPD-6-601-Q3 | | |
| | 6"-WAPD-1-601-Q3 | | |
| | 6"-WAPD-2-601-Q3 | | |
| | 16"-WFPD-22-601-Q2 | 783 | 10.3-5 |
| | 16"-WFPD-24-601-Q2 | 784 | 10.3-5 |
| | 16"-WFPD-23-601-Q2 | 785 | 10.3-5 |
| | 16"-WFPD-9-601-Q2 | 0261 | 10.3-5 |
| | 16"-WFPD-13-601-Q2 | | |
| | 16"-WFPD-17-601-Q2 | | |
| | 6"-WD-23-151-Q3 | 203 | 10.3-5 |
| | 6"-WD-24-151-Q3 | | |
| | 6"-WD-25-151-Q3 | | |
| | 6"-WD-26-151-Q3 | | |
| | 4"-WD-27-151-Q3 | | |
| | 4"-WD-41-151-Q3 | | |
| | 8"-WD-22-151-Q3 | 2031 | 10.3-5 |
| | 6"-WD-25-151-Q3 | | |
| | 6"-WD-26-151-Q3 | | |
| Diesel Generator Exhaust (OL) | 22"-OL-55-151-Q3 | 651 | RM-53A |

NOTES:

- (1) Problems 160 and 161 are included within the scope of the reanalysis effort for problem 159.
- (2) Problem 165 has been analyzed on NUPIPE as part of the Beaver Valley Unit 2 stress analysis effort.

These lines are identified on the flow diagrams included in Appendix C.

BEAVER VALLEY POWER STATION, UNIT 1

In addition to the problems referenced above, a number of other computer analyses were also performed for Beaver Valley - Unit 1, using the SHOCK2 code. These have been excluded from the scope of the reanalysis for interim startup and are discussed in Appendix B.

APPENDIX B

PROBLEMS TO BE REANALYZED IN THE LONG TERM

The problems described in Tables B-1, B-2, and B-3 are within the scope of the long term effort. These problems are identified on the flow diagrams included in Appendix D.

1. Primary Component Cooling Water System

The primary component cooling water (CC) system is used during normal operation and cooldown to remove heat from various primary plant components; however, safe shutdown of the reactor (i.e., hot standby) can be achieved without dependence on the CC system. By use of other systems the plant can be maintained in this condition indefinitely while restoration of the CC system is being accomplished.

The responses to the FSAR questions listed in the references below discuss in detail the effects of various CC system pipe breaks and their impacts on the operation of the plant. These discussions demonstrate the capability of the plant to maintain a safe shutdown condition without the availability of the CC system. The response to FSAR Question 9.33

541 122

BEAVER VALLEY POWER STATION, UNIT 1

describes the method of repair and the expected repair times for cracks and breaks of various severities. As mentioned in that response, the worst case repair (the addition of a piece of pipe) can be made within 5 days.

In summary, problems associated with the CC system outside the containment are included in the long-term reanalysis effort because the CC system is not required either to attain or maintain a safe shutdown condition. Table B-1 identifies the CC problems to be addressed in the long term.

References: FSAR Section 9.4.

FSAR Questions 9.2, 9.10, 9.11, 9.13, 9.33, 9.34, and 9.35.

2. Other Safety Systems

Table B-2 identifies the SHOCK2 problems that are within the scope of the long-term reanalysis effort; these lines are not required for safe shutdown.

3. Hand Calculations

Table B-3 identifies SHOCK2 problems that are not within the scope of the interim startup or long-term reanalysis effort; these SHOCK2 runs are only

BEAVER VALLEY POWER STATION, UNIT 1

check calculations of manual hand calculations. They are identified here only to show the scope of the original SHOCK2 effort.

4. Superseded Calculations

The following SHOCK2 runs have been superseded by a problem presently within the interim and long term reanalysis effort.

| Superseded <u>SHOCK2 Run</u> | New Problem <u>Number</u> |
|---------------------------------|------------------------------|
| 122A | 122 |
| 312 | 840 |
| 657 | 785 |
| 916 | 217 |
| 1012 | 391 |
| 2110 | 341B |
| 6230 | 310 |

5. Seismically Supported Non-O Lines

The following lines are not safety related but have been seismically supported as designated by an "E" in the line designation table.

BEAVER VALLEY POWER STATION, UNIT 1

2"-CV-1-154

2"-SHPD-5-601

2"-SHPD-6-601

2"-SHPD-7-601

2"-SHPD-8-601

1/4-SS-163-N9

1/4-SS-173-N9

1/4-SS-174-N9

BEAVER VALLEY POWER STATION, UNIT 1

TABLE B-2

SAFETY SYSTEMS TO BE ANALYZED IN THE LONG TERM

| <u>System</u> | <u>Line Number</u> | <u>Problem No.</u> | <u>FSAR Fig. No.</u> |
|--|--------------------|--------------------|----------------------|
| Fuel Pool Cooling & Purification System (FC) | 6"-FC-4-152-Q3 | 104 | |
| | 6"-FC-5-152-Q3 | | |
| | 6"-FC-8-152-Q3 | 105E | 9.5-1 |
| | 6"-FC-9-152-Q3 | | |
| | 10"-FC-1-152-Q3 | 198B | 9.5-1 |
| | 6"-FC-2-152-Q3 | | |
| | 6"-FC-31-152-Q3 | | |
| | 4"-FC-10-152 | 107 | 9.5-1 |
| | 4"-FC-11-152 | | |
| | 6"-FC-14-152 | | |
| | 6"-FC-17-152 | | |
| | 6"-FC-32-152 | | |
| Quench Spray (QS) | 10"-QS-4-153B-Q3 | 614 | 6.4-1 |
| | 10"-QS-3-153B-Q3 | 617 | 6.4-1 |
| | 4"-QS-6-153B-Q3 | 210 | 6.4-1 |
| | 10"-QS-4-153B-Q3 | | |
| | 4"-QS-5-153B-Q3 | 218 | 6.4-1 |
| | 10"-QS-3-153B-Q3 | | |
| Recirculation Spray (RS) | 4"-RS-14-153B-Q2 | 611 | 6.4-1 |
| | 10"-RS-10-153B-Q2 | | |
| | 4"-RS-15-153B-Q2 | | |
| River Water (WR) | 30"-WR-175-151-Q3 | 153 | 9.9-1B |

541 126

BEAVER VALLEY POWER STATION, UNIT 1

TABLE B-3

HAND CALCULATIONS CHECKED BY SHOCK2

| <u>System</u> | <u>Line Number</u> | <u>Problem No.</u> |
|---|--------------------|--|
| High Pressure Steam (SHP) | 3"-SHP-26-601-Q2 | 3043 |
| | 3"-SHP-31-601-Q2 | |
| Steam Generator Auxiliary Feedwater Pump Discharge (WAPD) | 3"-WAPD-13-601-Q3 | 207 |
| | 3"-WAPD-11-601-Q3 | 208 |
| Generator Water Blowdown (WGCB) | 3"-WGCB-8-601-Q2 | 309, |
| | 3"-WGCB-12-601-Q2 | 3017, 6220, 3002, 3018, 6216 |
| | 3"-WGCB-4-601-Q2 | 310 |
| | 3"-WGCB-4-601-Q2 | 3100 |
| Fuel Pool Cooling and Purification System (FC) | 6"-FC-12-152-Q2 | 301 |
| | 6"-FC-17-152-Q2 | 655C |
| Charging and Volume Control System (CH) | 3"-CH-125-1503-Q2 | 911, 260, 3001 |
| | 2"-CH-97-1502-Q1 | 200 |
| | 2"-CH-141-1503-Q1 | 220 |
| | 2"-CH-100-1502-Q2 | 230 |
| | 2"-CH-186-152-Q2 | |
| | 2"-CH-1-1502-Q1 | 240 |
| | 2"-CH-96-1502-Q1 | 250 |
| | 2"-CH-23-1502-Q1 | 300 |
| | 2"-CH-143-1502-Q1 | 350 |
| | 2"-CH-149-1502-Q1 | |
| | 2"-CH-145-602-Q1 | |
| | 2"-CH-2-602-Q1 | |
| | 2"-CH-3-602-Q1 | |

BEAVER VALLEY POWER STATION, UNIT 1

TABLE B-3 (Cont)

| <u>System</u> | <u>Line Number</u> | <u>Problem No.</u> |
|-----------------------|---------------------|------------------------|
| | 2"-CH-4-602-Q1 | |
| | 2"-CH-146-152-Q3 | |
| | 3/4"-CH-115-1502-Q2 | 380 |
| | 2"-CH-2-602-Q2 | 702 |
| | 2"-CH-148-602-Q2 | 703 |
| | 3"-CH-106-153W-Q2 | 901, 3135 |
| | 3"-CH-107-153W-Q2 | 3135 |
| | 3"-CH-108-153W-Q2 | 704, 3135 |
| | 3"-CH-110-153W-Q2 | 704, |
| | 3"-CH-111-153W-Q2 | 3057 |
| | 3"-CH-114-152W-Q2 | 3129, 3044 |
| | 4"-CH-14-153W-Q2 | 3057 |
| | 3"-CH-6-153W-Q2 | 3122 |
| | 3"-CH-226-153W-Q2 | |
| | 3"-CH-13-153W-Q2 | 3125 |
| | 4"-CH-72-1503-Q2 | 3131 |
| | 4"-CH-76-1503-Q2 | |
| | 3"-CH-71-1503-Q2 | |
| | 3"-CH-75-1503-Q2 | |
| | 3"-CH-80-1503-Q2 | |
| | 3"-CH-69-1503-Q2 | 3031 |
| | 3"-CH-70-1503-Q2 | |
| | 3"-CH-73-1503-Q2 | |
| | 3"-CH-74-1503-Q2 | |
| | 4"-CH-72-1503-Q2 | |
| | 4"-CH-76-1503-Q2 | |
| | 3"-CH-126-1502-Q1 | 3035 |
| Safety Injection (SI) | 3"-SI-81-1503-Q1&Q2 | 900, 3004 |
| | 3"-SI-140-1503-Q1 | 902, 3004 |

123

BEAVER VALLEY POWER STATION, UNIT 1

TABLE B-3 (Cont)

| <u>System</u> | <u>Line Number</u> | <u>Problem No.</u> |
|-----------------------------------|----------------------|--------------------|
| | 6"-SI-34-1502-Q1 | 3006 |
| | 6"-SI-74-1502-Q1 | |
| | 3"-SI-60-1503-Q2 | 3124 |
| | 3"-SI-57-1503-Q1&Q2 | 900 |
| | 3"-SI-130-1503-Q1&Q2 | 313, 902 |
| | 3"-SI-134-1503-Q2 | 922 |
| | 3"-SI-81-1503-Q2 | 3120 |
| | 3"-SI-56-1503-Q3 | 3052 |
| | 3"-SI-60-1503-Q3 | |
| | 3"-SI-133-1503-Q3 | |
| | 4"-SI-75-1503-Q3 | |
| | 3"-SI-134-1503-Q1 | |
| | 3"-SI-31-153W-Q2 | 3127 |
| | 3"-SI-145-153W-Q2 | |
| | 3"-SI-35-152-Q3 | 965 |
| Residual Heat Removal System (RH) | 6"-RH-14-152-Q2 | 3012 |
| Reactor Coolant (RC) | 3"-RC-13-1502-Q1 | 6530 |
| | 3"-RC-23-1502-Q1 | |
| | 3"-RC-33-1502-Q1 | |
| | 3"-RC-160-153W-Q2 | |
| | 2"-RC-54-1502-Q1 | 220 |
| | 3"-RC-160-153W | 917 |
| | 4"-RC-112-152-Q3 | 360 |
| | 3"-RC-160-153W | 917 |
| | 3"-RC-160-153W-Q2 | 3021 |
| Component Cooling (CC) | 6"-CC-512-151-Q3 | 914 |
| | 4"-CC-487-151-Q2 | 918 |

541 129

BEAVER VALLEY POWER STATION, UNIT 1

TABLE B-3 (Cont)

| <u>System</u> | <u>Line Number</u> | <u>Problem No.</u> |
|--------------------------------------|--------------------|------------------------|
| | 4"-CC-525-151-Q3 | |
| | 3"-CC-235-151-Q3 | 921 |
| | 3"-CC-466-151-Q2 | |
| | 3"-CC-523-151-Q3 | |
| Diesel Generator Oil Line (OL) | 3"-OL-46-151-Q3 | 650 |
| Primary Grade Water (PG) | 3"-PG-5-152 | 917 |
| Quench Spray (QS) | 2"-QS-29-152 | 315X |
| | 6"-QS-30-153B-Q3 | 840 |
| | 6"-QS-31-153B-Q3 | |
| | 6"-QS-16-152 | 139 |
| | 4"-QS-8-152 | 341B |
| Neutron Shield Tank Cooling (NSL) | 6"-NSL-2-152-Q3 | 312 |

541 130


BEAVER VALLEY POWER STATION, UNIT 1

LIST OF FIGURES

| <u>Figure</u> | <u>Title</u> |
|---------------|--|
| 4-1 | Main Coolant System Sh. 1 |
| 4-2 | Main Coolant System Sh. 2 |
| 6.3-1 | Safety Injection System Sh. 1 |
| 6.3-2 | Safety Injection System Sh. 2 |
| 6.4-1 | Containment Depressurization System |
| 9.1-1 | Charging and Volume Control System Sh. 1 |
| 9.3-1 | Residual Heat Removal System |
| 9.4-3 | Component Cooling Water System Sh. 3 |
| 9.4-4 | Component Cooling Water System Sh. 4 |
| 9.9-1A | River Water System |
| 9.9-1B | Intake Structure |
| 10.3-1 | Main Steam System |
| 10.3-5 | Feedwater System |
| RM-53A | Emergency Diesel Generator Fuel and Air System |

541 131

BOOK ORIGINAL

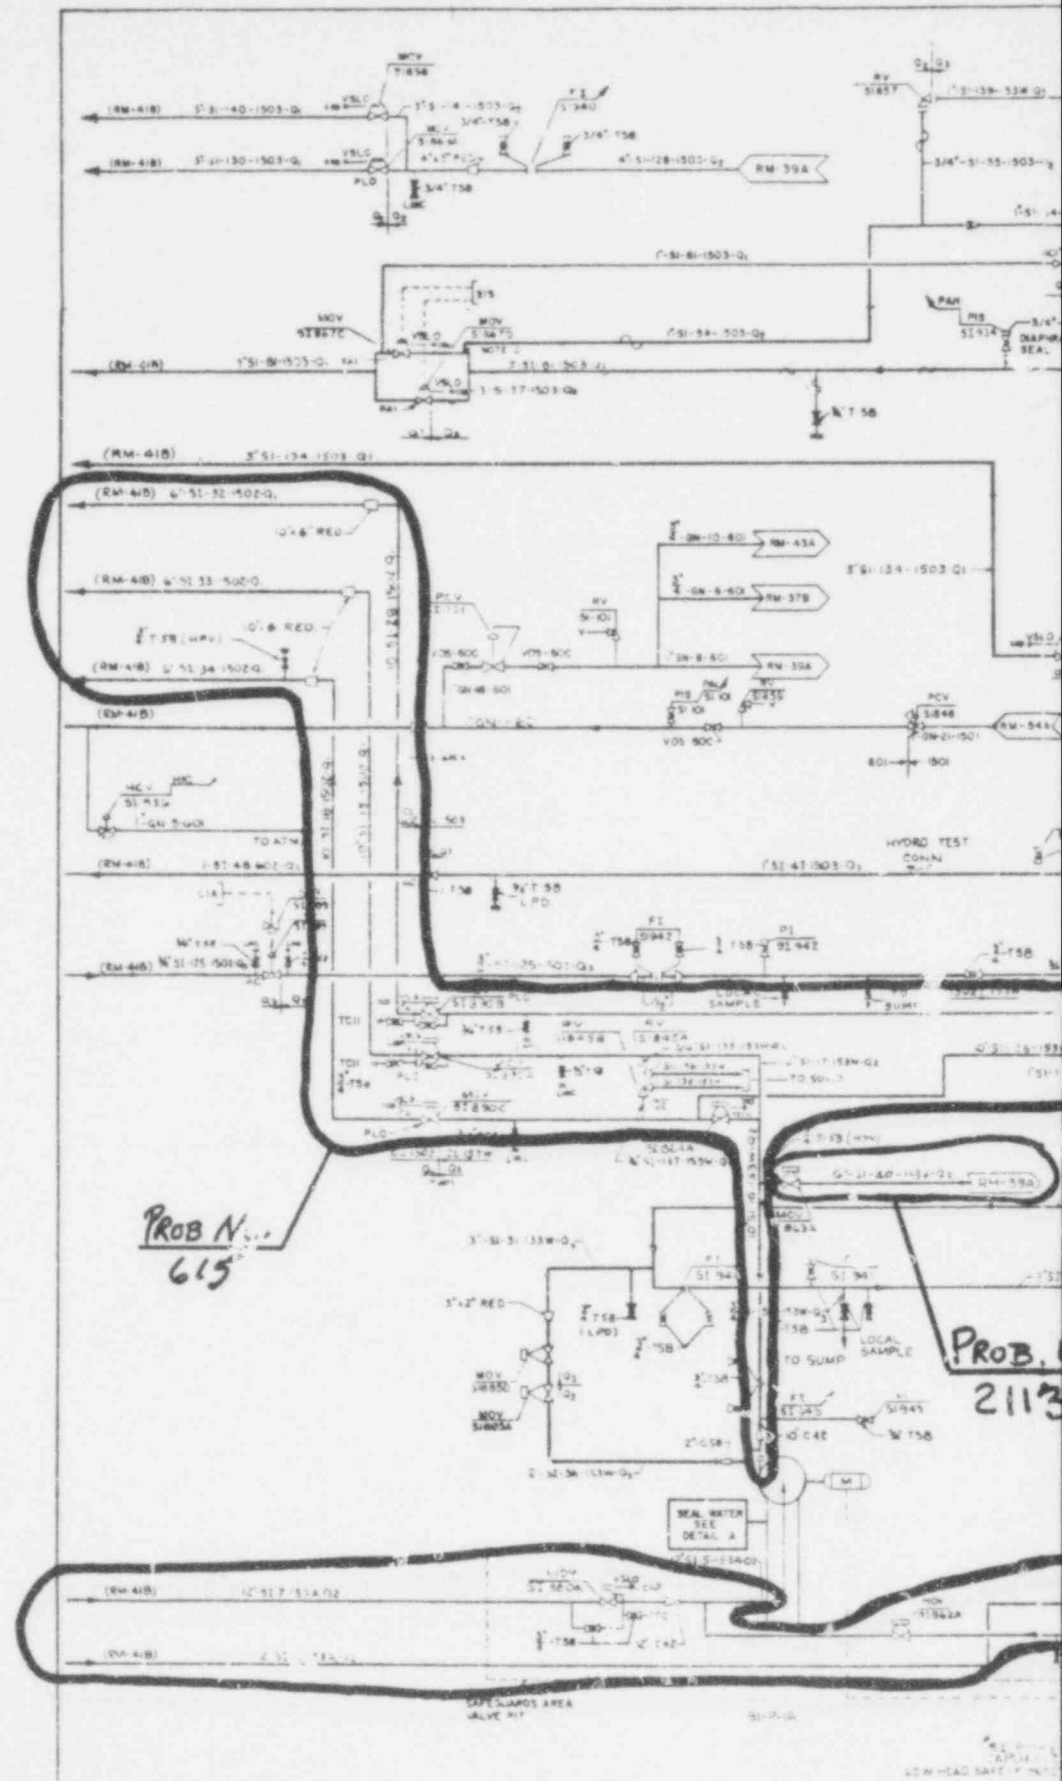


PROB N. 615




PROB. 2113


NOVEMBER 1975

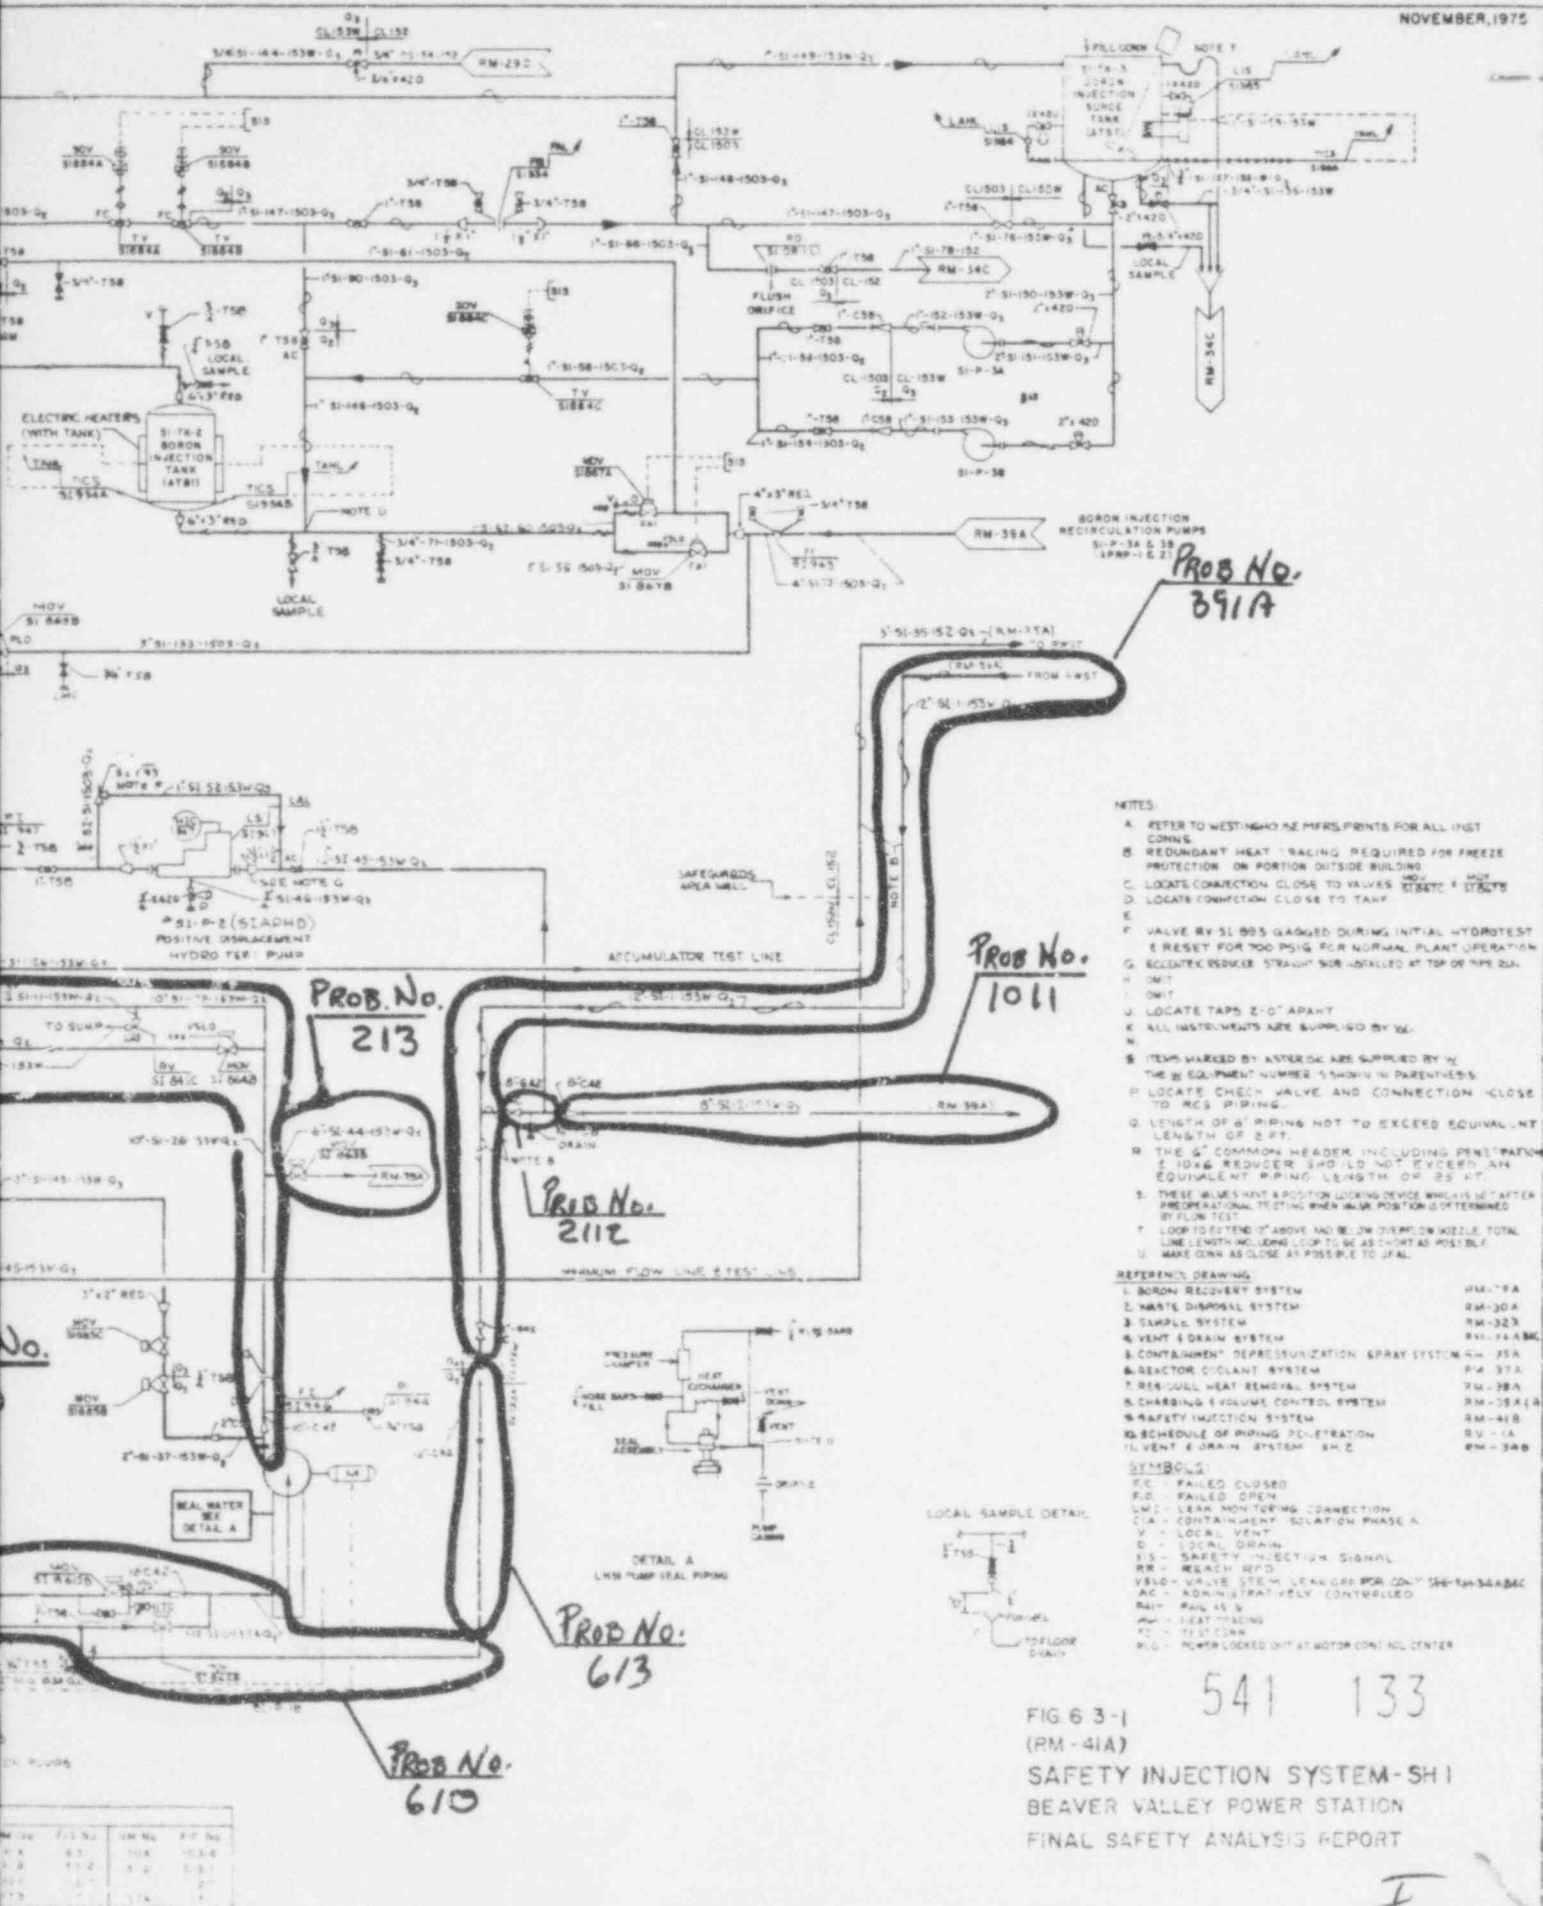


DO NOT WRITE

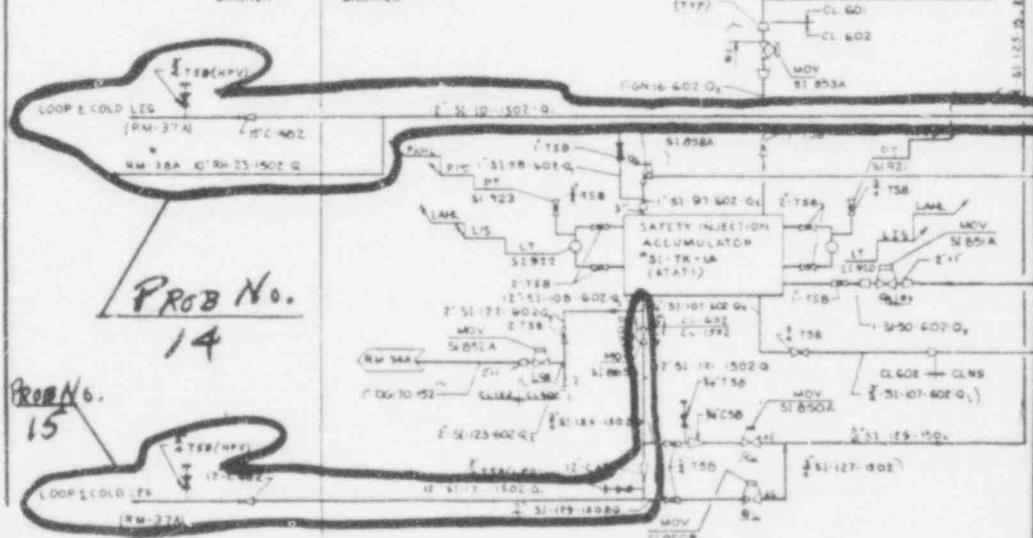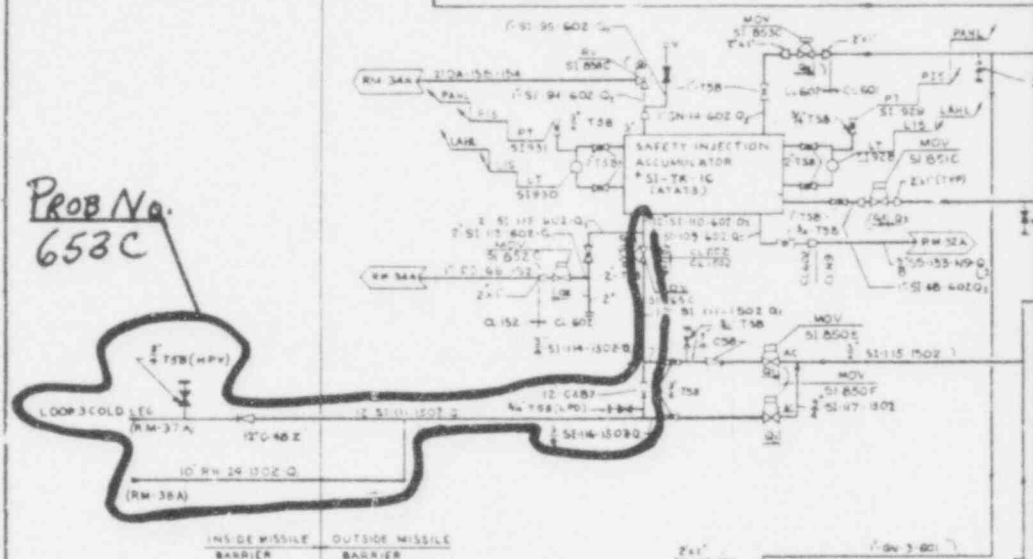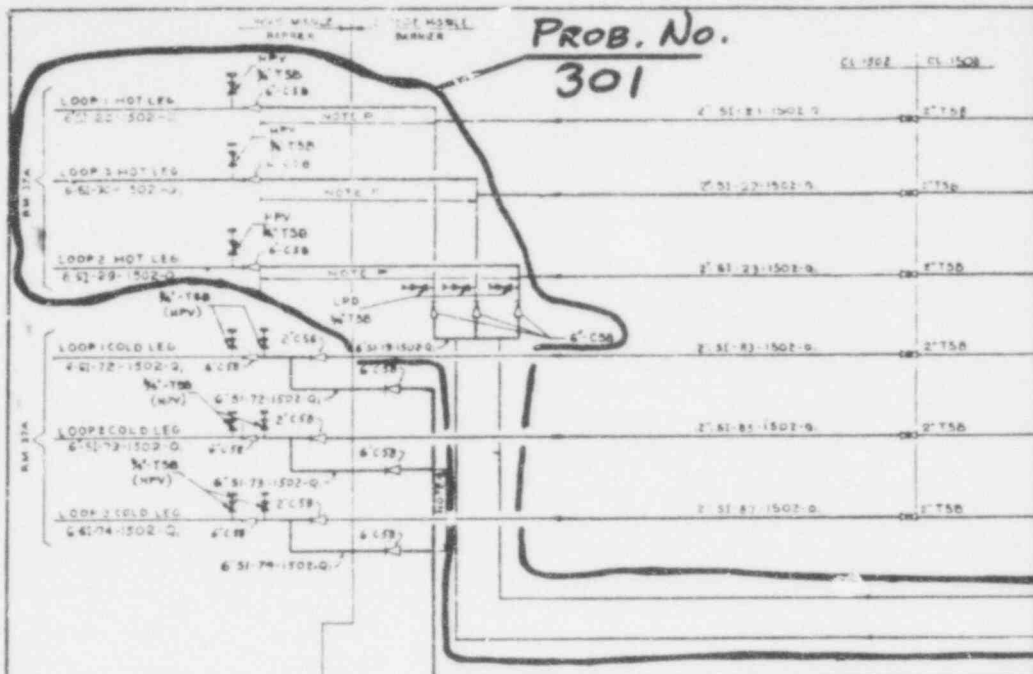

RM No. LEGEND

| RM No. | FIG. No. | RM No. | FIG. No. | RM No. | FIG. No. | RM No. | FIG. No. | RM No. | FIG. No. | RM No. | FIG. No. | RM No. | FIG. No. | RM No. | FIG. No. |
|--------|----------|--------|----------|--------|----------|--------|----------|--------|----------|--------|----------|--------|----------|--------|----------|
| 14A | 103-1 | 21A | 103-2 | 22C | 94-3 | 23B | 93-7 | 30B | 112-4 | 32C | 98-3 | 34C | 97-3 | 37B | 40 |
| 16A | 103-2 | 21B | 99-1 | 22D | 94-4 | 23C | 97-3 | 31A | 93-1 | 33A | 111 | 35A | 94-1 | 38A | 93-1 |
| 17A | 103-4 | 22A | 94-1 | 23A | 98-1 | 24C | 97-4 | 32A | 98 | 34A | 111 | 36A | 94-1 | 39A | 93-1 |
| 18A | 103-3 | 22B | 94-2 | 23B | 94-2 | 24 | 97-4 | 32B | 94-2 | 34B | 97-2 | 37 | 94-1 | 39B | 93-1 |

4/23/73

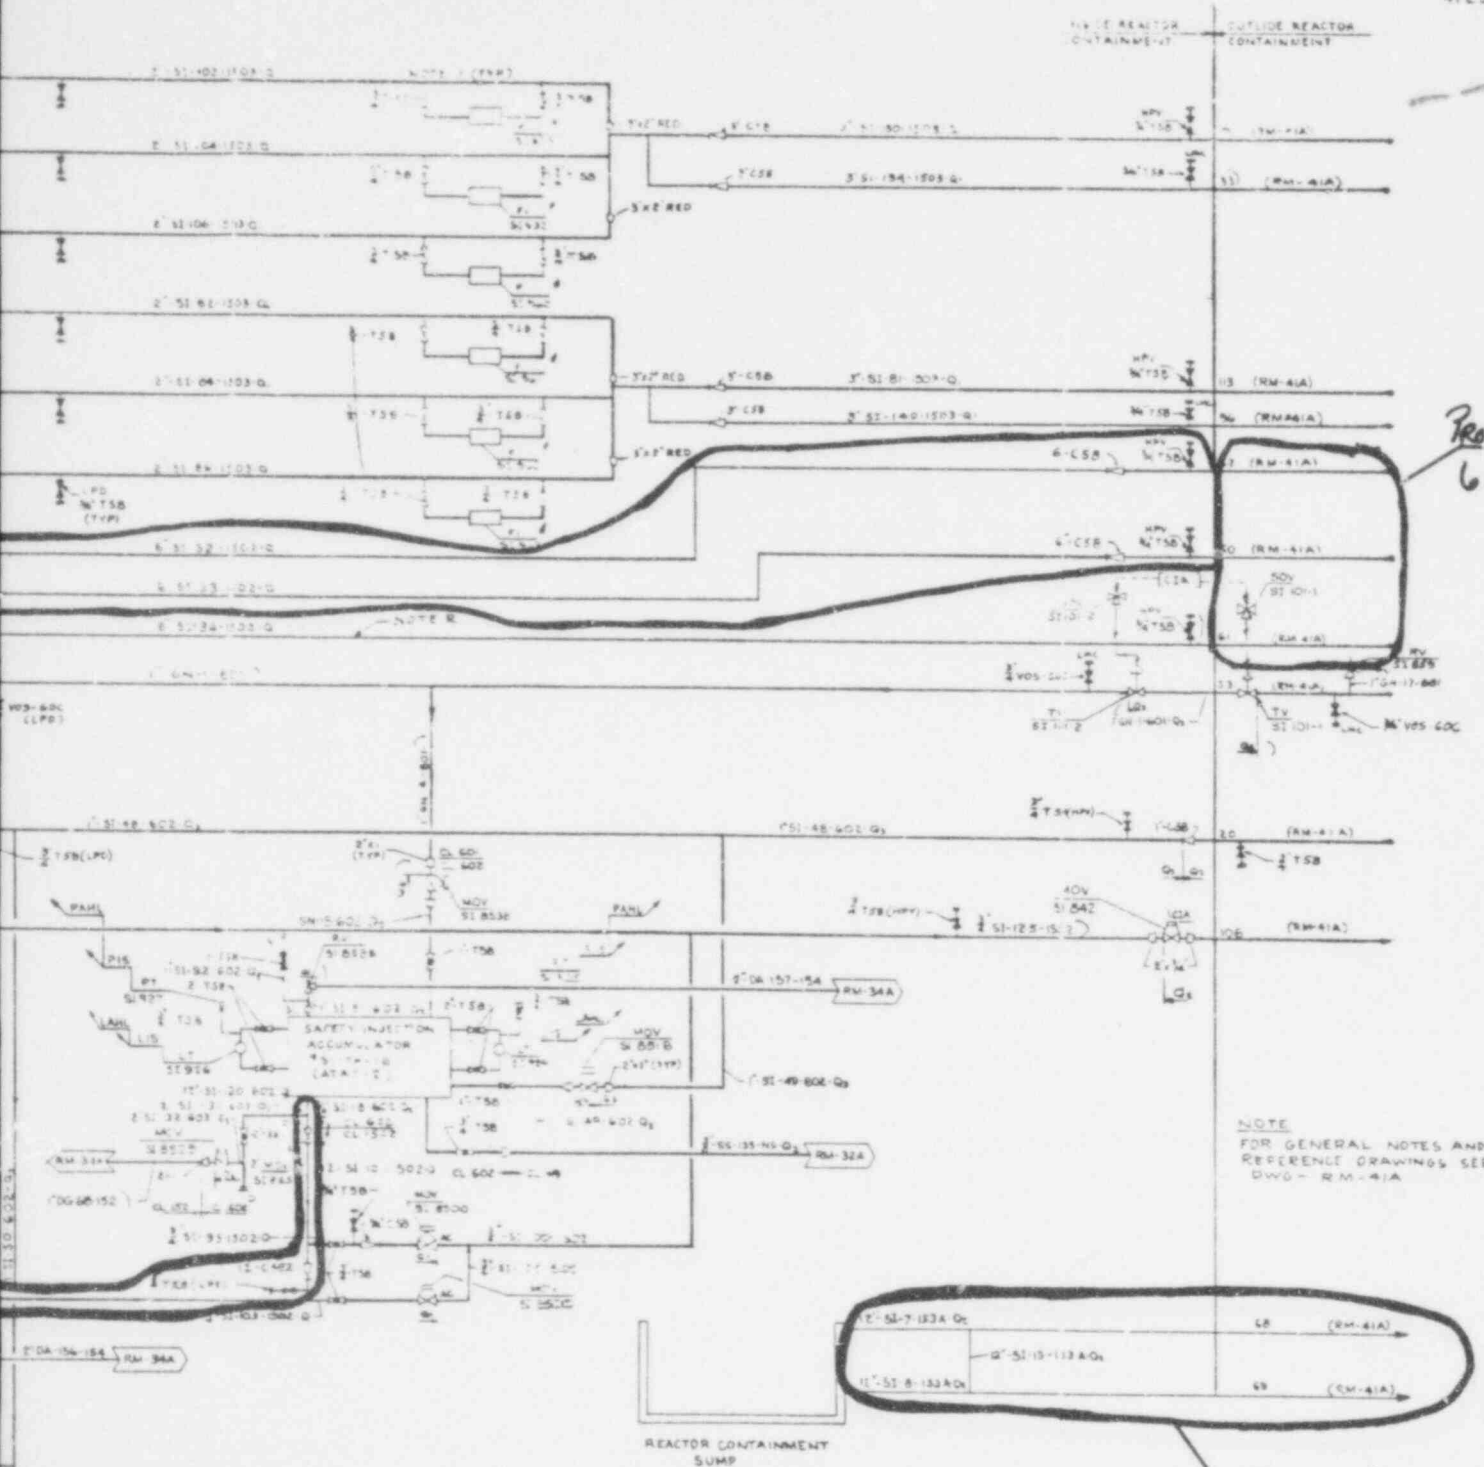
Prob No.
615NOTE
FOR GENERAL NOTES AND
REFERENCE DRAWINGS SEE
DWG - RM-41AProb No.
610

541 135

FIG. 6.3-2
(RM-41B)
SAFETY INJECTION SYSTEM-SH.2
BEAVER VALLEY POWER STATION
FINAL SAFETY ANALYSIS REPORT


POOR ORIGINAL

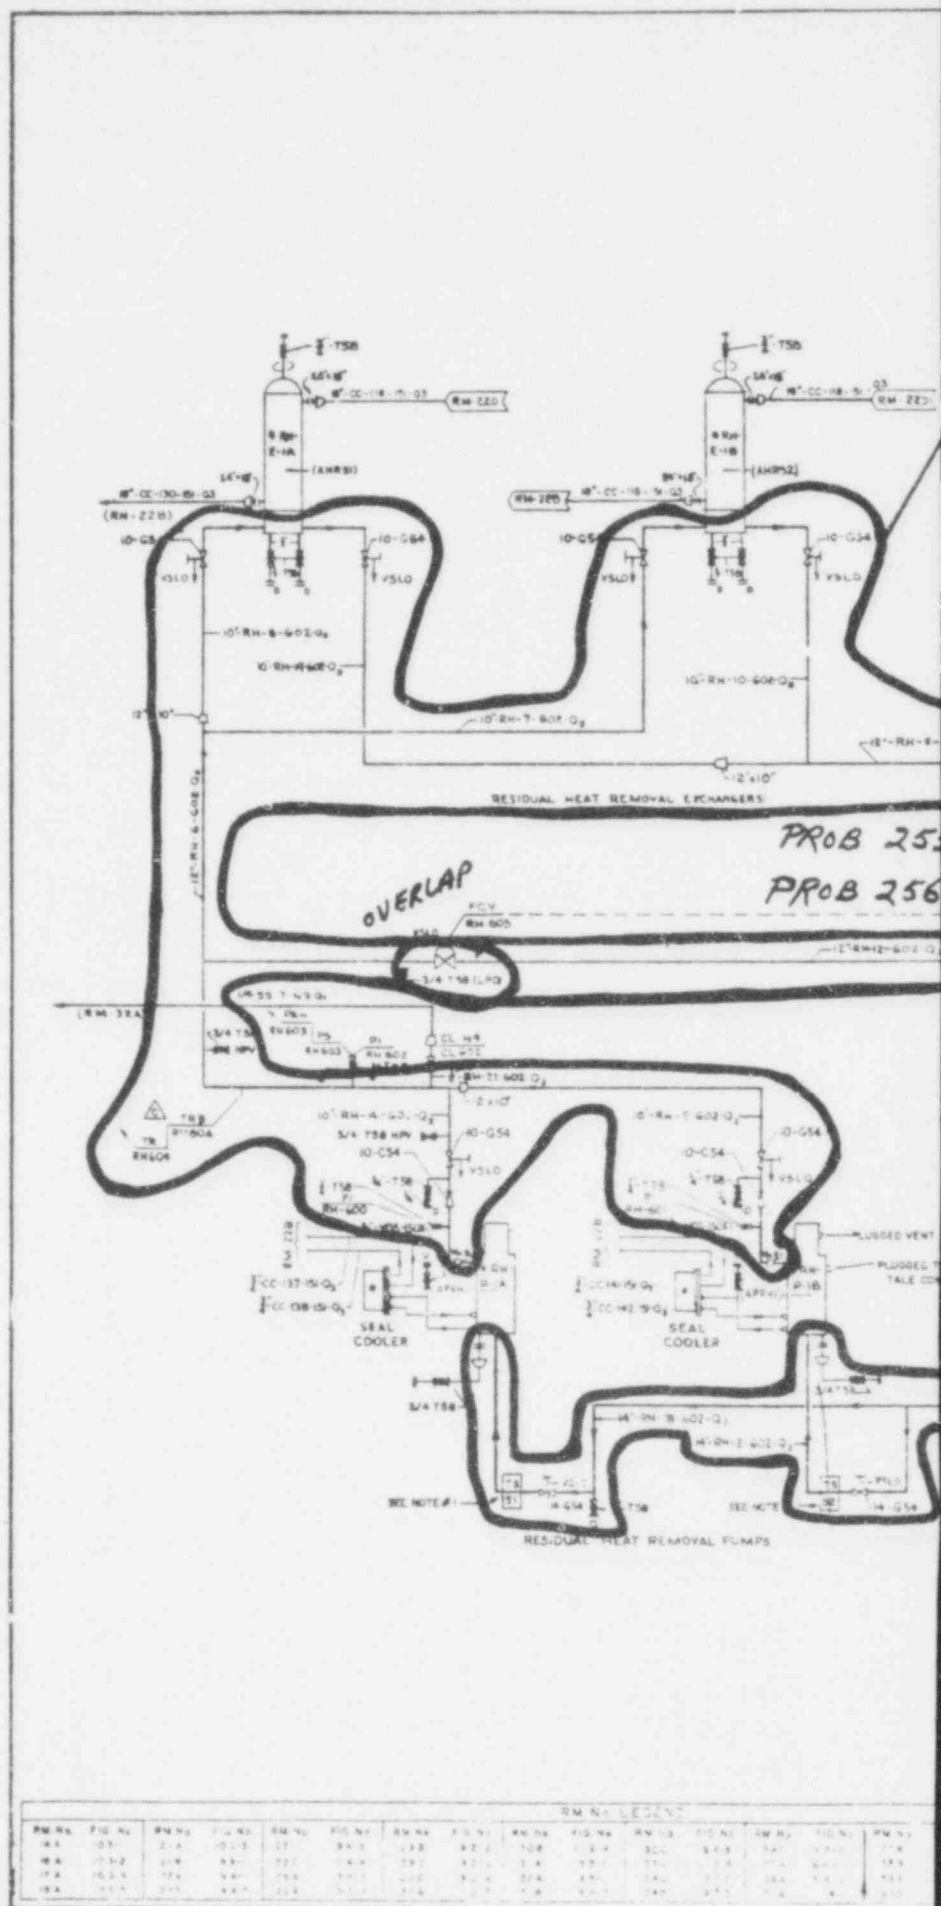

541 136

PROB No.
255A


PROB. No.
616

PROB No.
19/3061

PROB No.
256

PROB No.
653C

PROB No.
653B


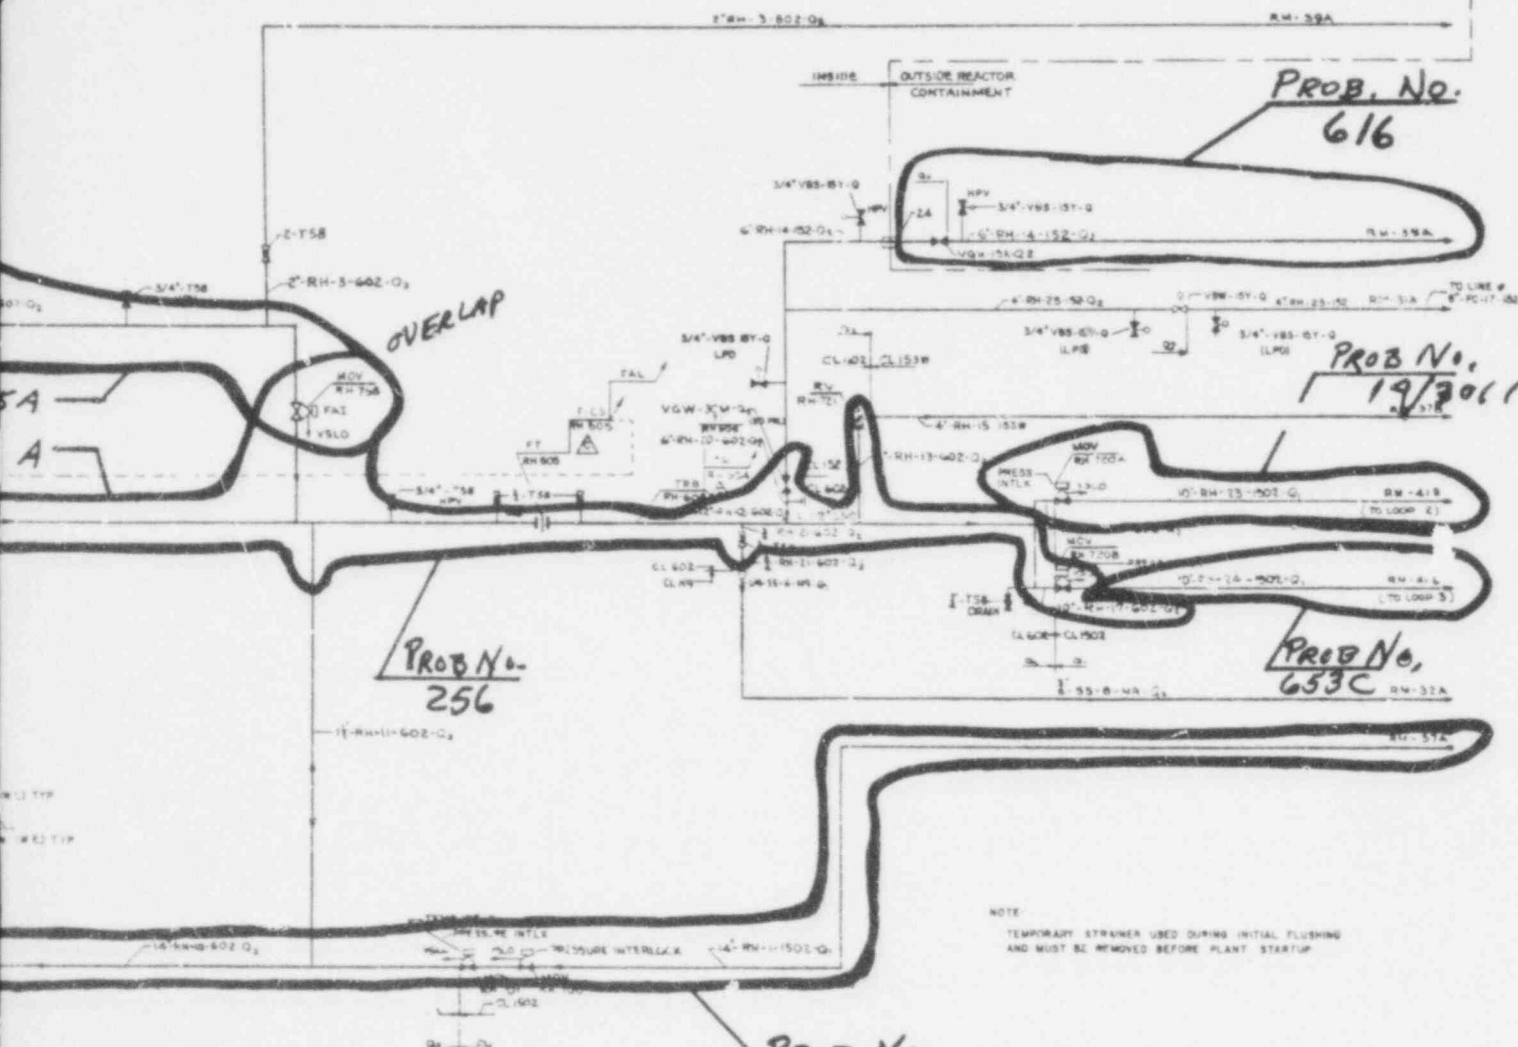




NOTE:
TEMPORARY STRAINER USED DURING INITIAL FLUSHING
AND MUST BE REMOVED BEFORE PLANT STARTUP

541 137

FIG. 9.3-1
(RM-38A)
RESIDUAL HEAT REMOVAL SYSTEM
BEAVER VALLEY POWER STATION
FINAL SAFETY ANALYSIS REPORT

I

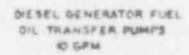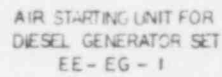

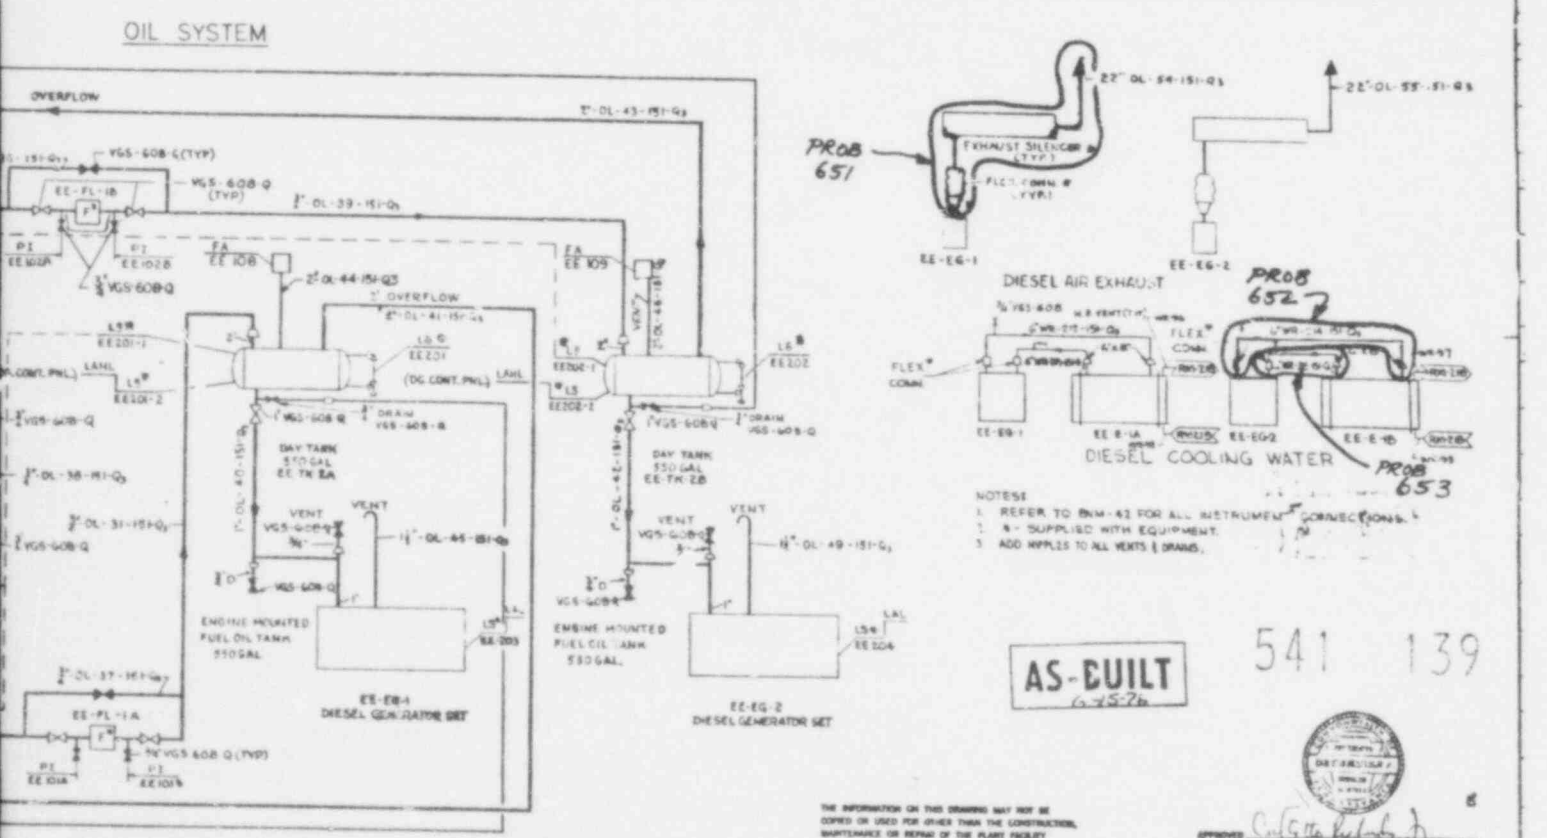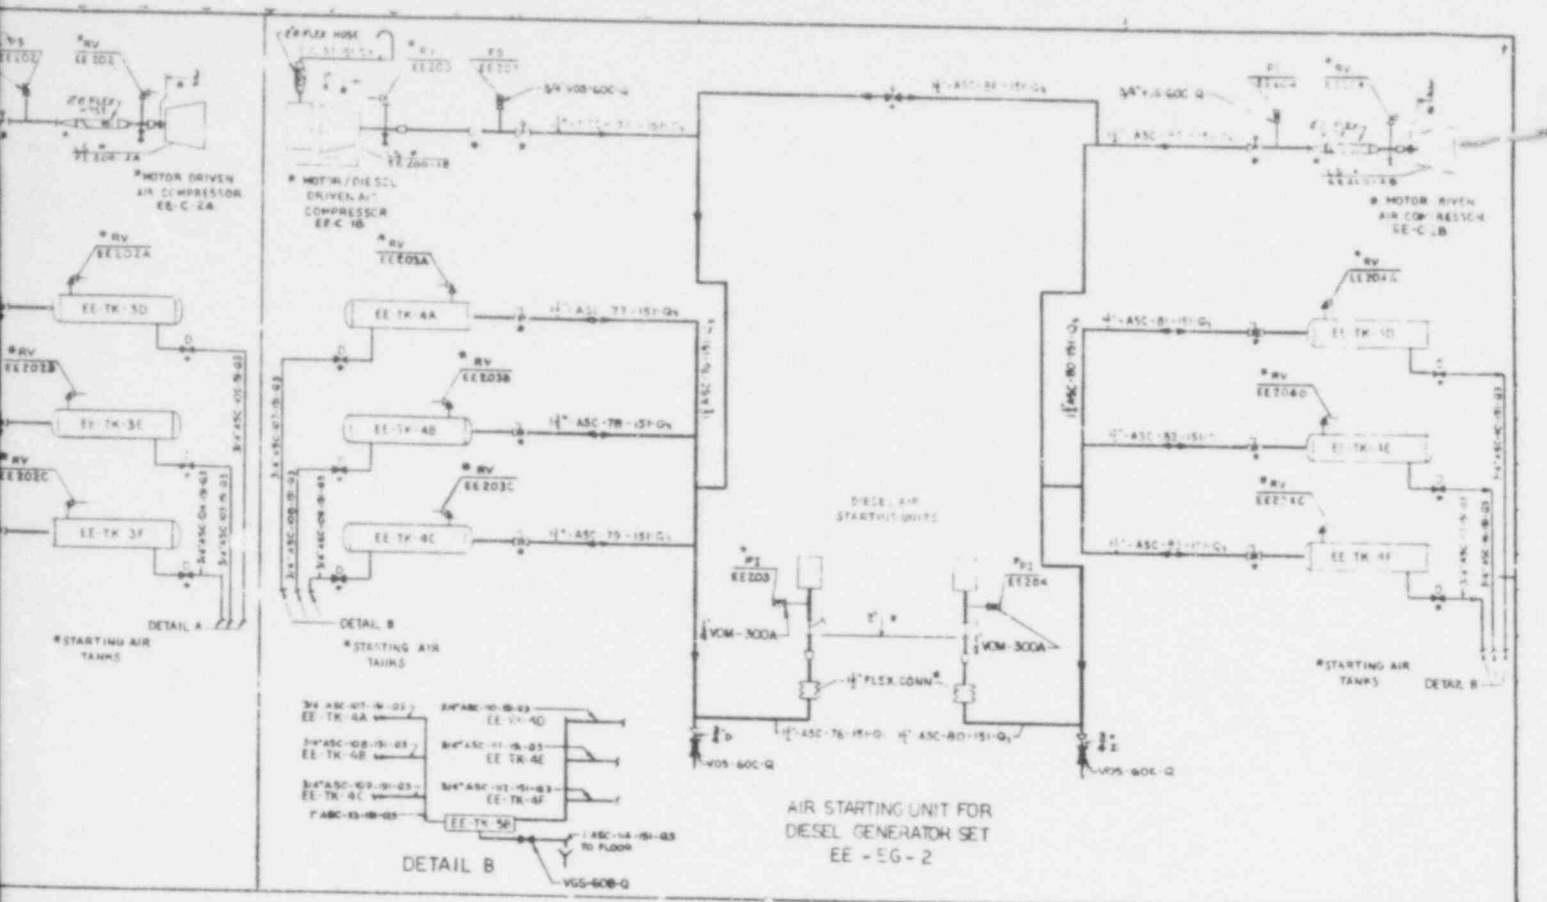

AS-BUILT

541 139



THE INFORMATION ON THIS DRAWING MAY NOT BE
CORRECT OR USED FOR OTHER THAN THE CONSTRUCTION,
MAINTENANCE OR REPAIR OF THE PLANT FACILITY
DESCRIBED IN THE TITLE BLOCK.

APPROVED: *[Signature]*



154W DWG. NO. 11700-RM-54

BEAVER VALLEY POWER STATION, UNIT 1


LIST OF FSAR FIGURES

| <u>Figure</u> | <u>Title</u> | |
|---------------|---|--|
| 6.4-1 | Containment Depressurization System | |
| 9.4-1 | Component Cooling Water System (Sheet 1) | |
| 9.4-2 | Component Cooling Water System (Sheets 1 & 2) | |
| 9.5-1 | Fuel Pool Cooling and Purification System | |
| 9.9-1B | Intake Structure | |

541 140


POOR ORIGINAL

541 141

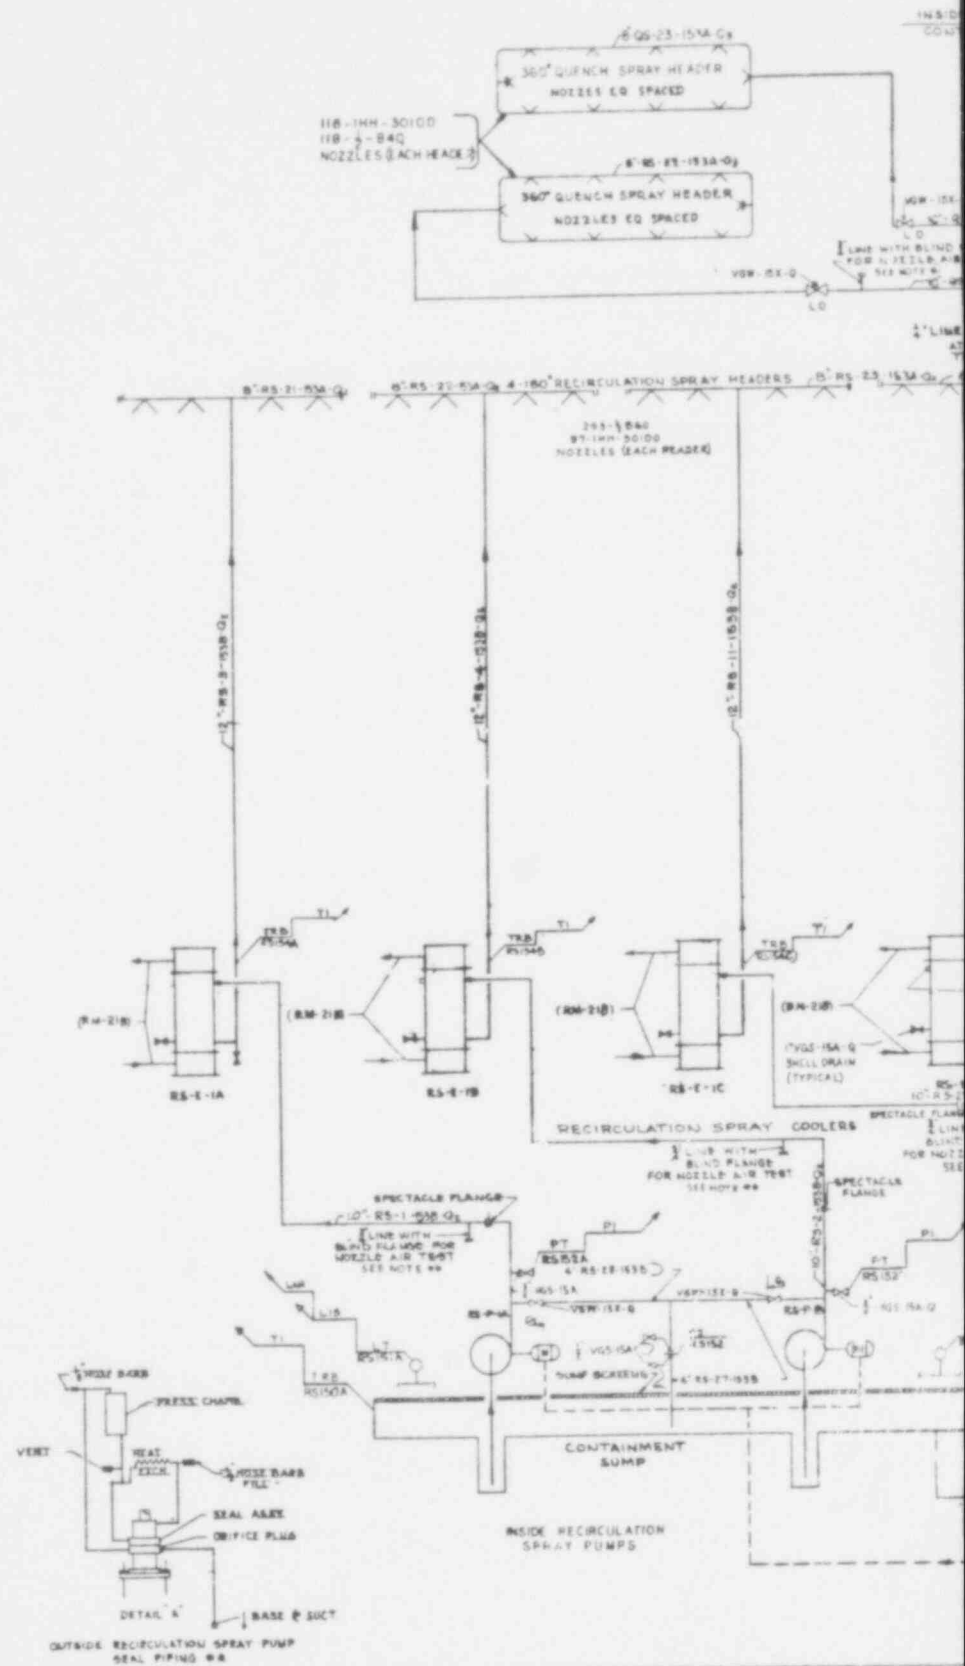



| RM No LEGEND | | | | | | | | | | | |
|--------------|--------|-------|--------|-------|--------|-------|--------|-------|--------|-------|--------|
| RM No | FIG No | RM No | FIG No | RM No | FIG No | RM No | FIG No | RM No | FIG No | RM No | FIG No |

12/7/73

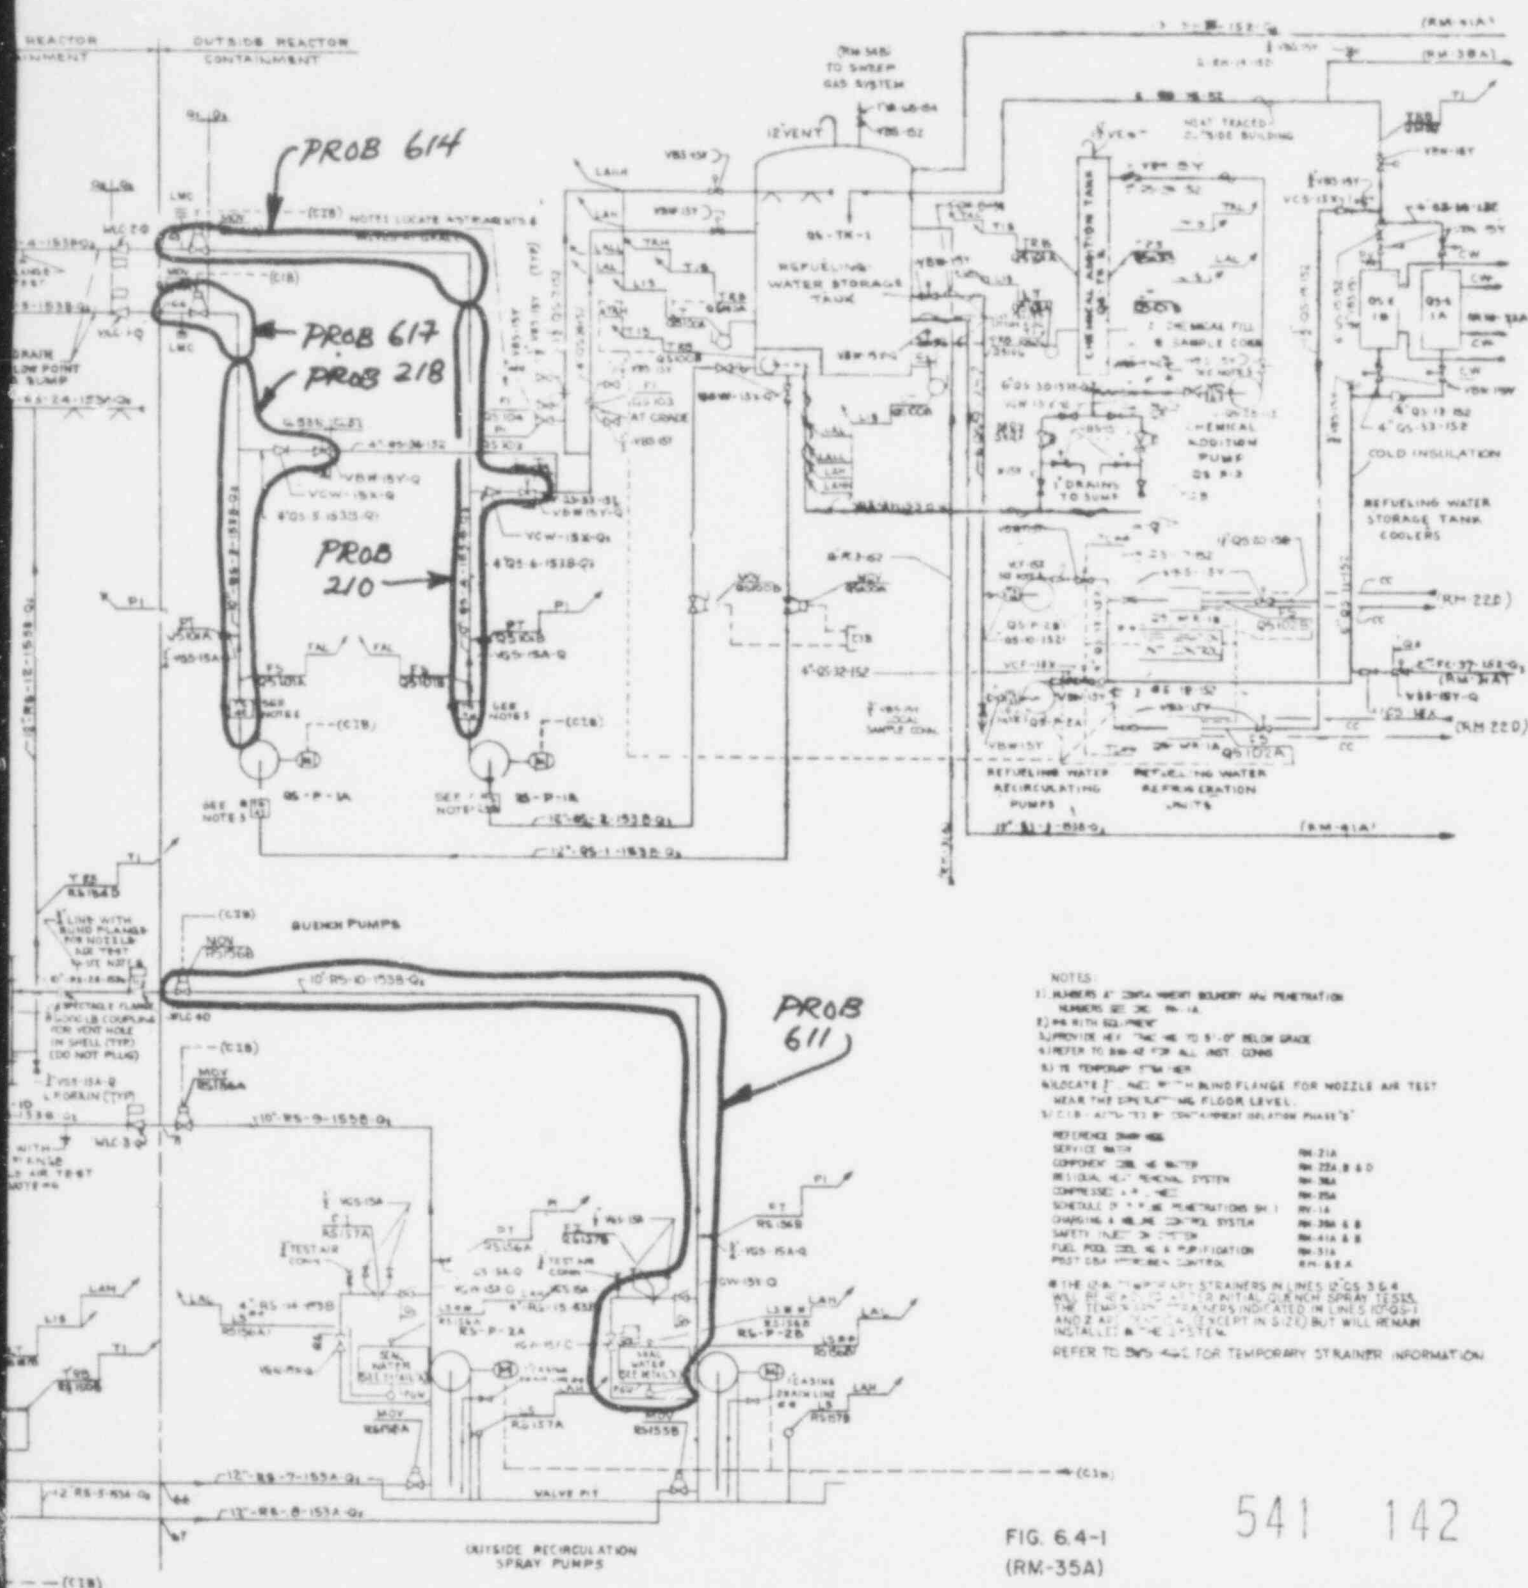FIG. 6.4-1
(RM-35A)CONTAINMENT DEPRESSURIZATION
SYSTEMBEAVER VALLEY POWER STATION
FINAL SAFETY ANALYSIS REPORT


FOR ORIGINAL

PROB
171

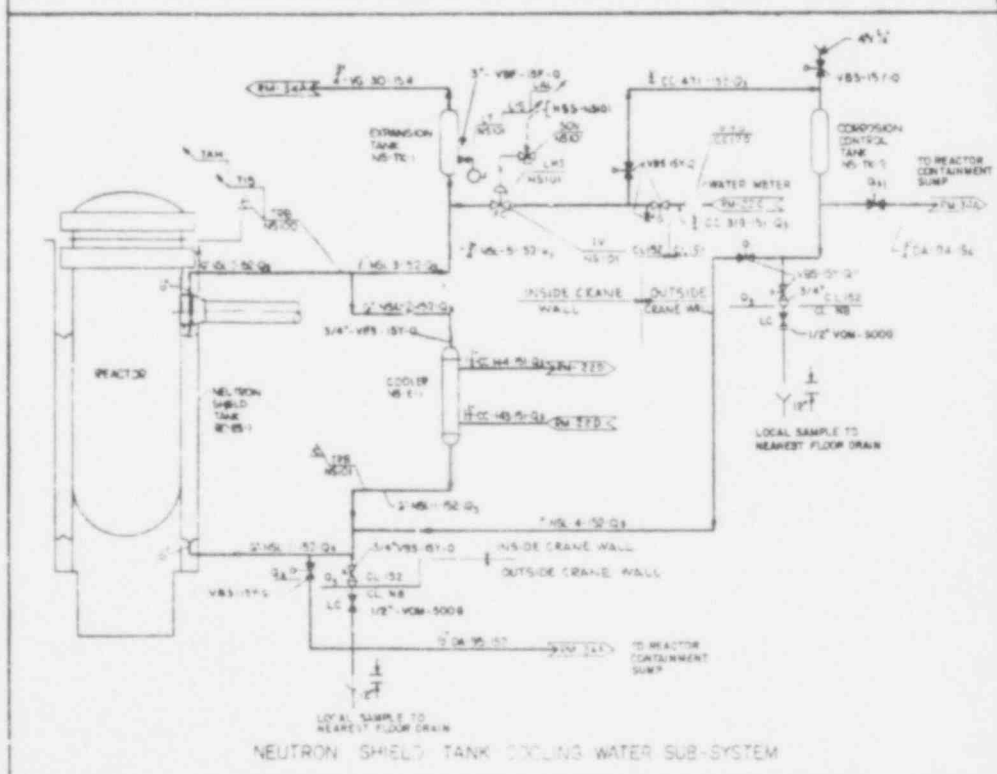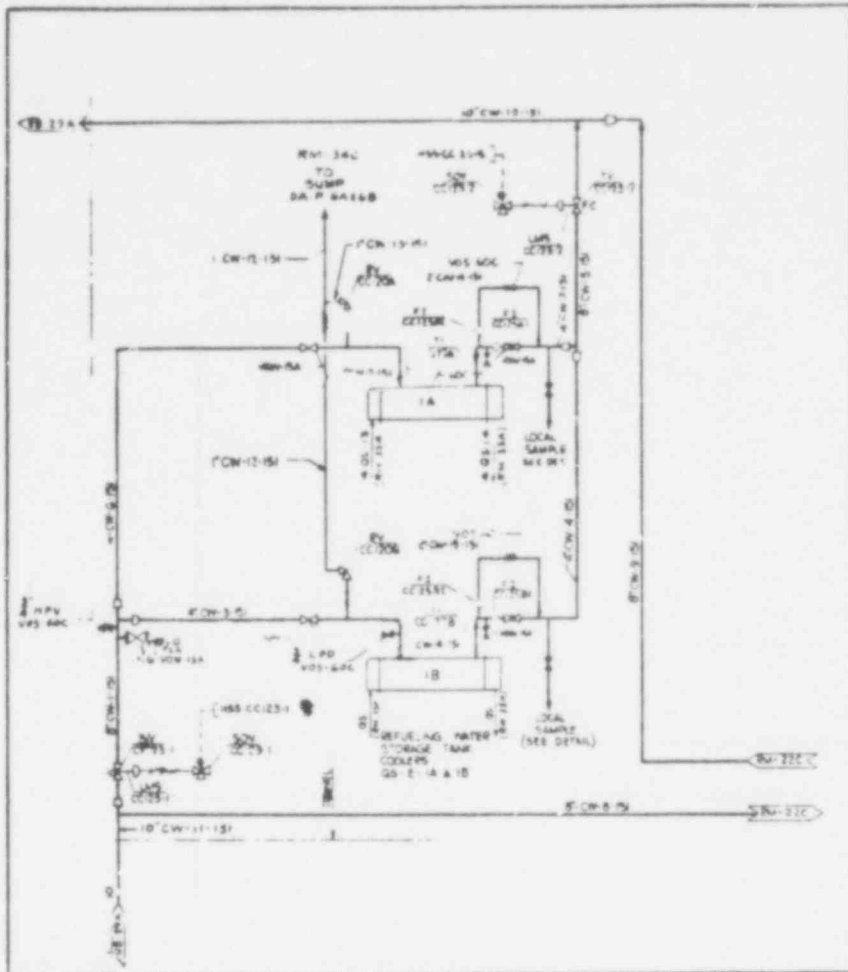


541 143


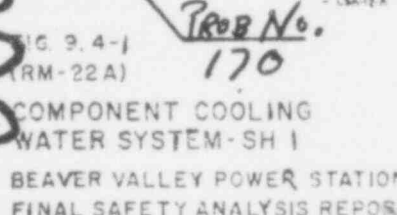

Prob No.
172


POOR ORIGINAL

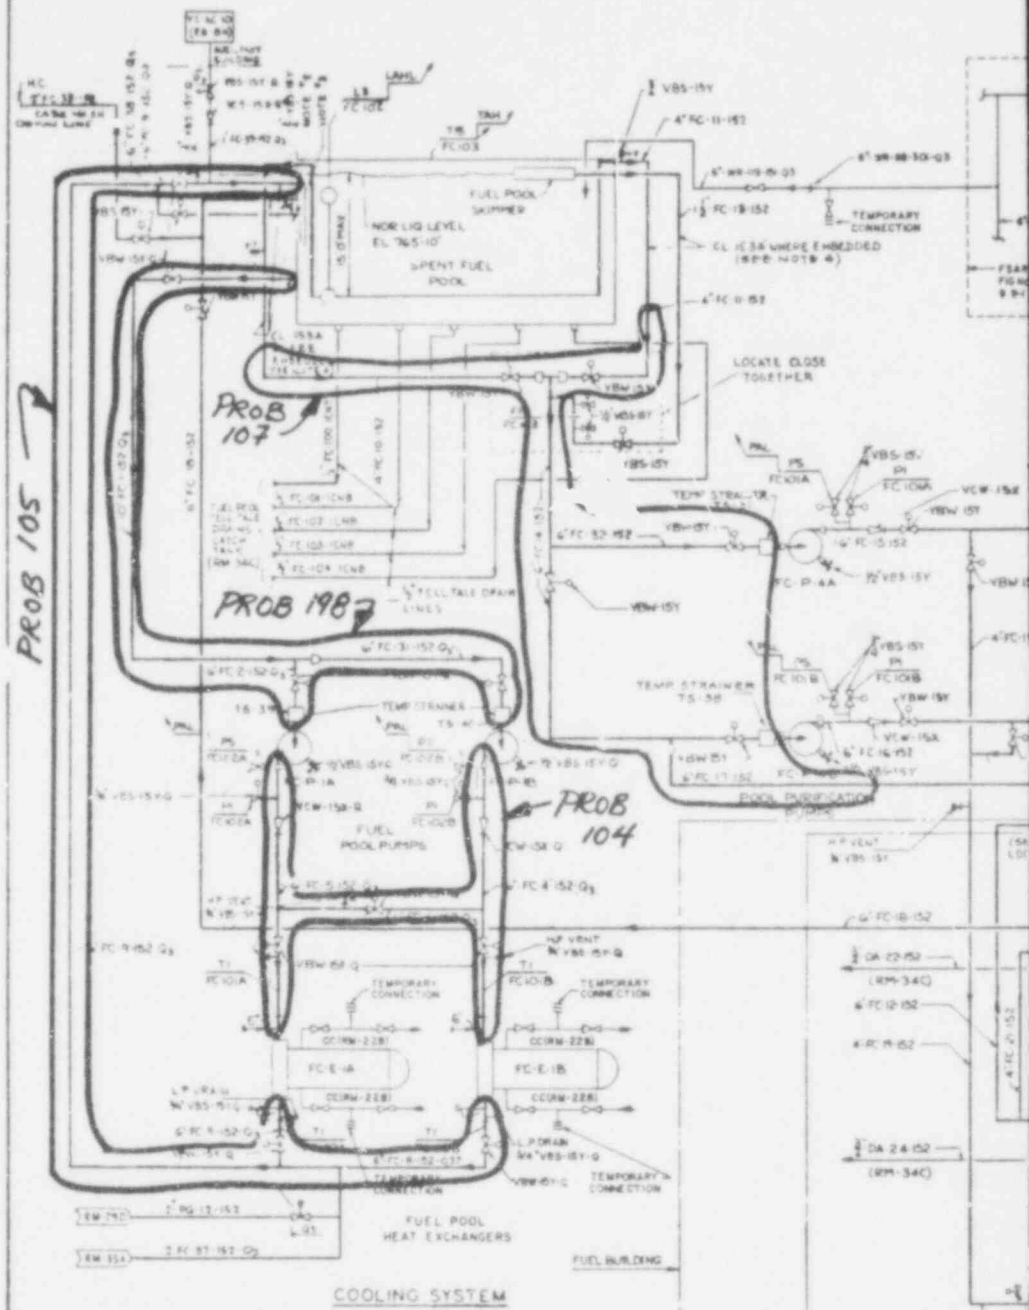


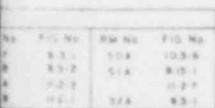

FUEL POOL COOLING AND
PURIFICATION SYSTEM
BEAVER VALLEY POWER STATION
FINAL SAFETY ANALYSIS REPORT

BEAVER VALLEY POWER STATION, UNIT 1

plant are subject to regulatory body approval, so this combination of requirements governs seismic design of B31.1 piping on nuclear plants.

As discussed previously, in all except the very early plants, a seismic ground motion in the form of ground spectra and appropriate acceleration levels would be specified. This motion would be applied to the buildings and amplifications of the ground motion at various levels throughout the buildings would be computed in the form of floor response spectra. It is the latter that were used as design bases for nuclear piping.

The qualification of large piping systems of safety class categories is nearly always done by means of a computer analysis. A dynamic analytical model of the piping system is derived in which the mass of the system is concentrated at a finite number of mass points and the flexibility of the system is represented by springs connecting the masses. System damping is included as viscous damping, normally with highly conservative numerical values of 0.5 or 1 percent of critical damping. The completed model is then analyzed for the appropriate seismic spectral motion on the computer.

Usually, one amplified floor response spectrum is used as an input acceleration at every point of support or connection to the building. This simplification can be an important conservatism especially for piping systems traversing different vertical levels or different buildings. The model of the piping system is passed through the computer several times to account for all directions of motion and both the operating and design basis earthquakes.

Inertia forces are developed first for all directions within each mode of vibration, then the contributions of each mode are combined to obtain the total force. A current controversy lies in the fact that force combinations within each mode were in some cases combined algebraically so that some loads would subtract from the total. The alternative would be to combine forces in such a way that subtraction could not occur, which is the case if an SRSS approach is used.

Effects of the inertial forces are combined with effects from relative building displacements, gravity (weight) effects, and internal/external pressure loadings on the pipe.

When load combinations are complete, bending moments and stresses in the piping system are computed according to B31.1 equations. Basically, twice the maximum shearing stress in the pipe due to bending and tension is computed and limited to $1.2 S_h$ for the OBE and $1.8 S_h$ for the DBE in a manner very comparable to ASME III today. S_h is the tabulated value of allowable stress as provided by the Code, in the hot condition. In B31.1, S_h is based on the lower of $5/8$ Yield Strength or $1/4$ Ultimate Strength at operating temperature, except certain austenitic materials are permitted S_h values at operating temperatures up to 90 percent of yield strength because of the greater toughness and ductility of these materials. These values of allowable stress are the lowest in use for any piping in the United States. ASME III Class 1 nuclear piping has higher allowables, as does B31.3 Refinery and Chemical Plant Piping. B31.4 and B31.8 for Gas and Oil Transmission piping respectively permit allowable stresses up to 72 percent of the ultimate

BEAVER VALLEY POWER STATION, UNIT 1

deflection. Extrapolating the curve of Figure H-3 to 0.5 inch deflection yields 10 percent damping.

As plasticity develops in the piping even in small amounts, damping ratios of 10 percent and higher are definitely to be expected. In fact, there is a major project underway at the present¹⁷ to develop seismic restraints based on cyclic plasticity of the supports. The essential quality of the relationship between damping, acceleration level, and damage is that damage to piping does not increase proportionately with input acceleration levels and this is due in large part to increases in damping levels as deflections increase.

8. CONCLUSIONS AND IMPLICATIONS FOR MODERN NUCLEAR PLANTS

The evolution of seismic design methods in nuclear power plants has been reviewed together with the development of the piping codes. It was shown that nuclear plants that meet the older B31.1 code will more than likely also satisfy the new nuclear codes that have better quantified conservatism.

Available data on the actual seismic performance of power piping systems were reviewed. It was shown that operating power plants do indeed have very high levels of seismic capability. Of the several plants that sustained severe ground motion from 0.2 to 0.6 g, there were no failures of welded steel power piping. Considering the magnitudes of the earthquakes and the variability of the design practices, this is an excellent record and can only have been made possible by the natural resiliency of power piping.

The probable reasons for this natural resiliency were discussed next. It is believed that the main reasons are: first, the substantial conservatism of the Code for Power Piping, B31.1, including the provisions for materials, fabrication, and construction; second, that design of piping for thermal expansion provides inherent seismic capability; and third, that damping increases very rapidly with deflection levels. The large damping factors prevent buildup of seismic disturbances in resonant systems. It is believed these reasons explain the remarkable performance of piping systems in earthquakes.

Based upon the foregoing observations, it is very improbable that piping-related safety problems would occur in nuclear plants in the eastern United States due to seismic disturbances. These plants have maximum ground motions of 0.15 g; they have been designed by dynamic analysis; and all safety piping systems have been specifically scrutinized. Contrast this situation with say the Kern County plant where 0.25 g was actually experienced and explicit analysis was performed only on the steam and feed lines; or the ENALUF plant which was probably designed statically and experienced perhaps 0.6 g. The contrast is simply too great; piping failures of nuclear safety systems should not result from earthquakes in the United States.

9. REFERENCES

1. Cloud, R.L. et al. Editors, Pressure Vessels and Piping, Design and Analysis, Amer. Soc. of Mech. Engrs. N.Y., N.Y., 1972.

541 148

BEAVER VALLEY POWER STATION UNIT 1

2. Biot, M.A., Analytical and Experimental Methods in Engineering Seismology, Trans ASCE 108 p 365-408, 1942.
3. Biggs, J.M., Introduction to Structural Dynamics, McGraw Hill Book Co., 1964.
4. Berkowitz, L., Seismic Analysis of Primary Piping Systems for Nuclear Generating Systems, Reactor and Fuel Processing Technology, Argonne Natl Lab, Fall, 1969.
5. Markl, A.R.C., Fatigue Tests of Piping Components, Trans ASME V 74 1952.
6. Brock, J.E., Expansion and Flexibility, Chap. 4, Piping Handbook, 5th Ed., King and Crocker (Eds.) McGraw Hill Publishing Co., 1967.
7. Markl, A.C.R., Piping Flexibility Analysis, Trans ASME, 1955, p 419.
8. Criteria of the ASME Boiler and Pressure Vessel Code for Design by Analysis, Amer. Soc. of Mech. Engrs., 1979 (to be published).
9. Swiger, W.F., personal communication, May 1979.
10. Swiger, W.F., Notes on Plants Designed by Stone & Webster Which Have Experienced Large Earthquakes, 1979, Unpublished.
11. How Nuclear Piping Code Rules Will Influence Piping Design Today and Tomorrow, Heating, Piping, and Air Conditioning, June, 1970, p 69.
12. The Great Alaska Earthquake of 1964, Engineering, National Academy of Sciences, Washington, D.C., 1973.
13. San Fernando, California, Earthquake of February 9, 1971, Leonard Murphy, Sci. Coord, U.S. Dept. of Comm., NOAA, Washington, D.C., 1973.
14. Snyder, Arthur I., Damage to Mechanical Equipment as a Result of the Feb. 9, 1971 Earthquake in San Fernando, California, Seismic Design and Analysis, Amer. Soc. of Mech. Engrs., 1971.
15. Managua, Nicaragua Earthquake of Dec. 23, 1972, Earthquake Engineering Research Inst., Nov., 1973.
16. Bohm, George J. Damping for Dynamic Analysis of Reactor Coolant Loop Systems, Optical Meeting on Reactor Safety, Salt Lake City, Utah, March 1973, Conf-730304 Available NTIS.
17. Bush, Spencer, Battelle Northwest Laboratories, Personal Communication.