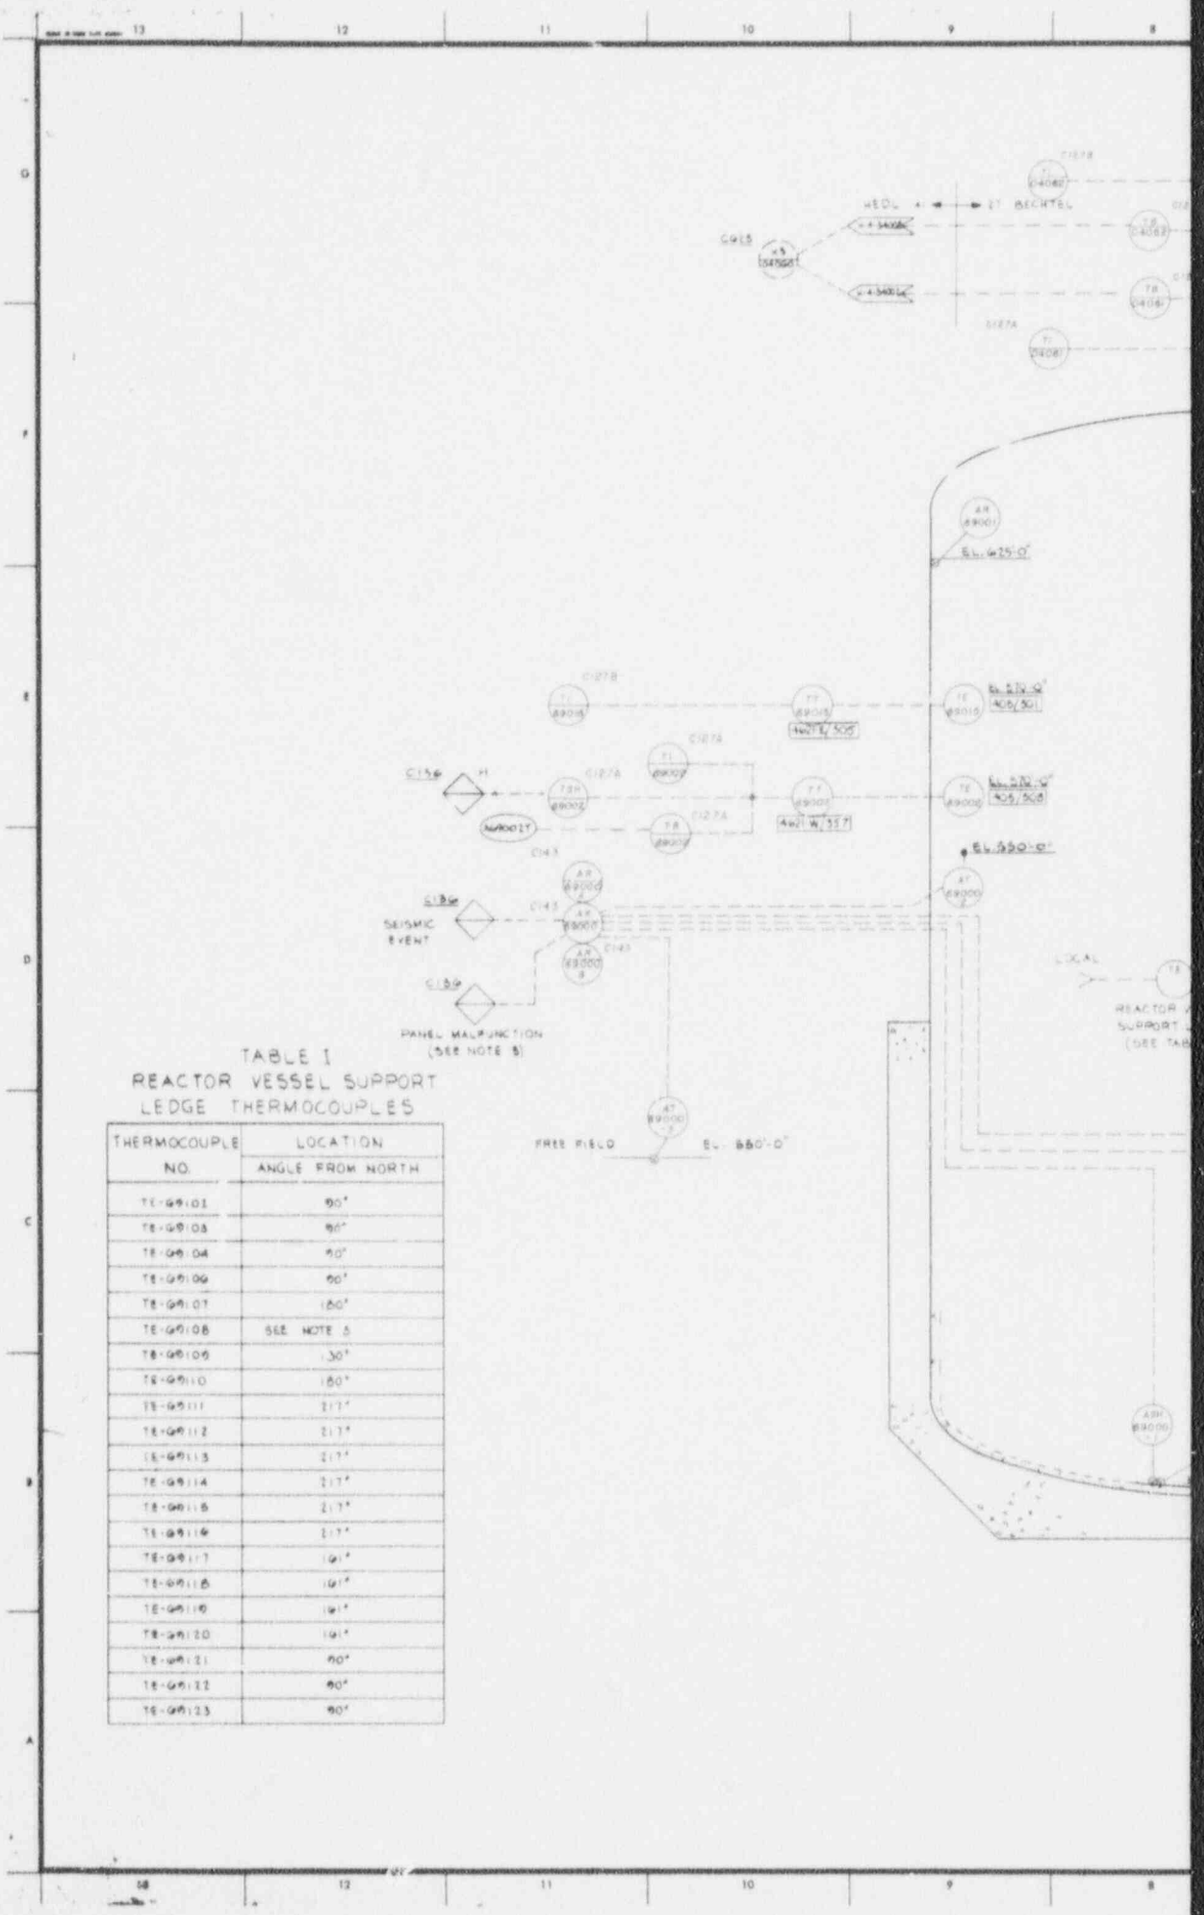

TABLE I

REACTOR VESSEL SUPPORT LEDGE THERMOCOUPLES

THERMOCOUPLE NO.	LOCATION ANGLE FROM NORTH
TE-G9101	90°
TE-G9103	90°
TE-G9104	90°
TE-G9106	90°
TE-G9107	180°
TE-G9108	SEE NOTE 8
TE-G9109	270°
TE-G9110	180°
TE-G9111	217°
TE-G9112	217°
TE-G9113	217°
TE-G9114	217°
TE-G9115	217°
TE-G9116	217°
TE-G9117	191°
TE-G9118	191°
TE-G9119	191°
TE-G9120	191°
TE-G9121	90°
TE-G9122	90°
TE-G9123	90°

8001110614

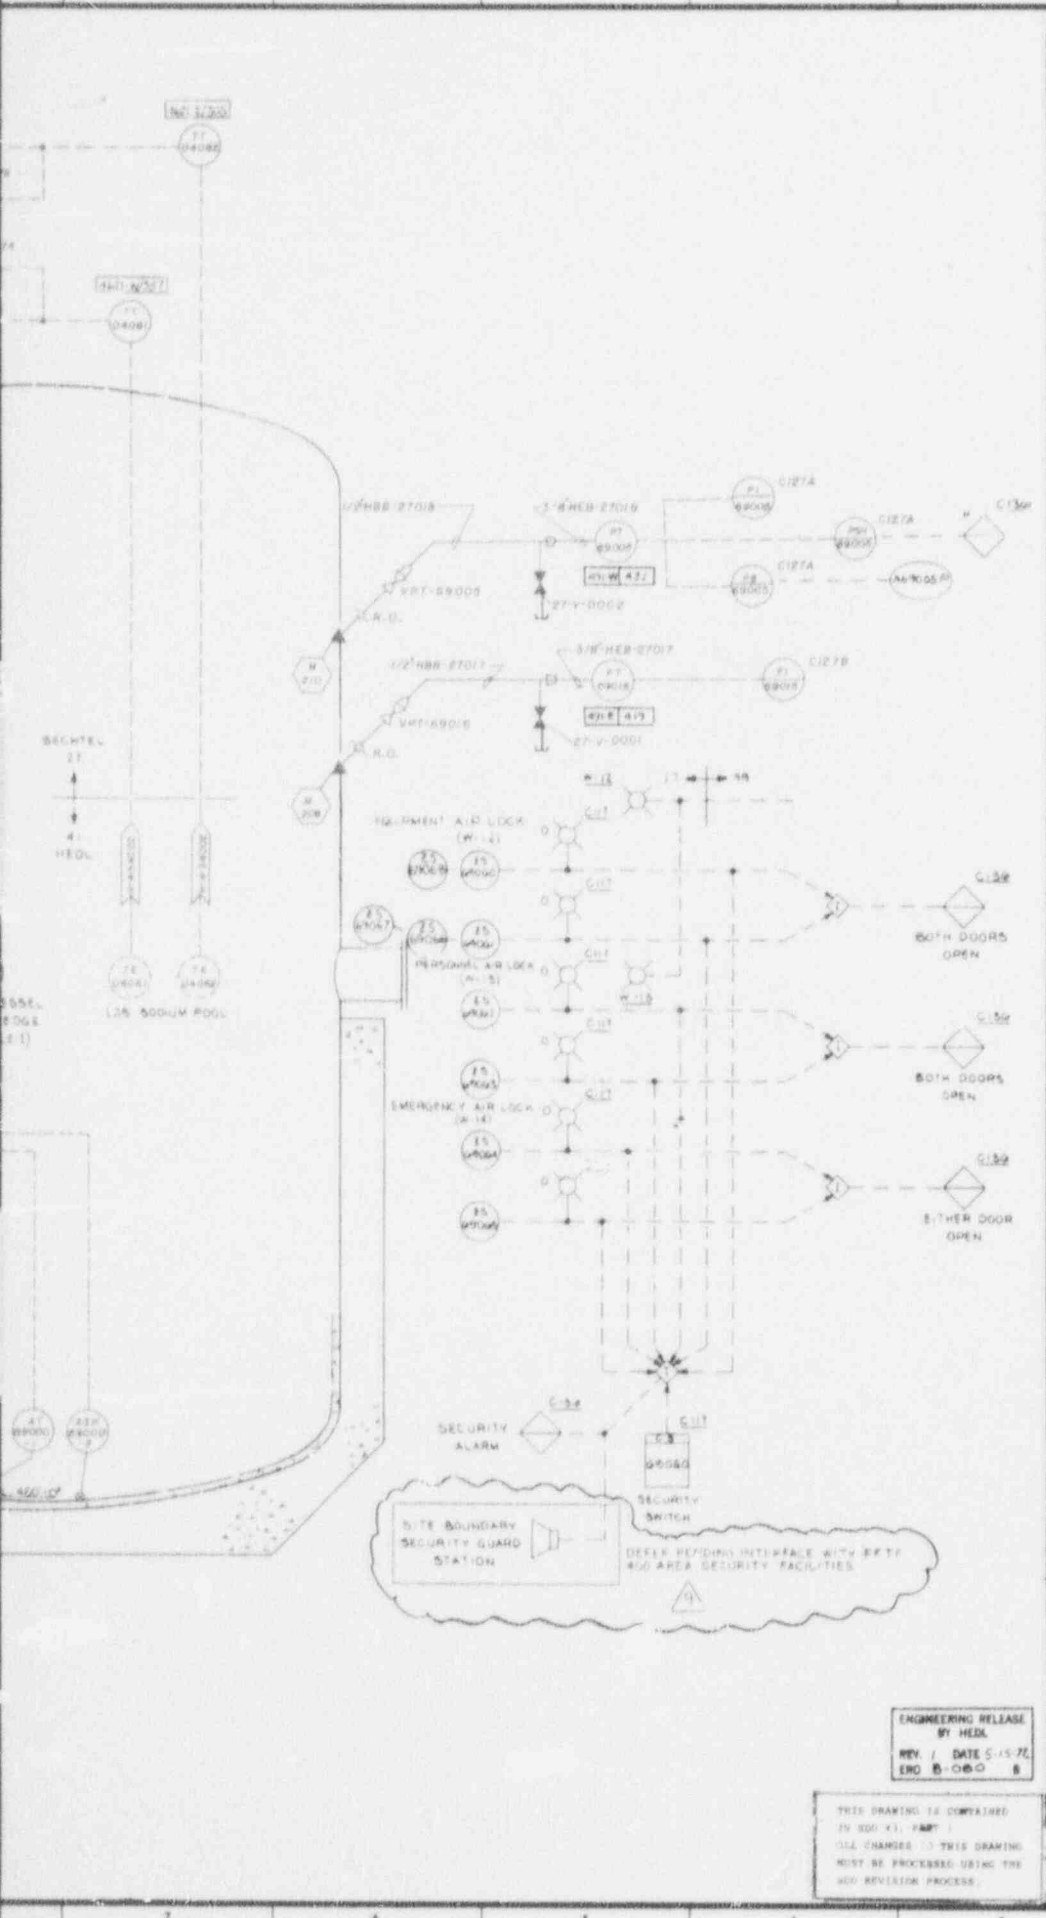

NEXT USED ON

REFERENCE DRAWINGS

DWG. NO.	REV. NO.	DRAWING TITLE OR SHEET NO.
H-4-11140		P&ID - REACTOR CONTAINMENT VACUUM RELIEF SYS. SYS 27
H-4-34002		IDS P & I FLOW DIAGRAM SODIUM SYSTEM SYS 41
H-4-12151		LOGIC DIAGRAM - REACTOR CONTAINMENT SYS 27
SP-HBB-2701730	0	CTMT M208 TO PT 69016 SYS 27
SP-HBB-2701830	0	CTMT M210 TO PT 69005 SYS 27

NOTES:

1. SEE DWGS H-4-11093 THRU H-4-11096, H-4-11098 AND H-4-11099 FOR SYMBOL INDENTIFICATION AND LEGEND.
2. CONTAINMENT VACUUM RELIEF VALVE MONITORING INSTRUMENTATION IS SHOWN ON DRAWING H-4-11140.
3. THE PANEL C-143 MALFUNCTION ALARM CONSISTS OF THE FOLLOWING PANEL ALARMS: (1) END OF MAGNETIC TAPE, (2) LOSS OF AC POWER, AND (3) HIGH PANEL TEMPERATURE.
4. THE CONTAINMENT POST ACCIDENT PRESSURE TRANSMITTERS UTILIZE THE PRESSURE CONNECTION ON THE CONTAINMENT PIPING PENETRATIONS.
5. THERMOCOUPLE TE-41108 IS ABANDONED PER SNR-9548.

REVISIONS

DESCRIPTION	REV NO.
REVISED/FCN H-1890	9
REVISED/ECN-D-4555	8
REVISED/ECN-D-0908	7
REVISED/FCN H-1232	6
REVISED & RELEASED (MB)	5
RELEASED ECP B-1701 ERO B-6BN (8-1-75)	4
~~FOR HEDL APPROVAL PER ECP B-1701~~	~~B~~
RELEASED HEDL ERO B-2214, ECP A-1002, (11-7-73)	3
~~FOR HEDL APPROVAL PER ECP B-1002~~	~~C~~
RELEASED PER ERO B-1150 (4-12-73)	2
~~FOR APPROVAL PER ECP B-0250~~	~~B~~
~~FOR APPROVAL PER ECP B-112~~	~~A~~
CONSTRUCTION ECP-B077	1
~~ISSUED FOR APPROVAL~~	~~0~~

DRAWING STATUS: 9

ENGINEERING RELEASE BY HEDL
REV. 1 DATE 5-15-72
ERO B-080 B

THIS DRAWING IS CONTAINED IN SDD 41, PART 1. ALL CHANGES TO THIS DRAWING MUST BE PROCESSED USING THE SDD REVISION PROCESS.

TYPE 1 DATA

A.T. KARADI
A. MARINO
SCALE: NONE
CLASSIFIED BY: NOT REQUIRED

U. S. ATOMIC ENERGY COMMISSION
RICHLAND OPERATIONS OFFICE
HANFORD ENGINEERING DEVELOPMENT LABORATORY
Operated by WADCO

BECHTEL SAN FRANCISCO JOB NO. 5855

REACTOR CONTAINMENT MONITORING INSTRUMENTATION SYSTEM-27

FAST FLUX TEST FACILITY

YB A103 7002

H-4-12254 SHEET 1 OF 1